


CONSTRUCTION PLANS FOR: HAMILTON RIDGE PLAT 7

WAUKEE, IOWA

VICINITY MAP

NOT TO SCALE

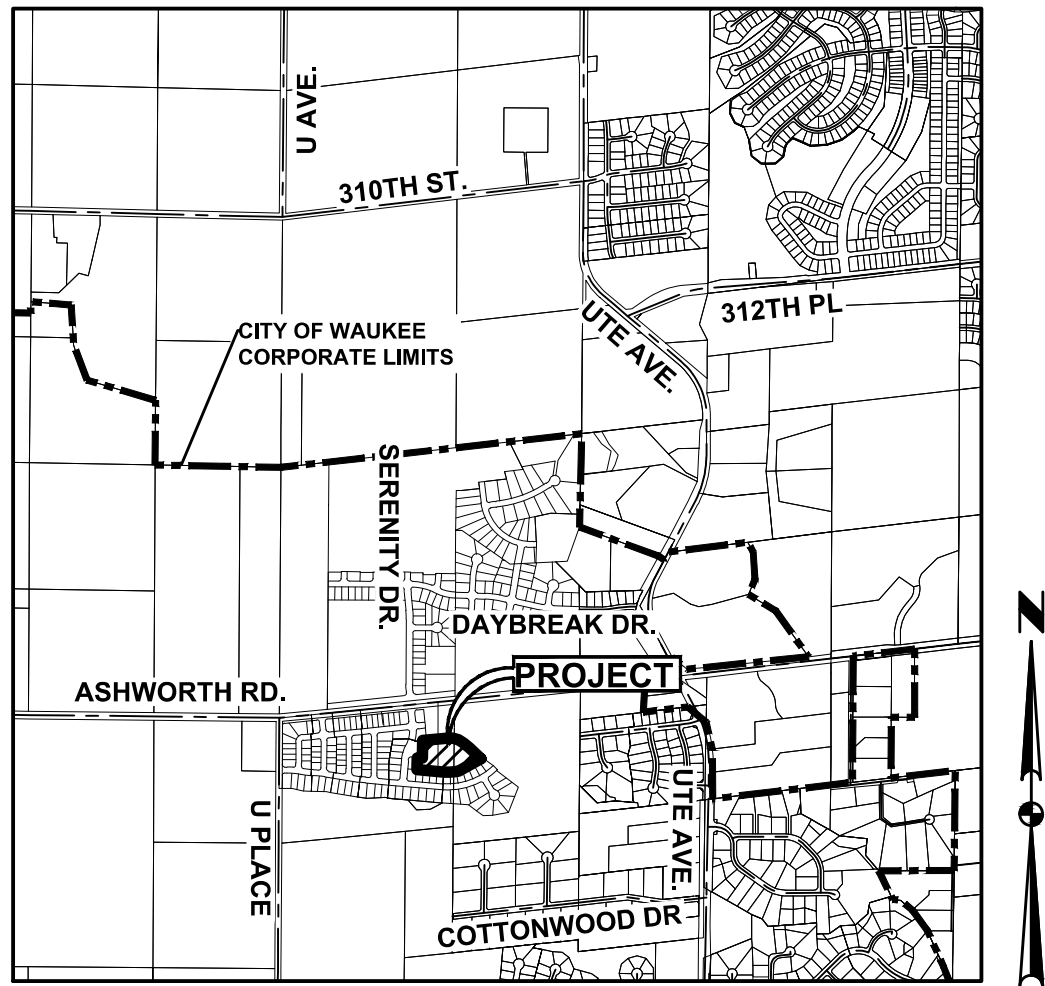

WAUKEE, IOWA

DEVELOPER

LANDMARK DEVELOPMENT SERVICES
9550 HICKMAN ROAD, SUITE 100
CLIVE, IOWA 50325
PH: (515) 986-5994
CONTACT: BILL SPENCER

OWNER

HAMILTON RIDGE, LLC
CONTACT: BILL SPENCER
9550 HICKMAN ROAD, SUITE 100
CLIVE, IA 50325
PH: (515) 986-5994

ENGINEER

CIVIL DESIGN ADVANTAGE
3405 SE CROSSROADS DRIVE, SUITE G
GRIMES, IOWA 50111
CONTACT: ERIN OLLENDIKE
EMAIL: ERINO@CDA-ENG.COM
PH: (515) 369-4400
FX: (515) 369-4410

SURVEYOR

CIVIL DESIGN ADVANTAGE
3405 SE CROSSROADS DRIVE, SUITE G
GRIMES, IOWA 50111
CONTACT: CHARLIE MCGLOTHLEN
EMAIL: CHARLIE@CDA-ENG.COM
PH: (515) 369-4400
FX: (515) 369-4410

ZONING

R-2: ONE AND TWO-FAMILY
RESIDENTIAL DISTRICT

BULK REGULATIONS

R-2: ONE- AND TWO- FAMILY RESIDENTIAL DISTRICT (LOTS 14-17)

FRONT YARD: 30 FEET
SIDE YARD: A TOTAL OF 15 FEET - ONE SIDE MAY BE REDUCED TO
NOT LESS THAN 7 FEET
REAR YARD: 30 FEET

BENCHMARKS

DALLAS COUNTY BM# G121, EAST SIDE OF R16 0.1 MILE SOUTH OF 300TH
STREET.
ELEVATION=1032.82

BURY BOLT ON HYDRANT @ NW CORNER OF DAYBREAK DRIVE & CREST
RIDGE DRIVE.
ELEVATION=1023.95

CONSTRUCTION SCHEDULE

SPRING 2021 - FALL 2021

DEVELOPMENT SUMMARY

TOTAL AREA OF PLAT 7 = 3.91 ACRES (170,116 SF)

NOTES

- ANY CHANGES PROPOSED TO THE CONSTRUCTION DRAWINGS DURING CONSTRUCTION SHALL BE APPROVED IN WRITING BY THE DEVELOPMENT SERVICES DEPARTMENT.
- THE CONTRACTOR IS RESPONSIBLE FOR ANY CHANGES MADE DURING CONSTRUCTION THAT HAVE NOT BEEN GRANTED APPROVAL IN WRITING BY THE DEVELOPMENT SERVICES DEPARTMENT.
- THE RESULTS OF THE GEOTECHNICAL REPORT ARE TO BE PROVIDED TO THE CITY OF WAUKEE ENGINEERING DEPARTMENT. THE CONSTRUCTION DRAWINGS ARE SUBJECT TO ANY CHANGES REQUIRED BY THE REPORT.

DATE OF SURVEY:

APRIL 16, 2020

SUBMITTALS

FIRST SUBMITTAL: 07/13/2021
SECOND SUBMITTAL: 07/27/2021
THIRD SUBMITTAL: 08/18/2021
FINAL SUBMITTAL: 09/03/2021
AS-BUILT SUBMITTAL: 12/29/2021

INDEX OF SHEETS

NO.	DESCRIPTION
1	TITLE SHEET
2-3	TYPICAL SECTIONS AND DETAILS
4	QUANTITIES, GENERAL NOTES AND BID ITEM REFERENCE NOTES
5	HYDRANT COVERAGE AND LANDSCAPE PLAN
6	GRADING PLAN
7	EROSION AND SEDIMENT CONTROL PLAN
8-9	STORM & SANITARY SEWER PLAN AND PROFILE
10	WATER MAIN PLAN AND PROFILE
11	INTERSECTION DETAILS

LEGAL DESCRIPTION

A PART OF PARCEL '20-69' AS SHOWN ON THE PLAT OF SURVEY RECORDED IN BOOK 2020, PAGE 23365, BEING A PART OF THE NORTHWEST FRACTIONAL QUARTER OF THE NORTHEAST QUARTER OF SECTION 7, TOWNSHIP 78 NORTH, RANGE 26 WEST OF THE FIFTH PRINCIPAL MERIDIAN AND A PART OF OUTLOT 'Z', HERTZ FARM PLAT 1, AN OFFICIAL PLAT, ALL IN THE CITY OF WAUKEE, DALLAS COUNTY, IOWA AND MORE PARTICULARLY DESCRIBED AS FOLLOWS:

BEGINNING AT THE NORTHEAST CORNER OF HAMILTON RIDGE PLAT 3, AN OFFICIAL PLAT; THENCE NORTH 84°11'29" EAST ALONG THE EASTERLY LINE OF HAMILTON RIDGE PLAT 1, AN OFFICIAL PLAT AND THE EASTERLY EXTENSION THEREOF, 255.86 FEET; THENCE SOUTH 89°39'26" EAST, 61.32 FEET; THENCE SOUTH 72°08'41" EAST, 59.31 FEET; THENCE SOUTH 56°03'28" EAST, 65.26 FEET; THENCE SOUTH 50°13'53" EAST, 73.12 FEET; THENCE SOUTH 47°15'30" EAST, 163.20 FEET TO THE NORTHERLY LINE OF HAMILTON RIDGE PLAT 6, AN OFFICIAL PLAT; THENCE SOUTH 60°50'51" WEST ALONG SAID NORTHERLY LINE, 263.40 FEET; THENCE SOUTH 77°26'50" WEST CONTINUING ALONG SAID NORTHERLY LINE, 23.95 FEET; THENCE SOUTH 84°14'56" WEST, 64.66 FEET; THENCE NORTH 88°56'57" WEST, 64.66 FEET TO THE NORTHWEST CORNER OF SAID HAMILTON RIDGE PLAT 6; THENCE NORTH 85°01'09" WEST ALONG THE EASTERLY LINE OF SAID HAMILTON RIDGE PLAT 3, A DISTANCE OF 69.57 FEET; THENCE NORTH 84°59'54" WEST CONTINUING ALONG SAID EASTERLY LINE, 208.46 FEET; THENCE NORTH 00°17'09" EAST CONTINUING ALONG SAID EASTERLY LINE, 121.19 FEET; THENCE SOUTH 89°42'51" EAST CONTINUING ALONG SAID EASTERLY LINE, 55.35 FEET; THENCE NORTH 00°17'09" EAST CONTINUING ALONG SAID EASTERLY LINE, 180.32 FEET TO THE POINT OF BEGINNING AND CONTAINING 3.91 ACRES (170,116 SQUARE FEET). THE PROPERTY IS SUBJECT TO ANY AND ALL EASEMENTS OF RECORD.

UTILITY WARNING

THE UTILITIES SHOWN HAVE BEEN LOCATED FROM FIELD SURVEY AND RECORDS OBTAINED BY THIS SURVEYOR. THE SURVEYOR MAKES NO GUARANTEE THAT THE UTILITIES SHOWN COMPRISE ALL THE UTILITIES IN THE AREA, EITHER IN SERVICE OR ABANDONED. THE SURVEYOR FURTHER DOES NOT WARRANT THAT THE UTILITIES SHOWN ARE IN THE EXACT LOCATION SHOWN.

AS-BUILT DRAWINGS

AS-BUILT PLANS ARE BASED ON SURVEYED INVERT ELEVATIONS AND INFORMATION SUPPLIED BY THE CONTRACTOR. CIVIL DESIGN ADVANTAGE TAKES NO RESPONSIBILITY FOR UNAUTHORIZED CHANGES TO THE PLANS WITHOUT CITY/OWNER KNOWLEDGE. FIELD VERIFICATION OF UTILITIES OR OTHER PLAN ELEMENTS IS ALWAYS RECOMMENDED.

GENERAL LEGEND

PROPOSED

SECTION LINE	----
CENTER LINE	----
RIGHT OF WAY	--- R/W ---
PERMANENT EASEMENT	--- P/E ---
TEMPORARY EASEMENT	--- T/E ---
TYPE SW-501 STORM INTAKE	
TYPE SW-503 STORM INTAKE	
TYPE SW-505 STORM INTAKE	
TYPE SW-506 STORM INTAKE	
TYPE SW-513 STORM INTAKE	
TYPE SW-401 STORM MANHOLE	
TYPE SW-402 STORM MANHOLE	
TYPE SW-301 SANITARY MANHOLE	
STORM/SANITARY CLEANOUT	
WATER VALVE	
FIRE HYDRANT ASSEMBLY	
SIGN	
DETECTABLE WARNING PANEL	
WATER CURB STOP	
STORM SEWER STRUCTURE NO.	
STORM SEWER PIPE NO.	
SANITARY SEWER STRUCTURE NO.	
SANITARY SEWER PIPE NO.	
SANITARY SEWER WITH SIZE	8"S
SANITARY SERVICE	S S S
STORM SEWER	ST ST
STORM SERVICE	ST ST
WATERMAIN WITH SIZE	8"W
WATER SERVICE	W W W
SAWCUT (FULL DEPTH)	
SILT FENCE	
USE AS CONSTRUCTED	(UAC)
TOP OF PROPOSED GROUND	TG
MINIMUM OPENING ELEVATION	MOE
MINIMUM GRADE AT EXPOSED STRUCTURE	MGS

EXISTING

SANITARY MANHOLE	
WATER VALVE BOX	
FIRE HYDRANT	
WATER CURB STOP	
WELL	
STORM SEWER MANHOLE	
STORM SEWER SINGLE INTAKE	
STORM SEWER DOUBLE INTAKE	
FLARED END SECTION	
DECIDUOUS TREE	
CONIFEROUS TREE	
DECIDUOUS SHRUB	
CONIFEROUS SHRUB	
ELECTRIC POWER POLE	
GUY ANCHOR	
STREET LIGHT	
POWER POLE W/ TRANSFORMER	
UTILITY POLE W/ LIGHT	
ELECTRIC BOX	
ELECTRIC TRANSFORMER	
ELECTRIC MANHOLE OR VAULT	
TRAFFIC SIGN	
TELEPHONE JUNCTION BOX	
TELEPHONE MANHOLE/VAULT	
TELEPHONE POLE	
GAS VALVE BOX	
CABLE TV JUNCTION BOX	
CABLE TV MANHOLE/VAULT	
MAIL BOX	
BENCHMARK	
SOIL BORING	
UNDERGROUND TV CABLE	TV
GAS MAIN	G
FIBER OPTIC	FO
UNDERGROUND TELEPHONE	T
OVERHEAD ELECTRIC	OE
UNDERGROUND ELECTRIC	E
FIELD TILE	TILE
SANITARY SEWER W/ SIZE	8"S
STORM SEWER W/ SIZE	15" RCP
WATER MAIN W/ SIZE	8"W

ALL CONSTRUCTION SHALL CONFORM TO THE PROJECT SPECIFICATIONS AND THE SOILS REPORT PREPARED BY CONSTRUCTION MATERIALS TESTING (CMT).

THIS PROJECT REQUIRES AN IOWA NPDES PERMIT #2. CIVIL DESIGN ADVANTAGE WILL PROVIDE THE PERMITS AND THE INITIAL STORM WATER POLLUTION PREVENTION PLAN (SWPPP) FOR THE CONTRACTORS USE DURING CONSTRUCTION. THE CONTRACTOR SHALL BE RESPONSIBLE FOR UPDATING THE SWPPP THROUGHOUT CONSTRUCTION AND MEETING LOCAL, STATE AND FEDERAL REQUIREMENTS.

THIS DESIGN SPECIFICALLY PREPARED FOR USE AT THE LOCATION SHOWN. USE IN ANY OTHER MANNER EXCEEDS THE INTENDED PURPOSE OF THESE DRAWINGS AND ANY ACCOMPANYING SPECIFICATIONS.

THE 2020 EDITION OF THE CITY OF WAUKEE STANDARD SPECIFICATIONS FOR PUBLIC IMPROVEMENTS AND THE 2021 EDITION OF SUDAS STANDARD SPECIFICATIONS SHALL APPLY TO ALL WORK PERFORMED ON THIS PROJECT EXCEPT AS MODIFIED HEREIN.



CIVIL DESIGN ADVANTAGE

3405 SE CROSSROADS DR. SUITE G GRIMES, IOWA 50111

PH: (515) 369-4400 Fax: (515) 369-4410

PROJECT NO. 2106.480



1-800-292-8989

www.iowaonecall.com



I HEREBY CERTIFY THAT THIS ENGINEERING DOCUMENT WAS PREPARED BY ME OR UNDER MY DIRECT PERSONAL SUPERVISION AND THAT I AM A DULY LICENSED PROFESSIONAL ENGINEER UNDER THE LAWS OF THE STATE OF IOWA.

Erin K. Ollendike


ERIN K. OLLENDIKE, P.E.

12-29-2021


DATE

LICENSE NUMBER 16926
MY LICENSE RENEWAL DATE IS DECEMBER 31, 2021
PAGES OR SHEETS COVERED BY THIS SEAL:

ALL SHEETS

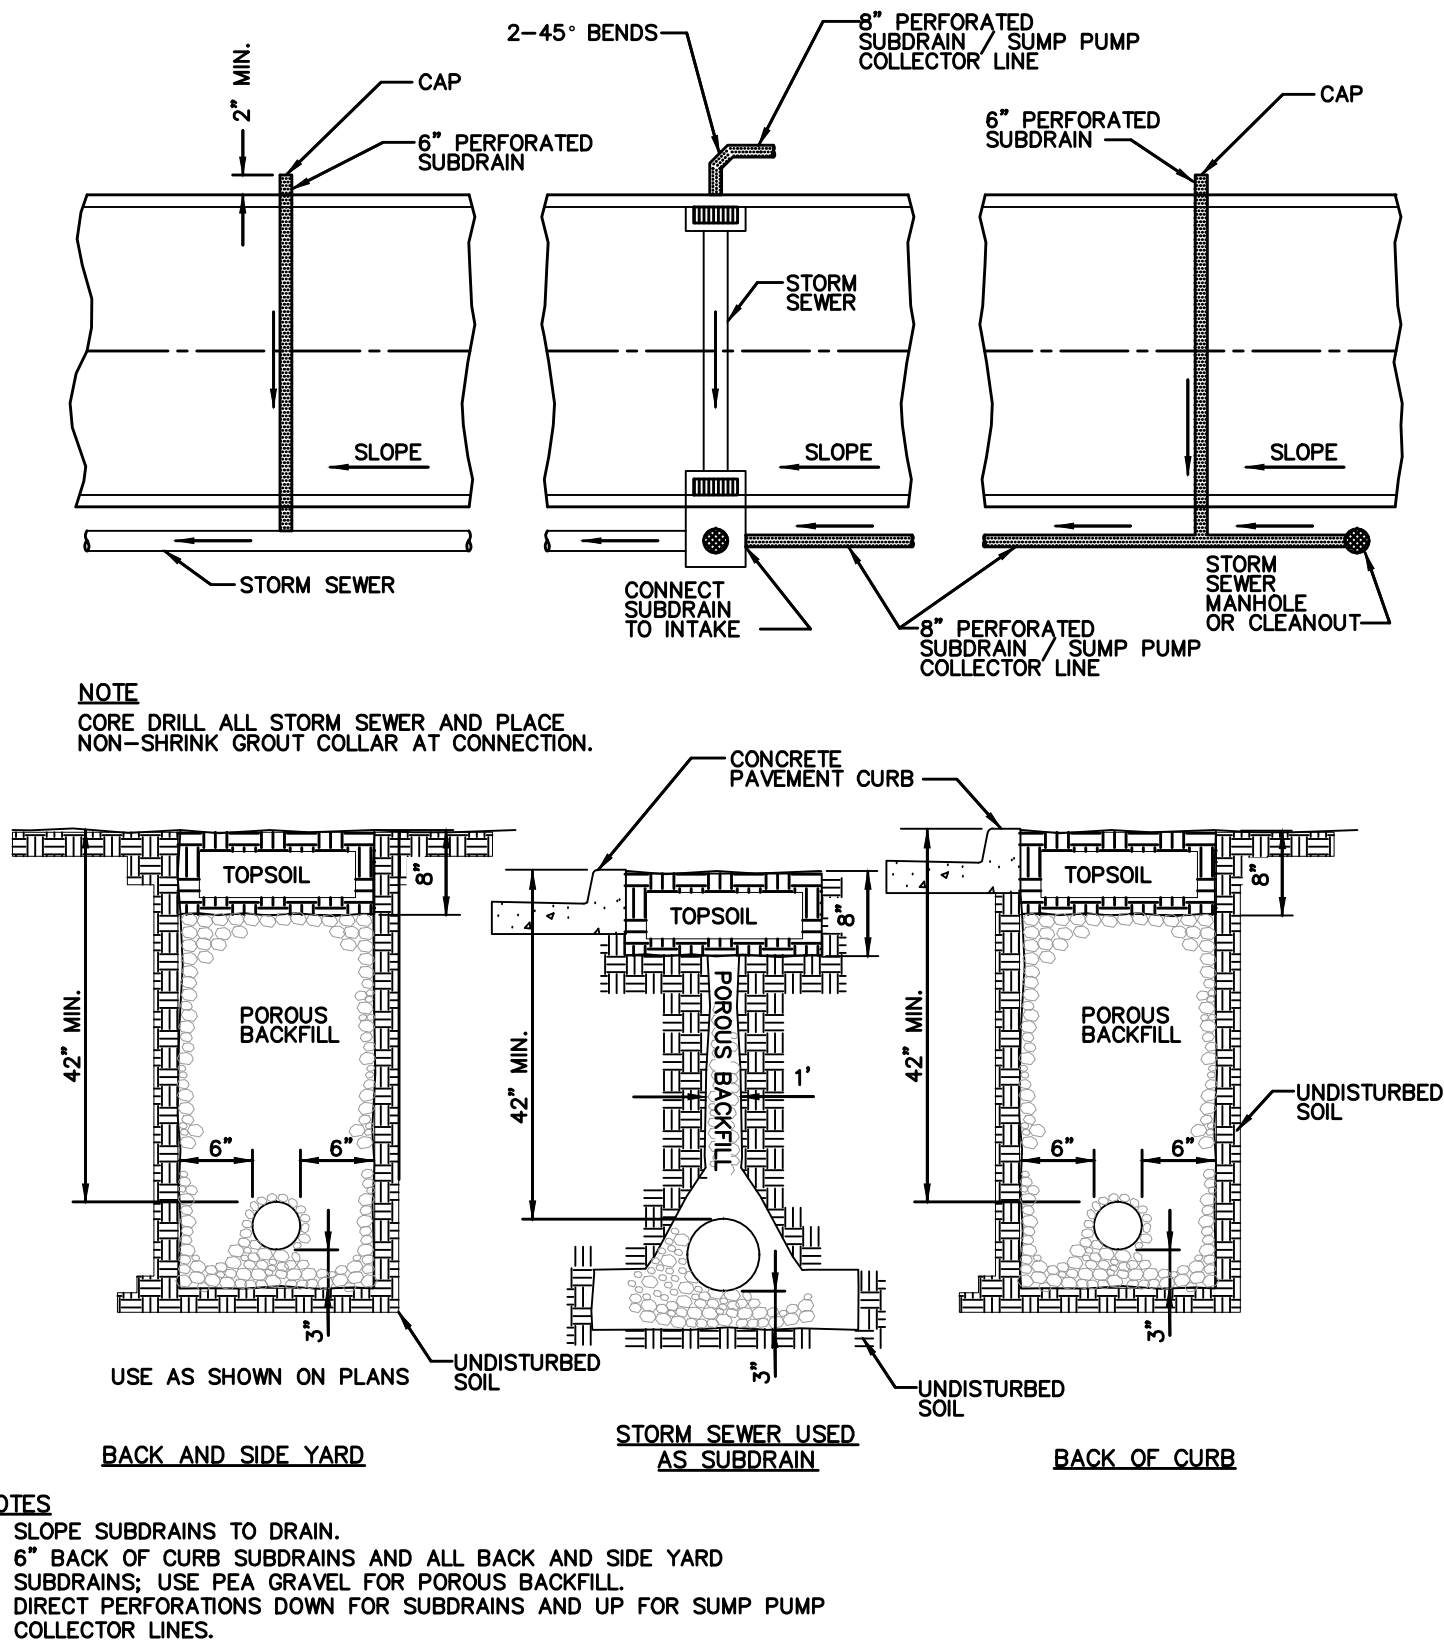


6" PERFORATED SUBDRAIN

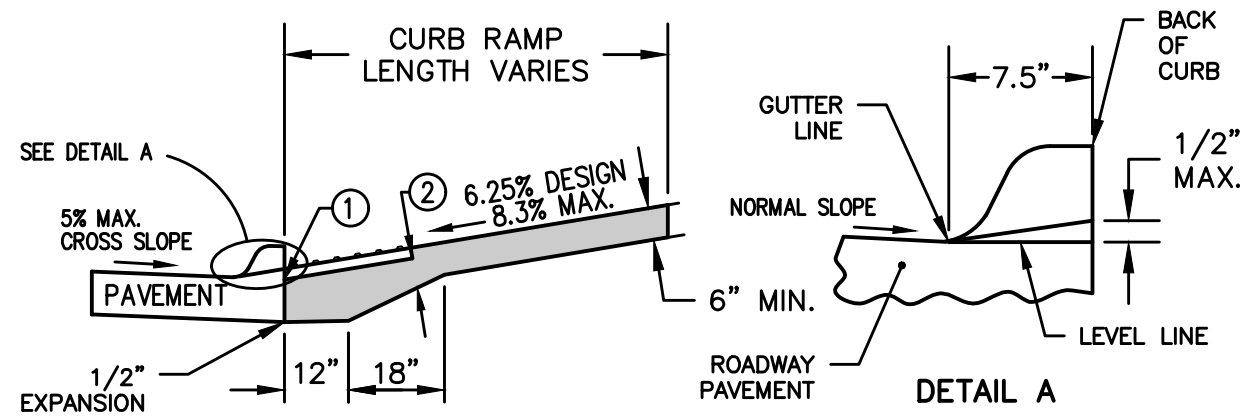


1. INSTALL A 24 INCH WIDE (MIN.) STRIP OF DETECTABLE WARNINGS AT THE BACK OF CURB. EXTEND THE DETECTABLE WARNINGS ACROSS THE FULL WIDTH OF THE RAMP.
2. PROVIDE A MINIMUM OF 8 INCHES OF CONCRETE BELOW THE DETECTABLE WARNING PANEL.


NOTE:
ALL TRUNCATED DOMES SHALL BE CAST IRON.

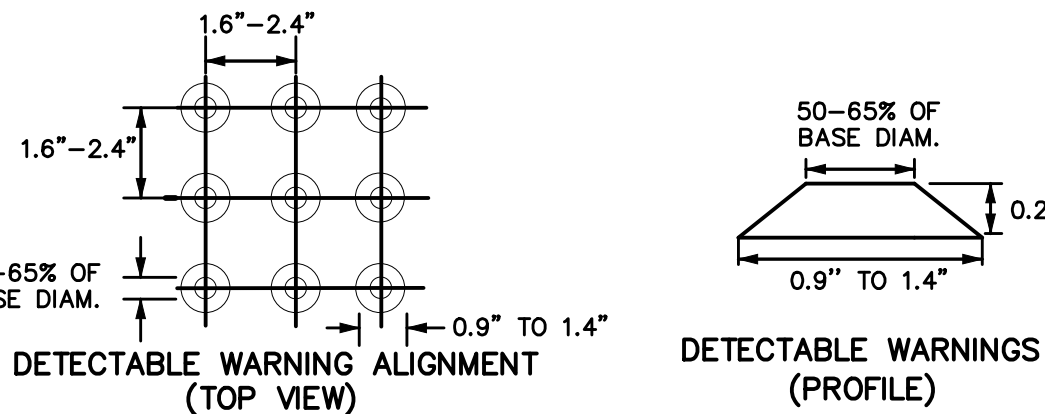

DETECTABLE WARNING DETAIL
NOT TO SCALE

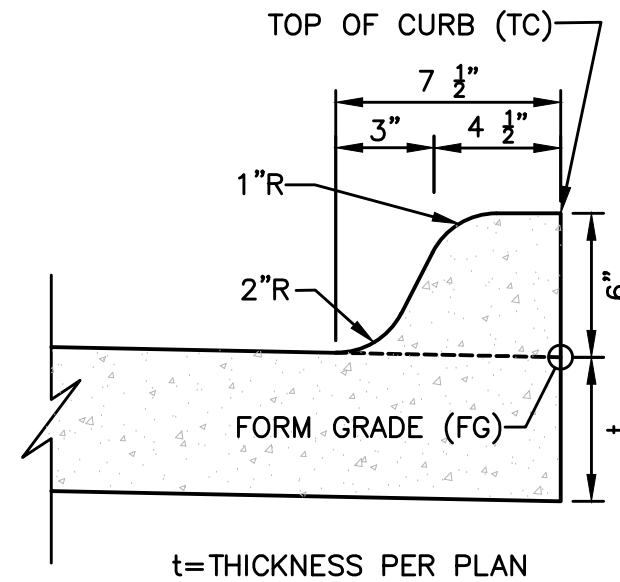


INTEGRAL 6" STANDARD
SPOT ELEVATION
REFERENCE DETAIL
NOT TO SCALE

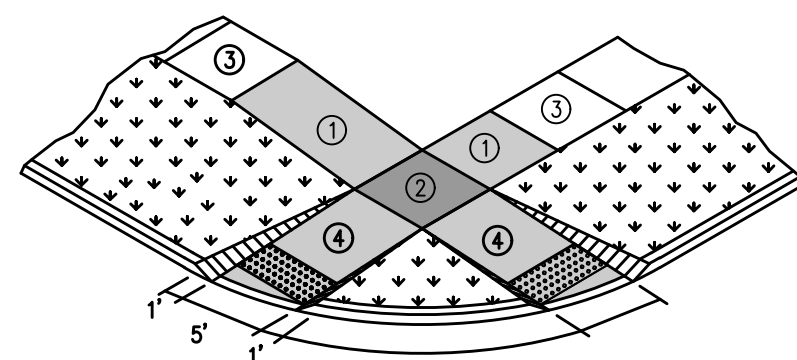

- Key
- CURB RAMP
 - TURNING SPACE
 - DETECTABLE WARNING
1. Parallel Curb Ramp: Target cross slope of 1.5% with a maximum cross slope of 2.0%. The length of the parallel ramp is not to exceed 15 feet, regardless of resulting slope. Do not exceed 8.3% slope for parallel ramps shorter than 15 feet.
 2. Turning Space: Target slope of 1.5% with a maximum slope perpendicular to the travel directions of 2.0%. At mid-block crossings, cross slope of landing may exceed 2.0% to match the roadway grade. Minimum 5 feet by 5 feet.
 3. Target cross-slope of 1.5% with a maximum cross-slope of 2.0%.
 4. Perpendicular curb ramp: Target running slope of 6.25% with maximum running slope of 8.3%. The minimum pavement depth for ramps and landings shall be 6-inches.

CURB RAMPs FOR CLASS
OF CLASS B OR C SIDEWALK
NOT TO SCALE

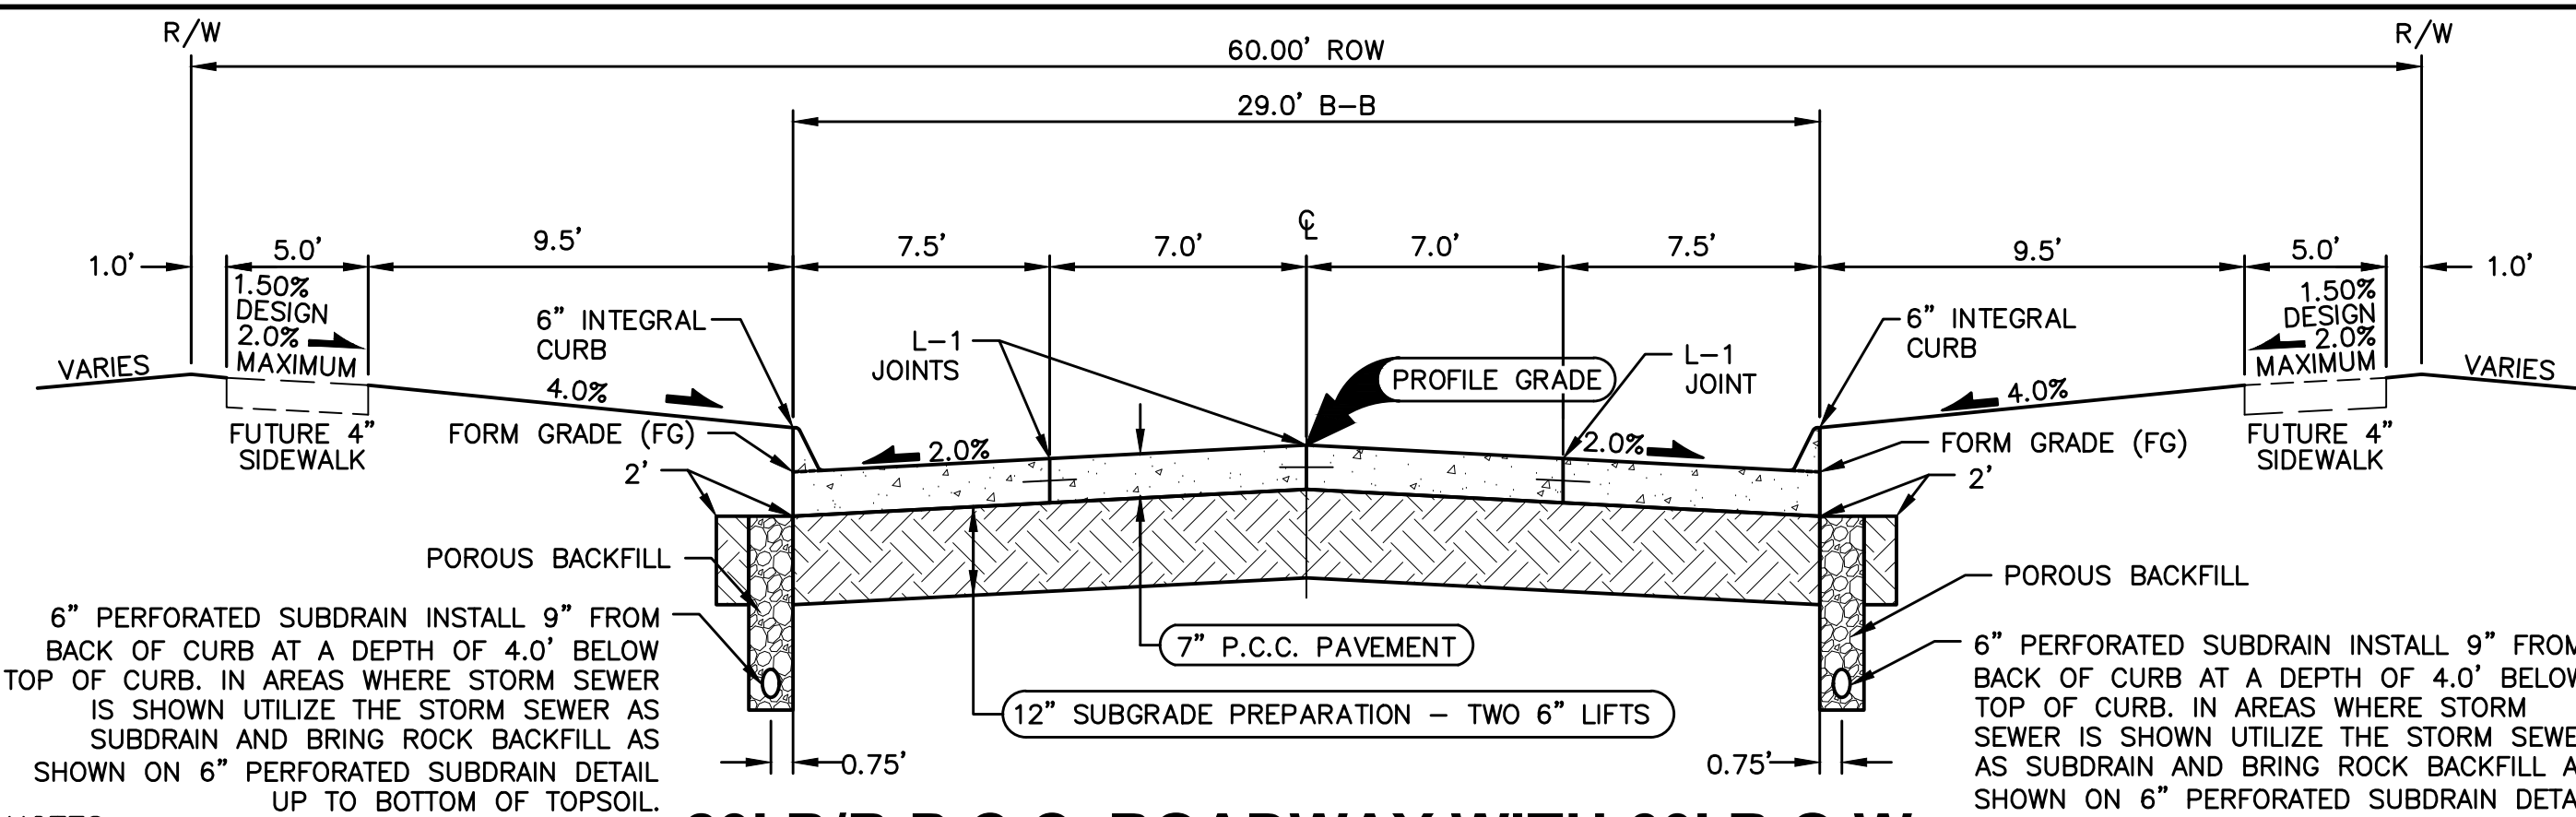


- NOTES:
1. PREPARE SUBGRADE IN 2 - 6" LIFTS.
 2. MAXIMUM C JOINT SPACING IS 15'.


29' B/B P.C.C. ROADWAY WITH 60' R.O.W.
NOT TO SCALE

REVISIONS		DATE
AS-BUILT SUBMITTAL	12/29/2021	
FINAL SUBMITTAL	09/02/2021	
THIRD SUBMITTAL	08/18/2021	
SECOND SUBMITTAL	07/27/2021	
FIRST SUBMITTAL	07/13/2021	

3405 S.E. CROSSROADS DRIVE, SUITE G
GRIMES, IOWA 50111
PHONE: (515) 369-4400 FAX: (515) 369-4410
ENGINEER: EKO
EI:JWM TECH: MST

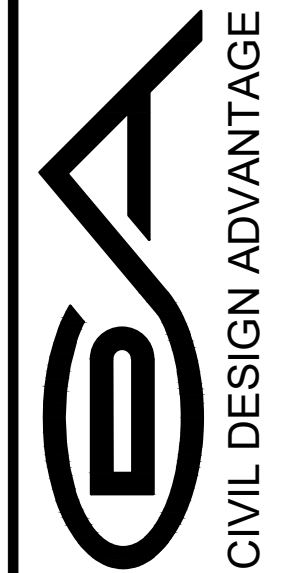

FILE: H:\2021\2106480\DWG\2106480-COV-BET-TAB-AS-BUILD.DWG
COMMENTS: DATE PLOTTED: 12/29/2021 8:38 AM
PLOTTER: HP PLOTTER VENDOR: WATKINS THOMPSON

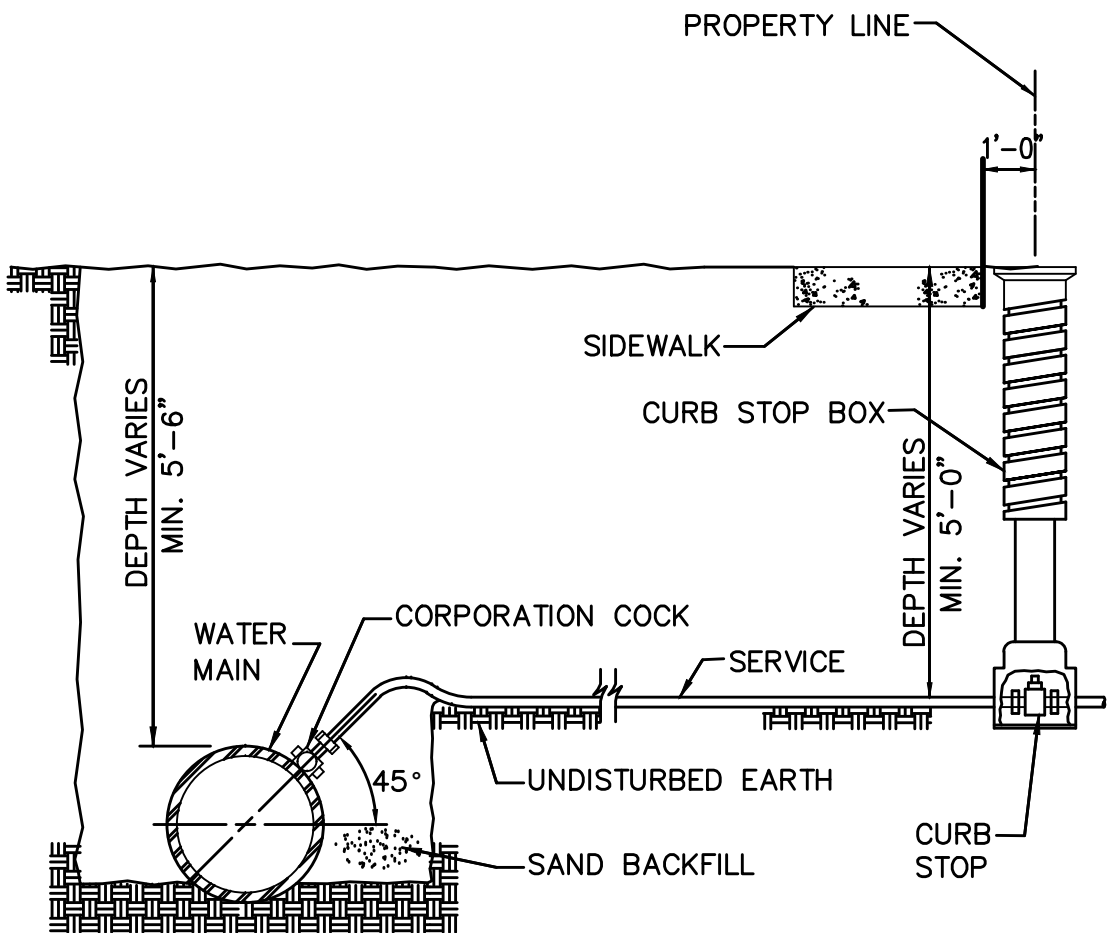


NOTES:

1. TERMINATE CURB STOP BOX ROD 1'-6" BELOW FINISHED GRADE.

WATER SERVICE CONNECTION


NOT TO SCALE

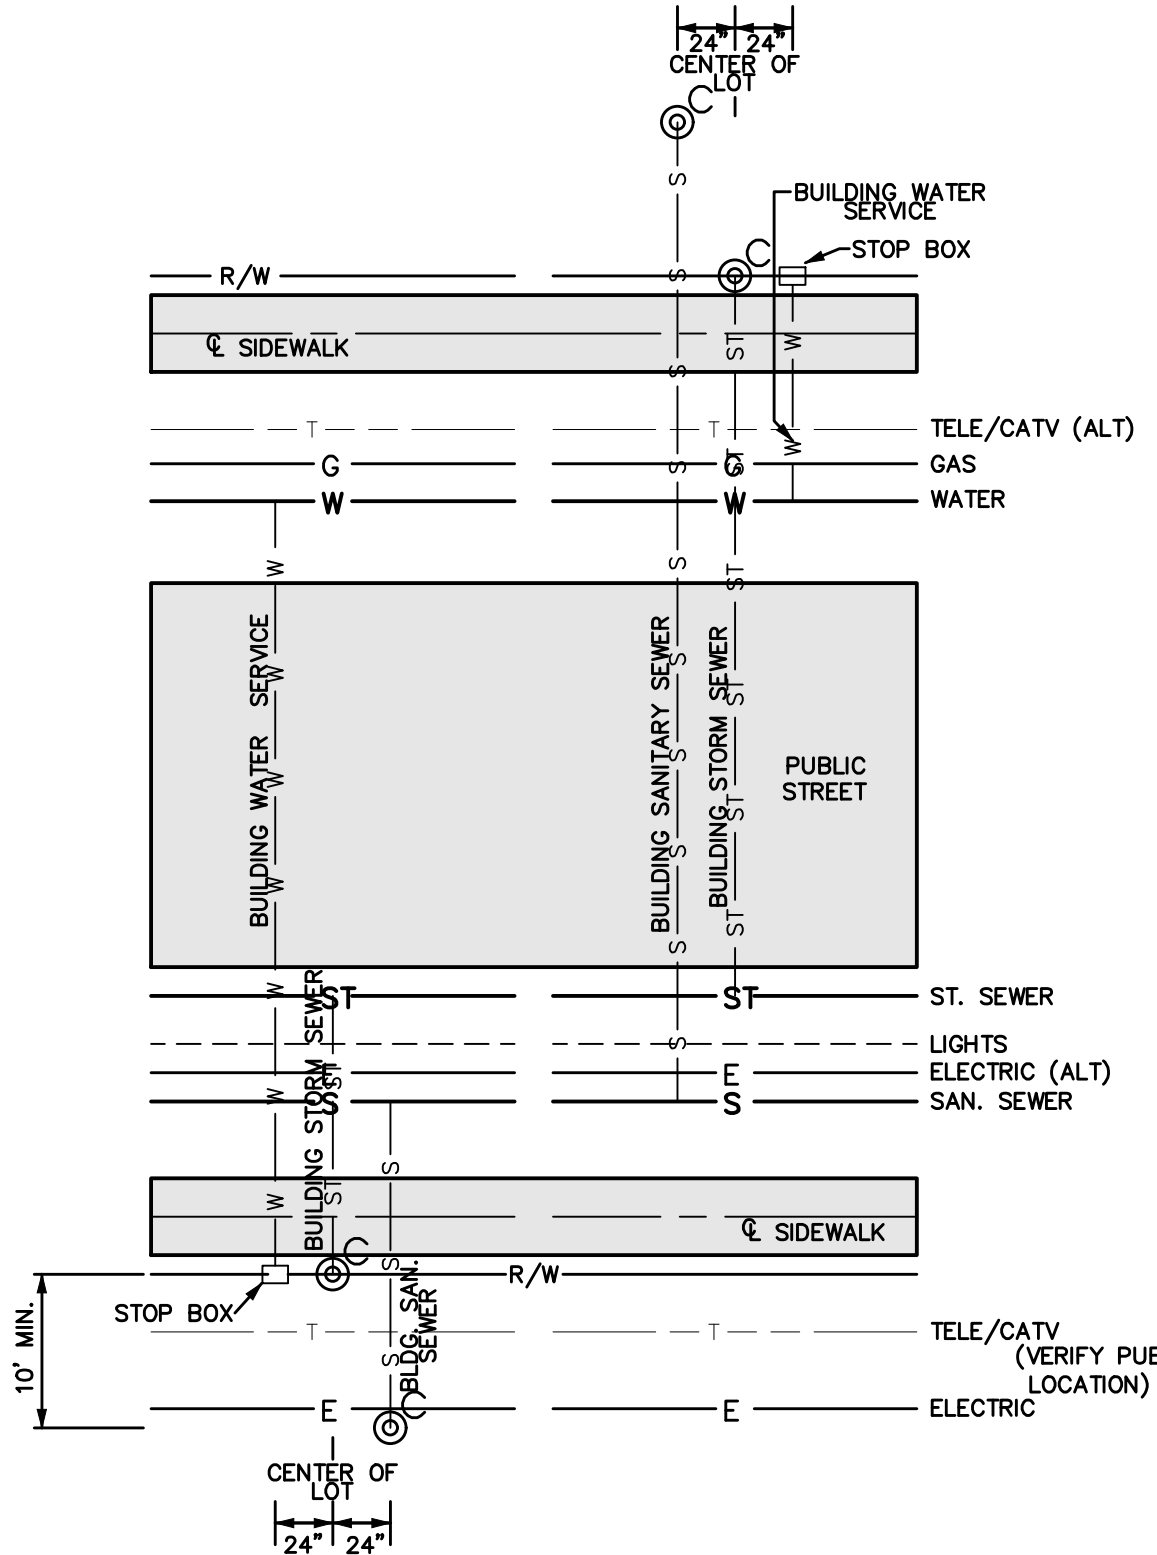

CITY OF WAUKEE
UTILITY SERVICE LOCATIONS


NOT TO SCALE

- NOTES:
1. PLACE ONE 6" STEEL POST BURIED 3' AT WATER CURB BOX. STEEL POST SHALL BE PAINTED BLUE.
 2. BRING SUMP SERVICE STUB TO A MINIMUM OF 1-FOOT ABOVE FINISHED GROUND LEVEL ELEVATION. INSTALL WATER TIGHT CAP ON THE END. PLACE A GREEN PAINTED STEEL POST NEXT TO THE STUB.
 3. BRING SANITARY SERVICE STUB TO A MINIMUM OF 1-FOOT ABOVE FINISHED GROUND LEVEL ELEVATION. INSTALL WATER TIGHT CAP ON THE END. PLACE A RED PAINTED STEEL POST NEXT TO THE STUB.

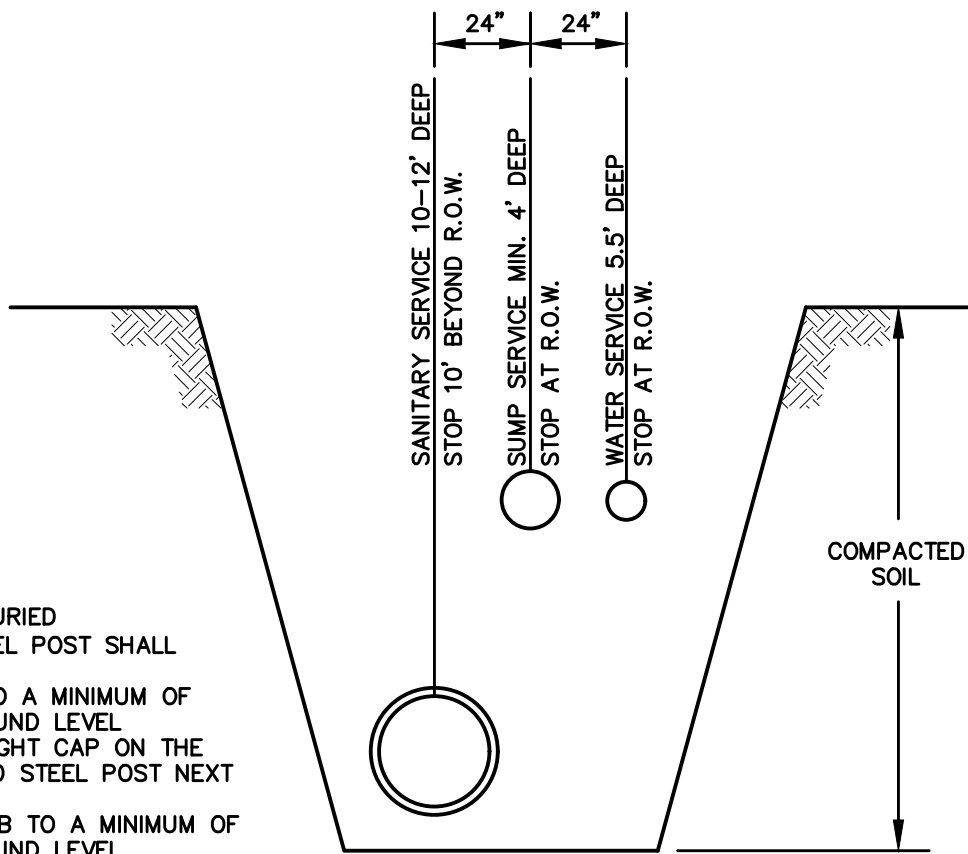

SERVICE LOCATION DETAIL

NOT TO SCALE

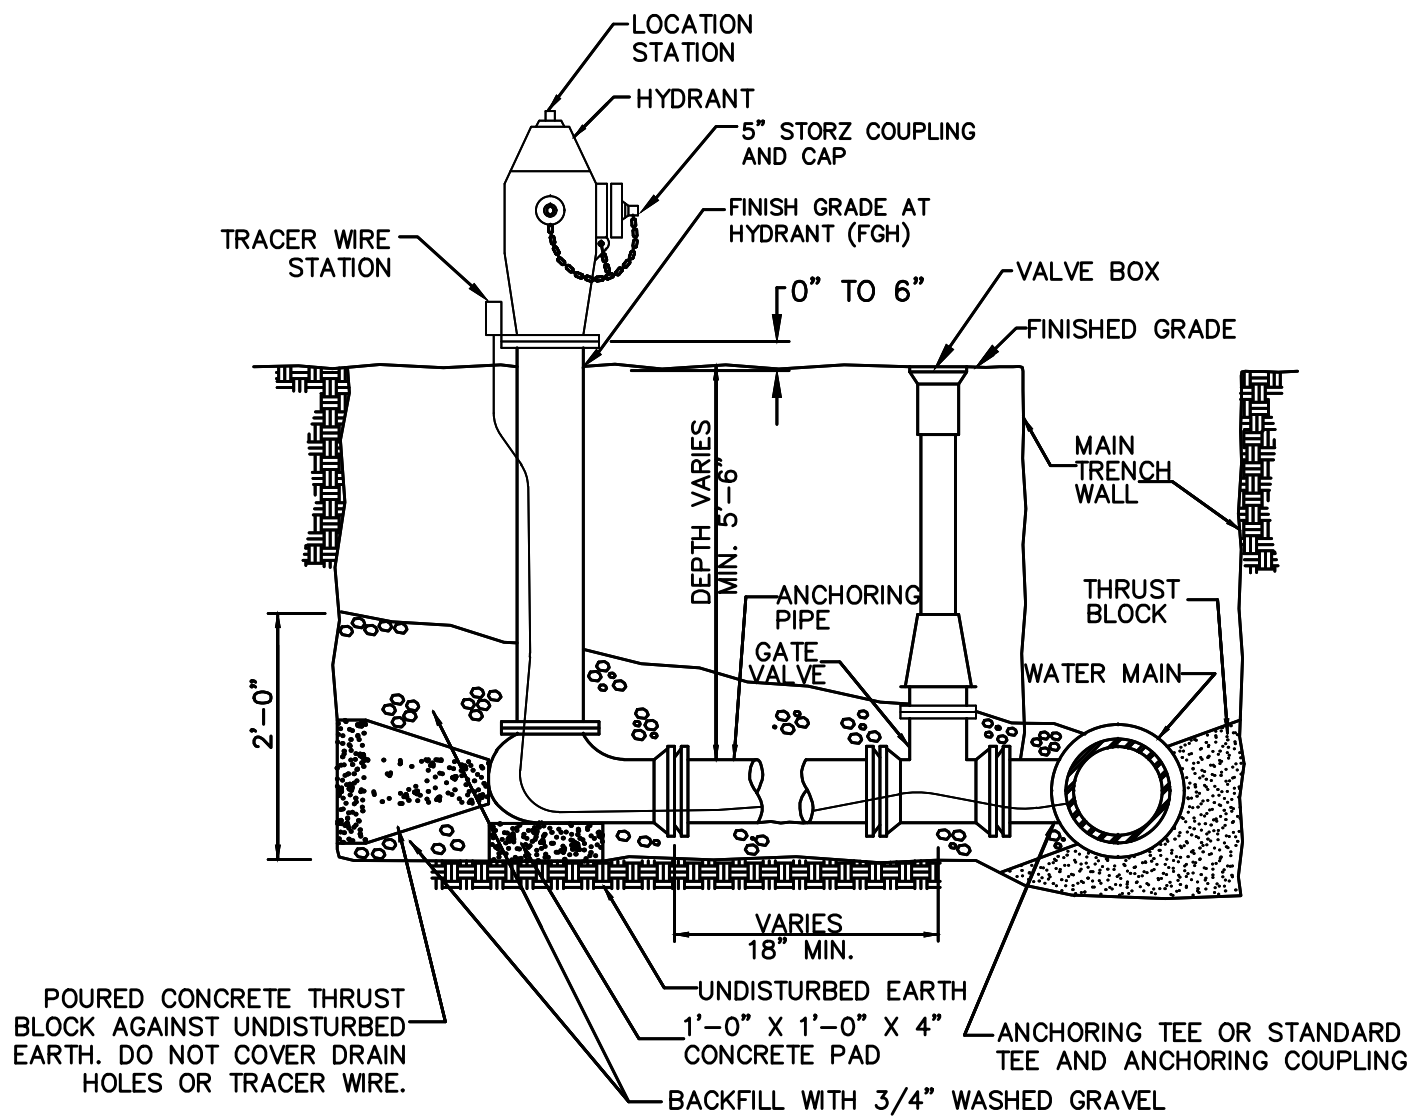


NOTES:

1. MINIMUM SIZE FOR PIPING, VALVES AND FITTINGS FROM WATER MAIN TO HYDRANT INLET: 6"
2. PROVIDE TRACER WIRE AND TRACER WIRE STATION.
3. WRAP HYDRANT, PIPE AND FITTINGS WITH POLYETHYLENE ENCASMENT.

HYDRANT ASSEMBLY DETAIL

NOT TO SCALE

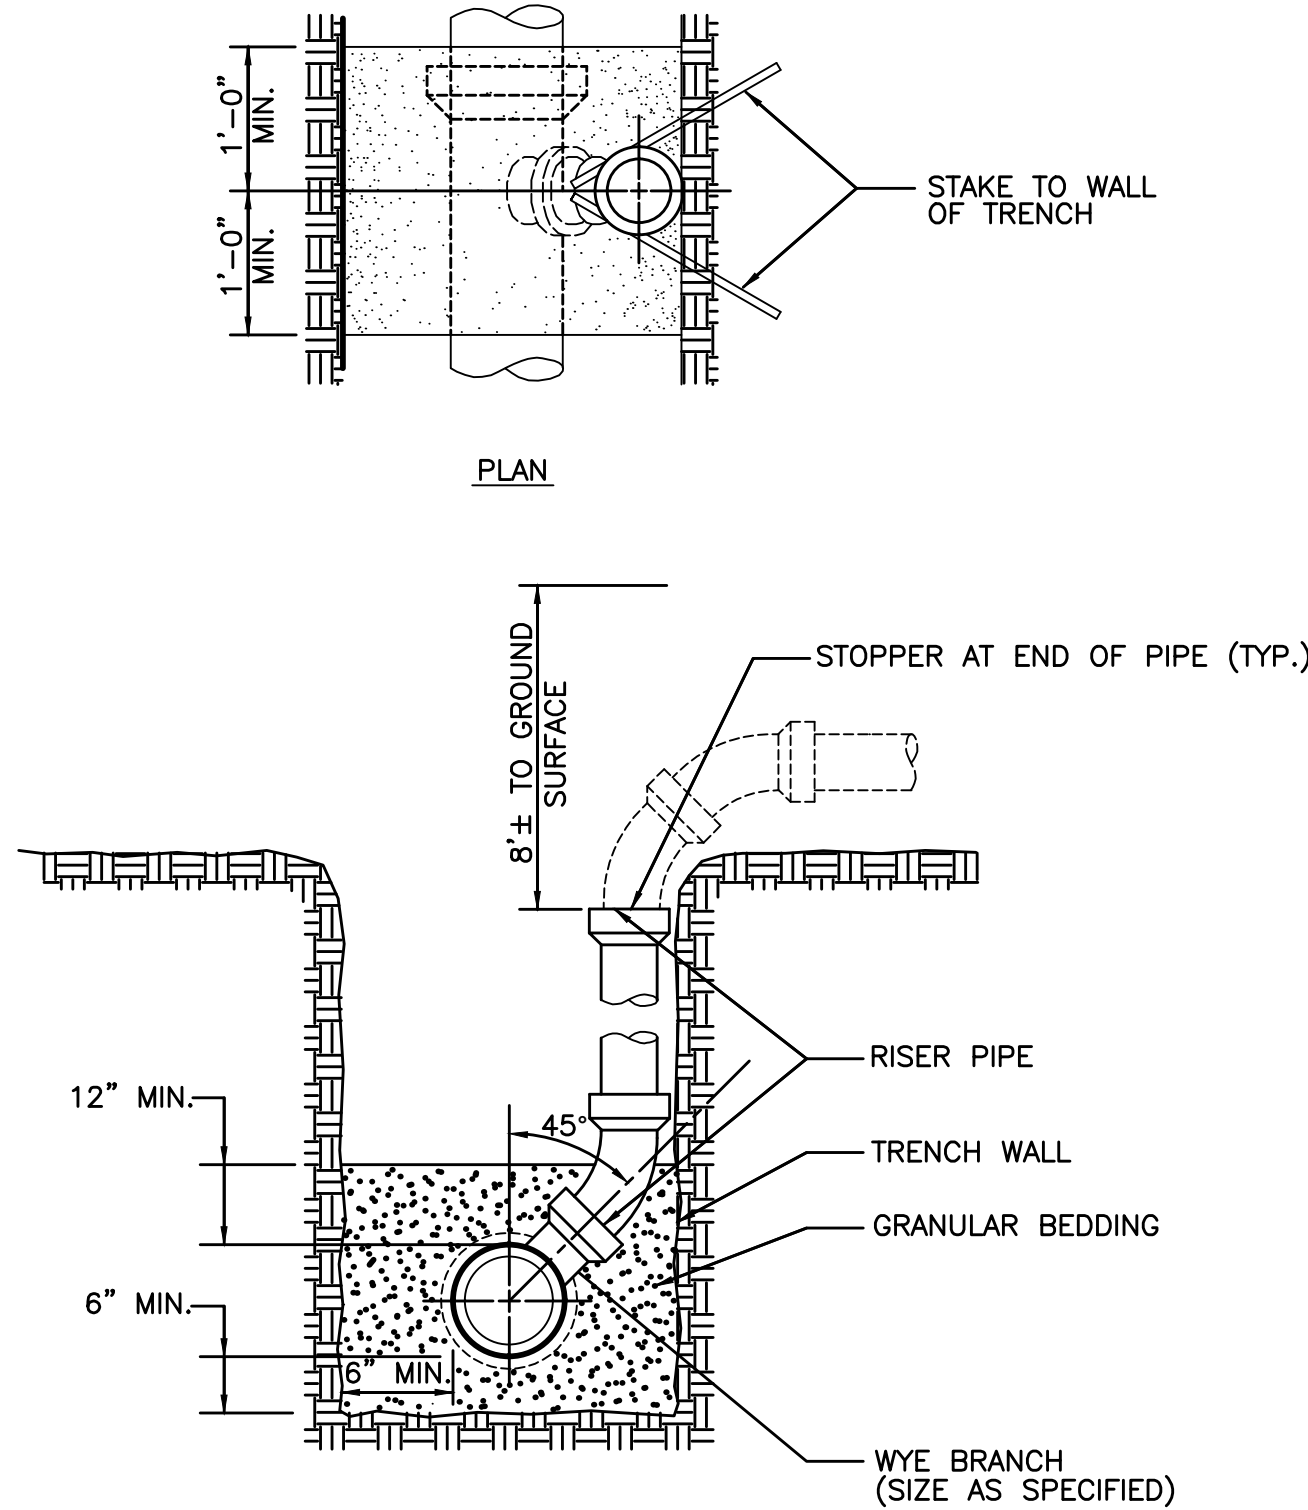

NOTES:

1. INSTALL RISER TO BEAR FIRMLY AGAINST UNDISTURBED WALL OF TRENCH. STAKE RISER PIPE IN PLACE PRIOR TO BACK-FILLING TO PREVENT MOVEMENT OF PIPE
2. NOTCH WALL OF TRENCH TO RECEIVE PIPE WHERE POSSIBLE.

SANITARY SEWER SERVICE RISER

NOT TO SCALE

HAMILTON RIDGE PLAT 7
TYPICAL SECTIONS AND DETAILS

WAUKEE, IOWA



3405 S.E. CROSSROADS DRIVE, SUITE G
GRIMES, IOWA 50111
PHONE: (515) 369-4400 FAX: (515) 369-4410
ENGINEER: EKO

EI:JWM

TECH: MST

REVISIONS

REVISIONS	DATE
AS-BUILT SUBMITTAL	12/29/2021
FINAL SUBMITTAL	09/02/2021
THIRD SUBMITTAL	08/18/2021
SECOND SUBMITTAL	07/27/2021
FIRST SUBMITTAL	07/13/2021

3
11

2106.480

FILE: H:\2021\2106480\DWG\2106480-COV-BET-TAB-AS-BUILD.DWG
DATE PLOTTED: 12/29/2021 8:38 AM
PLOTTER: HP PLOTTER
DRAWN BY: MATTHEW THOMPSON
CHECKED BY: ENG.

GENERAL NOTES

1.

ALL CONSTRUCTION SHALL CONFORM TO THE 2020 CITY OF WAUKEE STANDARD SPECIFICATIONS FOR PUBLIC IMPROVEMENTS AND TO THE 2021 EDITION OF SUDAS STANDARD SPECIFICATIONS. THE WAUKEE STANDARD SPECIFICATIONS SHALL GOVERN IF ANY DISCREPANCIES.
2.

WHERE PUBLIC UTILITY FIXTURES ARE SHOWN AS EXISTING ON THE PLANS OR ENCOUNTERED WITHIN THE CONSTRUCTION AREA, IT SHALL BE THE RESPONSIBILITY OF THE CONTRACTOR TO NOTIFY THE OWNERS OF THOSE UTILITIES PRIOR TO THE BEGINNING OF ANY CONSTRUCTION. THE CONTRACTOR SHALL AFFORD ACCESS TO THESE FACILITIES FOR NECESSARY MODIFICATION OF SERVICES. UNDERGROUND FACILITIES, STRUCTURES AND UTILITIES HAVE BEEN PLOTTED FROM AVAILABLE SURVEYS AND RECORDS, AND THEREFORE, THEIR LOCATIONS MUST BE CONSIDERED APPROXIMATE ONLY. IT IS POSSIBLE THERE MAY BE OTHERS, THE EXISTENCE OF WHICH IS PRESENTLY NOT KNOWN OR SHOWN. IT IS THE CONTRACTORS RESPONSIBILITY TO DETERMINE THEIR EXISTENCE AND EXACT LOCATIONS AND TO AVOID DAMAGE THERETO. NO CLAIMS FOR ADDITIONAL COMPENSATION WILL BE ALLOWED TO THE CONTRACTOR FOR ANY INTERFERENCE OR DELAY CAUSED BY SUCH WORK.
3.

THE CONTRACTOR IS REQUIRED TO UTILIZE THE UTILITY ONE-CALL SERVICE AT 800-292-8989 AT LEAST 48 HOURS PRIOR TO EXCAVATING ANYWHERE ON THE PROJECT.
4.

THE CONTRACTOR IS RESPONSIBLE FOR REPLACING ANY AREAS OF PAVEMENT OR SIDEWALK NOT TO BE REMOVED THAT IS DAMAGED DUE TO OPERATING HIS EQUIPMENT ON THE PAVEMENT OR SIDEWALK. PAVEMENT REPLACEMENT SHALL COMPLY WITH THE WAUKEE STANDARD SPECIFICATIONS FOR PUBLIC IMPROVEMENTS.
5.

THE GENERAL CONTRACTOR SHALL BE RESPONSIBLE FOR THE COORDINATION OF WORK BETWEEN ALL SUPPLIERS AND SUBCONTRACTORS INVOLVED IN THE PROJECT, INCLUDING STAGING OF CONSTRUCTION DETAILS.
6.

THE CONTRACTOR SHALL CONFINE HIS GRADING OPERATIONS TO WITHIN THE PROPOSED AND EXISTING RIGHT OF WAY, CONSTRUCTION LIMITS AND EASEMENTS SHOWN ON THE PLANS. ANY DAMAGE TO PROPERTIES OUTSIDE THE SITE BOUNDARY SHALL BE THE SOLE RESPONSIBILITY OF THE CONTRACTOR.
7.

PRIOR TO CONSTRUCTION, CONTRACTOR SHALL NOTIFY (48 HRS NOTICE) THE FOLLOWING:

A. CITY OF WAUKEE ENGINEERING DEPARTMENT

B. APPROPRIATE UTILITY COMPANIES

C. OWNER

D. CIVIL DESIGN ADVANTAGE
- *

48 HOUR NOTICE SHALL BE GIVEN TO THE CITY OF WAUKEE ENGINEERING DEPARTMENT PRIOR TO WEEKEND AND HOLIDAY WORK.
8.

PRIOR TO CONSTRUCTION, THE PROJECT MANAGER SHALL CONTACT THE WAUKEE ENGINEERING DEPARTMENT AND SCHEDULE A PRE-CONSTRUCTION MEETING AT LEAST ONE WEEK PRIOR TO THE ANTICIPATED START OF CONSTRUCTION.
9.

SPECIAL CARE SHALL BE TAKEN WHEN FORMING AT INTERSECTIONS SO THE PROFILES SHOWN ON THE PLANS AND THE ELEVATIONS SHOWN ON THE INTERSECTION DETAILS ARE OBTAINED. SHORT LENGTHS OF FORMS OR FLEXIBLE FORMS MAY BE NECESSARY AT THESE LOCATIONS.

ESTIMATE REFERENCE INFORMATION	
Data listed below is for informational purpose only and shall not constitute a basis for any extra work orders.	
ITEM NO.	DESCRIPTION
	THE 2020 EDITION OF THE CITY OF WAUKEE STANDARD SPECIFICATIONS FOR PUBLIC IMPROVEMENTS AND THE 2021 EDITION OF SUDAS STANDARD SPECIFICATIONS SHALL APPLY TO ALL WORK PERFORMED ON THIS PROJECT EXCEPT AS MODIFIED HEREIN.
	ALL REFERENCES TO SECTIONS AND FIGURES ARE TO THE SUDAS STANDARD SPECIFICATIONS. CITY OF WAUKEE STANDARD DETAILS SHALL GOVERN IF ANY DISCREPANCIES.
1	CLEAR AND GRUB ALL AREAS AFFECTED BY GRADING OPERATIONS. THE CONTRACTOR SHALL FIELD VERIFY CLEARING AND GRUBBING NEEDS PRIOR TO BIDDING. INCLUDES REMOVAL OF ANY EXISTING FIELD FENCE. ALL MATERIAL THAT IS REMOVED FROM THE PROJECT SHALL BECOME THE PROPERTY OF THE CONTRACTOR. INCLUDED REMOVAL OF EXISTING CROPS FOR CONSTRUCTION OF TEMPORARY ACCESS. DO NOT DISTURB CROPS OUTSIDE OF THE PROJECT LIMITS. AREA SHOWN FOR REFERENCE ONLY.
2	STRIP, SALVAGE AND RE-SPREAD TOPSOIL PER SECTION 2010 OF SUDAS STANDARD SPECIFICATIONS OR PROVIDE THE CITY WITH A TOPSOIL PRESERVATION PLAN. TOPSOIL TO BE RESPREAD SHALL BE FREE OF ROCK AND DEBRIS AND BE SUITABLE FOR THE GROWTH OF GRASS. COORDINATE LOCATION OF STOCKPILE WITH OWNER.
3	EXCAVATION INCLUDES ALL WORK NECESSARY TO ACHIEVE PROPER GRADES AS SHOWN IN THE PLANS. NO PAYMENT FOR OVERHAUL SHALL BE ALLOWED.
4	REFER TO SHEET 2 FOR TYPICAL LOCATIONS AND THICKNESS.
5	SANITARY SEWER SHALL BE PVC TRUSS PIPE. ANY CONNECTIONS TO EXISTING SANITARY SEWER SHALL BE CONSIDERED INCIDENTAL. REFER TO FIG. 3010.101 AND 3010.103 FOR PIPE EMBEDMENT DETAILS. GRANULAR PIPE BEDDING SHALL BE CONSIDERED INCIDENTAL. EXISTING SANITARY SEWER WILL NEED TO BE RETESTED AFTER SADDLE WYE INSTALLATION.
8-10	REFER TO FIGURE 3010.102 FOR TRENCH BEDDING AND BACKFILL ZONE DETAILS. GRANULAR PIPE BEDDING SHALL BE CONSIDERED INCIDENTAL. CONNECTIONS TO EXISTING STORM SEWER PIPE AND STRUCTURES SHALL BE CONSIDERED INCIDENTAL. WRAP ALL PIPE JOINTS IN ENGINEERING FABRIC. CLEAN AND TELEWISE SANITARY AND STORM SEWER PRIOR TO PAVING AND PROVIDE TELEVISING REPORT TO CITY IN HARD COPY AND DISC FORMAT. TELEVISING SHALL BE CONSIDERED INCIDENTAL. ALL STORM SEWER PIPE THAT CROSSES OVER WATERMAIN SHALL HAVE O-RING GASKETS JOINT RATED AT 13 PSI OR GREATER. O-RING GASKET JOINTS SHALL BE INSTALLED ON EACH SIDE OF THE CROSSING UNTIL THE NORMAL DISTANCE FROM THE WATER TO THE SEWER IS AT LEAST 10 FEET.
6,11,13	REFER TO DETAILS ON SHEETS 2, 3 AND PLAN AND PROFILE SHEETS FOR LOCATION AND DEPTH. STORM SEWER SERVICES TYING INTO EXISTING RCP PIPE ARE TO BE CORE DRILLED. BRINGING STORM AND SANITARY SERVICES TO GROUND LEVEL, PLACING A WATERTIGHT CAP AND INSTALLING A POST SHALL BE CONSIDERED INCIDENTAL TO THIS BID ITEM.
12-13	REFER TO FIG. 3010.101 AND FIG. 3010.104 FOR TRENCH BEDDING AND BACKFILL ZONE DETAILS. GRANULAR PIPE BEDDING SHALL BE CONSIDERED INCIDENTAL. REFER TO FIG. 5010.101 FOR THRUST BLOCK DETAILS. REFER TO FIG. 5010.102 FOR TRACER SYSTEM DETAILS. ALL FITTINGS, POLYETHYLENE WRAP, THRUST BLOCKS, AND TRACER WIRE SYSTEM SHALL BE CONSIDERED INCIDENTAL.
14-15	REFER TO FIG. 5020.201 - FIRE HYDRANT ASSEMBLY FOR FIRE HYDRANT CONSTRUCTION DETAILS. INCLUDES ANCHORING TEE, ANCHORING ELBOW, GATE VALVE, VALVE BOX, ANCHORING PIPE, ANCHORING COUPLING, ELBOWS, 5" STORZ FITTINGS, POLYETHYLENE WRAP, THRUST BLOCK AND TRACER WIRE SYSTEM AND FIRE HYDRANT.
14-15	REFER TO WATERMAIN PLAN AND PROFILE SHEETS FOR LOCATIONS OF HYDRANTS. ANY RELOCATED FIRE HYDRANTS ARE TO INCLUDE 5-INCH STORZ FITTINGS.
16	REFER TO FIG.6010.301 - CIRCULAR SANITARY SEWER MANHOLE (SW-301) FOR CONSTRUCTION DETAILS. CASTINGS IN PAVEMENT SHALL BE TYPE B RING AND COVER. WHEN CASTINGS ARE NOT IN PAVEMENT, INSTALL MANHOLE CONE SECTION, MANHOLE STEPS, AND RING/COVER CASTING SUCH THAT SEPARATION IS MAINTAINED BETWEEN MANHOLE COVERS AND PAVED AREAS (BACK OF CURB, SIDEWALK PAVEMENT, SIDEWALK APPROACHES/RAMPS). ALL SANITARY SEWER MANHOLES SHALL BE VACUUM TESTED.

ESTIMATE REFERENCE INFORMATION	
Data listed below is for informational purpose only and shall not constitute a basis for any extra work orders.	
ITEM NO.	DESCRIPTION
17-20	REFER TO FIG. 6010.514 - BOXOUTS FOR GRATE INTAKES. REFER TO FIG. 6010.603 - CASTINGS FOR GRATE INTAKES FOR TYPE R GRATE DETAILS AND FIG. 6010.602 - CASTINGS FOR STORM SEWER MANHOLES FOR TYPE E CASTING DETAILS. THE MAXIMUM HEIGHT OF ADJUSTING RINGS ALLOWED FOR INTAKE CASTINGS IS 6". THE MAXIMUM HEIGHT OF ADJUSTING RINGS ALLOWED FOR MANHOLE CASTINGS IS 12".
17	REFER TO FIG. 6010.501 - SINGLE GRATE INTAKE (SW-501) FOR CONSTRUCTION DETAILS.
18	REFER TO FIG. 6010.503 - SINGLE GRATE INTAKE WITH MANHOLE (SW-503) FOR CONSTRUCTION DETAILS.
19	REFER TO FIG. 6010.505 - DOUBLE GRATE INTAKE (SW-505) FOR CONSTRUCTION DETAILS.
21	REFER TO FIG. 7010.101 - JOINTS (PV-101) FOR JOINT DETAILS. MAXIMUM C AND CD JOINT SPACING IS 15 FEET.
22	THE SITE SEEDING SHALL CONFORM TO THE SPECIFICATION FOR TYPE (1) PERMANENT LAWN MIXTURE AND TYPE (4) URBAN TEMPORARY EROSION CONTROL SEED MIXTURE. SEEDING QUANTITIES -TYPE 1 PERMANENT LAWN MIXTURE = 0.26 AC -TYPE 4 URBAN TEMPORARY EROSION CONTROL MIXTURE = 3.36 AC
23	REFER TO PLAN AND PROFILE SHEETS FOR LOCATIONS. REFER TO IDOT STANDARD ROAD PLAN SI-182 FOR CONSTRUCTION DETAILS. EACH LOCATION CONSISTS OF FIVE SIGNS WITH POSTS PER SI-182.
24	ALL TRAFFIC CONTROL SHALL BE IN ACCORDANCE WITH THE LATEST EDITION OF THE MANUAL ON TRAFFIC CONTROL DEVICES. THE CONTRACTOR SHALL INSTALL AND MAINTAIN ROAD BARRICADES AT END OF EXISTING PAVEMENTS UNTIL THE PROJECT IS ACCEPTED. THE MESSAGE BOARD WILL BE REQUIRED AT LEAST 1 WEEK IN ADVANCE OF ANY LANE CLOSURES.
25	REFER TO SHEET 7 OF THE CONSTRUCTION DRAWINGS FOR EROSION AND SEDIMENT CONTROLS. REFER TO SEPARATE STORM WATER POLLUTION PREVENTION PLAN (SWPPP) FOR SPECIFIC DETAILS.

10.

TO OBTAIN THE CORRECT FORM GRADES AT LOW POINTS WHERE INTAKES ARE LOCATED, THE CONTRACTOR MUST EXERCISE ADDITIONAL CARE WHEN PAVING FULL WIDTH PAVEMENTS. THIS MAY REQUIRE POURING ONE HALF OF THE PAVEMENT AT A TIME OR OTHER METHODS APPROVED BY THE ENGINEER.
11.

THE CONTRACTOR MAY BE REQUIRED AS DIRECTED BY THE ENGINEER OR THE CITY, TO PLACE TEMPORARY WARNING DEVICES AND SAFETY FENCE AT CERTAIN LOCATIONS WHERE REPLACEMENT FEATURES ARE NOT INSTALLED THE SAME DAY. THIS SHALL BE INCIDENTAL TO THE BID ITEM TRAFFIC CONTROL. THE CONTRACTOR SHALL INSTALL AND MAINTAIN ROAD BARRICADES AT END OF EXISTING PAVEMENTS UNTIL THE PROJECT IS ACCEPTED.
12.

PLAN AND PROFILE SHEETS INCLUDED IN THE PROJECT ARE FOR THE PURPOSE OF ALIGNMENT, LOCATION AND SPECIFIC DIRECTIONS FOR WORK TO BE PERFORMED UNDER THIS CONTRACT. IRRELEVANT DATA ON THESE SHEETS IS NOT TO BE CONSIDERED A PART OF THIS CONTRACT.
13.

THE CONTRACTOR SHALL APPLY NECESSARY MOISTURE TO THE CONSTRUCTION AREA AND HAUL ROADS TO PREVENT THE SPREAD OF DUST.
14.

THE CONTRACTOR IS REQUIRED TO BE FAMILIAR WITH AND COMPLY WITH OSHA STANDARDS. NOTHING WITHIN THESE PLANS SHALL RELIEVE THE CONTRACTOR OF THIS REQUIREMENT.
15.

ALL MATERIAL TESTING SHALL BE CONSIDERED INCIDENTAL TO OTHER CONSTRUCTION.
16.

PRIOR TO ANY WORK AT THE SITE, CONTRACTOR SHALL EXAMINE ANY APPLICABLE DRAWINGS AVAILABLE FROM THE OWNER, ENGINEER, AND/OR ARCHITECT, AND CONSULT WITH OWNER'S PERSONNEL AND UTILITY COMPANY REPRESENTATIVES. NO COMPENSATION WILL BE ALLOWED FOR DAMAGE FROM FAILURE TO COMPLY WITH THIS REQUIREMENT.
17.

ALL TRAFFIC CONTROL SHALL BE IN ACCORDANCE WITH THE LATEST EDITION OF THE MANUAL ON UNIFORM TRAFFIC CONTROL DEVICES (MUTCD).
18.

ALL SLOPES IN PAVEMENT SHALL BE UNIFORM TO AVOID PONDING.
19.

SIDEWALKS, ACCESSIBLE CURB RAMPS AND SIDEWALK RAMPS INCLUDING RAISED TRUNCATED DOME AND DETECTABLE WARNINGS AND WARNING PANELS SHALL BE DESIGNED AND INSTALLED TO THE LATEST P.R.O.W.A.G. AND A.D.A. REQUIREMENTS.
20.

PLACE 3/4" EXPANSION JOINT BETWEEN ALL P.C.C. PAVEMENT/SIDEWALKS AND BUILDINGS. PLACE 1/2" EXPANSION JOINT BETWEEN SIDEWALKS AND P.C.C PAVEMENT. THE PCC RAMP JOINT LOCATED AT THE BACK OF CURB AND ALL EXPANSION JOINTS SHALL BE SEALED.
21.

REMOVE DEBRIS SPILLED INTO R.O.W. AT THE END OF EACH WORK DAY AND BEFORE RAIN EVENTS.
22.

DO NOT STORE CONSTRUCTION MATERIALS AND EQUIPMENT IN THE R.O.W.
23.

ALL PROPERTY PINS SHALL BE PROTECTED FROM GRADING OR OTHER OPERATIONS. ANY PINS DISTURBED SHALL BE RESET AT THE CONTRACTOR'S EXPENSE.
24.

IN THE EVENT OF A DISCREPANCY BETWEEN DETAILED PLANS AND QUANTITIES, THE DETAILED PLANS SHALL GOVERN.

25.

ALL FIELD TILES ENCOUNTERED SHALL BE REPAIRED AND CONNECTED TO STORM SEWERS WHERE POSSIBLE. LOCATIONS SHALL BE PROVIDED TO THE ENGINEER FOR NOTATION ON AS-BUILTS.
26.

ALL CONSTRUCTION STAKING TO BE COMPLETED UNDER THE DIRECTION OF A LICENSED ENGINEER OR LAND SURVEYOR. ALL CURB DROPS AND SIDEWALK/SHARED USE PATH SHALL ALSO BE STAKED UNDER THE DIRECTION OF A LICENSED ENGINEER OR LAND SURVEYOR
27.

THE CONTRACTOR SHALL SUBMIT A LIST OF CONSTRUCTION MATERIALS TO THE CITY OF WAUKEE ENGINEERING DEPARTMENT PRIOR TO CONSTRUCTION.
28.

A GEOTECHNICAL ENGINEER SHALL BE ONSITE DURING CONSTRUCTION AND FOR PROOF ROLLING TO INSPECT SOILS. IT IS THE CONTRACTOR'S RESPONSIBILITY TO ENSURE THE GEOTECHNICAL ENGINEER IS PRESENT. A COPY OF ALL REPORTS AND FINDINGS REQUIRING ALTERATION FROM THE APPROVED PLAN SET IS TO BE PROVIDED TO THE WAUKEE ENGINEERING DEPARTMENT FOR REVIEW AND DISCUSSION PRIOR TO COMMENCING WITH PAVING WITHIN THE PROJECT.
29.

THE CONTRACTOR SHALL COORDINATE ALL EXISTING PUBLIC UTILITY CONNECTIONS WITH THE CITY OF WAUKEE ENGINEERING DEPARTMENT.
30.

ALL TESTING SHALL BE COMPLETED ACCORDING TO THE CITY OF WAUKEE STANDARD SPECIFICATIONS FOR PUBLIC IMPROVEMENTS AND THE WAUKEE ENGINEERING DEPARTMENT SHALL BE PRESENT TO WITNESS ALL TESTING.
31.

AS-BUILTS SHALL BE PROVIDED TO THE WAUKEE ENGINEERING DEPARTMENT INCLUDING ALL UTILITIES AND AS-BUILT GRADES FOR DRAINAGE SWALES, OVERFLOWS, ACCESSIBLE RAMPS AND DETENTION FACILITIES. THE CONTRACTOR SHALL PROVIDE INFORMATION TO THE DESIGN ENGINEER FOR INCLUSION ON THE RECORD AS-BUILT DRAWINGS.
32.

THE CONTRACTOR IS RESPONSIBLE FOR CLEANING AND TELEVISING ALL STORM AND SANITARY SEWERS. THE CITY OF WAUKEE ENGINEERING DEPARTMENT SHALL WITNESS AND APPROVE ALL CLEANING AND TELEVISING PRIOR TO PAVING. A COPY OF THE VIDEOS AND A HARD COPY OF THE INSPECTION REPORT SHALL BE PROVIDED TO THE CITY OF WAUKEE ENGINEERING DEPARTMENT. ALL SANITARY SEWER MANHOLES ARE TO BE VACUUM TESTED.
33.

ALL FIRE HYDRANTS INCLUDING ANY RELOCATED HYDRANTS SHALL HAVE 5-INCH STORZ FITTINGS.
34.

ALL PROPOSED PEDESTRIAN CROSSINGS SHALL BE INSTALLED AS PART OF THE PLAT IMPROVEMENTS.
35.

ALL CONNECTIONS TO EXISTING MANHOLES ARE TO BE CORE DRILLED AND USE A LINK SEAL.
36.

ANY FIELD FENCE LOCATED WITHIN THE PROPERTY IS TO BE REMOVED.
37.

ALL EXISTING AND PROPOSED MANHOLES SHALL HAVE A MINIMUM OF 1 - 4" ADJUSTING RING TO ALLOW FOR FUTURE ADJUSTMENT SHOULD THE STRUCTURE END UP IN A DRIVEWAY.
38.

THE RESULTS OF THE GEOTECHNICAL EXPLORATION ARE TO BE PROVIDED TO THE CITY OF WAUKEE ENGINEERING DEPARTMENT AND THIS PLAN IS SUBJECT TO ANY CHANGES REQUIRED BY THE REPORT.
39.

THIS SITE WILL HAVE SAWCUTTING AND CONCRETE GRINDING SO PROTECTION OF STORM SEWERS AND DRAINAGE WAYS FROM SLURRY WILL NEED TO OCCUR FOR ALL OFFSITE DISCHARGE.

DATE

12/29/2021

09/02/2021

08/18/2021

07/27/2021

07/13/2021

AS-BUILT SUBMITTAL

FINAL SUBMITTAL

THIRD SUBMITTAL

SECOND SUBMITTAL

FIRST SUBMITTAL

REVISIONS

3405 S.E. CROSSROADS DRIVE, SUITE G
GRIMES, IOWA 50111
PHONE: (515) 369-4400 FAX: (515) 369-4410
EI:JWM TECH: MST
ENGINEER: EKO

HAMILTON RIDGE PLAT 7

QUANTITIES, GENERAL NOTES AND
BID ITEM REFERENCE NOTES

4



11

2106.480

WAUKEE, IOWA

CIVIL DESIGN ADVANTAGE

FILE: H:\2021\2106440\DWG\2106440-COV-BET-TAB-AS-BUILT.DWG
COMMENTS: DATE PLOTTED: 12/29/2021 8:36 AM
PLOTTER: HP PLOTTER
PLOTTER: MATTHEW THOMPSON

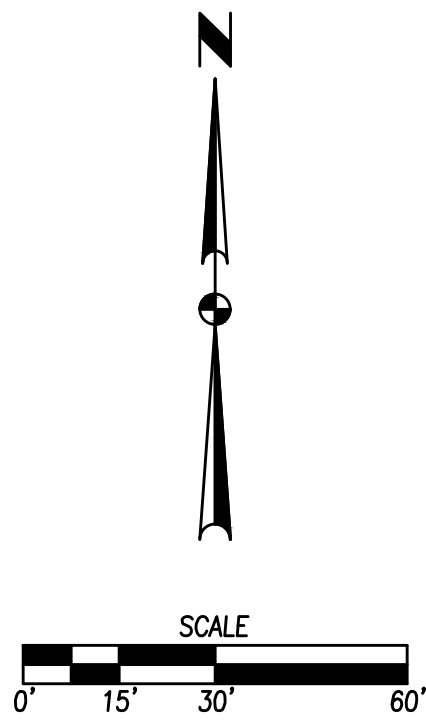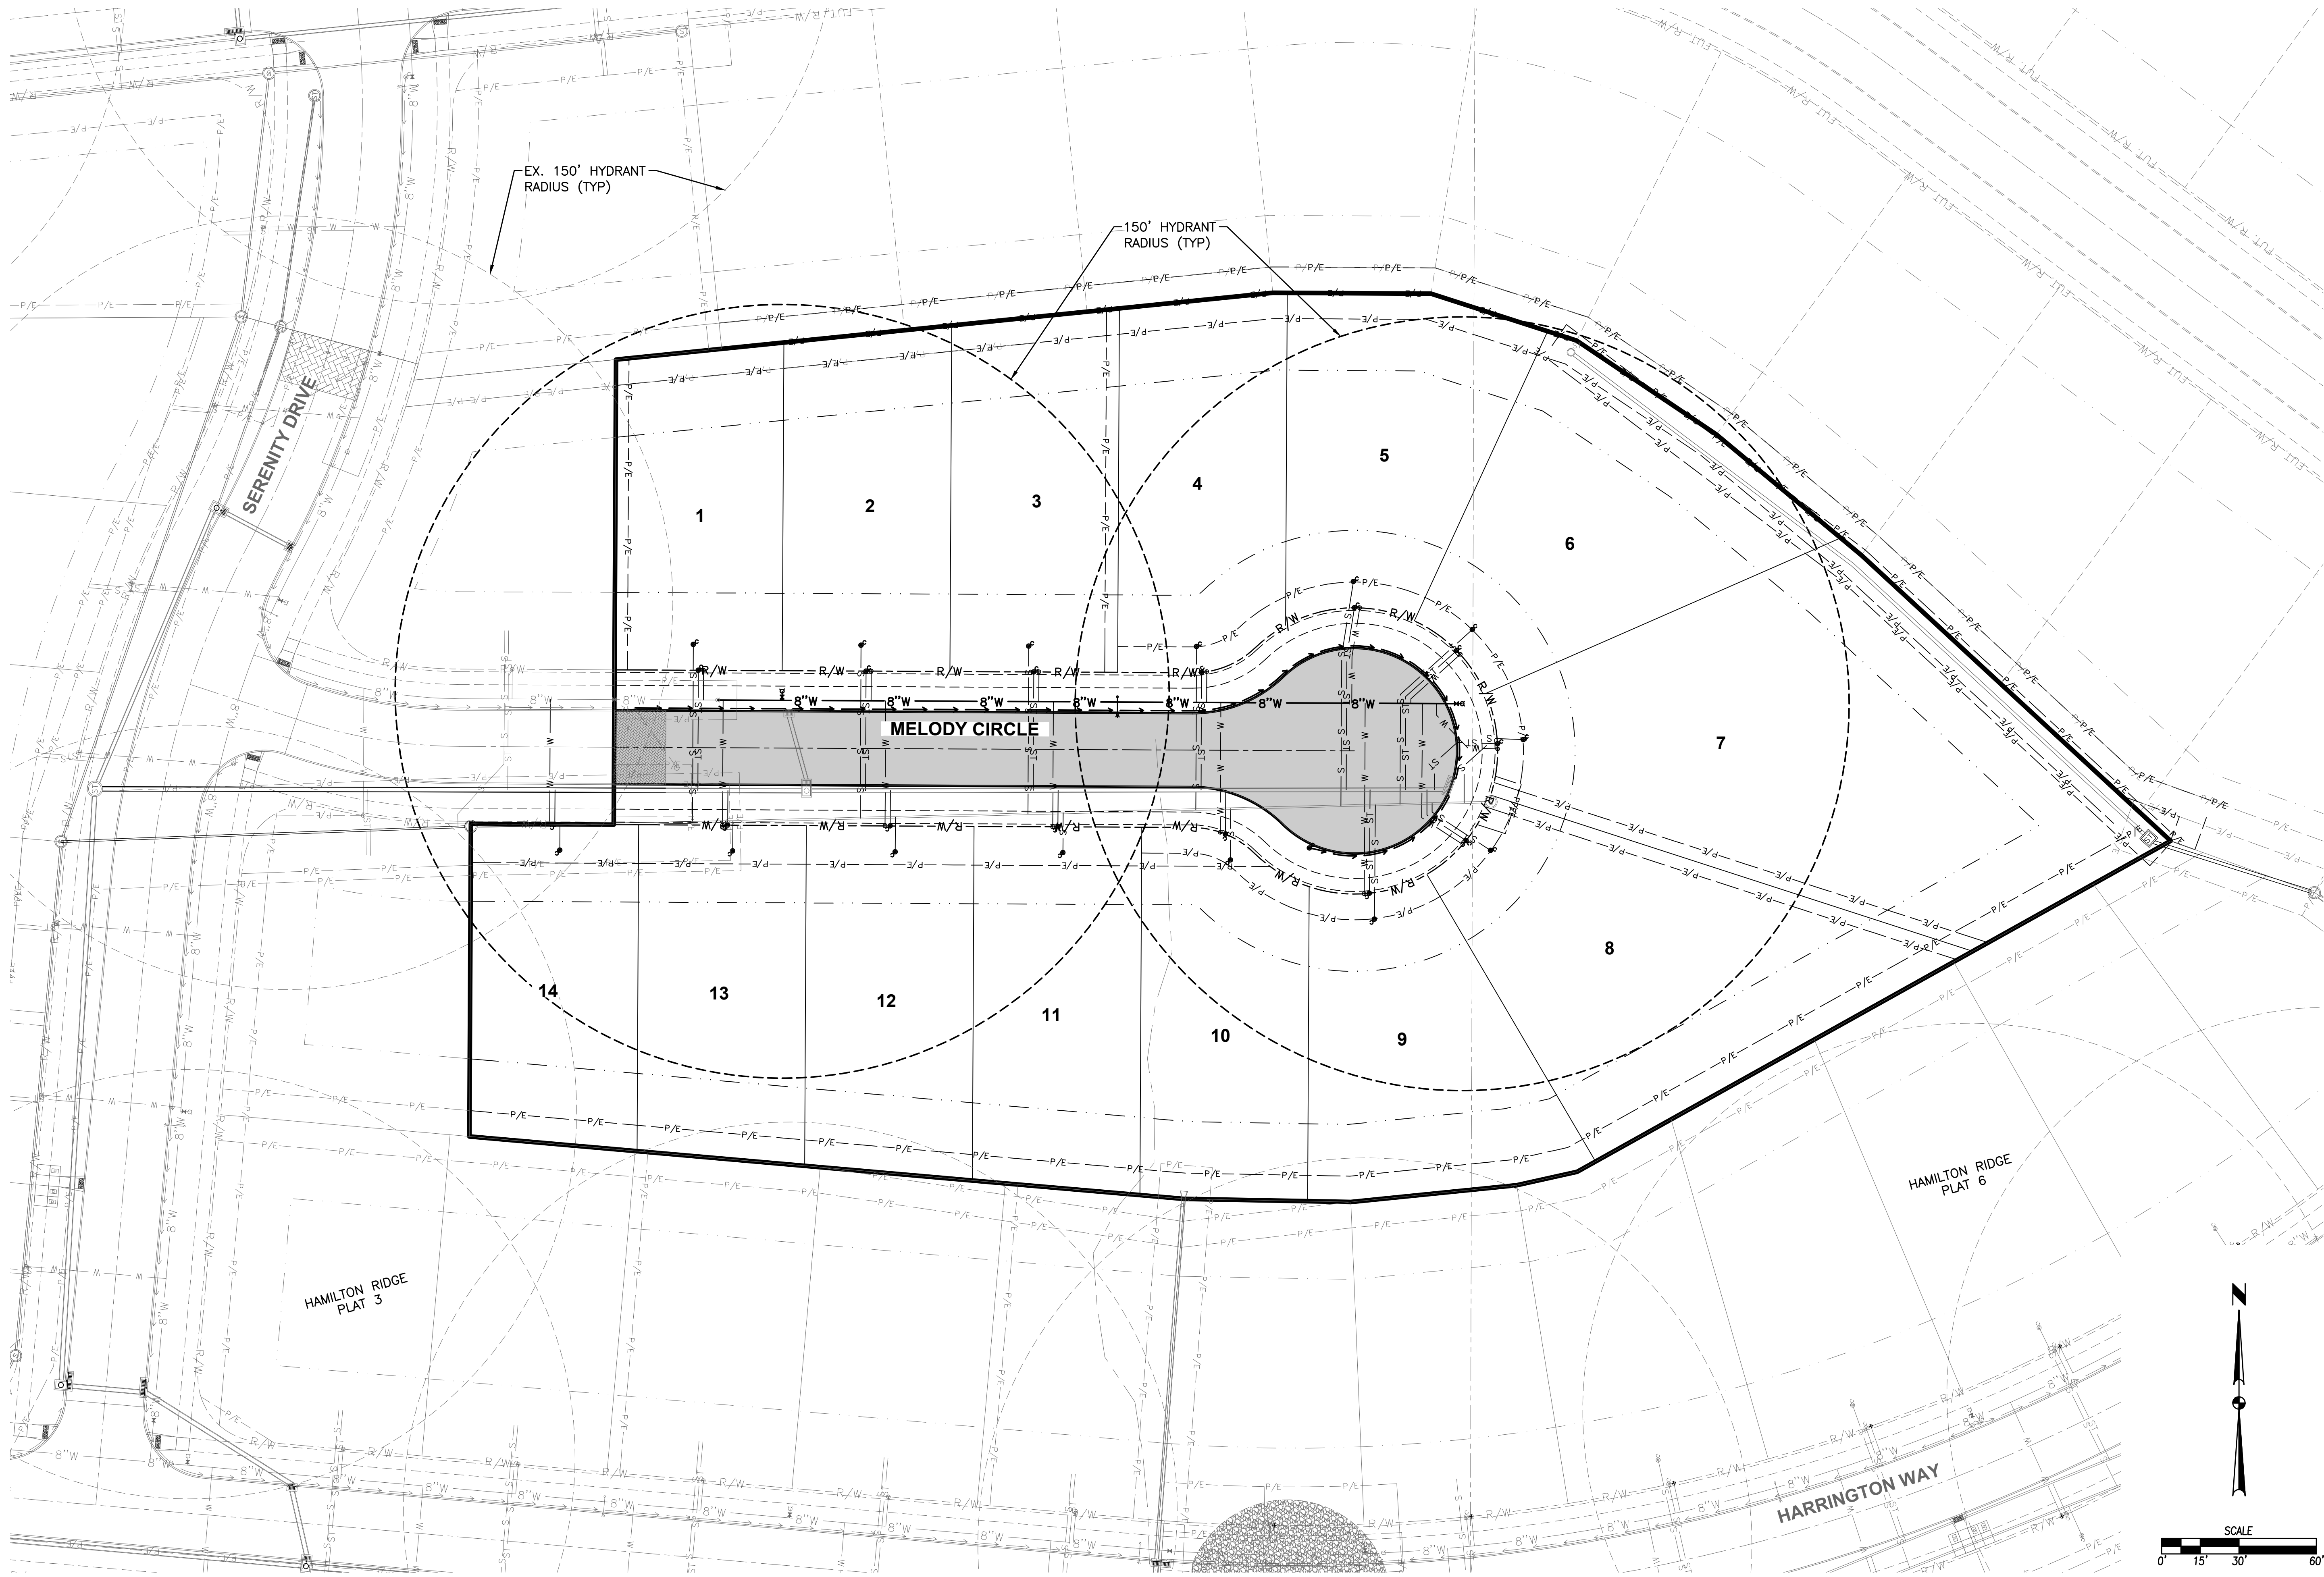

HAMILTON RIDGE PLAT 7

HYDRANT COVERAGE AND LANDSCAPE PLAN




WAUKEE, IOWA

3405 S.E. CROSSROADS DRIVE, SUITE G
GRIMES, IOWA 50111
PHONE: (515) 369-4400 FAX: (515) 369-4410
ENGINEER: EKO

REVISIONS

DATE	REVISIONS
12/29/2021	AS-BUILT SUBMITTAL
09/02/2021	FINAL SUBMITTAL
08/18/2021	THIRD SUBMITTAL
07/27/2021	SECOND SUBMITTAL
07/13/2021	FIRST SUBMITTAL



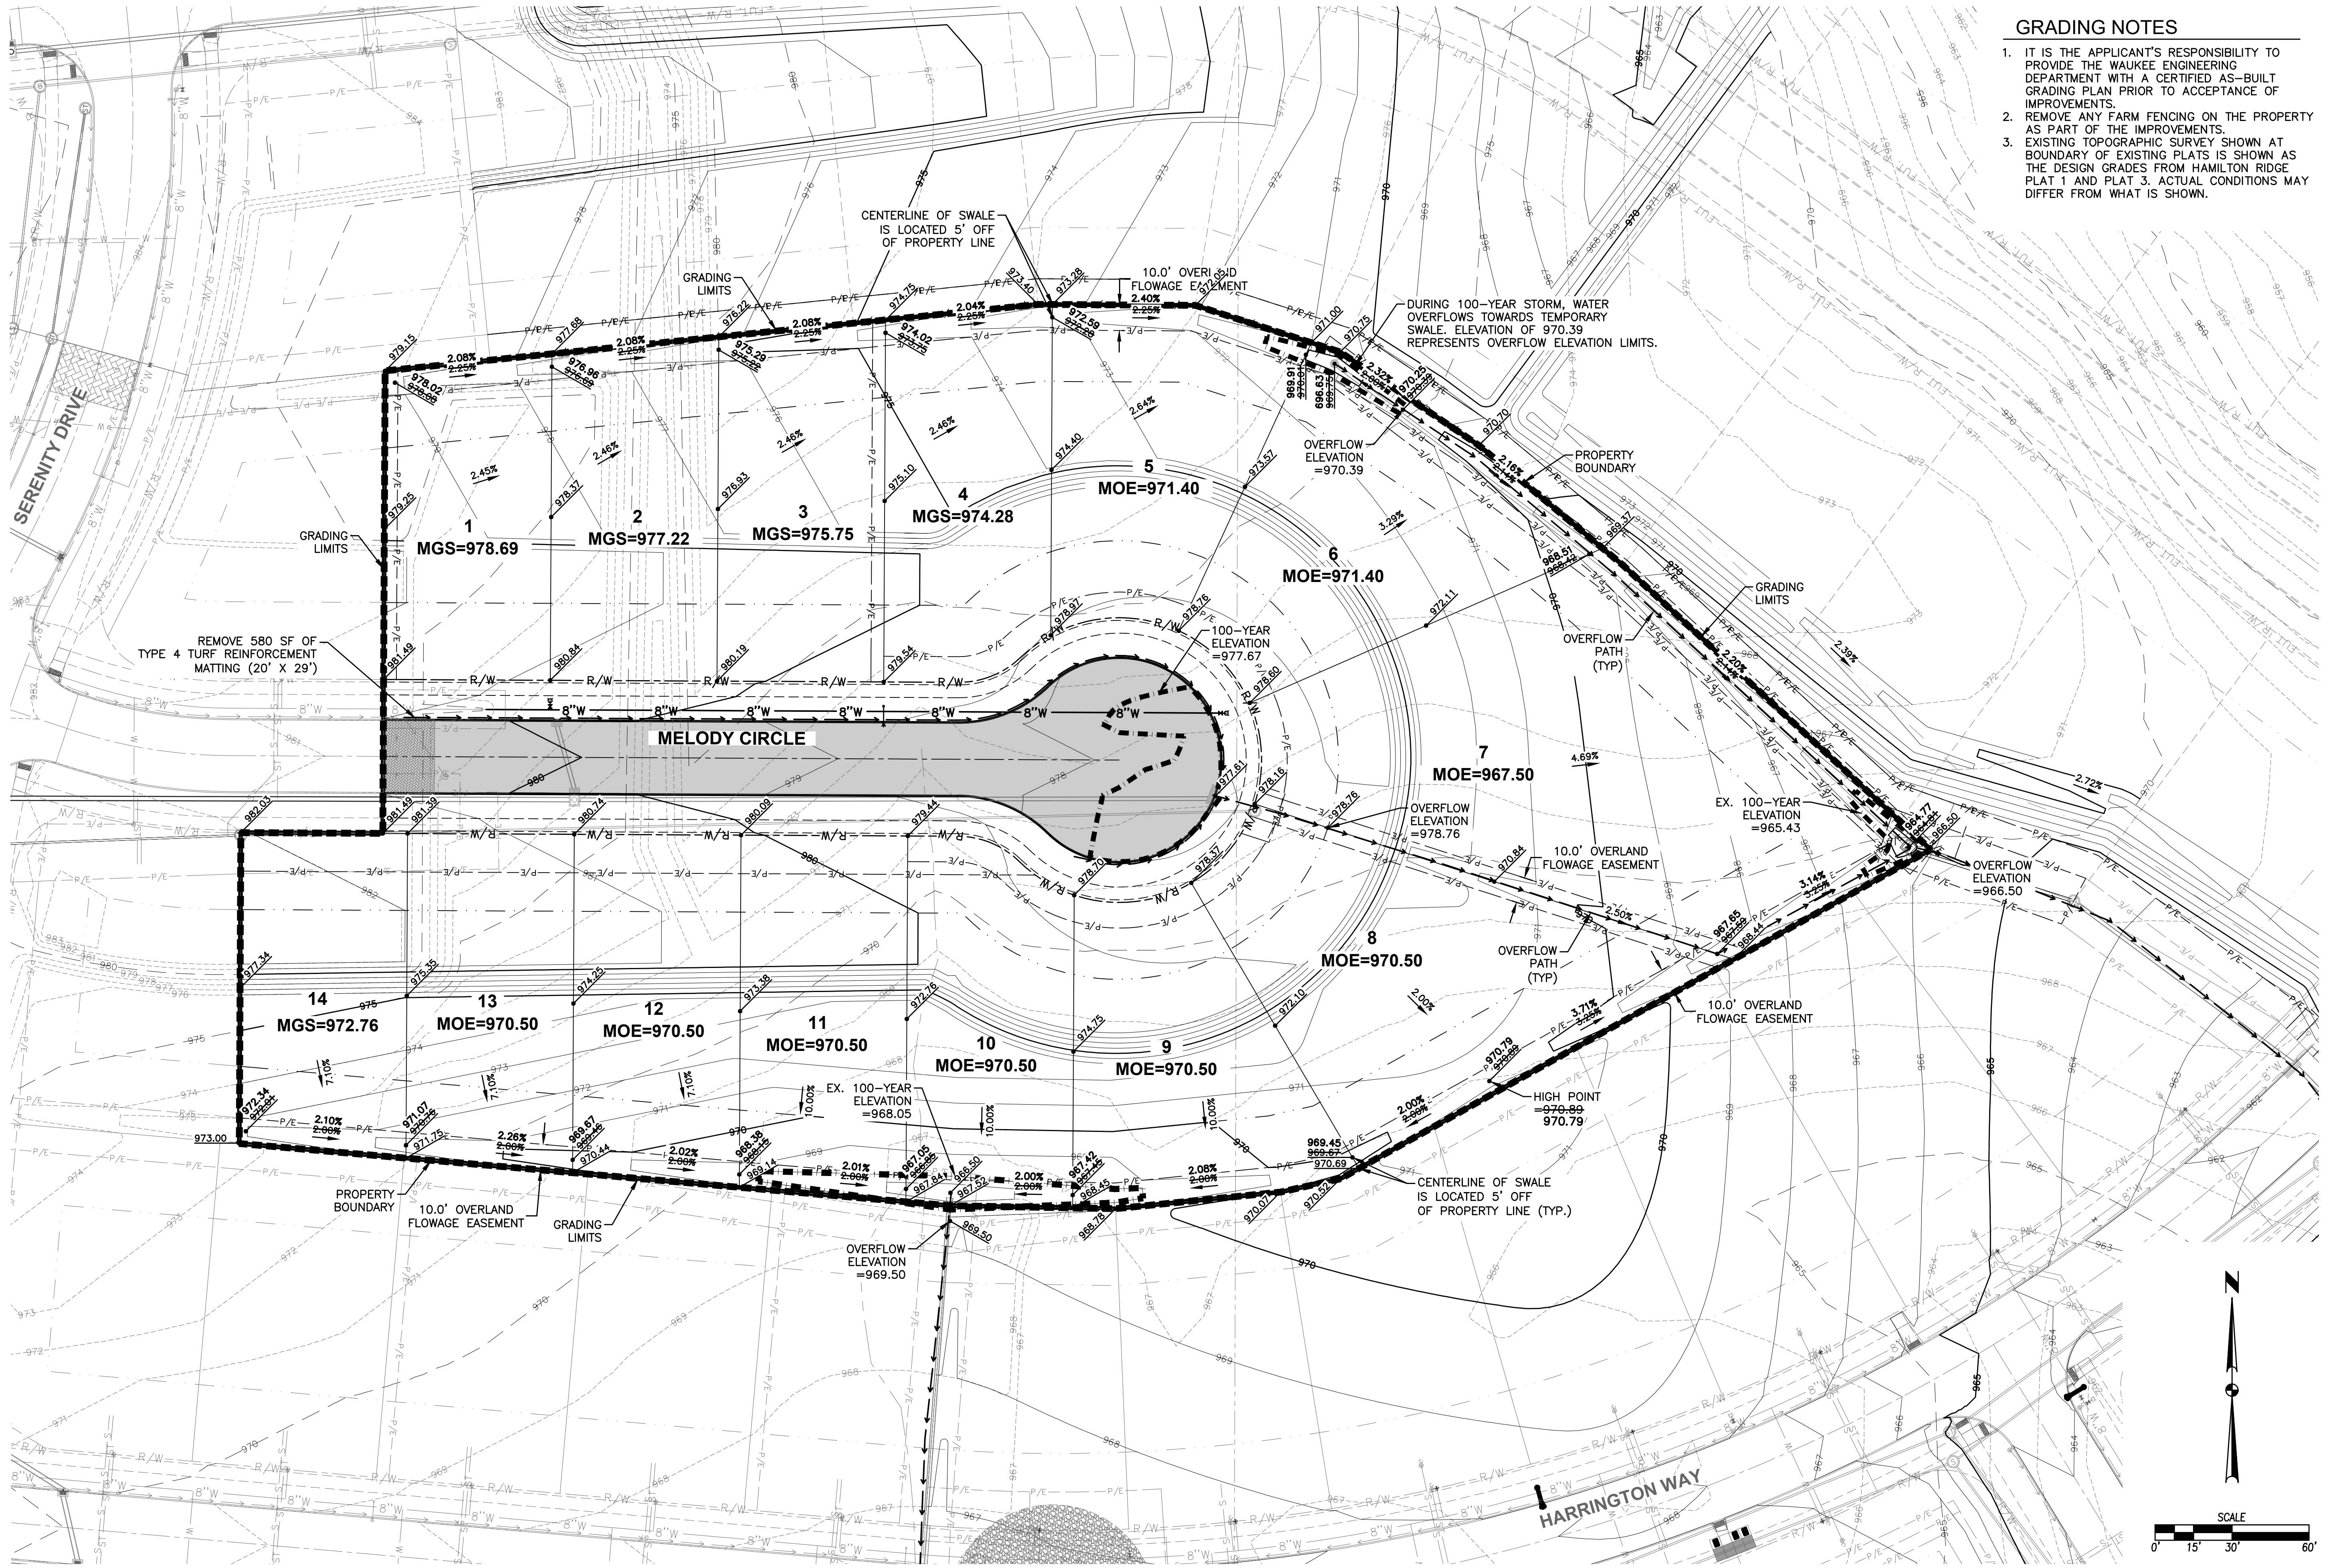

GRADING NOTES

- IT IS THE APPLICANT'S RESPONSIBILITY TO PROVIDE THE WAUKEE ENGINEERING DEPARTMENT WITH A CERTIFIED AS-BUILT GRADING PLAN PRIOR TO ACCEPTANCE OF IMPROVEMENTS.
- REMOVE ANY FARM FENCING ON THE PROPERTY AS PART OF THE IMPROVEMENTS.
- EXISTING TOPOGRAPHIC SURVEY SHOWN AT BOUNDARY OF EXISTING PLATS IS SHOWN AS THE DESIGN GRADES FROM HAMILTON RIDGE PLAT 1 AND PLAT 3. ACTUAL CONDITIONS MAY DIFFER FROM WHAT IS SHOWN.

7

11

2106.480

HAMILTON RIDGE PLAT 7

EROSION AND SEDIMENT CONTROL PLAN

CIVIL DESIGN ADVANTAGE

WAUKEE, IOWA

3405 S.E. CROSSROADS DRIVE, SUITE G

GRIMES, IOWA 50111

PHONE: (515) 369-4400 FAX: (515) 369-4410

REVISIONS	DATE
AS-BUILT SUBMITTAL	12/28/2021
FINAL SUBMITTAL	09/02/2021
THIRD SUBMITTAL	08/18/2021
SECOND SUBMITTAL	07/27/2021
FIRST SUBMITTAL	07/13/2021

ENGINEER: EKO


EI:JWM TECH: MST





ITEM NO.	ITEM	UNIT	TOTAL
1	SILT FENCE	LF	614
2	DITCH CHECKS	LF	599
3	SEEDING, FERTILIZING, AND MULCHING	AC	3.62
4	INLET PROTECTION DEVICES	EA	3
5	CONCRETE WASHOUT PIT	EA	1

<u>DISCHARGE POINT #1 TO AN UNKNOWN TRIBUTARY OF SUGAR CREEK ±1000 FT</u>	
TOTAL AREA DISTURBED TO DISCHARGE POINT	3.04 ACRES
STORAGE VOLUME REQUIRED (3.04 OF ACRES*3600 CU FT)	10,944 CU FT
VOLUME PROVIDED IN SILT FENCE (227 LF @ 10.0 CU FT/LF OF FENCE)	2,270 CU FT
VOLUME PROVIDED IN DITCH CHECK (397 LF @ 15.0 CU FT/LF)	5,955 CU FT
VOLUME PROVIDED IN TSB #3	<u>35,156 CU FT</u>
TOTAL VOLUME PROVIDED	43,381 CU FT
 <u>DISCHARGE POINT #2 TO AN UNKNOWN TRIBUTARY OF SUGAR CREEK ±600 FT</u>	
TOTAL AREA DISTURBED TO DISCHARGE POINT	0.86 ACRES
STORAGE VOLUME REQUIRED (0.86 OF ACRES*3600 CU FT)	3,096 CU FT
VOLUME PROVIDED IN SILT FENCE (387 LF @ 10.0 CU FT/LF OF FENCE)	3,870 CU FT
VOLUME PROVIDED IN DITCH CHECK (202 LF @ 15.0 CU FT/LF)	<u>3,030 CU FT</u>
TOTAL VOLUME PROVIDED	6,900 CU FT

 1. IF DEWATERING IS NEEDED FOR ANY REASON, DISCHARGE OF WATER OFFSITE IS TO CONFORM WITH THE GENERAL PERMIT #2 REQUIREMENT.
2. DISTURBED AREAS SHALL BE TEMPORARILY SEEDED OR MULCHED IMMEDIATELY WHENEVER CLEARING, GRADING, EXCAVATING, OR OTHER EARTH DISTURBING ACTIVITIES HAVE PERMANENTLY OR TEMPORARILY CEASED AND WILL NOT RESUME FOR A PERIOD EXCEEDING 14 CALENDAR DAYS.
3. STORM SEWERS AND DRAINAGE WAYS SHALL BE PROTECTED FROM CONCRETE SLURRY PRODUCED BY SAWCUTTING AND CONCRETE GRINDING.

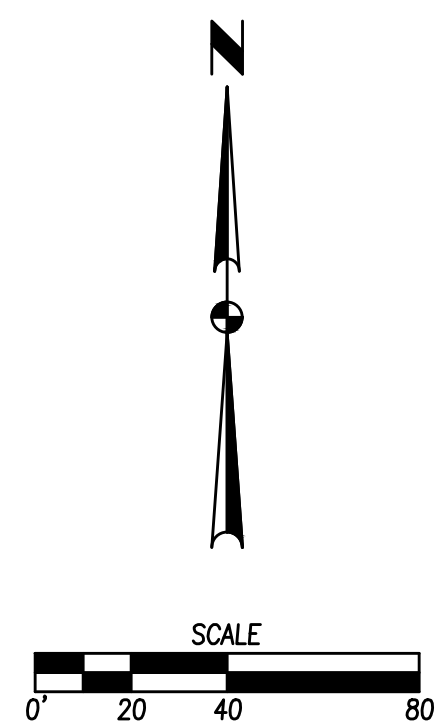




DRAINAGE ARROW 	UNDISTURBED AREA 
GRADING LIMITS 	RIP-RAP 
FILTER SOCK 	GRAVEL ENTRANCE 
SILT FENCE 	STAGING AREA 
DITCH CHECK 	CONCRETE WASHOUT PIT 
INLET PROTECTION 	
PORTABLE RESTROOM 	
TEMPORARY STANDPIPE 	

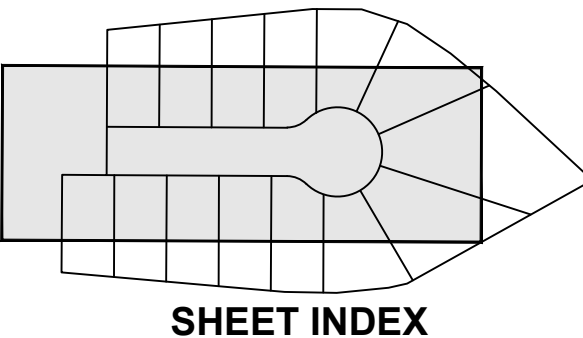





3405 S.E. CROSSROADS DRIVE, SUITE G
GRIMES, IOWA 50111
PHONE: (515) 369-4400 FAX: (515) 369-4410
ENGINEER: EKO EI:JWM TECH: MS

CIVIL DESIGN ADVANTAGE

HAMILTON RIDGE PLAT 7

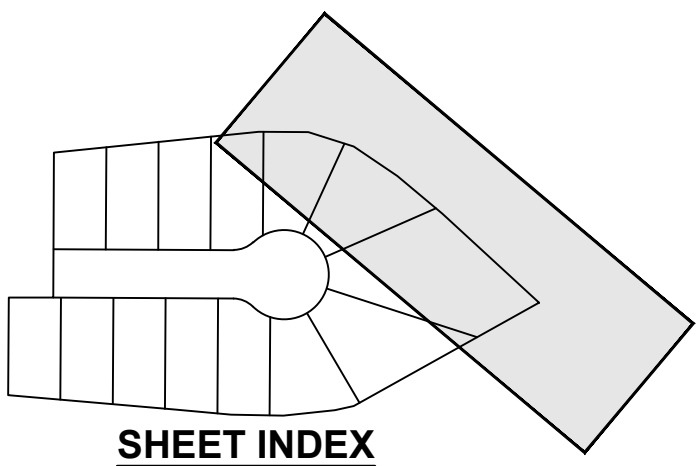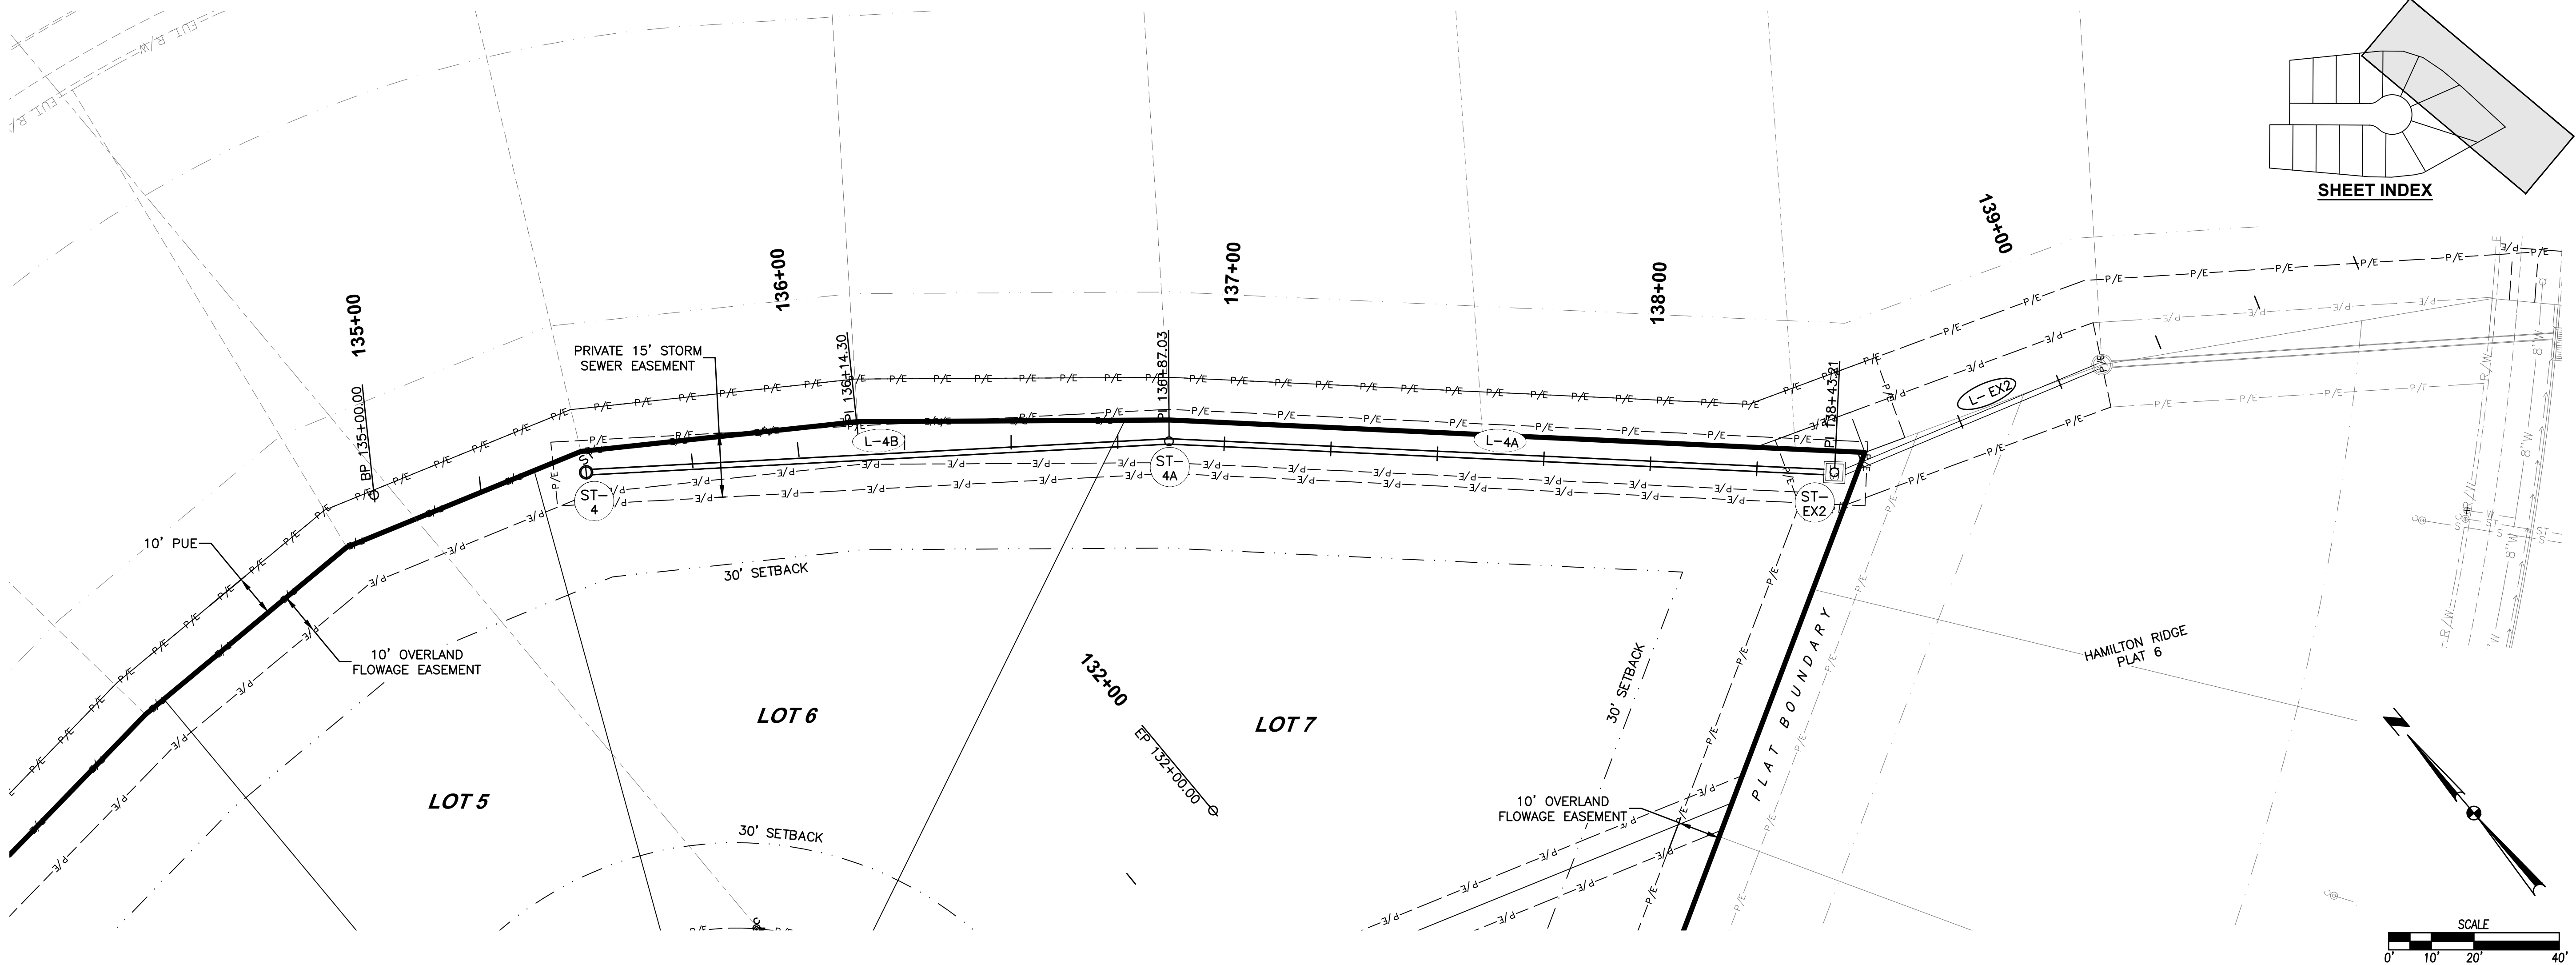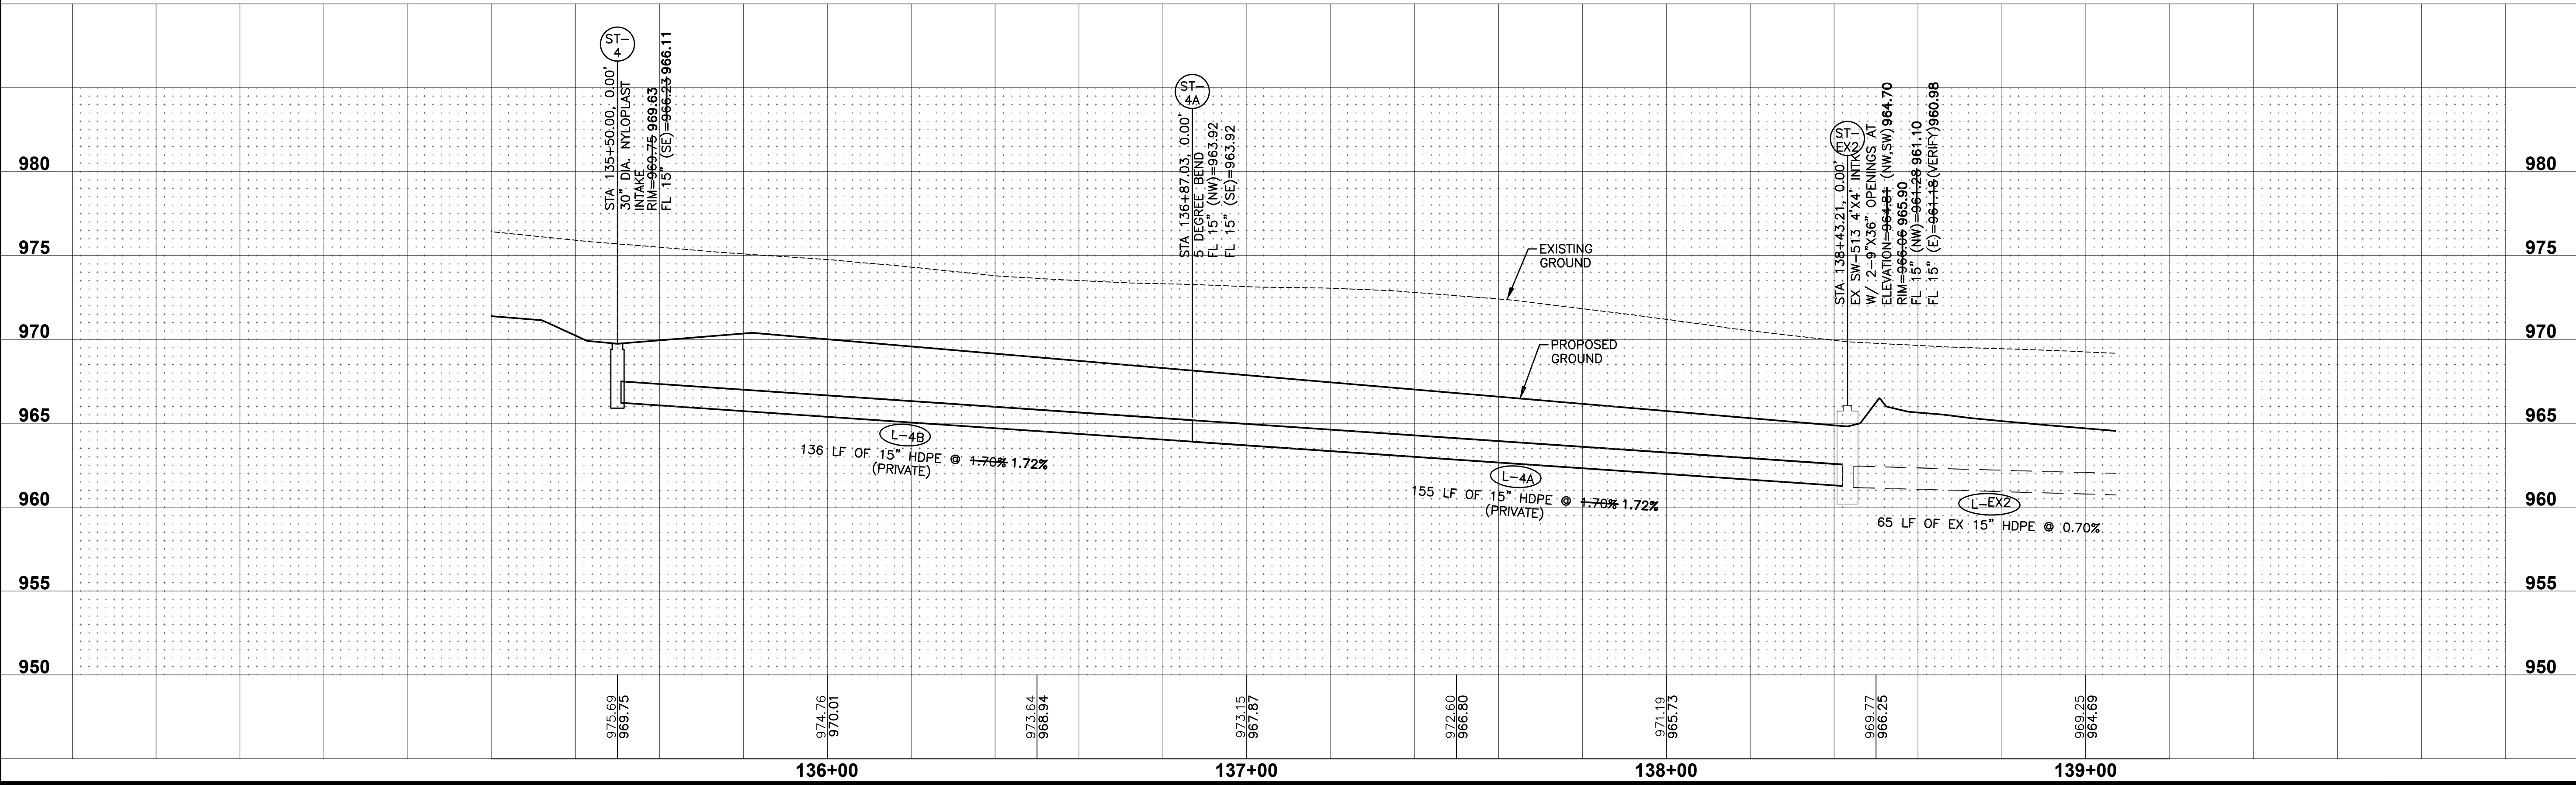

FILE: H:\2021\2106440\DWG\2106440-PWP-WATERMAIN-ASBUIL.DWG
COMMENTS: DATE PLOTTED: 12/29/2021 9:23 AM
PLOTTER: HP PLOTTER
PLOTTER: HP PLOTTER

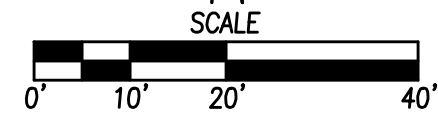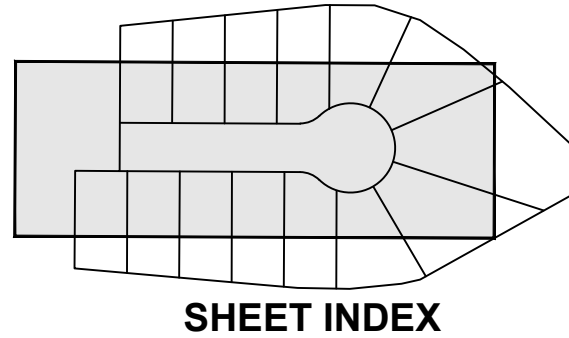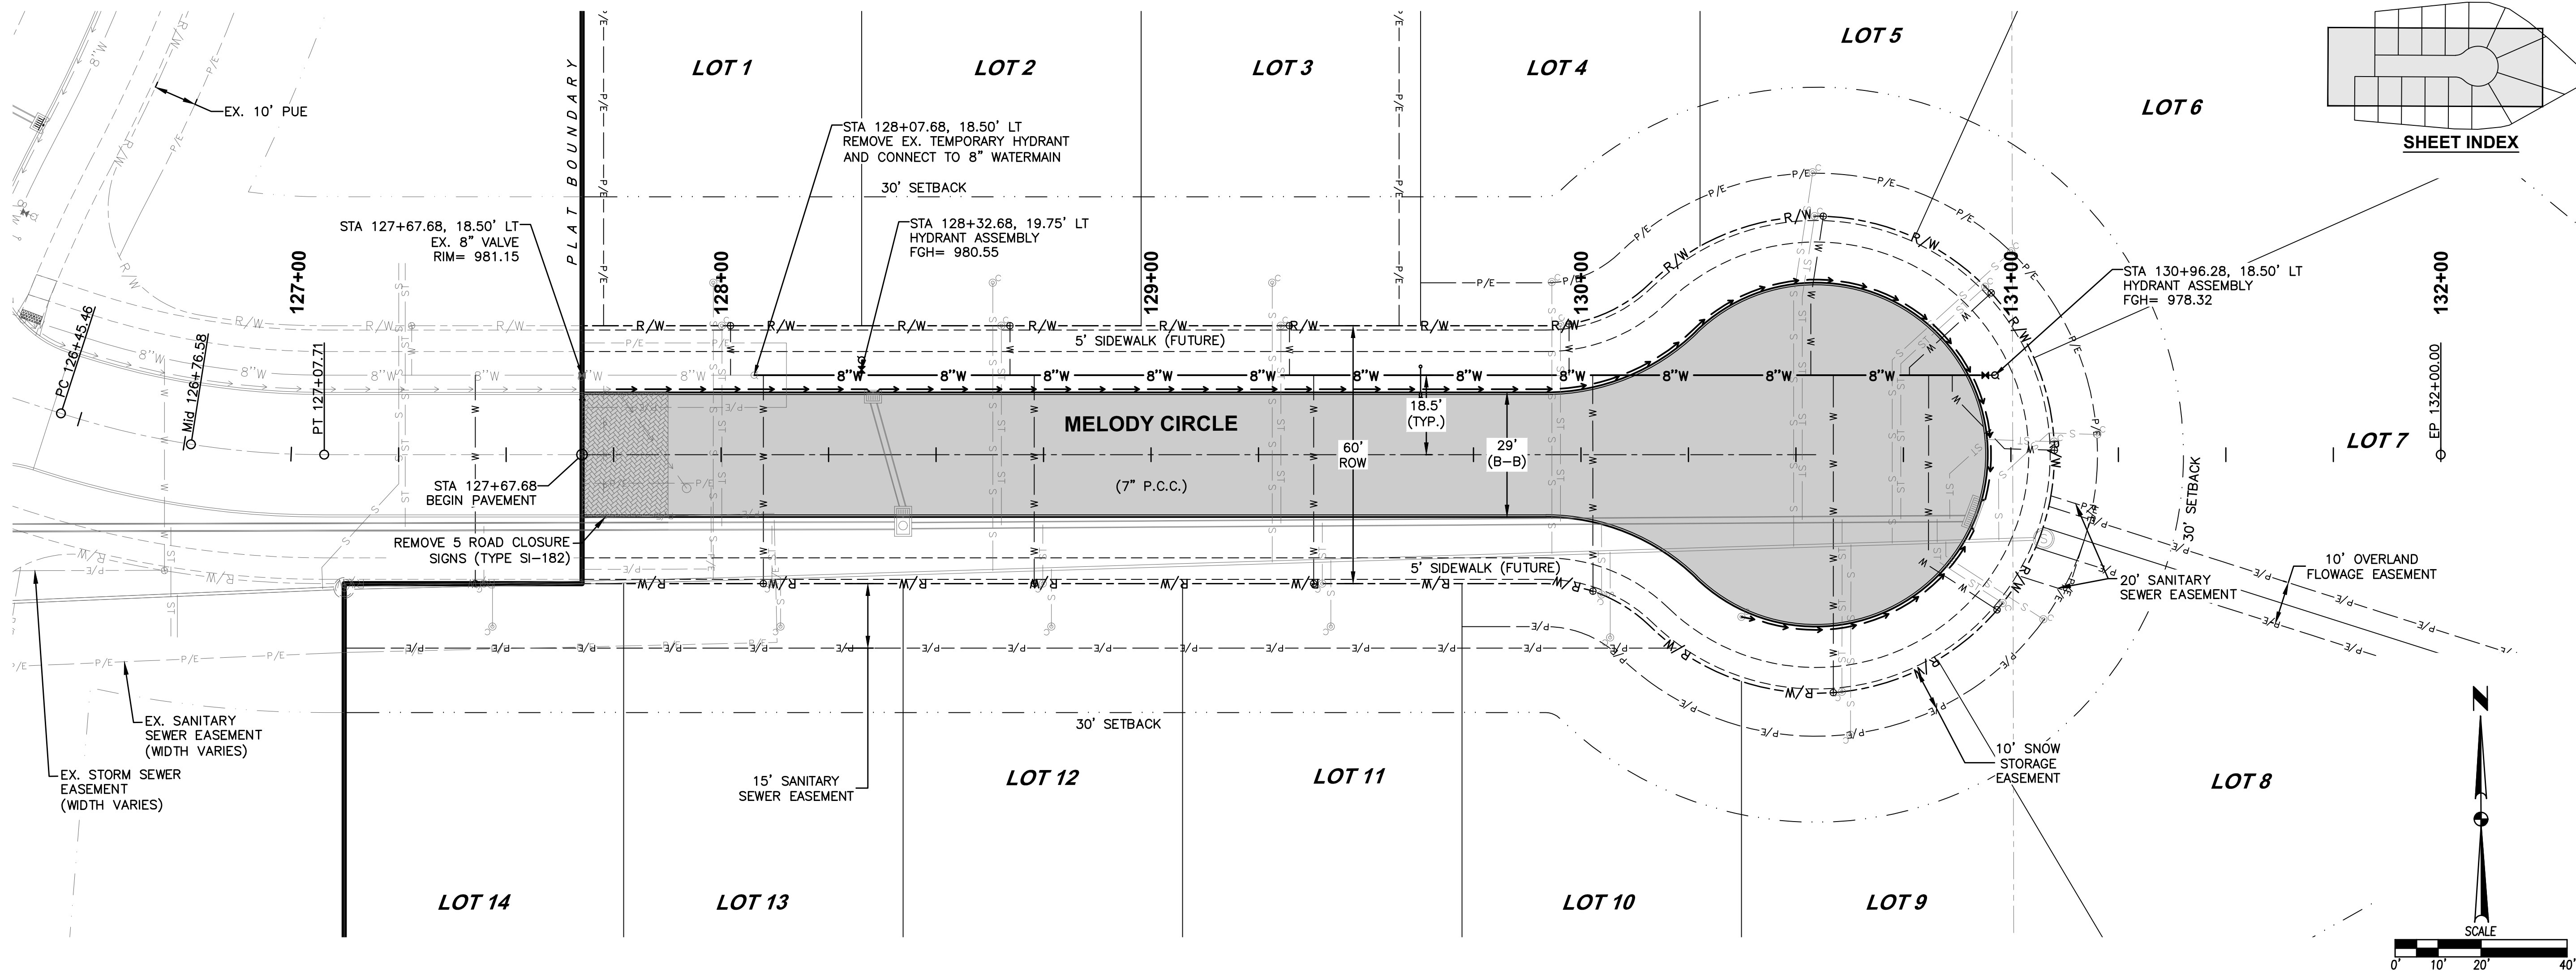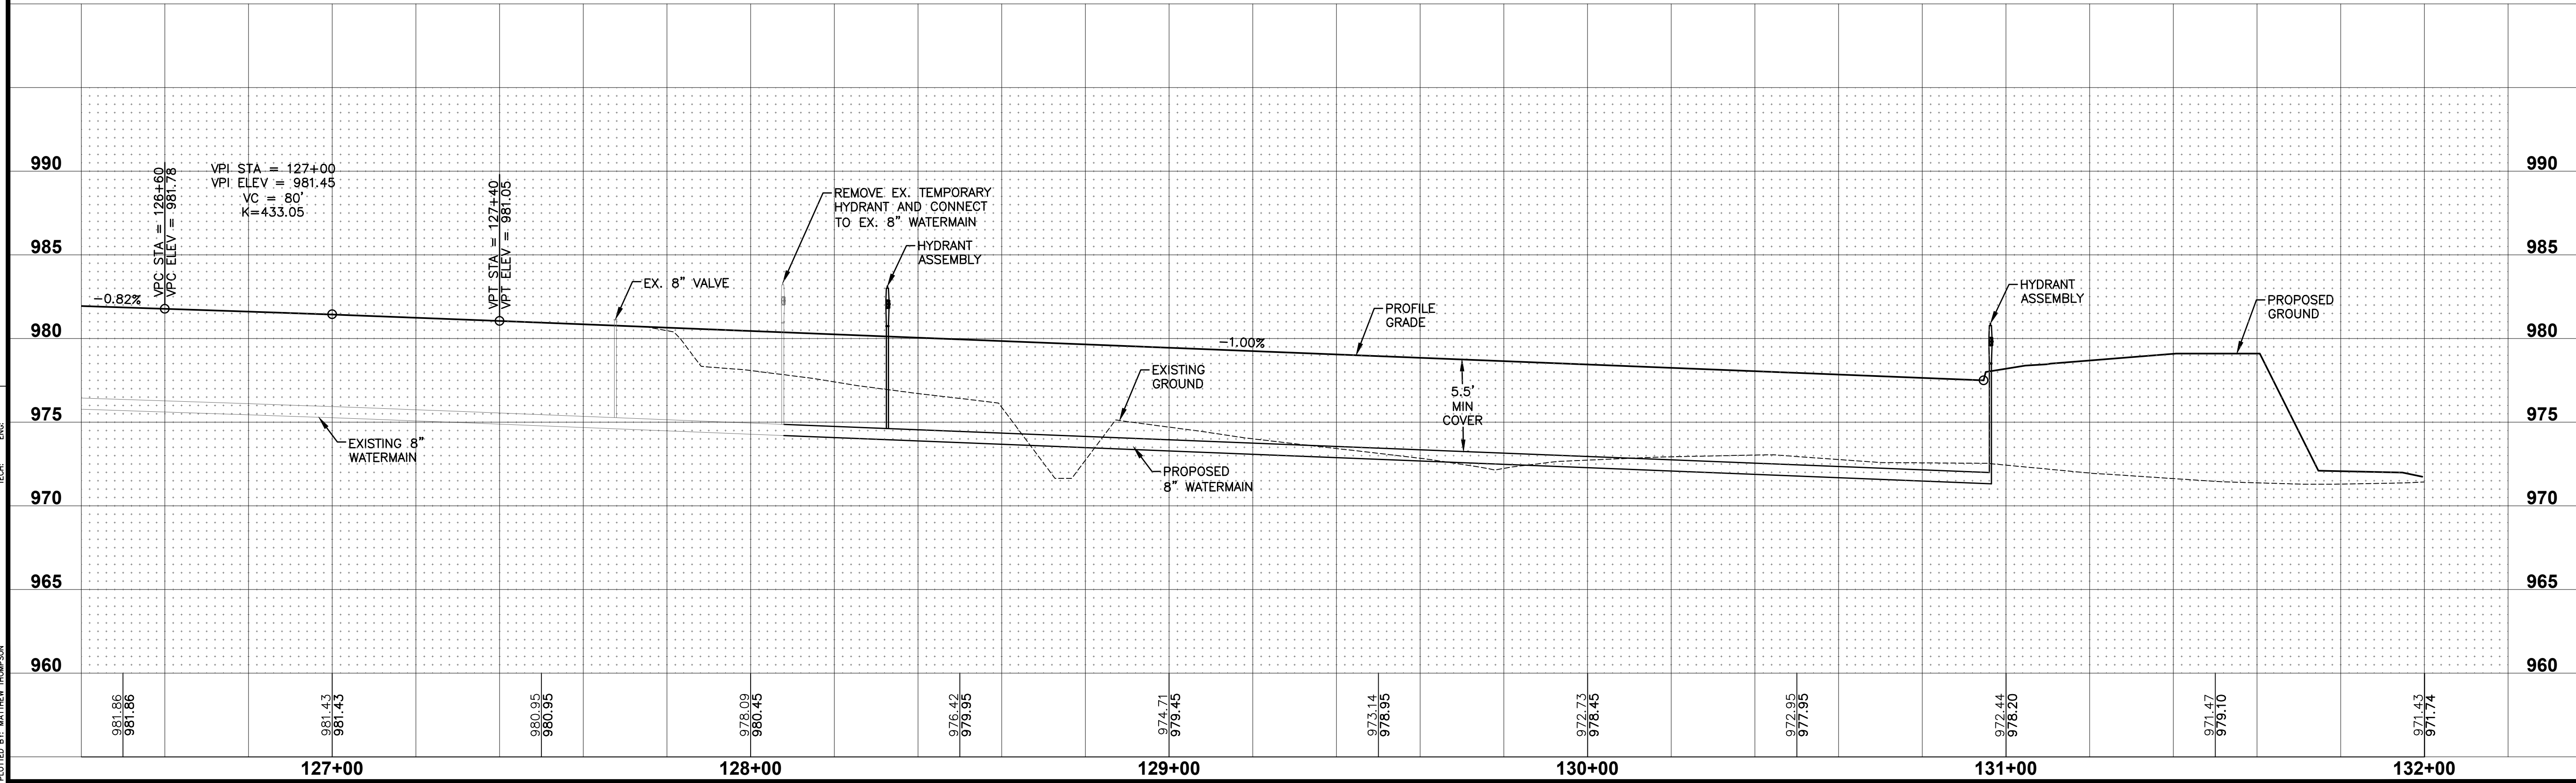


HAMILTON RIDGE PLAT 7

WATERMAIN PLAN AND PROFILE


10/11
2106.480

3405 S.E. CROSSROADS DRIVE, SUITE G
GRIMES, IOWA 50111
PHONE: (515) 369-4400 FAX: (515) 369-4410
ENGINEER: EKO
TECH: MST

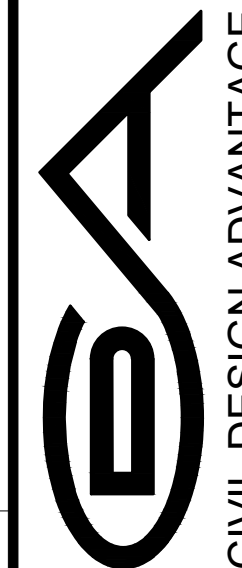


WAUKEE, IOWA


REVISIONS	DATE
AS-BUILT SUBMITTAL	12/29/2021
FINAL SUBMITTAL	09/02/2021
THIRD SUBMITTAL	08/18/2021
SECOND SUBMITTAL	07/27/2021
FIRST SUBMITTAL	07/13/2021

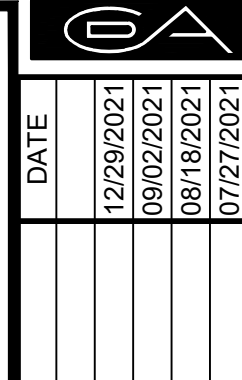

FILE: H:\2021\2106440\DWG\2106440-INTERSECTION-ASBUIL.DWG
PLOT DATE: 12/29/2021 9:24 AM
PLOTTER: HP PLOTTER
DRAWN BY: MATTHEW THOMPSON
CHECKED BY: JAMES HARRIS
DATE PLOTTED: 12/29/2021 9:24 AM
COMMENTS: ENDS

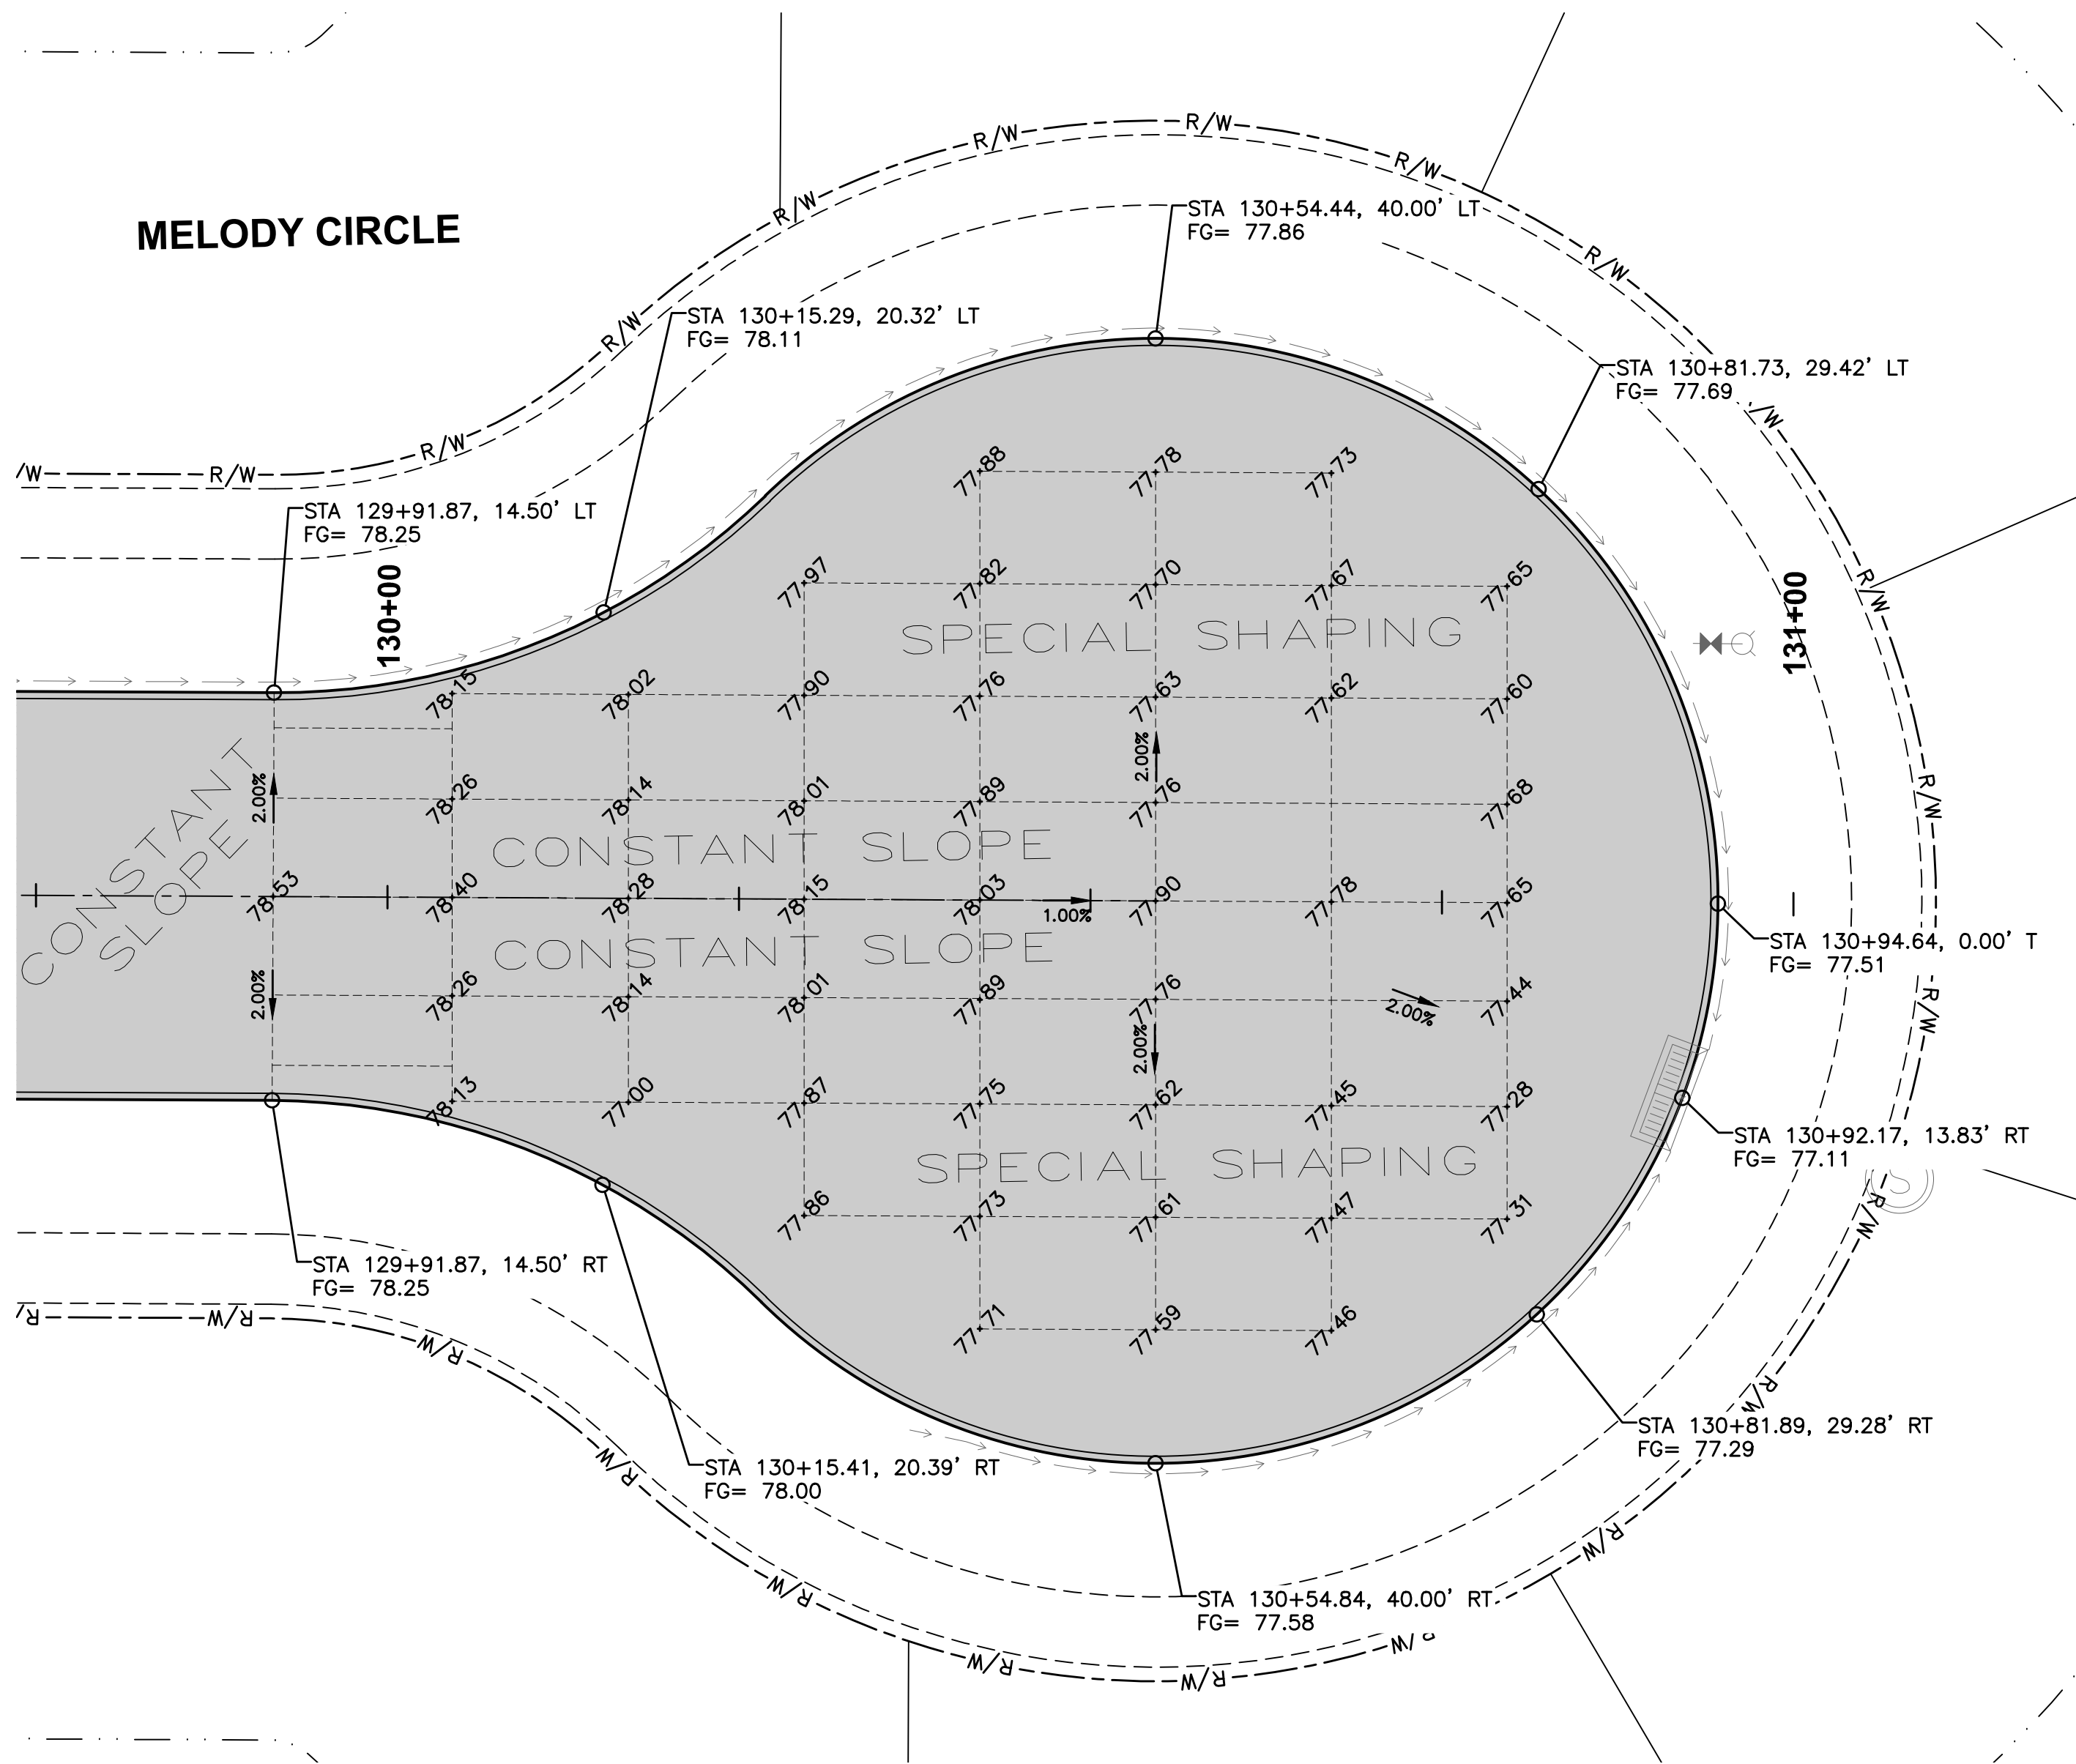

GEOMETRICS AND STAKING LAYOUT

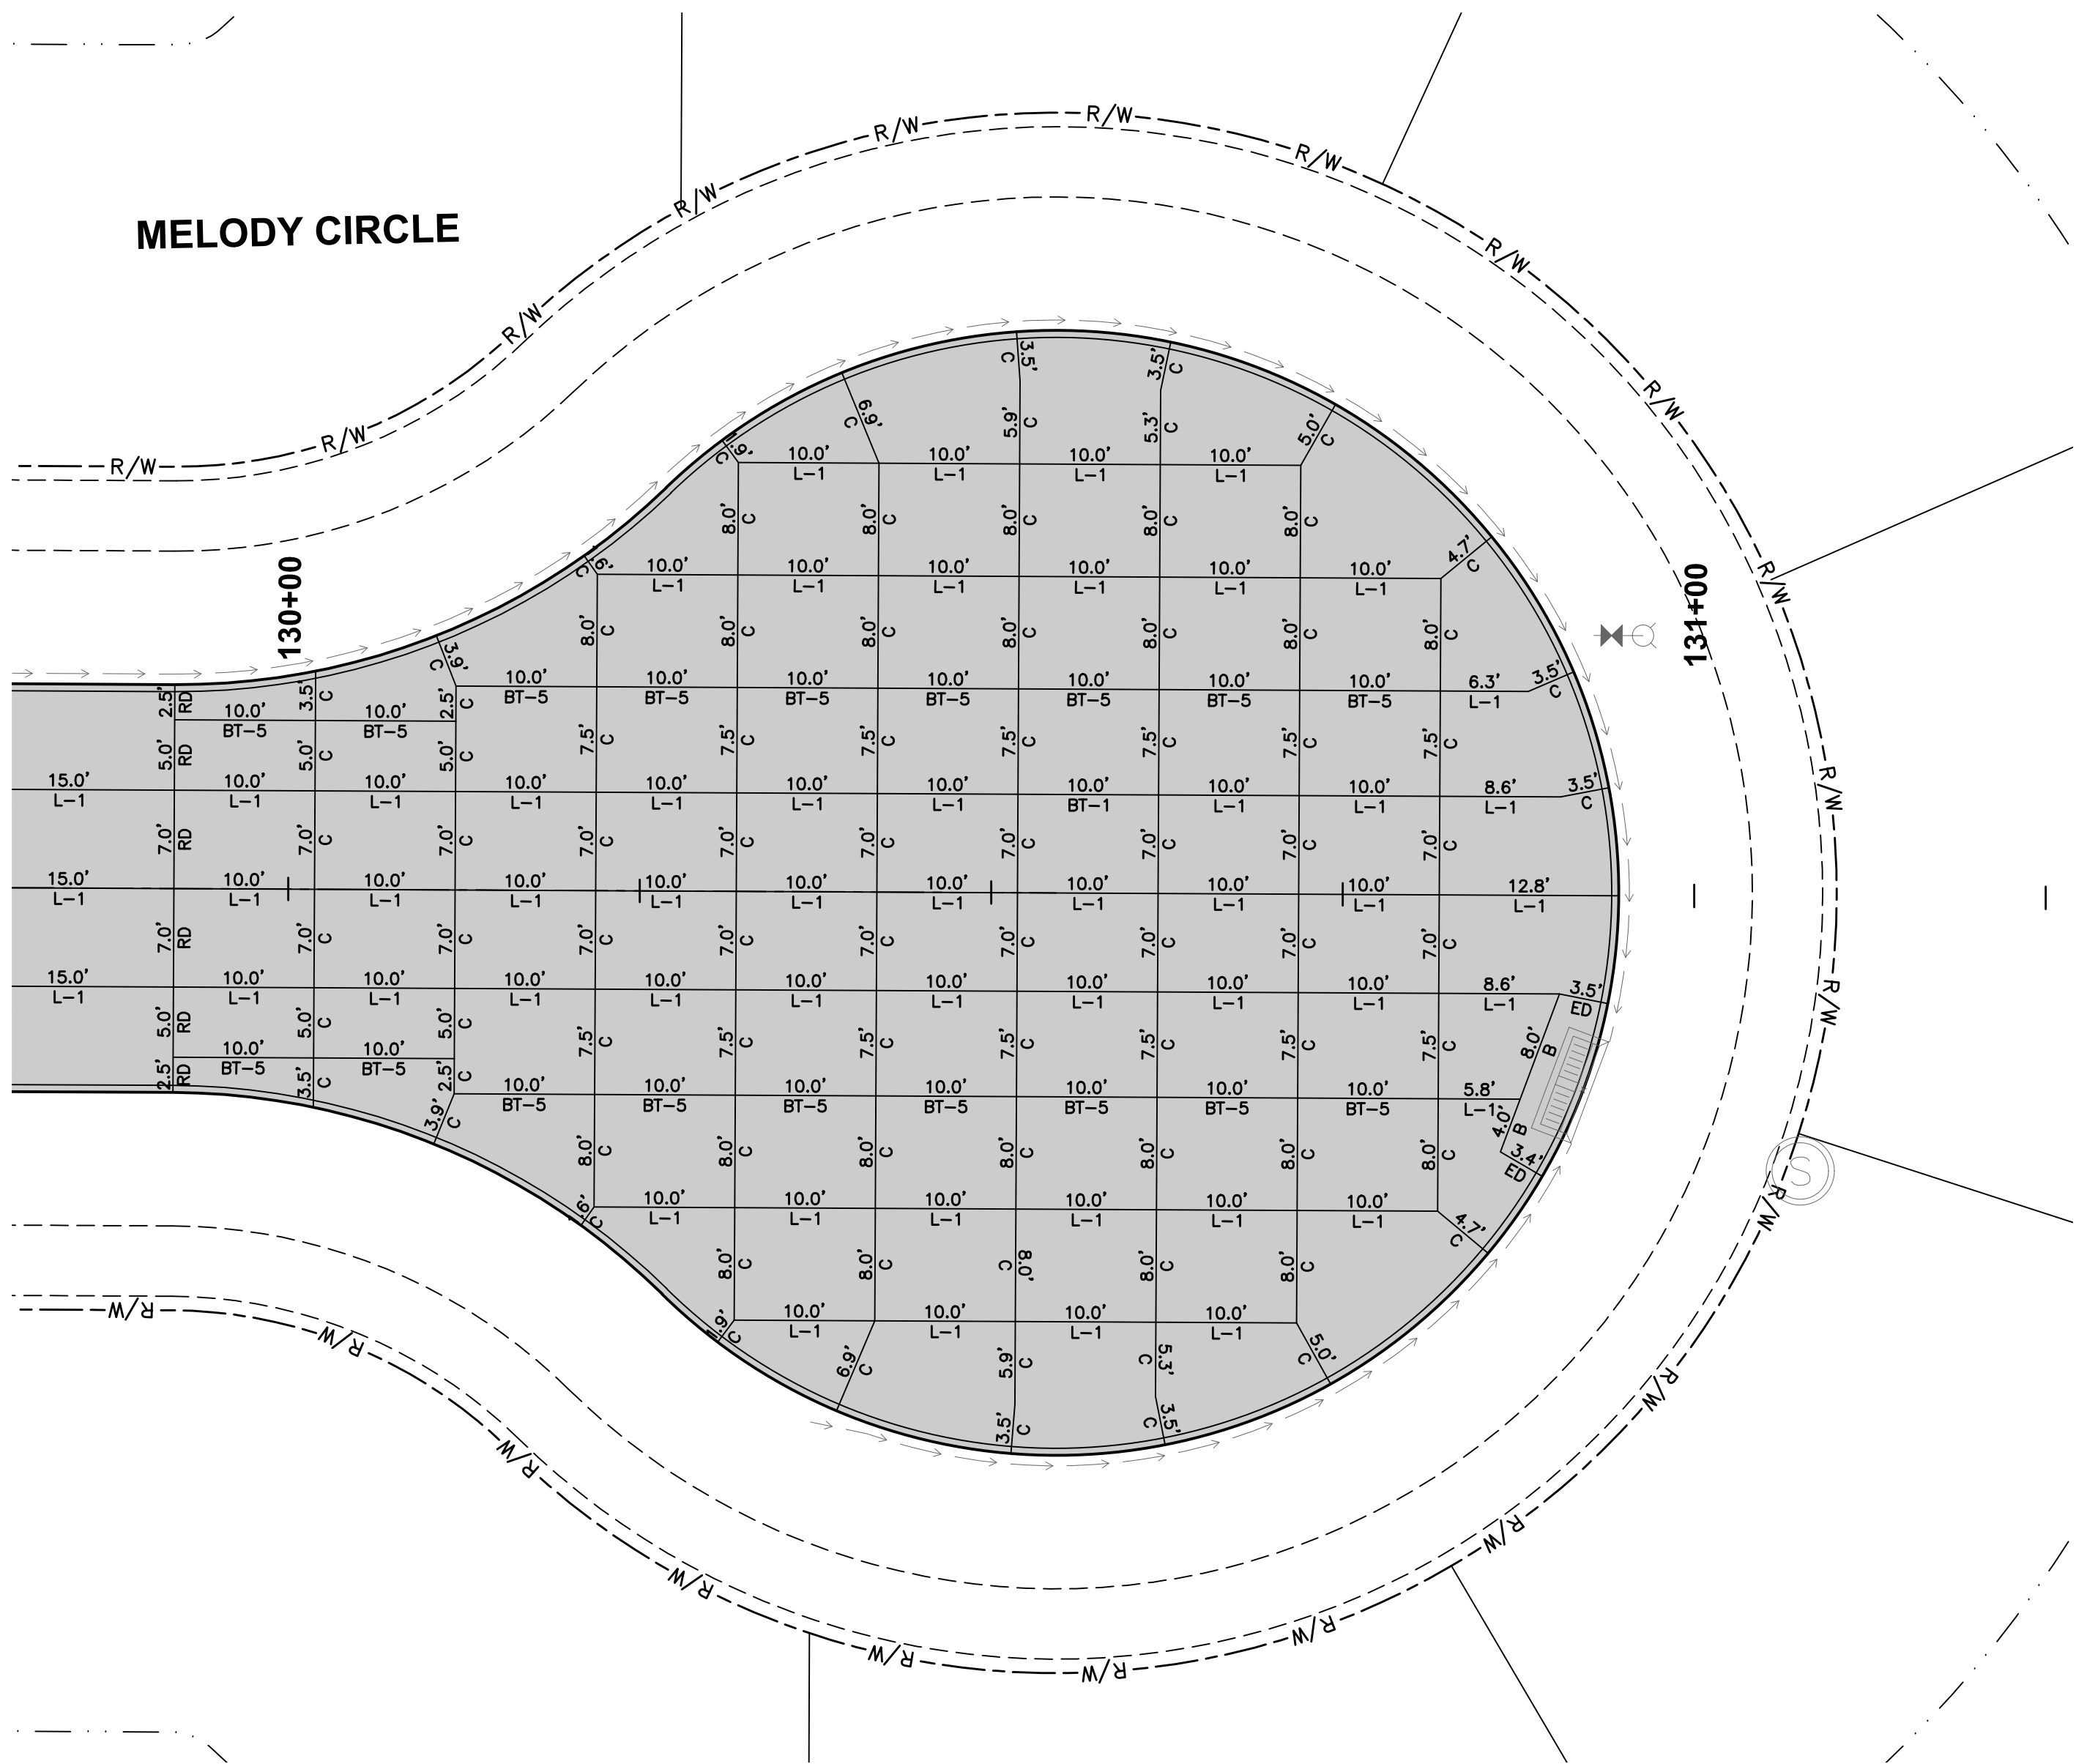

JOINTING LAYOUT

NOTES:

1. ELEVATIONS SHOWN ARE TOP OF SLAB AND/OR FORM GRADE.
2. INSTALL ACCESSIBLE CURB RAMPS AT LOCATIONS SHOWN.
3. REFER TO FIGURE 6010.514 FOR GRATE INTAKE BOXOUT FOR PCC PAVEMENT DETAILS.
4. ORIENT MANHOLE CONE SECTIONS TO KEEP CASTINGS OUT OF SIDEWALK RAMPS.
5. ADD 900 TO FOUR DIGIT SPOT ELEVATIONS TO OBTAIN PROJECT DATUM.

REVISIONS		DATE
AS-BUILT SUBMITTAL	12/29/2021	
FINAL SUBMITTAL	09/02/2021	
THIRD SUBMITTAL	08/18/2021	
SECOND SUBMITTAL	07/27/2021	
FIRST SUBMITTAL	07/13/2021	

HAMILTON RIDGE PLAT 7 INTERSECTION DETAILS		3405 S.E. CROSSROADS DRIVE, SUITE G GRIMES, IOWA 50111 PHONE: (515) 369-4400 FAX: (515) 369-4410
CIVIL DESIGN ADVANTAGE	ENGINEER: EKO	TECH: MST

WAUKEE, IOWA

11/11
2106.480