


CONSTRUCTION PLANS FOR: HAMILTON RIDGE PLAT 6

WAUKEE, IOWA

VICINITY MAP

NOT TO SCALE

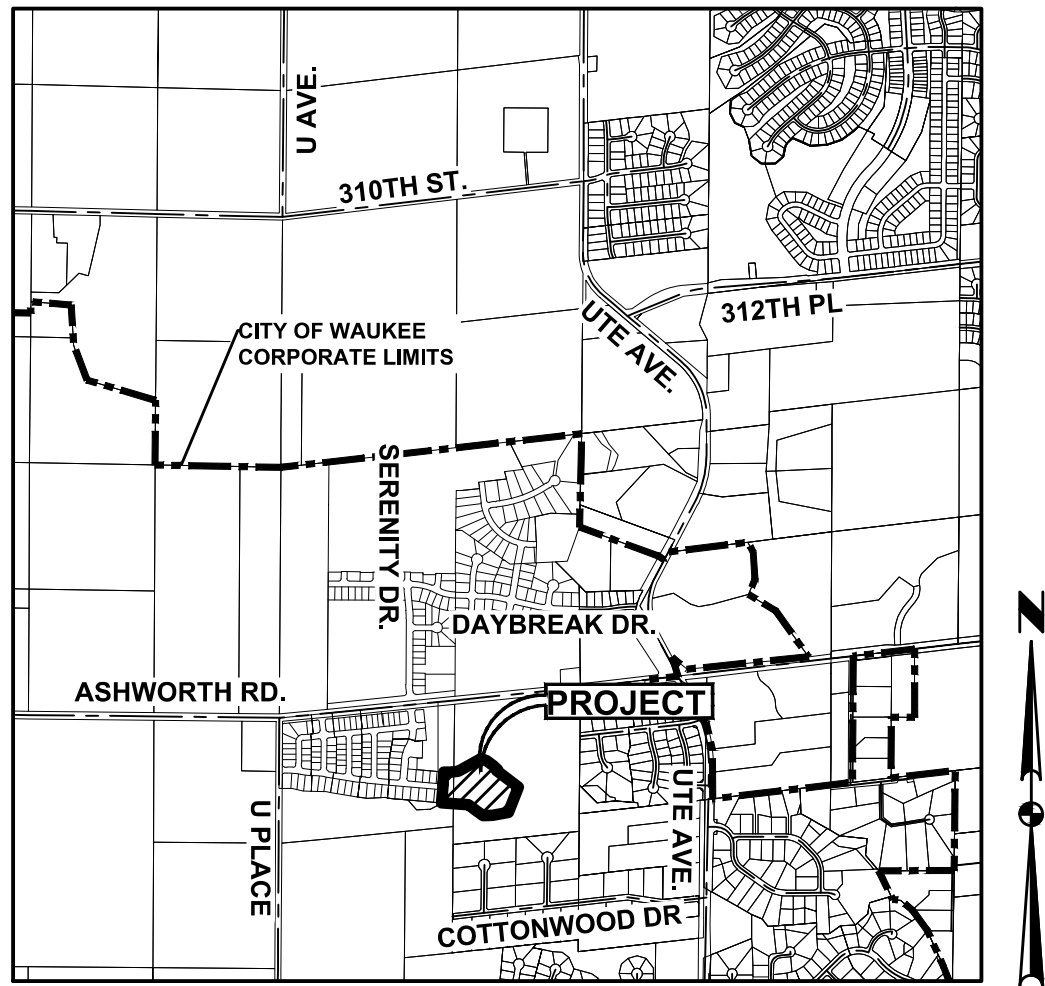

WAUKEE, IOWA

DEVELOPER

LANDMARK DEVELOPMENT SERVICES
9550 HICKMAN ROAD, SUITE 100
CLIVE, IOWA 50325
PH: (515) 986-5994
CONTACT: BILL SPENCER

OWNER

HAMILTON RIDGE, LLC
CONTACT: BILL SPENCER
9550 HICKMAN ROAD, SUITE 100
CLIVE, IA 50325
PH: (515) 986-5994

ENGINEER

CIVIL DESIGN ADVANTAGE
3405 SE CROSSROADS DRIVE, SUITE G
GRIMES, IOWA 50111
CONTACT: ERIN OLLENDIKE
EMAIL: ERINO@CDA-ENG.COM
PH: (515) 369-4400
FX: (515) 369-4410

SURVEYOR

CIVIL DESIGN ADVANTAGE
3405 SE CROSSROADS DRIVE, SUITE G
GRIMES, IOWA 50111
CONTACT: CHARLIE MCGLOTHLEN
EMAIL: CHARLIEM@CDA-ENG.COM
PH: (515) 369-4400
FX: (515) 369-4410

ZONING

R-2: ONE AND TWO-FAMILY
RESIDENTIAL DISTRICT

DATE OF SURVEY:

APRIL 16, 2020

SUBMITTALS

FIRST SUBMITTAL:	07/13/2021
SECOND SUBMITTAL:	07/27/2021
THIRD SUBMITTAL:	08/18/2021
FINAL SUBMITTAL:	09/02/2021
REVISED FINAL SUBMITTAL:	10/05/2021
AS-BUILT SUBMITTAL:	11/01/2022

BULK REGULATIONS

R-2: ONE- AND TWO- FAMILY RESIDENTIAL DISTRICT (LOTS 1-18)

FRONT YARD: 30 FEET
SIDE YARD: A TOTAL OF 15 FEET - ONE SIDE MAY BE REDUCED TO
NOT LESS THAN 7 FEET
REAR YARD: 30 FEET

BENCHMARKS

DALLAS COUNTY BM# G121, EAST SIDE OF R16 0.1 MILE SOUTH OF 300TH
STREET.
ELEVATION=1032.82

BURY BOLT ON HYDRANT @ NW CORNER OF DAYBREAK DRIVE & CREST
RIDGE DRIVE.
ELEVATION=1023.95

CONSTRUCTION SCHEDULE

SPRING 2021 - FALL 2021

DEVELOPMENT SUMMARY

TOTAL AREA OF PLAT 6 = 7.09 ACRES (308,857 SF)

NOTES

- ANY CHANGES PROPOSED TO THE CONSTRUCTION DRAWINGS DURING CONSTRUCTION SHALL BE APPROVED IN WRITING BY THE DEVELOPMENT SERVICES DEPARTMENT.
- THE CONTRACTOR IS RESPONSIBLE FOR ANY CHANGES MADE DURING CONSTRUCTION THAT HAVE NOT BEEN GRANTED APPROVAL IN WRITING BY THE DEVELOPMENT SERVICES DEPARTMENT.
- THE RESULTS OF THE GEOTECHNICAL REPORT ARE TO BE PROVIDED TO THE CITY OF WAUKEE ENGINEERING DEPARTMENT. THE CONSTRUCTION DRAWINGS ARE SUBJECT TO ANY CHANGES REQUIRED BY THE REPORT.

INDEX OF SHEETS

NO.	DESCRIPTION
1	TITLE SHEET
2-4	TYPICAL SECTIONS AND DETAILS
5	QUANTITIES, GENERAL NOTES AND BID ITEM REFERENCE NOTES
6	HYDRANT COVERAGE AND LANDSCAPE PLAN
7-8	GRADING PLAN
9-10	EROSION AND SEDIMENT CONTROL PLAN
11-14	STORM & SANITARY SEWER PLAN AND PROFILE
15-16	WATER MAIN PLAN AND PROFILE
17-18	INTERSECTION DETAILS

AS-BUILT DRAWINGS

AS-BUILT PLANS ARE BASED ON SURVEYED INVERT ELEVATIONS AND INFORMATION SUPPLIED BY THE CONTRACTOR. CIVIL DESIGN ADVANTAGE TAKES NO RESPONSIBILITY FOR UNAUTHORIZED CHANGES TO THE PLANS WITHOUT CITY/OWNER KNOWLEDGE. FIELD VERIFICATION OF UTILITIES OR OTHER PLAN ELEMENTS IS ALWAYS RECOMMENDED.

LEGAL DESCRIPTION

A PART OF OUTLOT 'Z', HERTZ FARM PLAT 1, AN OFFICIAL PLAT IN THE CITY OF WAUKEE, DALLAS COUNTY, IOWA AND MORE PARTICULARLY DESCRIBED AS FOLLOWS:

COMMENCING AT THE SOUTHWEST CORNER OF SAID OUTLOT 'Z'; THENCE NORTH 35°04'48" WEST ALONG THE WESTERLY LINE OF SAID OUTLOT 'Z', 461.90 FEET TO THE POINT OF BEGINNING; THENCE NORTH 86°14'08" WEST CONTINUING ALONG SAID WESTERLY LINE, 277.38 FEET; THENCE NORTH 04°16'39" EAST CONTINUING ALONG SAID WESTERLY LINE, 194.58 FEET; THENCE WESTERLY CONTINUING ALONG SAID WESTERLY LINE AND A CURVE CONCAVE NORTHERLY WHOSE RADIUS IS 670.00 FEET, WHOSE ARC LENGTH IS 2.04 FEET AND WHOSE CHORD BEARS NORTH 85°38'08" WEST, 2.04 FEET; THENCE NORTH 04°27'06" EAST CONTINUING ALONG SAID WESTERLY LINE, 125.00 FEET; THENCE SOUTH 88°56'57" EAST, 64.66 FEET; THENCE NORTH 84°14'56" EAST, 64.66 FEET; THENCE NORTH 77°26'50" EAST, 23.95 FEET; THENCE NORTH 60°50'51" EAST, 263.40 FEET; THENCE SOUTH 70°10'37" EAST, 59.26 FEET; THENCE SOUTH 59°34'04" EAST, 92.81 FEET; THENCE SOUTH 44°24'32" EAST, 60.00 FEET; THENCE SOUTHWESTERLY ALONG A CURVE CONCAVE NORTHWESTERLY WHOSE RADIUS IS 730.00 FEET, WHOSE ARC LENGTH IS 20.54 FEET AND WHOSE CHORD BEARS SOUTH 45°37'14" WEST, 20.54 FEET; THENCE SOUTH 52°35'53" EAST, 281.95 FEET; THENCE SOUTH 21°16'43" WEST, 280.80 FEET; THENCE SOUTH 80°43'43" WEST, 166.74 FEET; THENCE SOUTH 86°58'27" WEST, 96.10 FEET; THENCE NORTH 54°40'48" WEST, 88.15 FEET; THENCE NORTH 52°13'27" WEST, 101.85 FEET TO THE POINT OF BEGINNING AND CONTAINING 7.09 ACRES (308,857 SQUARE FEET).

THE PROPERTY IS SUBJECT TO ANY AND ALL EASEMENTS OF RECORD.

UTILITY WARNING

THE UTILITIES SHOWN HAVE BEEN LOCATED FROM FIELD SURVEY AND RECORDS OBTAINED BY THIS SURVEYOR. THE SURVEYOR MAKES NO GUARANTEE THAT THE UTILITIES SHOWN COMPRISE ALL THE UTILITIES IN THE AREA, EITHER IN SERVICE OR ABANDONED. THE SURVEYOR FURTHER DOES NOT WARRANT THAT THE UTILITIES SHOWN ARE IN THE EXACT LOCATION SHOWN.

GENERAL LEGEND

PROPOSED

SECTION LINE	----
CENTER LINE	----
RIGHT OF WAY	--- R/W ---
PERMANENT EASEMENT	--- P/E ---
TEMPORARY EASEMENT	--- T/E ---
TYPE SW-501 STORM INTAKE	
TYPE SW-503 STORM INTAKE	
TYPE SW-505 STORM INTAKE	
TYPE SW-506 STORM INTAKE	
TYPE SW-513 STORM INTAKE	
TYPE SW-401 STORM MANHOLE	
TYPE SW-402 STORM MANHOLE	
TYPE SW-301 SANITARY MANHOLE	
STORM/SANITARY CLEANOUT	
WATER VALVE	
FIRE HYDRANT ASSEMBLY	
SIGN	
DETECTABLE WARNING PANEL	
WATER CURB STOP	
STORM SEWER STRUCTURE NO.	
STORM SEWER PIPE NO.	
SANITARY SEWER STRUCTURE NO.	
SANITARY SEWER PIPE NO.	
SANITARY SEWER WITH SIZE	
SANITARY SERVICE	
STORM SEWER	
STORM SERVICE	
WATERMAIN WITH SIZE	
WATER SERVICE	
SAWCUT (FULL DEPTH)	
SILT FENCE	
USE AS CONSTRUCTED	(UAC)
TOP OF PROPOSED GROUND	TG
MINIMUM OPENING ELEVATION	MOE
MINIMUM GRADE AT EXPOSED STRUCTURE	MGS

EXISTING

SANITARY MANHOLE	
WATER VALVE BOX	
FIRE HYDRANT	
WATER CURB STOP	
WELL	
STORM SEWER MANHOLE	
STORM SEWER SINGLE INTAKE	
STORM SEWER DOUBLE INTAKE	
FLARED END SECTION	
DECIDUOUS TREE	
CONIFEROUS TREE	
DECIDUOUS SHRUB	
CONIFEROUS SHRUB	
ELECTRIC POWER POLE	
GUY ANCHOR	
STREET LIGHT	
POWER POLE W/ TRANSFORMER	
UTILITY POLE W/ LIGHT	
ELECTRIC BOX	
ELECTRIC TRANSFORMER	
ELECTRIC MANHOLE OR VAULT	
TRAFFIC SIGN	
TELEPHONE JUNCTION BOX	
TELEPHONE MANHOLE/VAULT	
TELEPHONE POLE	
GAS VALVE BOX	
CABLE TV JUNCTION BOX	
CABLE TV MANHOLE/VAULT	
MAIL BOX	
BENCHMARK	
SOIL BORING	
UNDERGROUND TV CABLE	
GAS MAIN	
FIBER OPTIC	
UNDERGROUND TELEPHONE	
OVERHEAD ELECTRIC	
UNDERGROUND ELECTRIC	
FIELD TILE	
SANITARY SEWER W/ SIZE	
STORM SEWER W/ SIZE	
WATER MAIN W/ SIZE	

ALL CONSTRUCTION SHALL CONFORM TO THE PROJECT SPECIFICATIONS AND THE SOILS REPORT PREPARED BY CONSTRUCTION MATERIALS TESTING (CMT).


THIS PROJECT REQUIRES AN IOWA NPDES PERMIT #2. CIVIL DESIGN ADVANTAGE WILL PROVIDE THE PERMITS AND THE INITIAL STORM WATER POLLUTION PREVENTION PLAN (SWPPP) FOR THE CONTRACTORS USE DURING CONSTRUCTION. THE CONTRACTOR SHALL BE RESPONSIBLE FOR UPDATING THE SWPPP THROUGHOUT CONSTRUCTION AND MEETING LOCAL, STATE AND FEDERAL REQUIREMENTS.

THIS DESIGN SPECIFICALLY PREPARED FOR USE AT THE LOCATION SHOWN. USE IN ANY OTHER MANNER EXCEEDS THE INTENDED PURPOSE OF THESE DRAWINGS AND ANY ACCOMPANYING SPECIFICATIONS.

THE 2020 EDITION OF THE CITY OF WAUKEE STANDARD SPECIFICATIONS FOR PUBLIC IMPROVEMENTS AND THE 2021 EDITION OF SUDAS STANDARD SPECIFICATIONS SHALL APPLY TO ALL WORK PERFORMED ON THIS PROJECT EXCEPT AS MODIFIED HEREIN.



1-800-292-8989
www.iowaonecall.com

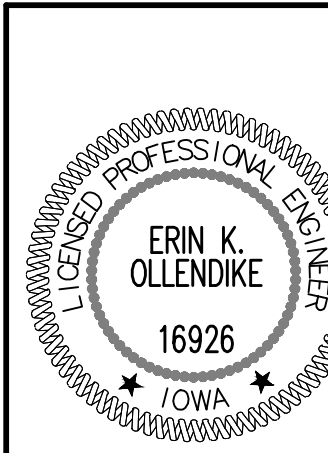

I HEREBY CERTIFY THAT THIS ENGINEERING DOCUMENT WAS PREPARED BY ME OR UNDER MY DIRECT PERSONAL SUPERVISION AND THAT I AM A DULY LICENSED PROFESSIONAL ENGINEER UNDER THE LAWS OF THE STATE OF IOWA.

Erin K. Ollendike


ERIN K. OLLENDIKE, P.E.

12/30/2022




DATE

LICENSE NUMBER 16926
MY LICENSE RENEWAL DATE IS DECEMBER 31, 2021
PAGES OR SHEETS COVERED BY THIS SEAL:


ALL SHEETS

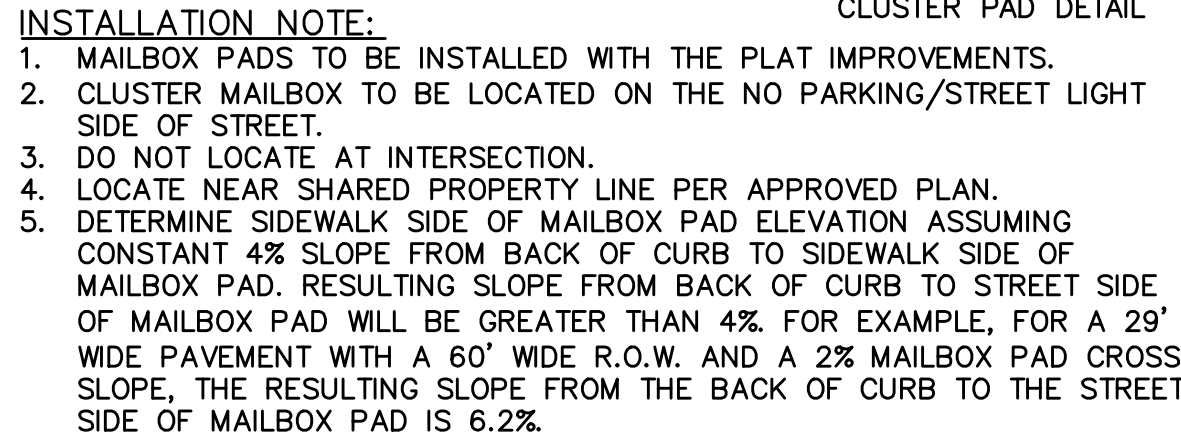

NOT TO SCALE

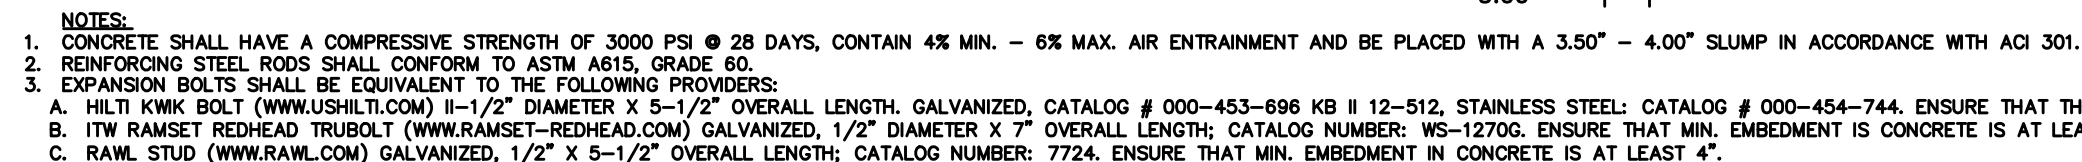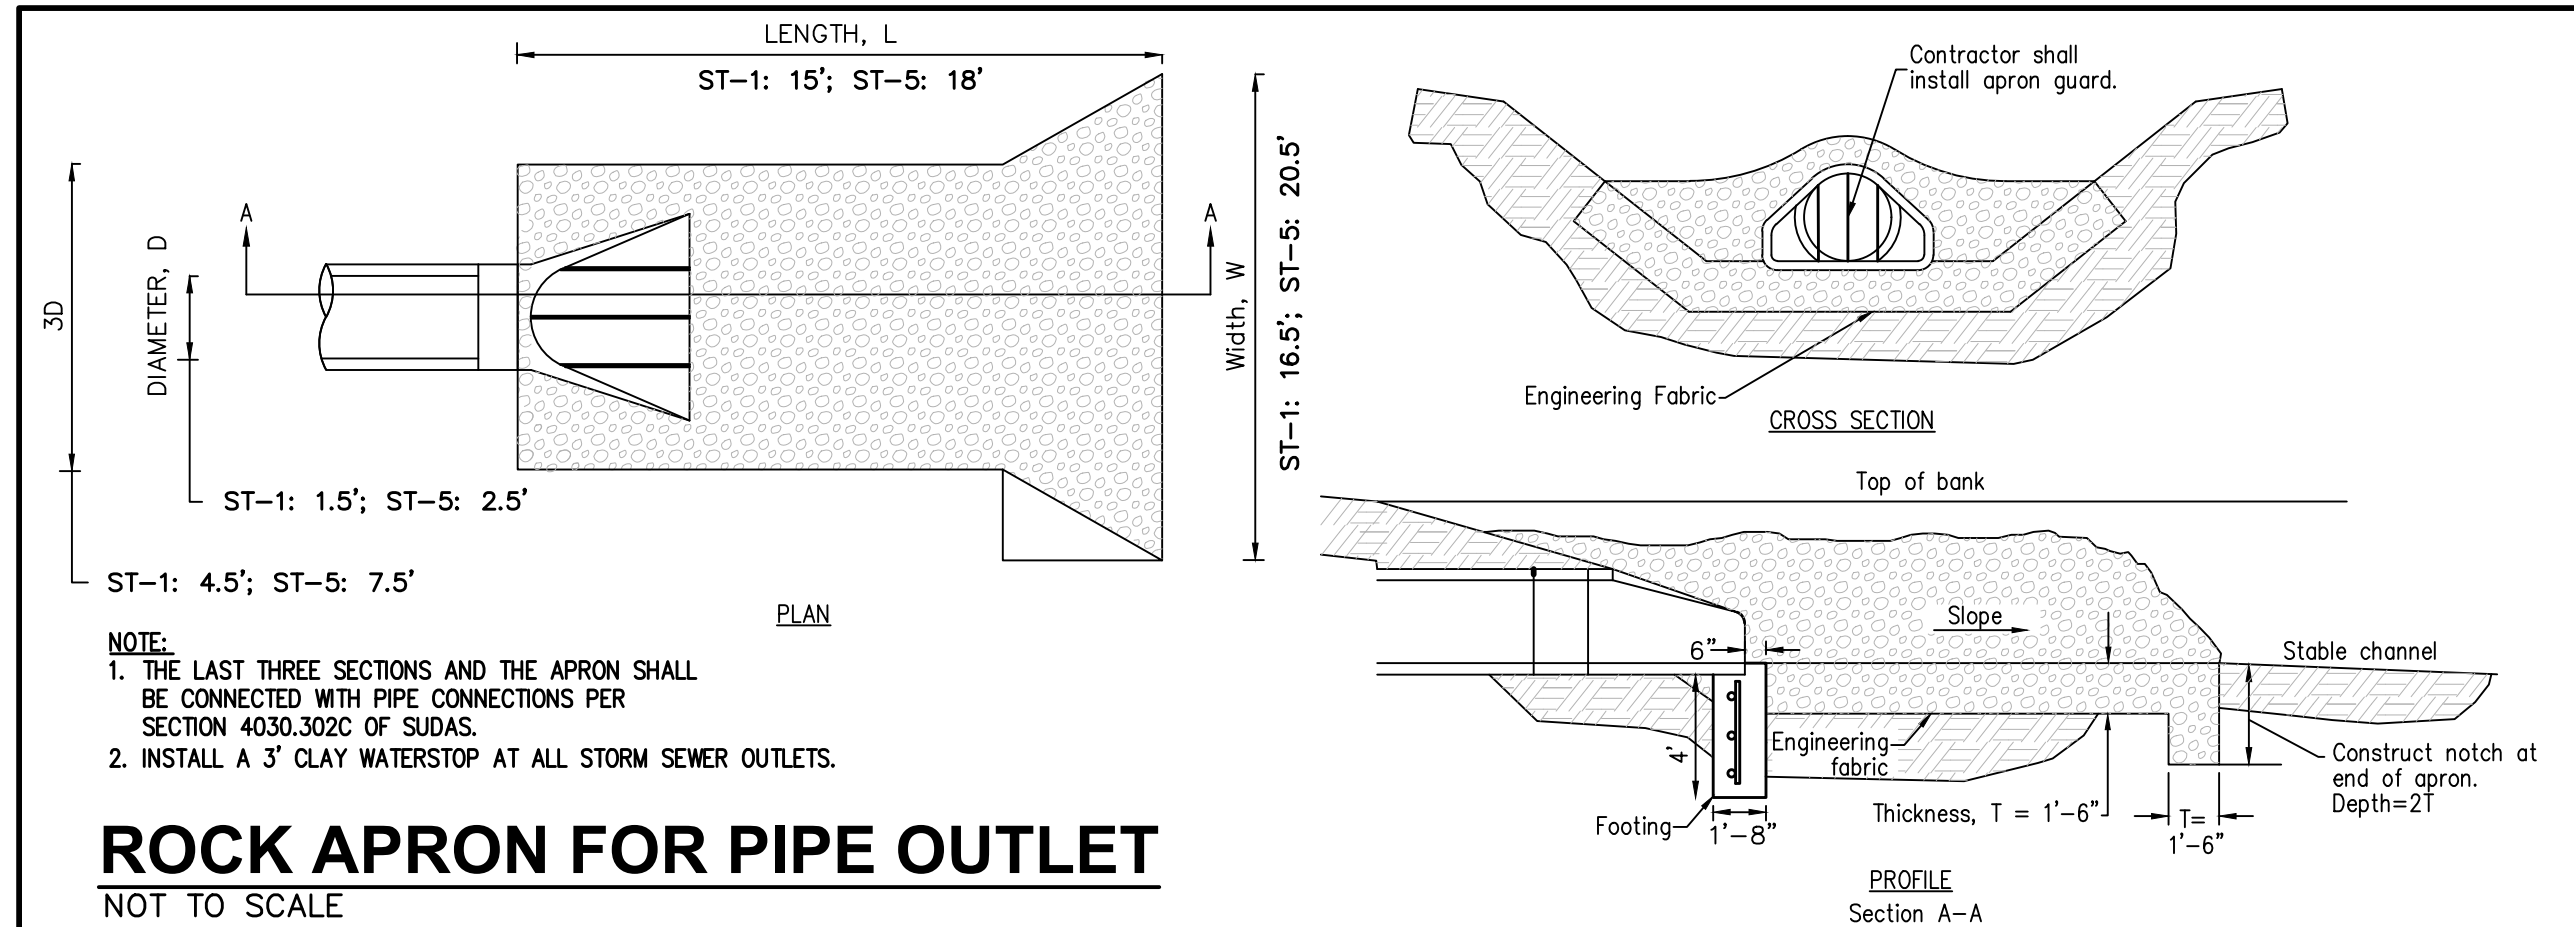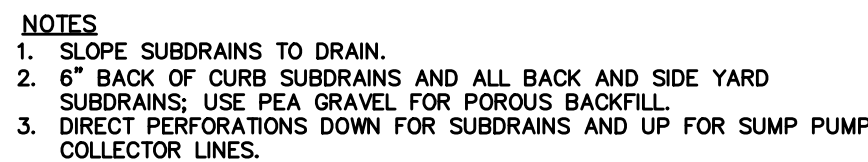


NOT TO SCALE

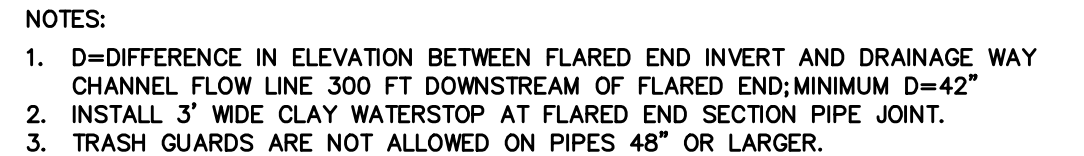









D	W	Mark	Size	Length	Count	D	W	Mark	Size	Length	Count
12"	2'-4"	4f1	4	2'-0"	3	48"	7'-10"	4f1	4	7'-6"	3
		4f2	4	3'-8"	2			4f2	4	3'-8"	6
15"	2'-10"	4f1	4	2'-6"	3	54"	8'-5"	4f1	4	8'-1"	3
		4f2	4	3'-8"	2			4f2	4	3'-8"	6
18"	3'-5"	4f1	4	3'-7"	3	60"	8'-11"	4f1	4	8'-7"	3
		4f2	4	3'-8"	3			4f2	4	3'-8"	6
24"	4'-6"	4f1	4	4'-2"	3	66"	8'-11"	4f1	4	8'-7"	3
		4f2	4	3'-8"	3			4f2	4	3'-8"	6
30"	5'-7"	4f1	4	5'-3"	3	72"	10'-0"	4f1	4	9'-8"	3
		4f2	4	3'-8"	4			4f2	4	3'-8"	7
36"	6'-8"	4f1	4	6'-4"	3	78"	10'-7"	4f1	4	10'-3"	3
		4f2	4	3'-8"	5			4f2	4	3'-8"	7
42"	7'-3"	4f1	4	6'-11"	3	84"	11'-1"	4f1	4	10'-9"	3
		4f2	4	3'-8"	5			4f2	4	3'-8"	8




NOT TO SCALE

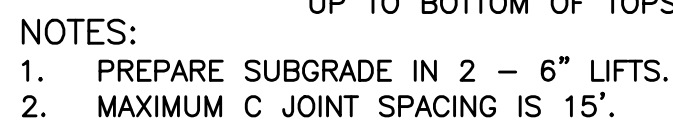

NOT TO SCALE

HARRINGTON WAY, CANTERBURY CIRCLE

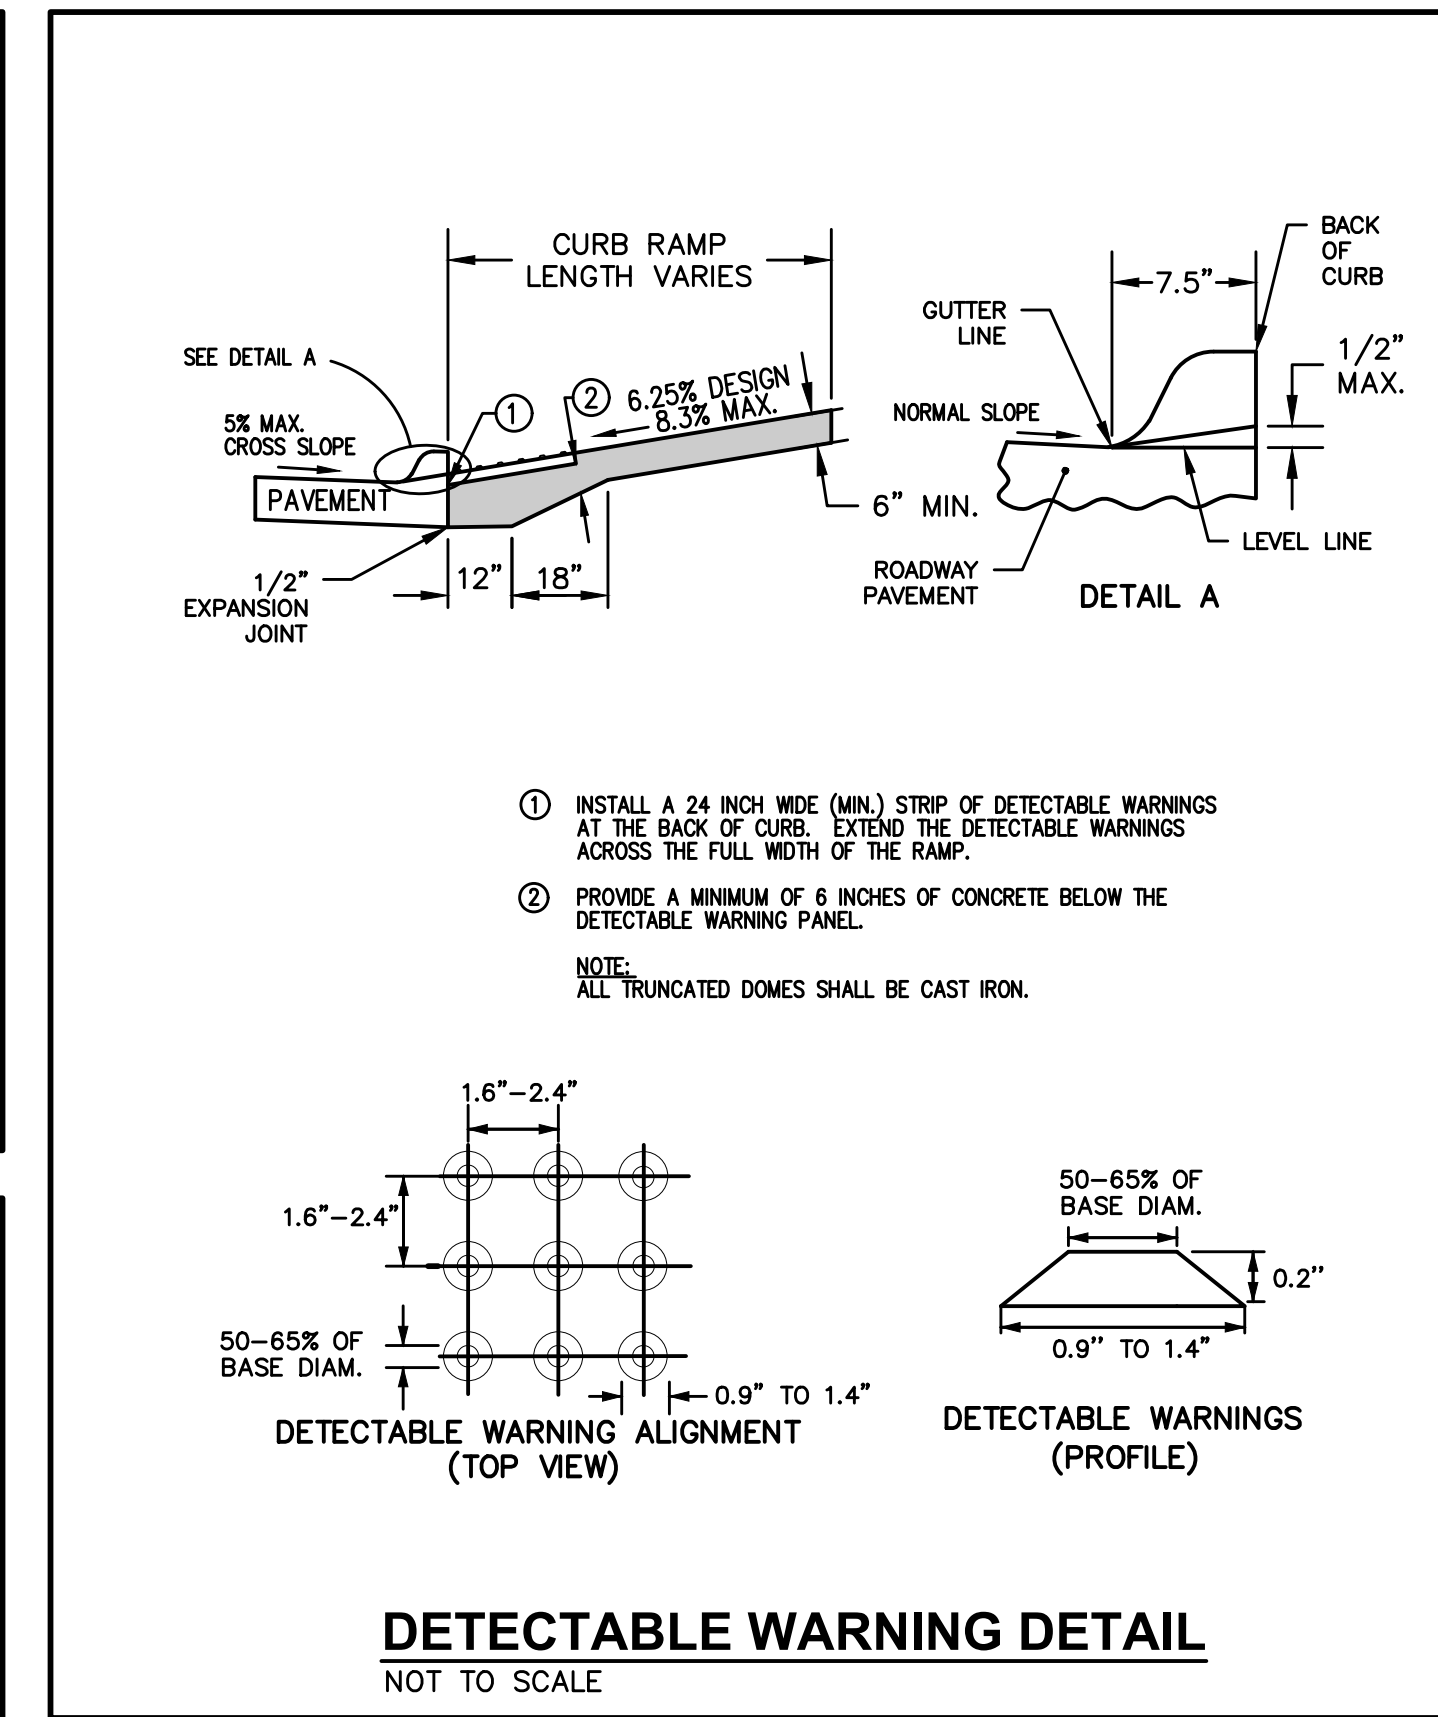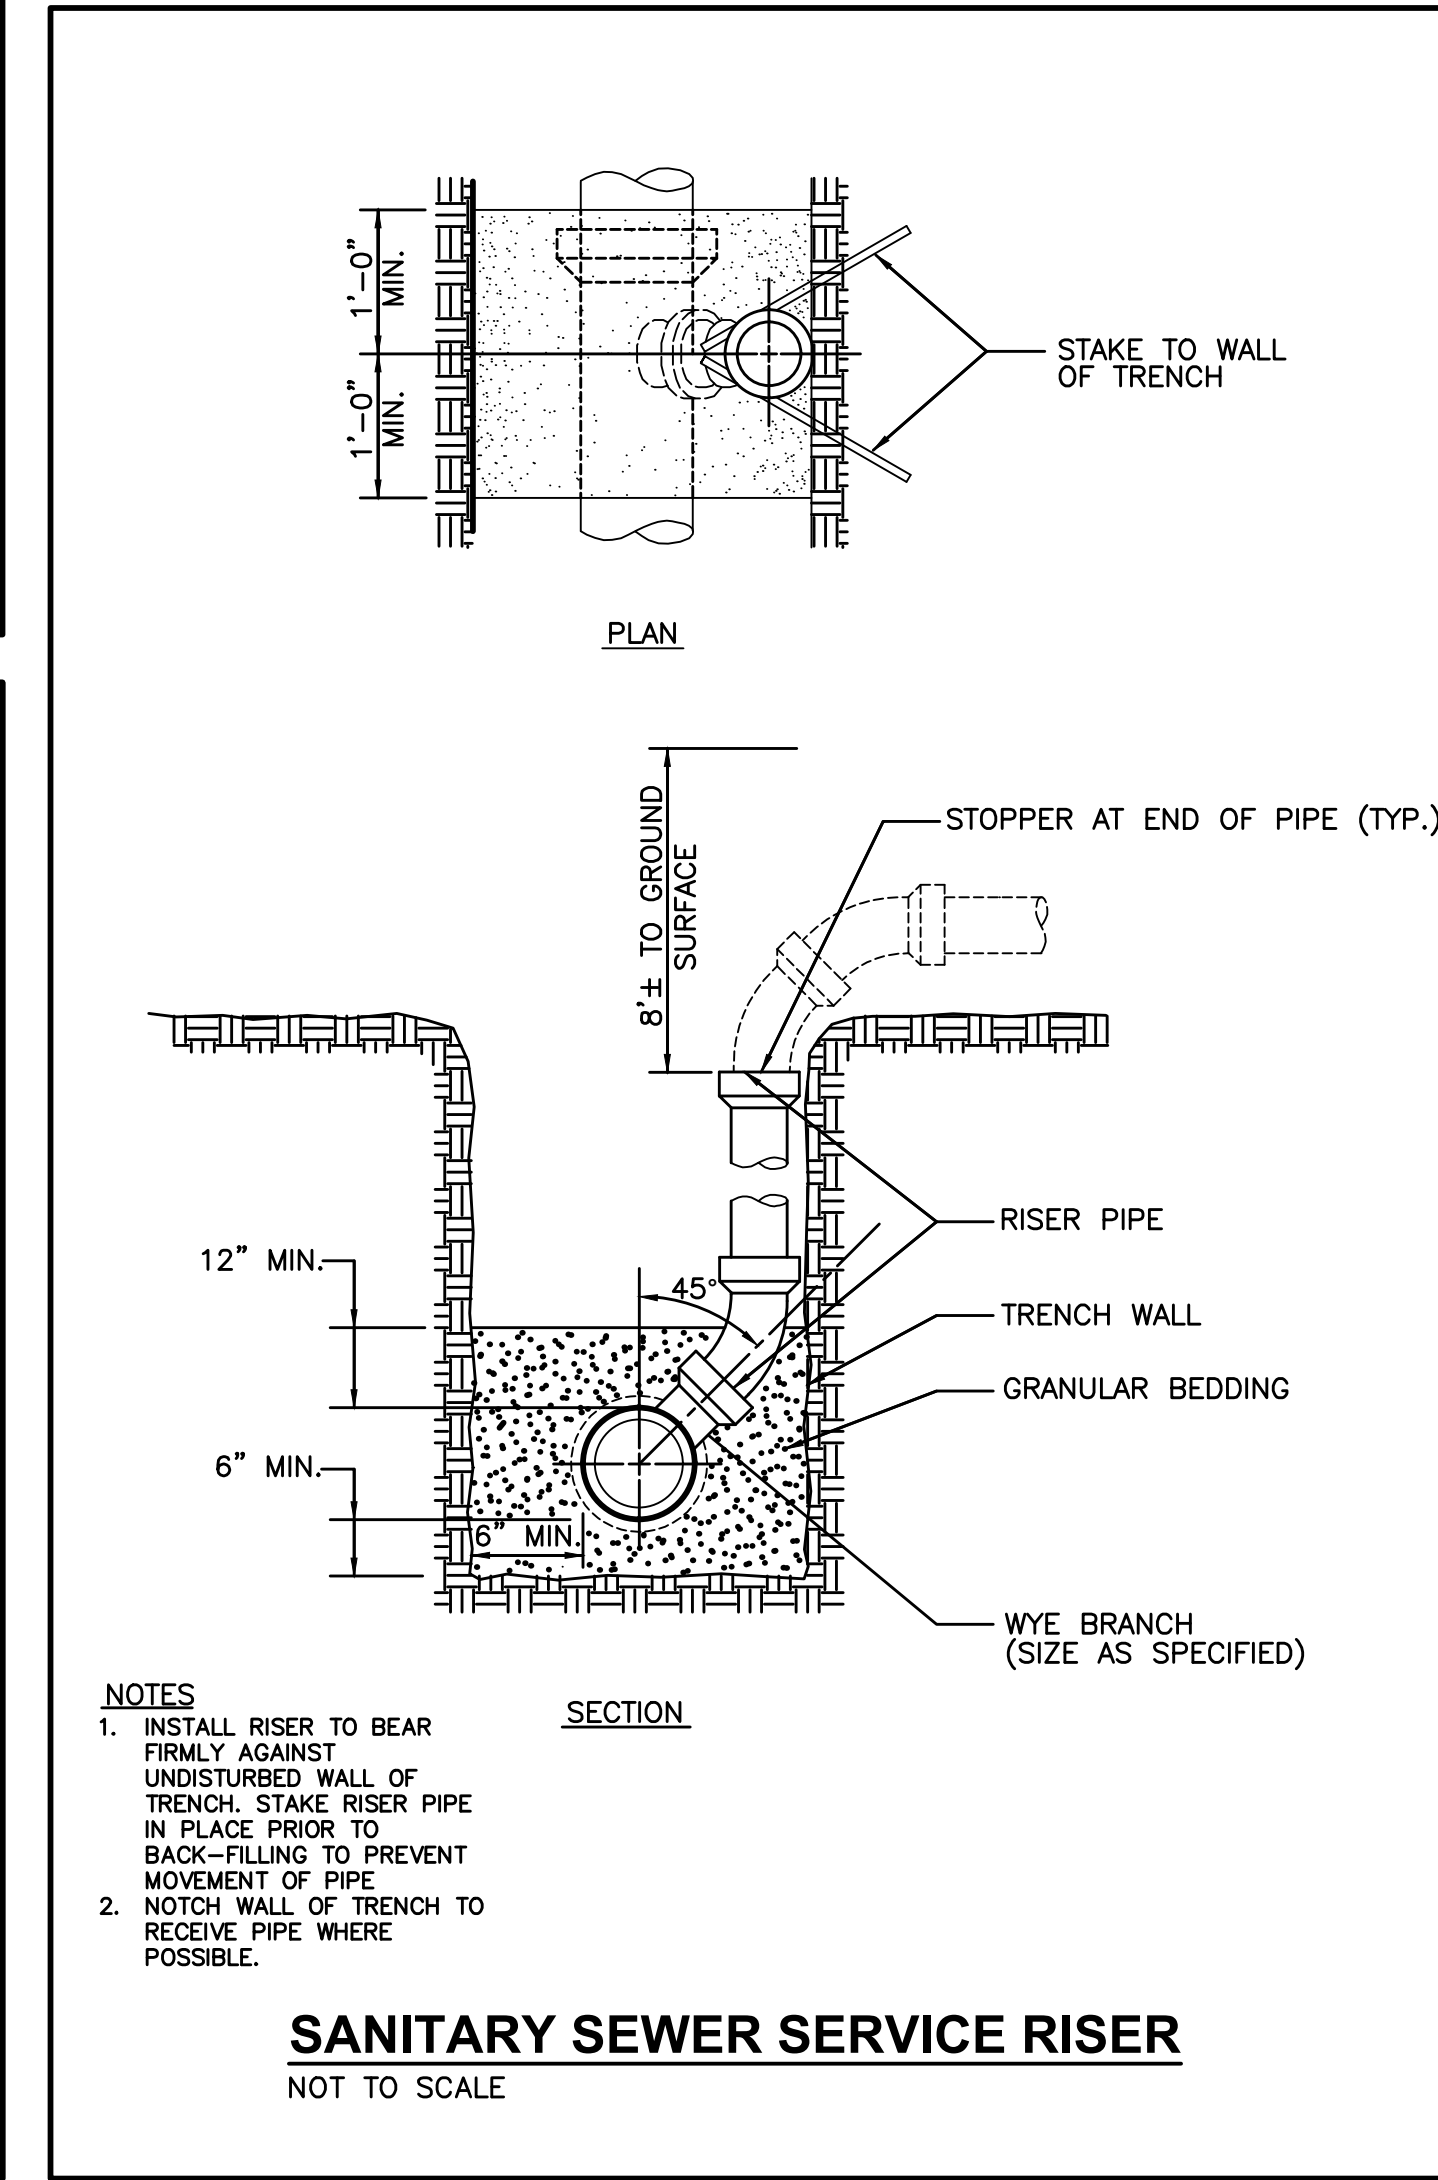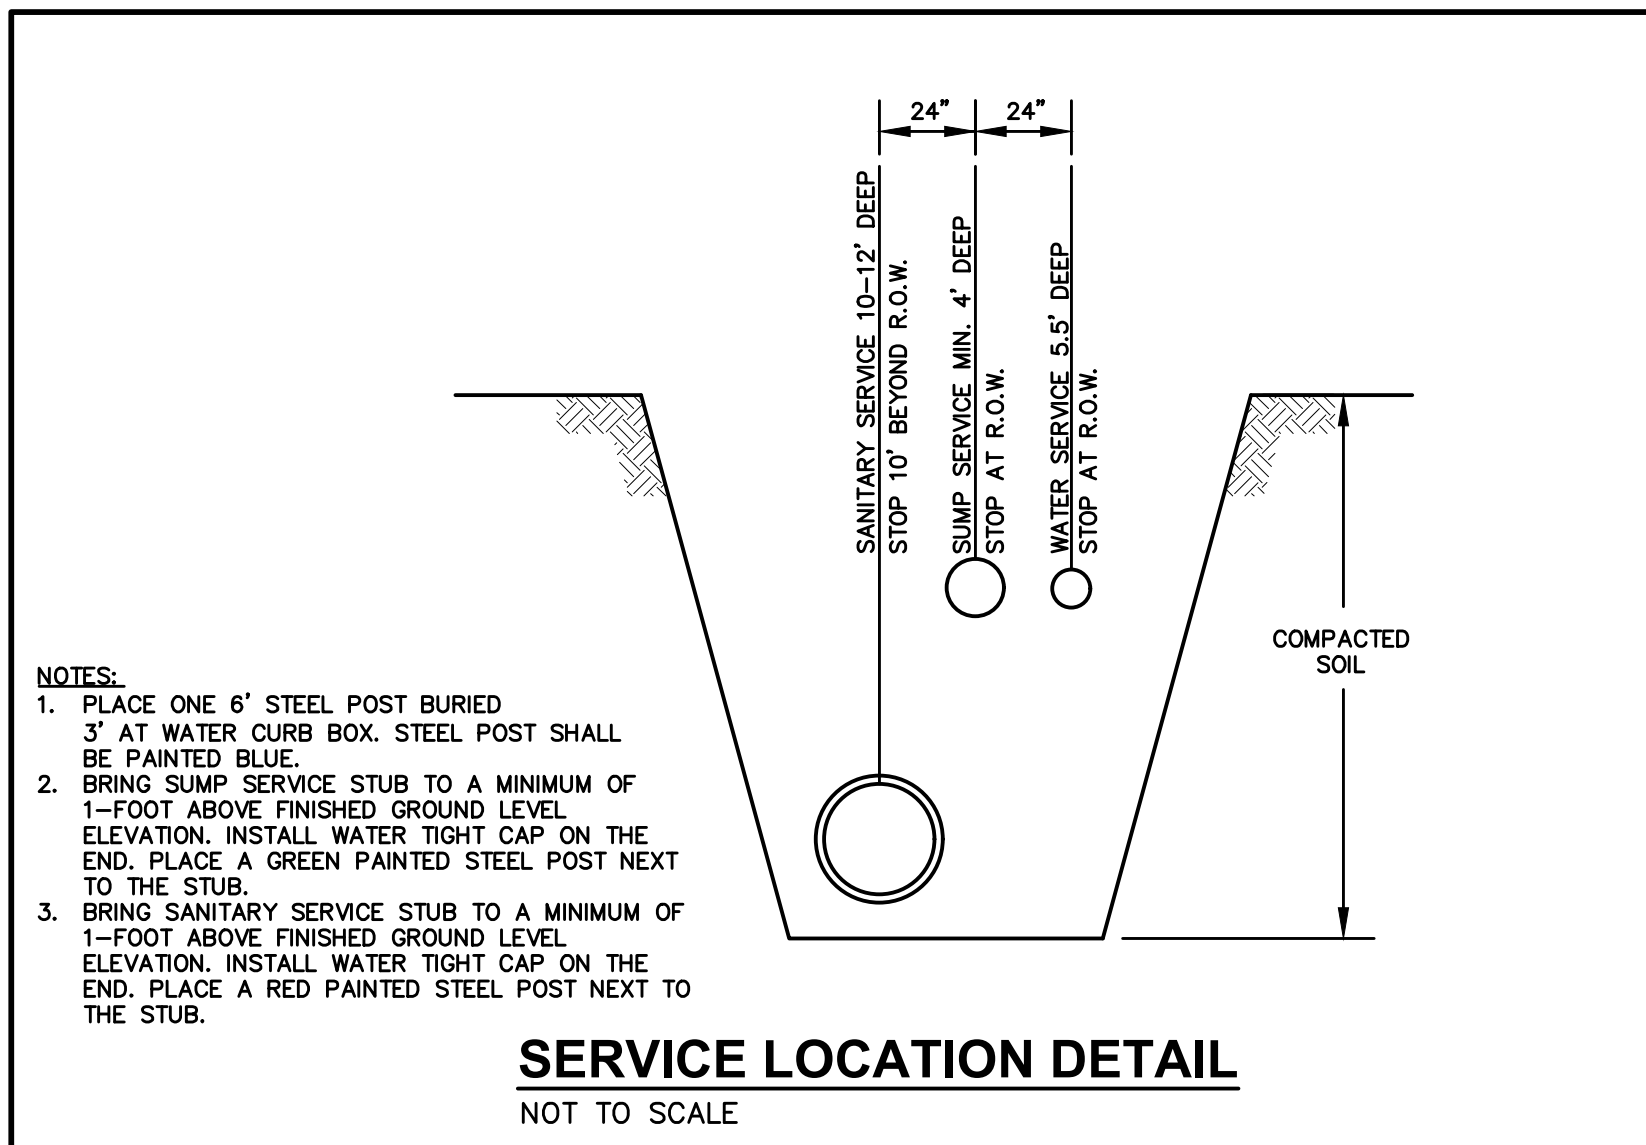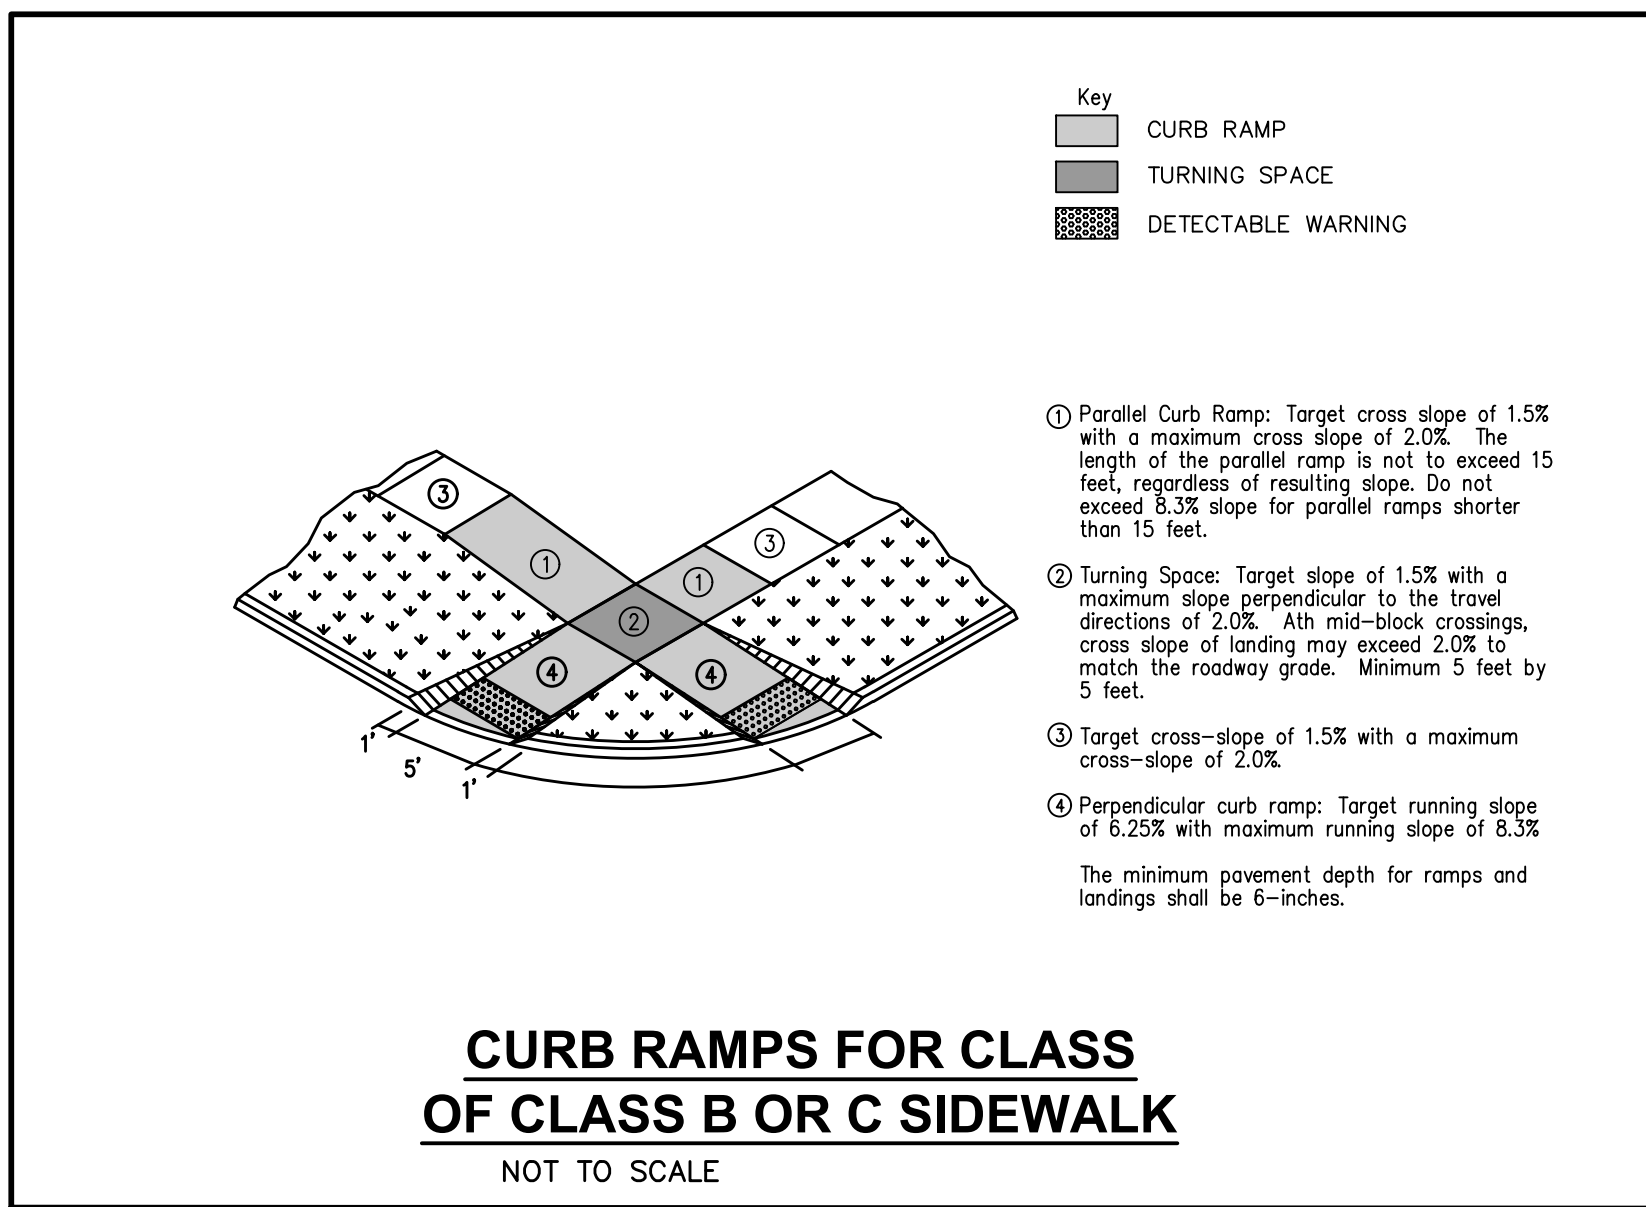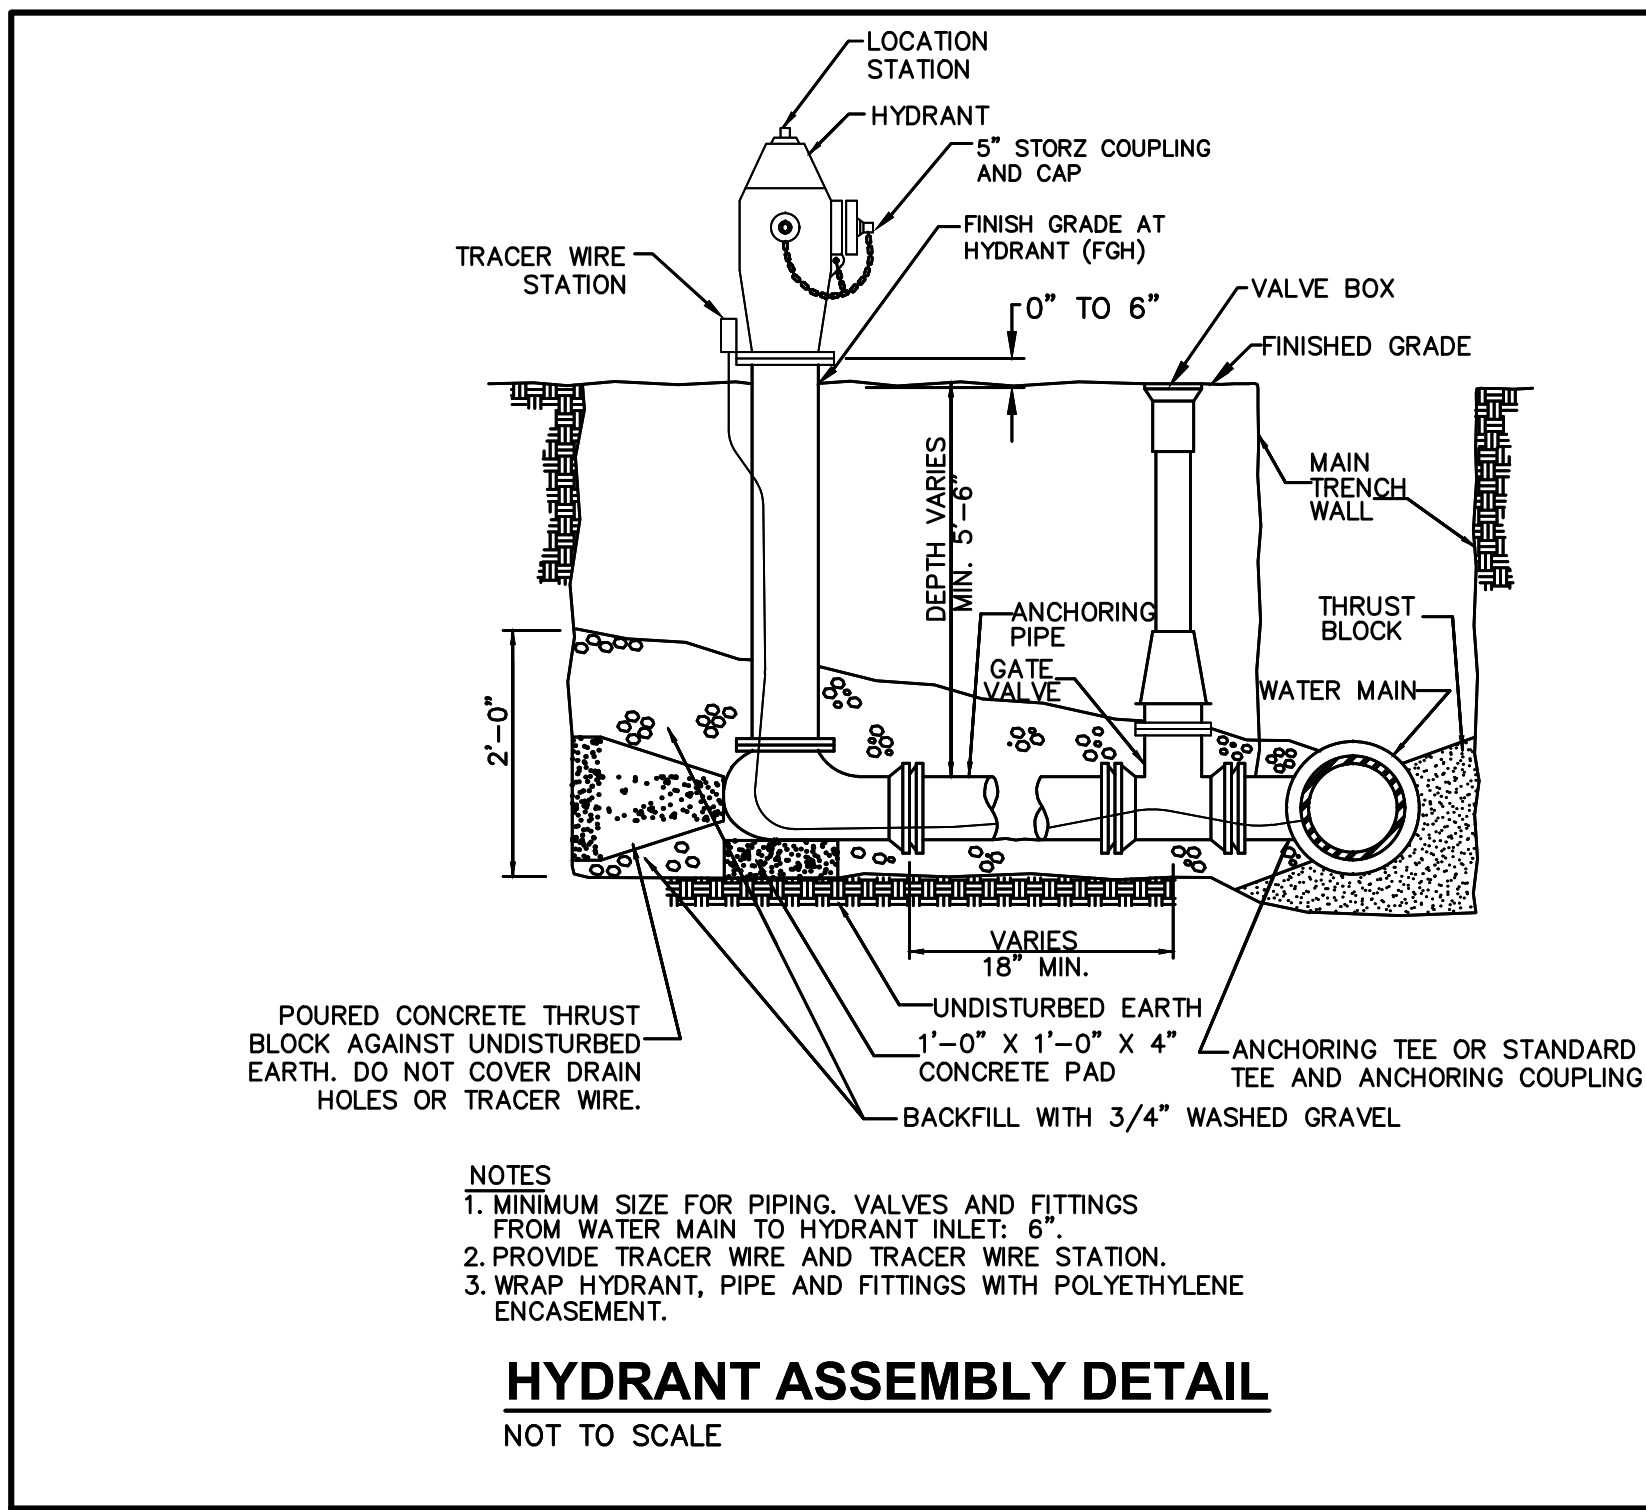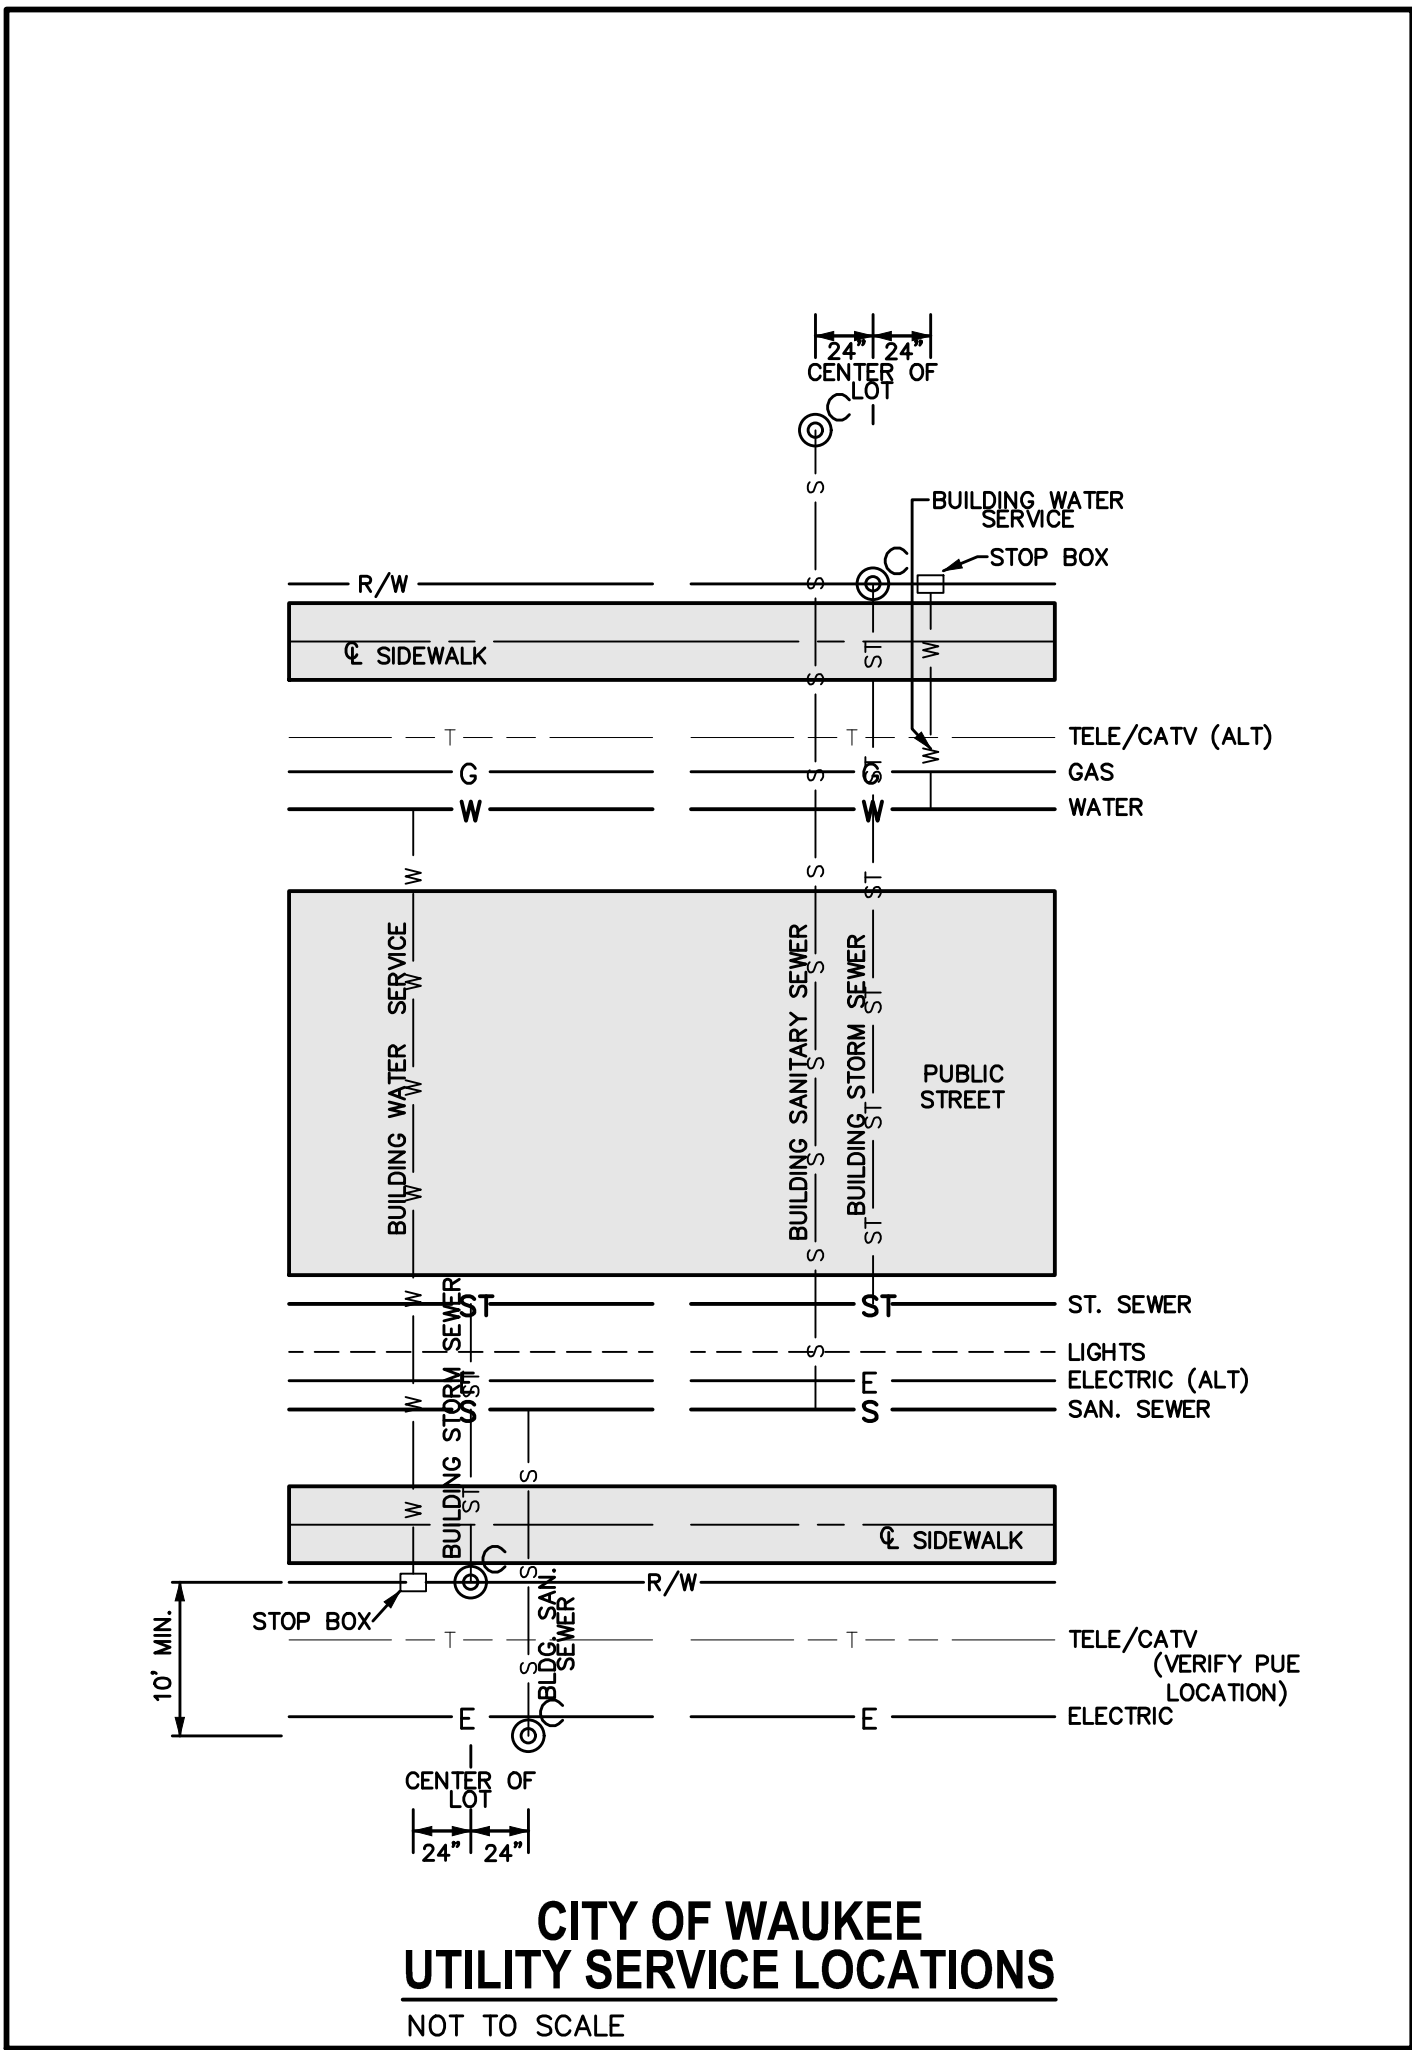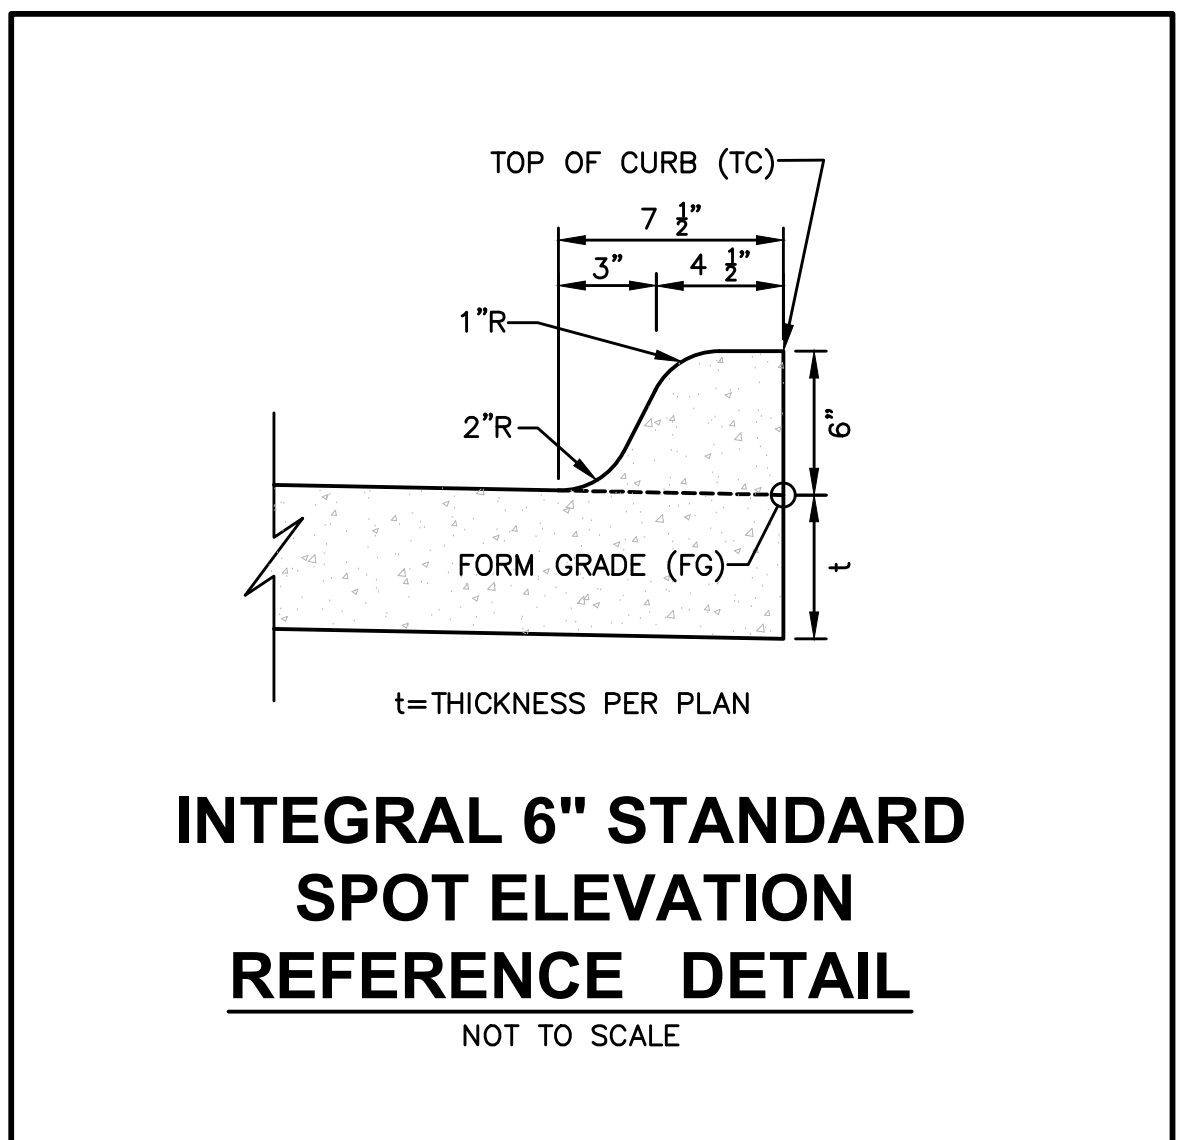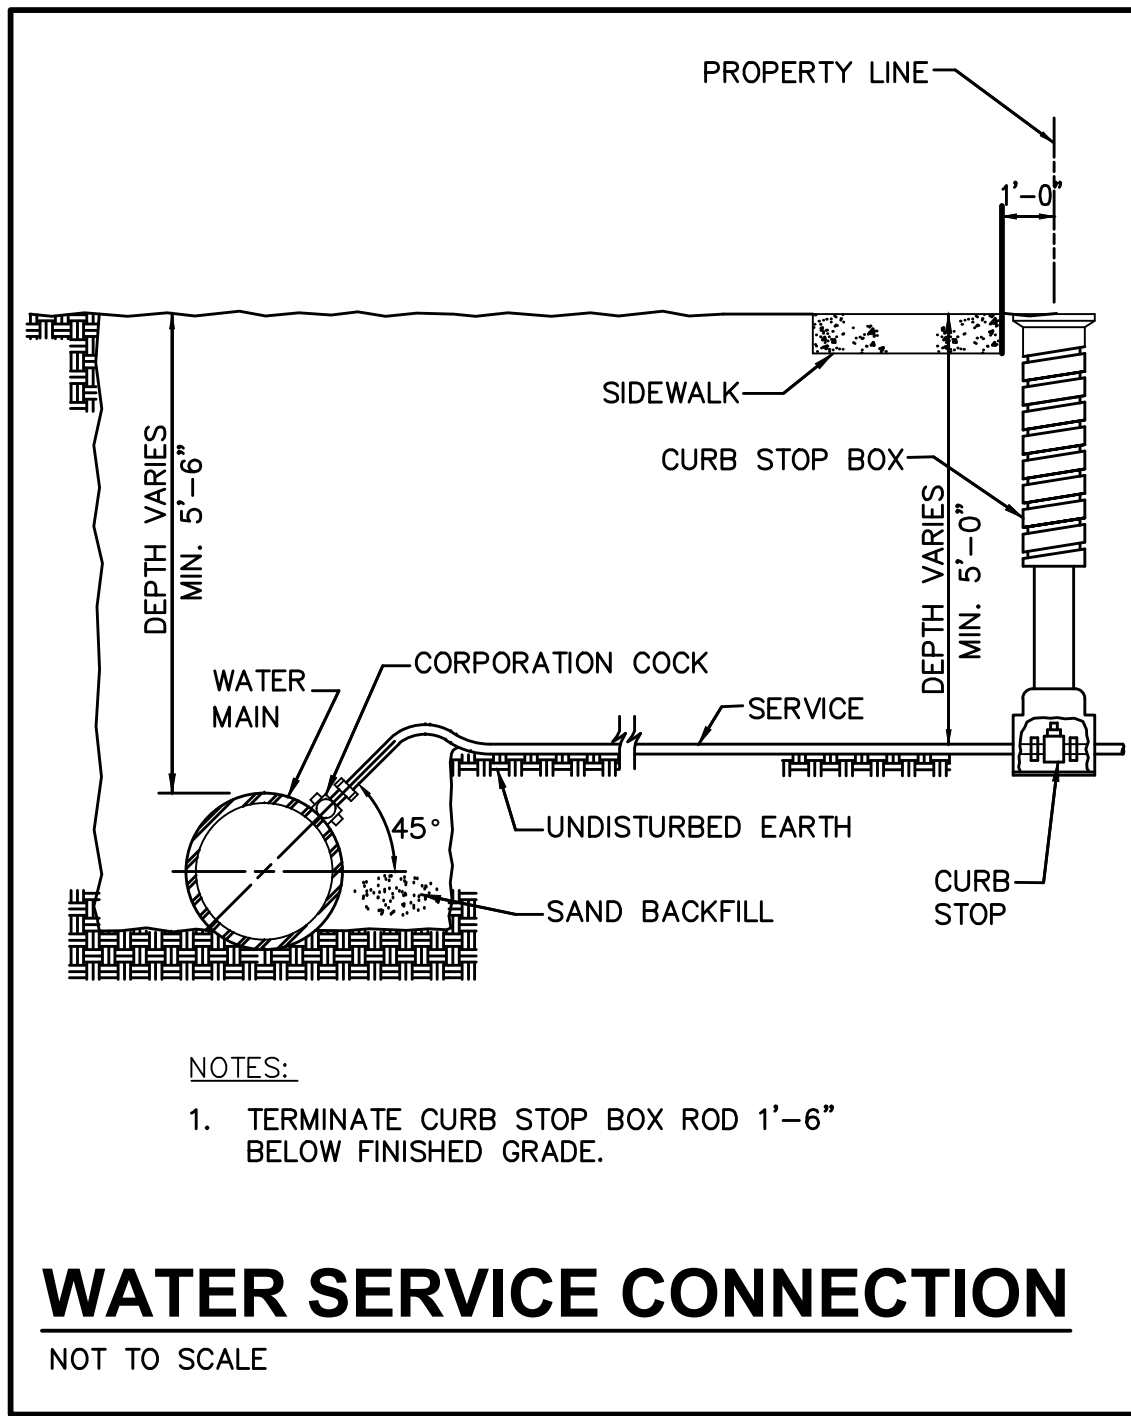

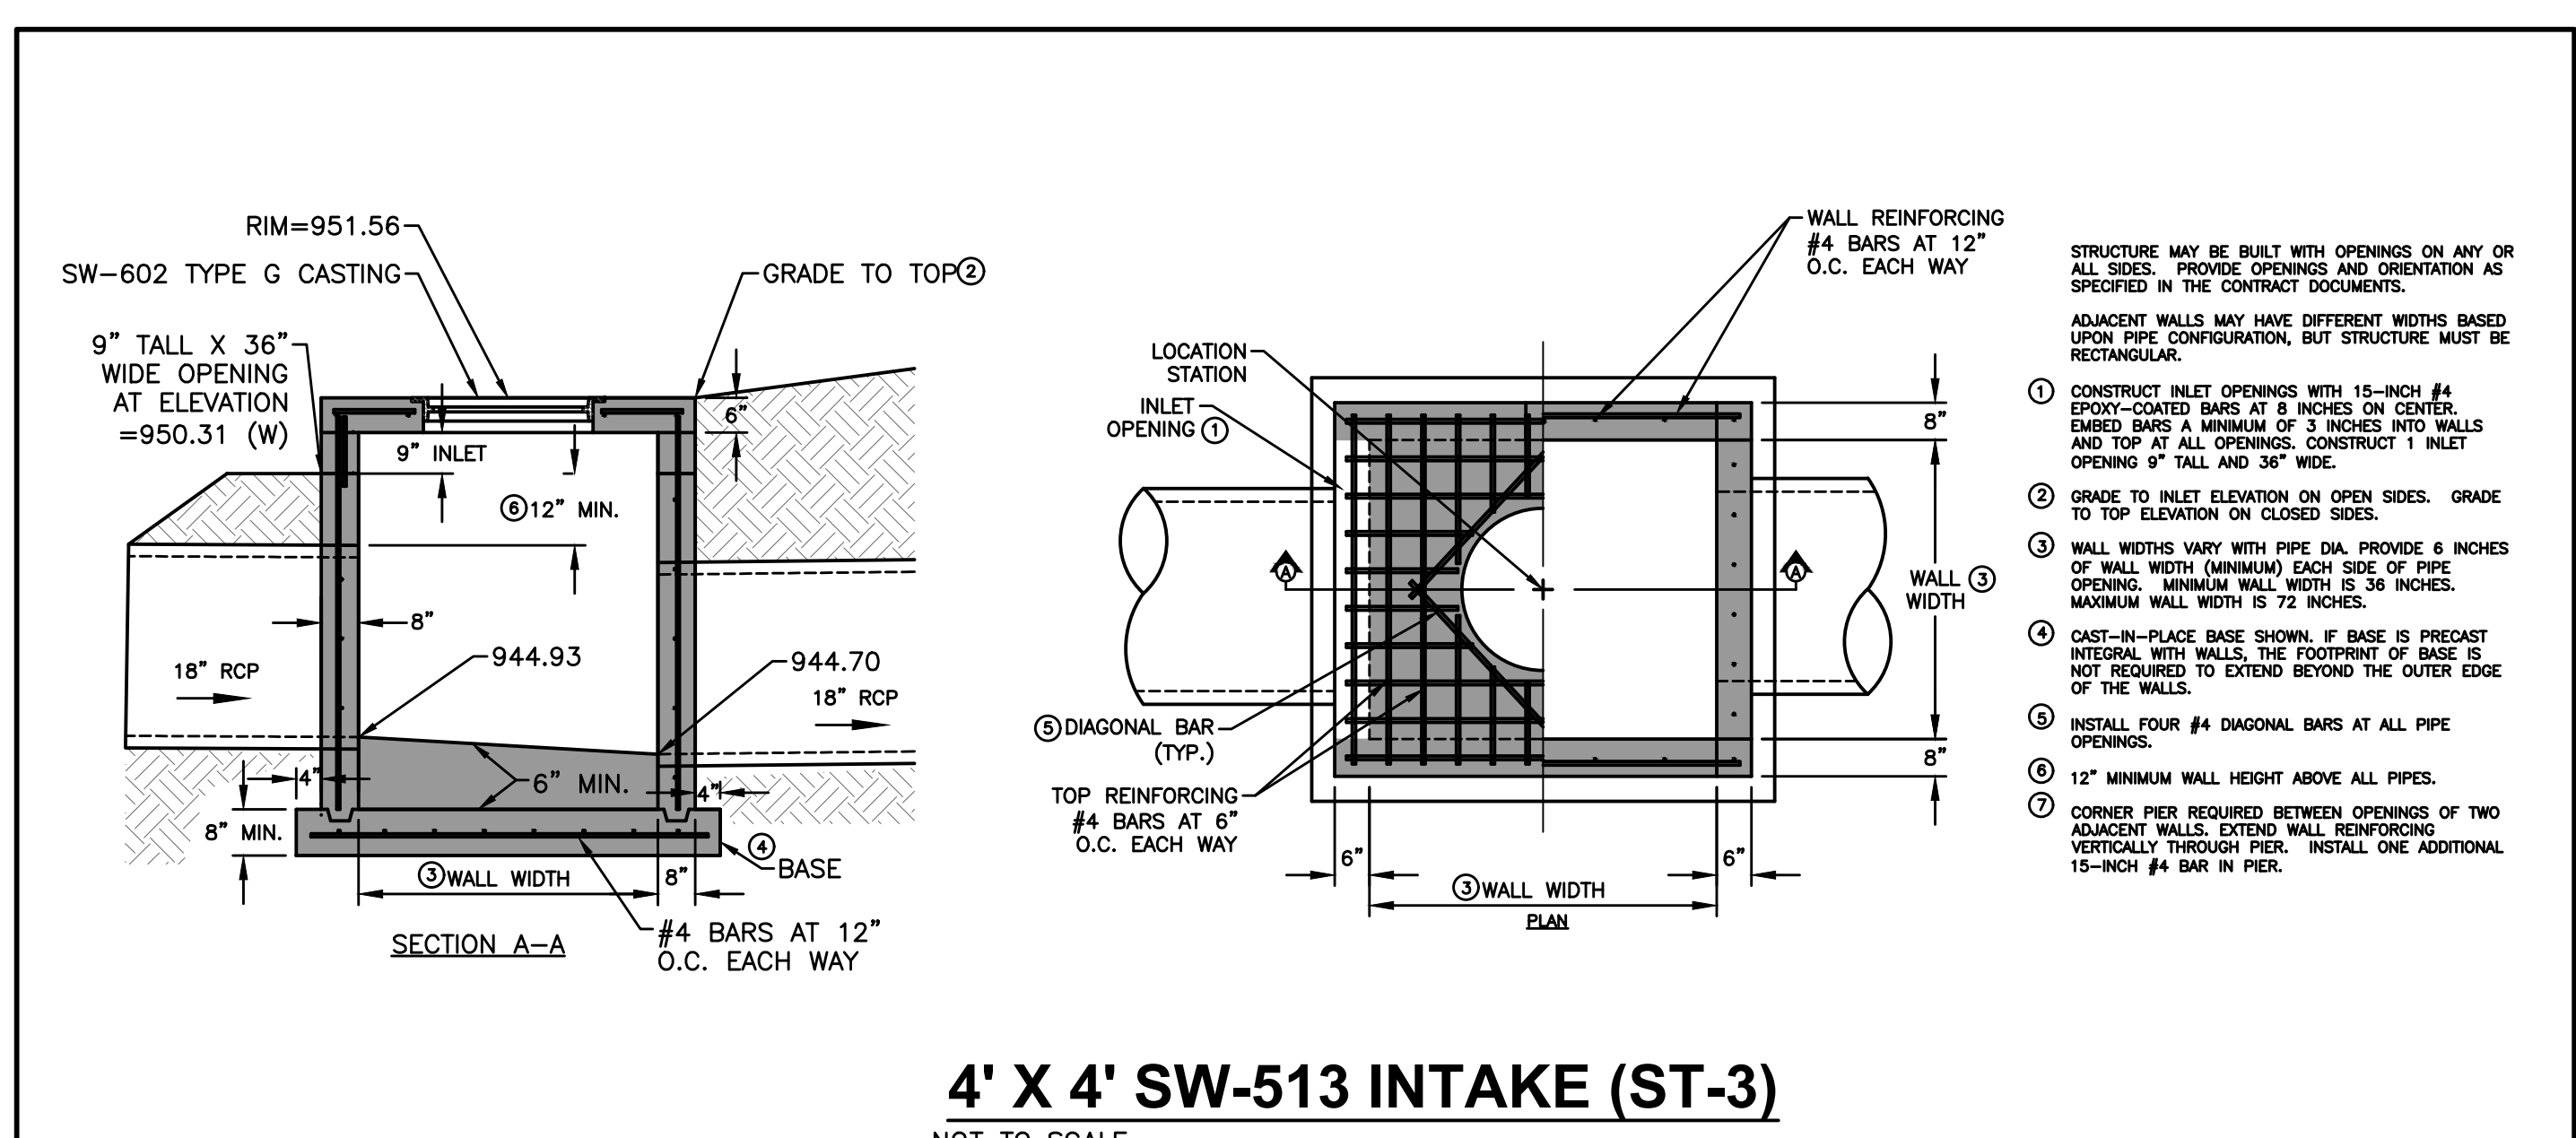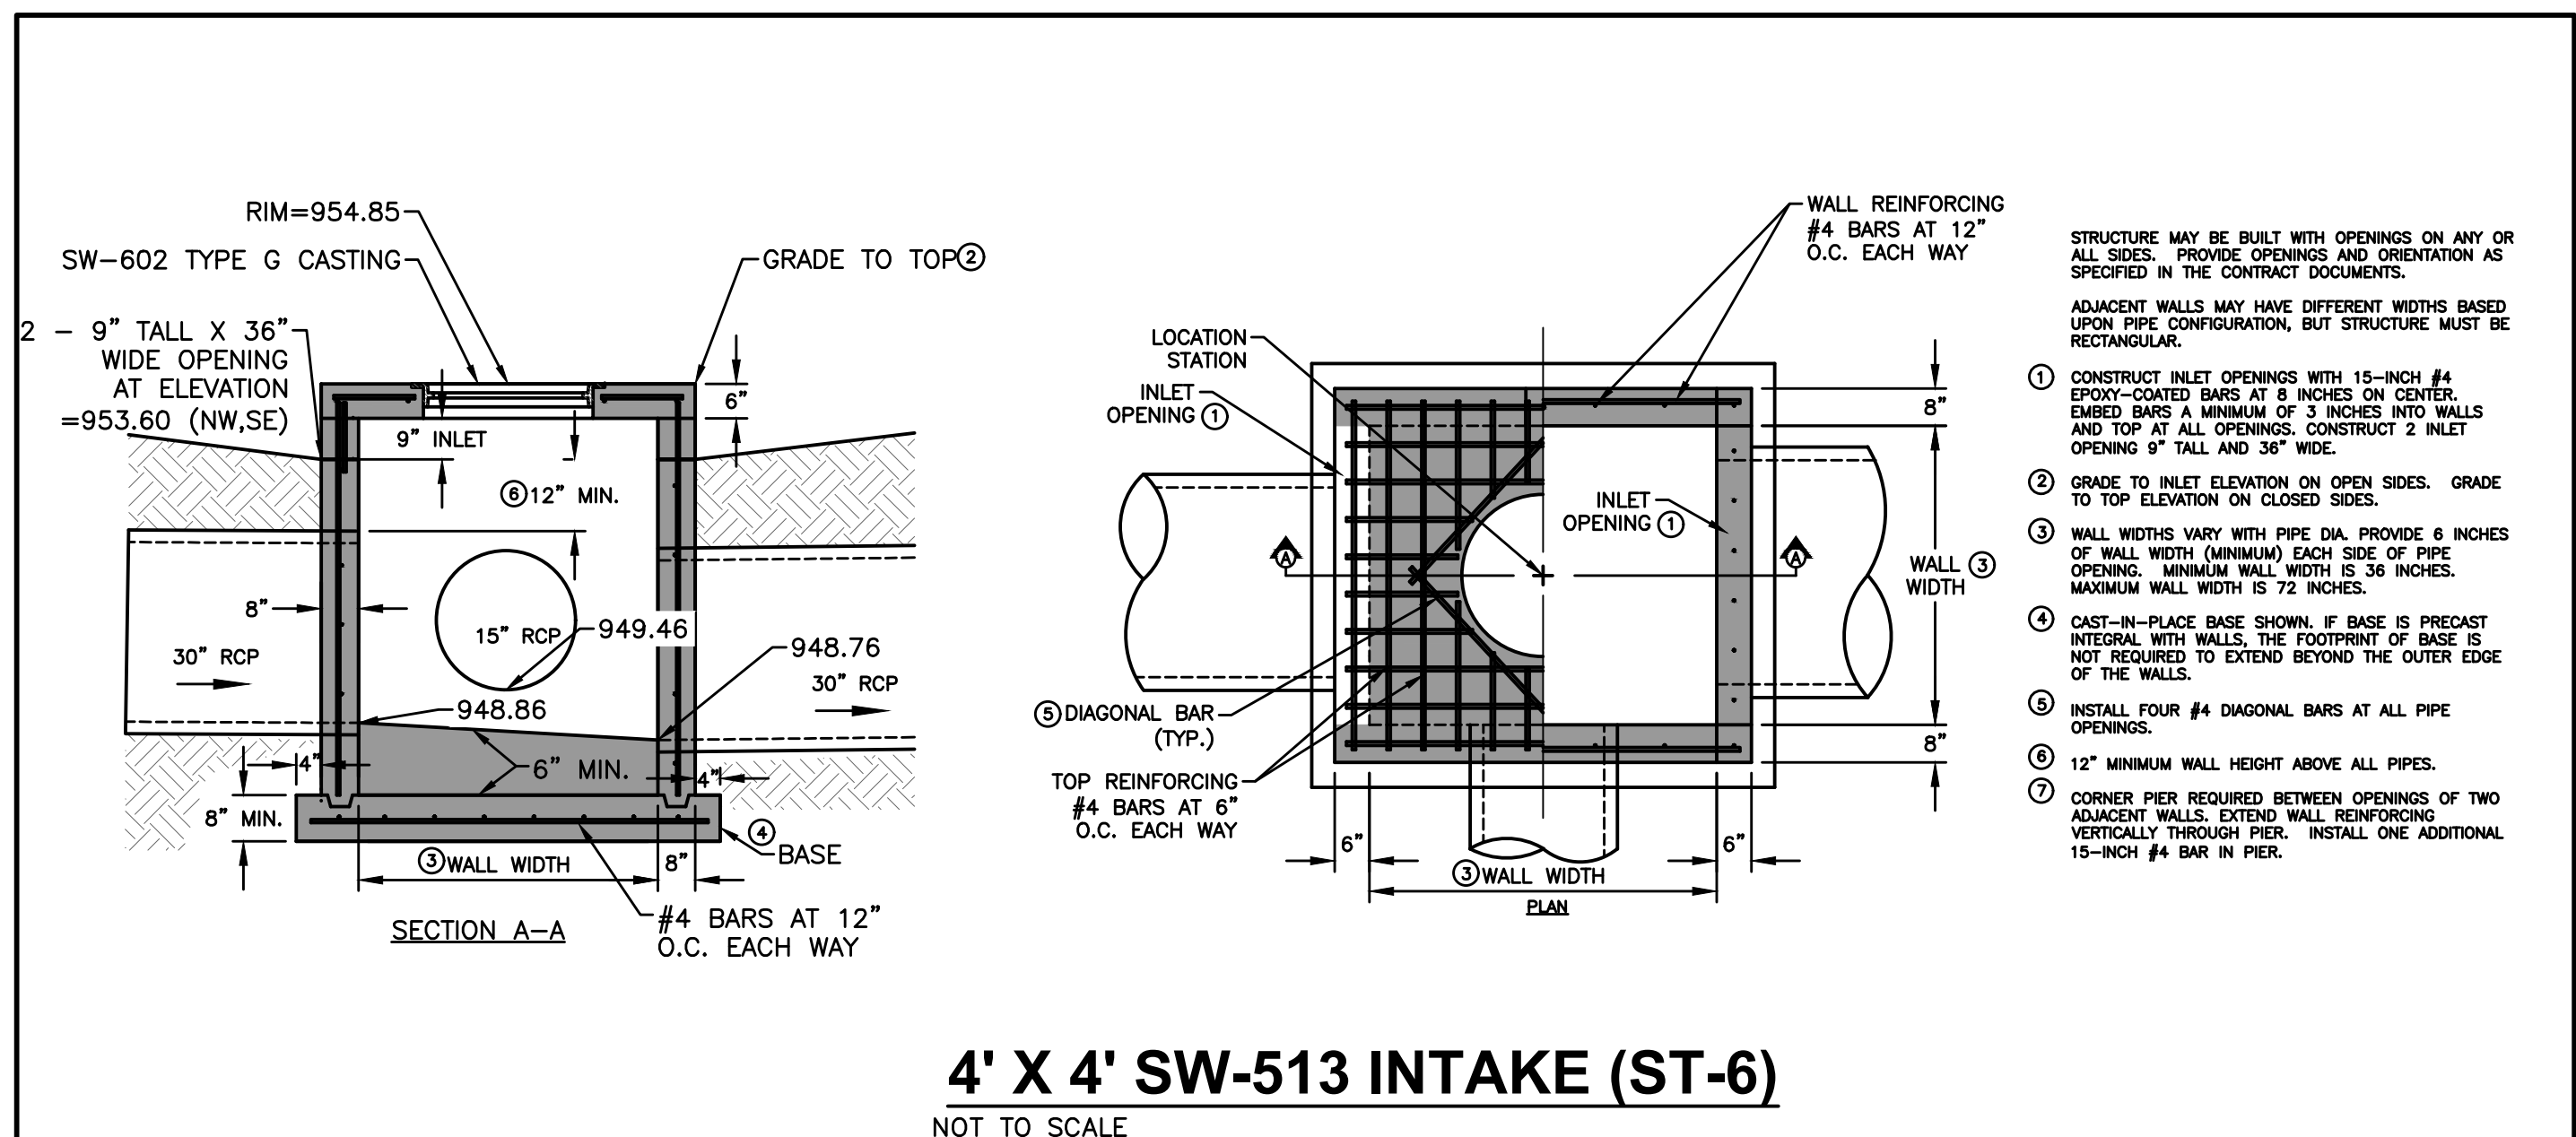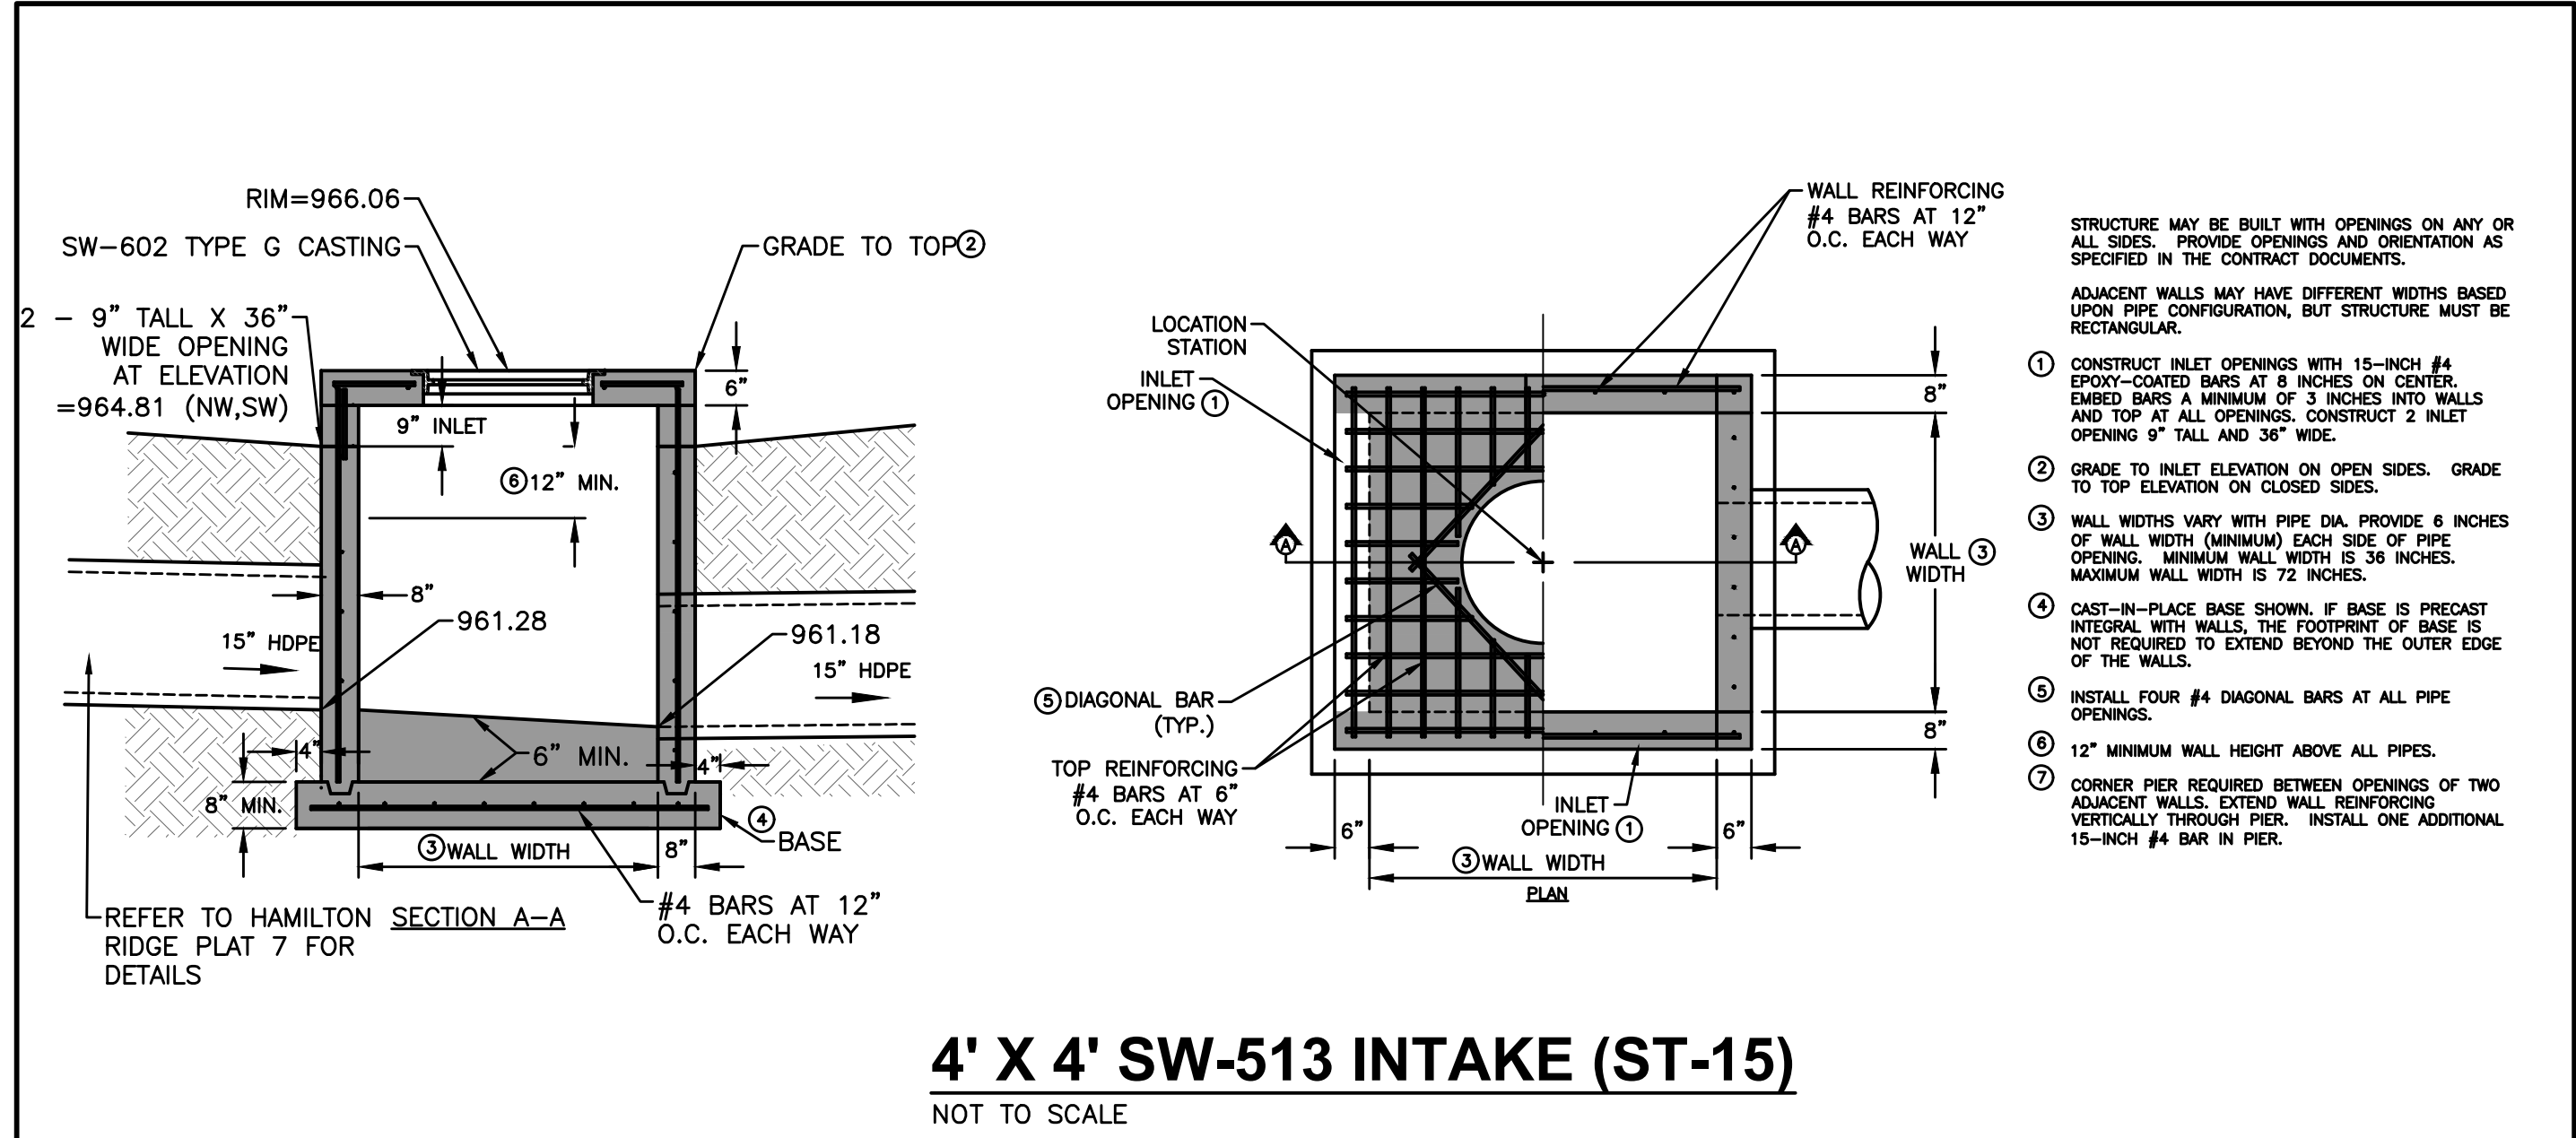

[illegible]

GENERAL NOTES

1. ALL CONSTRUCTION SHALL CONFORM TO THE 2020 CITY OF WAUKEE STANDARD SPECIFICATIONS FOR PUBLIC IMPROVEMENTS AND TO THE 2021 EDITION OF SUDAS STANDARD SPECIFICATIONS. THE WAUKEE STANDARD SPECIFICATIONS SHALL GOVERN IF ANY DISCREPANCIES.
2. WHERE PUBLIC UTILITY FIXTURES ARE SHOWN AS EXISTING ON THE PLANS OR ENCOUNTERED WITHIN THE CONSTRUCTION AREA, IT SHALL BE THE RESPONSIBILITY OF THE CONTRACTOR TO NOTIFY THE OWNERS OF THOSE UTILITIES PRIOR TO THE BEGINNING OF ANY CONSTRUCTION. THE CONTRACTOR SHALL AFFORD ACCESS TO THESE FACILITIES FOR NECESSARY MODIFICATION OF SERVICES. UNDERGROUND FACILITIES, STRUCTURES AND UTILITIES HAVE BEEN PLOTTED FROM AVAILABLE SURVEYS AND RECORDS, AND THEREFORE, THEIR LOCATIONS MUST BE CONSIDERED APPROXIMATE ONLY. IT IS POSSIBLE THERE MAY BE OTHERS. THE EXISTENCE OF WHICH IS PRESENTLY NOT KNOWN OR SHOWN. IT IS THE CONTRACTORS RESPONSIBILITY TO DETERMINE THEIR EXISTENCE AND EXACT LOCATIONS AND TO AVOID DAMAGE THERETO. NO CLAIMS FOR ADDITIONAL COMPENSATION WILL BE ALLOWED TO THE CONTRACTOR FOR ANY INTERFERENCE OR DELAY CAUSED BY SUCH WORK.
3. THE CONTRACTOR IS REQUIRED TO UTILIZE THE UTILITY ONE-CALL SERVICE AT 800-292-8989 AT LEAST 48 HOURS PRIOR TO EXCAVATING ANYWHERE ON THE PROJECT.
4. THE CONTRACTOR IS RESPONSIBLE FOR REPLACING ANY AREAS OF PAVEMENT OR SIDEWALK NOT TO BE REMOVED THAT IS DAMAGED DUE TO OPERATING HIS EQUIPMENT ON THE PAVEMENT OR SIDEWALK. PAVEMENT REPLACEMENT SHALL COMPLY WITH THE WAUKEE STANDARD SPECIFICATIONS FOR PUBLIC IMPROVEMENTS.
5. THE GENERAL CONTRACTOR SHALL BE RESPONSIBLE FOR THE COORDINATION OF WORK BETWEEN ALL SUPPLIERS AND SUBCONTRACTORS INVOLVED IN THE PROJECT, INCLUDING STAGING OF CONSTRUCTION DETAILS.
6. THE CONTRACTOR SHALL CONFINE HIS GRADING OPERATIONS TO WITHIN THE PROPOSED AND EXISTING RIGHT OF WAY, CONSTRUCTION LIMITS AND EASEMENTS SHOWN ON THE PLANS, ANY DAMAGE TO PROPERTIES OUTSIDE THE SITE BOUNDARY SHALL BE THE SOLE RESPONSIBILITY OF THE CONTRACTOR.
7. PRIOR TO CONSTRUCTION, CONTRACTOR SHALL NOTIFY (48 HRS NOTICE) THE FOLLOWING:
 - A. CITY OF WAUKEE ENGINEERING DEPARTMENT
 - B. APPROPRIATE UTILITY COMPANIES
 - C. OWNER
 - D. CIVIL DESIGN ADVANTAGE
- * 48 HOUR NOTICE SHALL BE GIVEN TO THE CITY OF WAUKEE ENGINEERING DEPARTMENT PRIOR TO WEEKEND AND HOLIDAY WORK.
8. PRIOR TO CONSTRUCTION, THE PROJECT MANAGER SHALL CONTACT THE WAUKEE ENGINEERING DEPARTMENT AND SCHEDULE A PRE-CONSTRUCTION MEETING AT LEAST ONE WEEK PRIOR TO THE ANTICIPATED START OF CONSTRUCTION.
9. SPECIAL CARE SHALL BE TAKEN WHEN FORMING AT INTERSECTIONS SO THE PROFILES SHOWN ON THE PLANS AND THE ELEVATIONS SHOWN ON THE INTERSECTION DETAILS ARE OBTAINED. SHORT LENGTHS OF FORMS OR FLEXIBLE FORMS MAY BE NECESSARY AT THESE LOCATIONS.

ESTIMATE REFERENCE INFORMATION	
Data listed below is for informational purpose only and shall not constitute a basis for any extra work orders.	
ITEM NO.	DESCRIPTION
	THE 2020 EDITION OF THE CITY OF WAUKEE STANDARD SPECIFICATIONS FOR PUBLIC IMPROVEMENTS AND THE 2021 EDITION OF SUDAS STANDARD SPECIFICATIONS SHALL APPLY TO ALL WORK PERFORMED ON THIS PROJECT EXCEPT AS MODIFIED HEREIN. ALL REFERENCES TO SECTIONS AND FIGURES ARE TO THE SUDAS STANDARD SPECIFICATIONS. CITY OF WAUKEE STANDARD DETAILS SHALL GOVERN IF ANY DISCREPANCIES.
1	CLEAR AND GRUB ALL AREAS AFFECTED BY GRADING OPERATIONS. THE CONTRACTOR SHALL FIELD VERIFY CLEARING AND GRUBBING NEEDS PRIOR TO BIDDING. INCLUDES REMOVAL OF ANY EXISTING FIELD FENCE. ALL MATERIAL THAT IS REMOVED FROM THE PROJECT SHALL BECOME THE PROPERTY OF THE CONTRACTOR. INCLUDED REMOVAL OF EXISTING CROPS FOR CONSTRUCTION OF TEMPORARY ACCESS. DO NOT DISTURB CROPS OUTSIDE OF THE PROJECT LIMITS. AREA SHOWN FOR REFERENCE ONLY.
2	STRIP, SALVAGE AND RE-SPREAD TOPSOIL PER SECTION 2010 OF SUDAS STANDARD SPECIFICATIONS OR PROVIDE THE CITY WITH A TOPSOIL PRESERVATION PLAN. TOPSOIL TO BE RESPREAD SHALL BE FREE OF ROCK AND DEBRIS AND BE SUITABLE FOR THE GROWTH OF GRASS. COORDINATE LOCATION OF STOCKPILE WITH OWNER.
3	EXCAVATION INCLUDES ALL WORK NECESSARY TO ACHIEVE PROPER GRADES AS SHOWN IN THE PLANS. NO PAYMENT FOR OVERHAUL SHALL BE ALLOWED.
4	REFER TO SHEET 2 FOR TYPICAL LOCATIONS AND THICKNESS.
5	SANITARY SEWER SHALL BE PVC TRUSS PIPE. ANY CONNECTIONS TO EXISTING SANITARY SEWER SHALL BE CONSIDERED INCIDENTAL. REFER TO FIG. 3010.101 AND 3010.103 FOR PIPE EMBEDMENT DETAILS. GRANULAR PIPE BEDDING SHALL BE CONSIDERED INCIDENTAL. EXISTING SANITARY SEWER WILL NEED TO BE RETESTED AFTER SADDLE WYE INSTALLATION.
8-13	REFER TO FIGURE 3010.102 FOR TRENCH BEDDING AND BACKFILL ZONE DETAILS. GRANULAR PIPE BEDDING SHALL BE CONSIDERED INCIDENTAL. CONNECTIONS TO EXISTING STORM SEWER PIPE AND STRUCTURES SHALL BE CONSIDERED INCIDENTAL. WRAP ALL PIPE JOINTS IN ENGINEERING FABRIC. CLEAN AND TELEVIEW SANITARY AND STORM SEWER PRIOR TO PAVING AND PROVIDE TELEVIEWING REPORT TO CITY IN HARD COPY AND DISC FORMAT. TELEVIEWING SHALL BE CONSIDERED INCIDENTAL. ALL STORM SEWER PIPE THAT CROSSES OVER WATERMAIN SHALL HAVE O-RING GASKETS JOINT RATED AT 13 PSI OR GREATER. O-RING GASKET JOINTS SHALL BE INSTALLED ON EACH SIDE OF THE CROSSING UNTIL THE NORMAL DISTANCE FROM THE WATER TO THE SEWER IS AT LEAST 10 FEET.
6,14,18	REFER TO DETAILS ON SHEETS 2, 3 AND PLAN AND PROFILE SHEETS FOR LOCATION AND DEPTH. STORM SEWER SERVICES TYING INTO EXISTING RCP PIPE ARE TO BE CORE DRILLED. BRINGING STORM AND SANITARY SERVICES TO GROUND LEVEL, PLACING A WATERTIGHT CAP AND INSTALLING A POST SHALL BE CONSIDERED INCIDENTAL TO THIS BID ITEM.
15-16	THE LAST THREE SECTIONS AND APRON SHALL BE CONNECTED WITH PIPE CONNECTORS. REFER TO FIG. 4030.221 - RCP APRON SECTION FOOTING FOR FOOTING CONSTRUCTION DETAILS. APRON GUARD REQUIRED ON ALL APRONS. RCP APRON FOOTING, PIPE APRON GUARD AND PIPE CONNECTORS TO BE CONSIDERED INCIDENTAL. INSTALL CLAY WATERSTOPS AT ALL RCP APRONS, MIN. 3' LONG.
17-18	REFER TO FIG. 3010.101 AND FIG. 3010.104 FOR TRENCH BEDDING AND BACKFILL ZONE DETAILS. GRANULAR PIPE BEDDING SHALL BE CONSIDERED INCIDENTAL. REFER TO FIG. 5010.101 FOR THRUST BLOCK DETAILS. REFER TO FIG. 5010.102 FOR TRACER SYSTEM DETAILS. ALL FITTINGS, POLYETHYLENE WRAP, THRUST BLOCKS, AND TRACER WIRE SYSTEM SHALL BE CONSIDERED INCIDENTAL.
20-21	REFER TO FIG. 5020.201 - FIRE HYDRANT ASSEMBLY FOR FIRE HYDRANT CONSTRUCTION DETAILS. INCLUDES ANCHORING TEE, ANCHORING ELBOW, GATE VALVE, VALVE BOX, ANCHORING PIPE, ANCHORING COUPLING, ELBOWS, 5" STORZ FITTINGS, POLYETHYLENE WRAP, THRUST BLOCK AND TRACER WIRE SYSTEM AND FIRE HYDRANT.
20-21	REFER TO WATERMAIN PLAN AND PROFILE SHEETS FOR LOCATIONS OF HYDRANTS. ANY RELOCATED FIRE HYDRANTS ARE TO INCLUDE 5-INCH STORZ FITTINGS.
22	REFER TO FIG.6010.301 - CIRCULAR SANITARY SEWER MANHOLE (SW-301) FOR CONSTRUCTION DETAILS. CASTINGS IN PAVEMENT SHALL BE TYPE B RING AND COVER. WHEN CASTINGS ARE NOT IN PAVEMENT, INSTALL MANHOLE CONE SECTION, MANHOLE STEPS, AND RING/COVER CASTING SUCH THAT SEPARATION IS MAINTAINED BETWEEN MANHOLE COVERS AND PAVED AREAS (BACK OF CURB, SIDEWALK PAVEMENT, SIDEWALK APPROACHES/RAMPS). ALL SANITARY SEWER MANHOLES SHALL BE VACUUM TESTED.
23	REFER TO FIG. 6010.401 - CIRCULAR STORM SEWER MANHOLE (SW-401) FOR CONSTRUCTION DETAILS. MANHOLE INSIDE DIAMETERS GREATER THAN 48" SHALL BE CONSIDERED INCIDENTAL.

ESTIMATE REFERENCE INFORMATION	
Data listed below is for informational purpose only and shall not constitute a basis for any extra work orders.	
ITEM NO.	DESCRIPTION
25-27	REFER TO FIG. 6010.514 – BOXOUTS FOR GRATE INTAKES. REFER TO FIG. 6010.603 – CASTINGS FOR GRATE INTAKES FOR TYPE R GRATE DETAILS AND FIG. 6010.602 – CASTINGS FOR STORM SEWER MANHOLES FOR TYPE E CASTING DETAILS. THE MAXIMUM HEIGHT OF ADJUSTING RINGS ALLOWED FOR INTAKE CASTINGS IS 6". THE MAXIMUM HEIGHT OF ADJUSTING RINGS ALLOWED FOR MANHOLE CASTINGS IS 12".
25	REFER TO FIG. 6010.505 – DOUBLE GRATE INTAKE (SW-505) FOR CONSTRUCTION DETAILS.
26	REFER TO FIG. 5010.616 – DOUBLE GRATE INTAKE WITH MANHOLE (SW-506) FOR CONSTRUCTION DETAILS.
28	REFER TO FIG. 7010.101 – JOINTS (PV-101) FOR JOINT DETAILS. MAXIMUM C AND CD JOINT SPACING IS 15 FEET.
29	REFER TO FIG. 7030.204 – GENERAL SIDEWALK AND ACCESSIBLE RAMP DETAILS AND FIG. 7030.208 – CURB RAMPS WITHIN INTERSECTION RADIUS FOR CLASS B OR C SIDEWALK FOR CONSTRUCTION DETAILS. DETECTABLE WARNING PANELS TO BE CAST IRON WITH A NATURAL FINISH. ACCESSIBLE CURB RAMPS INCLUDING TURNING SPACES SHALL BE 6" THICK P.C.C.
30	REFER TO SHEET 3 FOR CONSTRUCTION DETAILS. ALL TRUNCATED DOMES SHALL BE CAST IRON.
31	THE SITE SEEDING SHALL CONFORM TO THE SPECIFICATION FOR TYPE (1) PERMANENT LAWN MIXTURE AND TYPE (4) URBAN TEMPORARY EROSION CONTROL SEED MIXTURE. SEEDING QUANTITIES –TYPE 1 PERMANENT LAWN MIXTURE = 0.88 AC –TYPE 4 URBAN TEMPORARY EROSION CONTROL MIXTURE = 14.76 AC
32	REFER TO PLAN AND PROFILE SHEETS FOR LOCATIONS. REFER TO IDOT STANDARD ROAD PLAN SI-182 FOR CONSTRUCTION DETAILS. EACH LOCATION CONSISTS OF FIVE SIGNS WITH POSTS PER SI-182.
33	ALL TRAFFIC CONTROL SHALL BE IN ACCORDANCE WITH THE LATEST EDITION OF THE MANUAL ON TRAFFIC CONTROL DEVICES. THE CONTRACTOR SHALL INSTALL AND MAINTAIN ROAD BARRICADES AT END OF EXISTING PAVEMENTS UNTIL THE PROJECT IS ACCEPTED. THE MESSAGE BOARD WILL BE REQUIRED AT LEAST 1 WEEK IN ADVANCE OF ANY LANE CLOSURES.
34	REFER TO SHEETS 9-10 OF THE CONSTRUCTION DRAWINGS FOR EROSION AND SEDIMENT CONTROLS. REFER TO SEPARATE STORM WATER POLLUTION PREVENTION PLAN (SWPPP) FOR SPECIFIC DETAILS.
37	REFER TO MAILBOX CLUSTER PAD DETAIL AND MAILBOX PAD DETAIL ON SHEET 2. MAILBOX LOCATED BETWEEN LOTS 14 AND 15.



 
2106.479

HAMILTON RIDGE PLAT 6

QUANTITIES, GENERAL NOTES AND

BID ITEM REFERENCE NOTES

WAUKEE, IOWA



CIVIL DESIGN ADVANTAGE

3405 S.E. CROSSROADS DRIVE, SUITE G
GRIMES, IOWA 50111

PHONE: (515) 369-4400 FAX: (515) 369-4410

ENGINEER: EKO

EI: JWM TECH: MST

REVISONS	DATE
AS-BUILT SUBMITTAL	11/01/2022
REVISED FINAL SUBMITTAL	10/05/2021
FINAL SUBMITTAL	9/02/2021
THIRD SUBMITTAL	8/18/2021
SECOND SUBMITTAL	7/26/2021
FIRST SUBMITTAL	7/13/2021

EROSION AND SEDIMENT CONTROL PLAN

NOT TO SCALE



STABILIZATION QUANTITIES

ITEM NO.	ITEM	UNIT	TOTAL
1	SILT FENCE	LF	2,590
2	DITCH CHECKS	LF	1,088
3	SEEDING, FERTILIZING, AND MULCHING	AC	15.64
4	INLET PROTECTION DEVICES	EA	3
5	CONCRETE WASHOUT PIT	EA	1
6	CLASS 'E' RIP-RAP	TON	40

DISCHARGE POINT SUMMARY

DISCHARGE POINT #1 TO SUGAR CREEK +100 FT
TOTAL AREA DISTURBED TO DISCHARGE POINT
STORAGE VOLUME REQUIRED (1.58 OF ACRES*3600 CU FT)

VOLUME PROVIDED IN SILT FENCE (700 LF @ 10.0 CU FT/LF OF FENCE)
VOLUME PROVIDED IN DITCH CHECK (519 LF @ 15.0 CU FT/LF)

TOTAL VOLUME PROVIDED

DISCHARGE POINT #2 TO SUGAR CREEK +100 FT
TOTAL AREA DISTURBED TO DISCHARGE POINT
STORAGE VOLUME REQUIRED (3.51 OF ACRES*3600 CU FT)

VOLUME PROVIDED IN SILT FENCE (1,062 LF @ 10.0 CU FT/LF OF FENCE)
VOLUME PROVIDED IN DITCH CHECK (299 LF @ 15.0 CU FT/LF)

TOTAL VOLUME PROVIDED

DISCHARGE POINT #3 TO SUGAR CREEK +100 FT
TOTAL AREA DISTURBED TO DISCHARGE POINT
STORAGE VOLUME REQUIRED (11.18 OF ACRES*3600 CU FT)

VOLUME PROVIDED IN SILT FENCE (1,091 LF @ 10.0 CU FT/LF OF FENCE)
VOLUME PROVIDED IN DITCH CHECK (634 LF @ 15.0 CU FT/LF)
VOLUME PROVIDED IN TSB #3


TOTAL VOLUME PROVIDED

NOTES:


1. IF DEWATERING IS NEEDED FOR ANY REASON, DISCHARGE OF WATER OFFSITE IS TO CONFORM WITH THE GENERAL PERMIT #2 REQUIREMENT.
2. DISTURBED AREAS SHALL BE TEMPORARILY SEEDED OR MULCHED IMMEDIATELY WHENEVER CLEARING, GRADING, EXCAVATING, OR OTHER EARTH DISTURBING ACTIVITIES HAVE PERMANENTLY OR TEMPORARILY CEASED AND WILL NOT RESUME FOR A PERIOD EXCEEDING 14 CALENDAR DAYS.
3. STORM SEWERS AND DRAINAGE WAYS SHALL BE PROTECTED FROM CONCRETE SLURRY PRODUCED BY SAWCUTTING AND CONCRETE GRINDING.

SWPPP LEGEND

DRAINAGE ARROW		
GRADING LIMITS		UNDISTURBED AREA
FILTER SOCK		RIP-RAP
SILT FENCE		
DITCH CHECK		GRAVEL ENTRANCE
INLET PROTECTION		STAGING AREA
PORTABLE RESTROOM		
TEMPORARY STANDPIPE		TEMPORARY SEDIMENT BASIN
		CONCRETE WASHOUT PIT

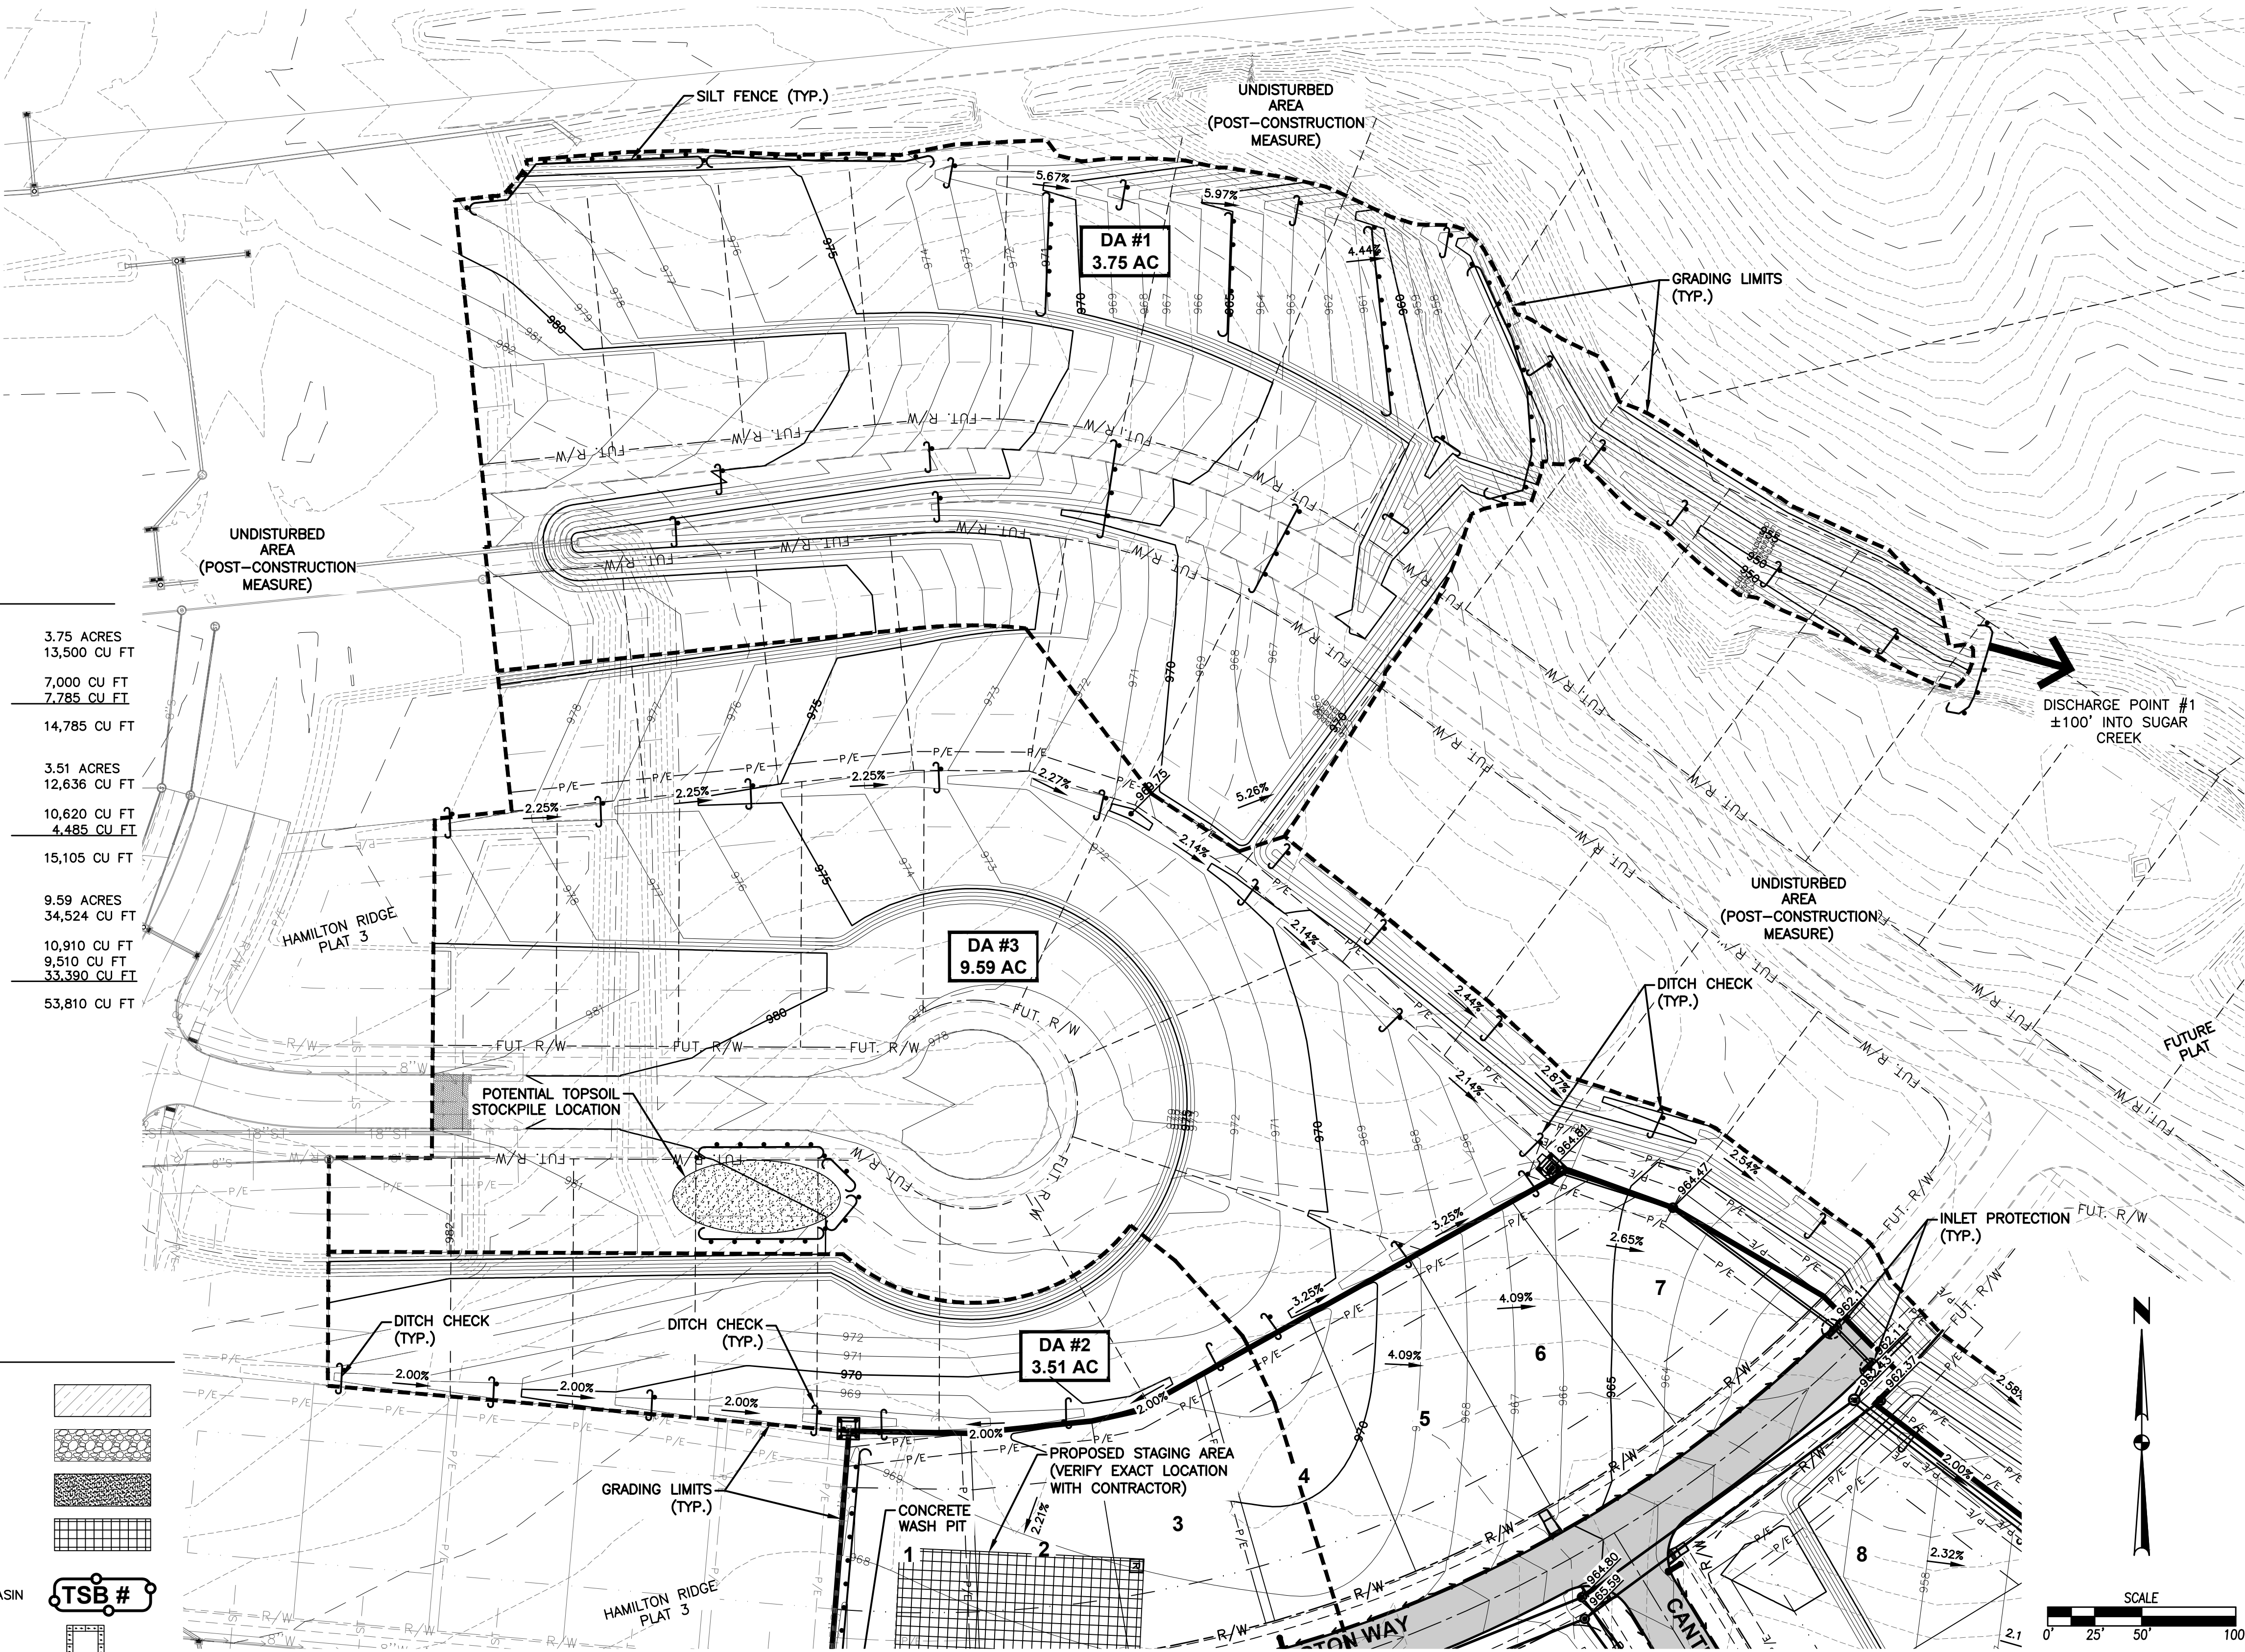


FILE: H:\2021\2106479\DWG\2106479-SWPPP-AS-BUILD.DWG
COMMENTS: DATE PLOTTED: 11/7/2022 3:18 PM
PLOTTER: HP PLOTTER
DRAWN BY: WATSON THOMPSON

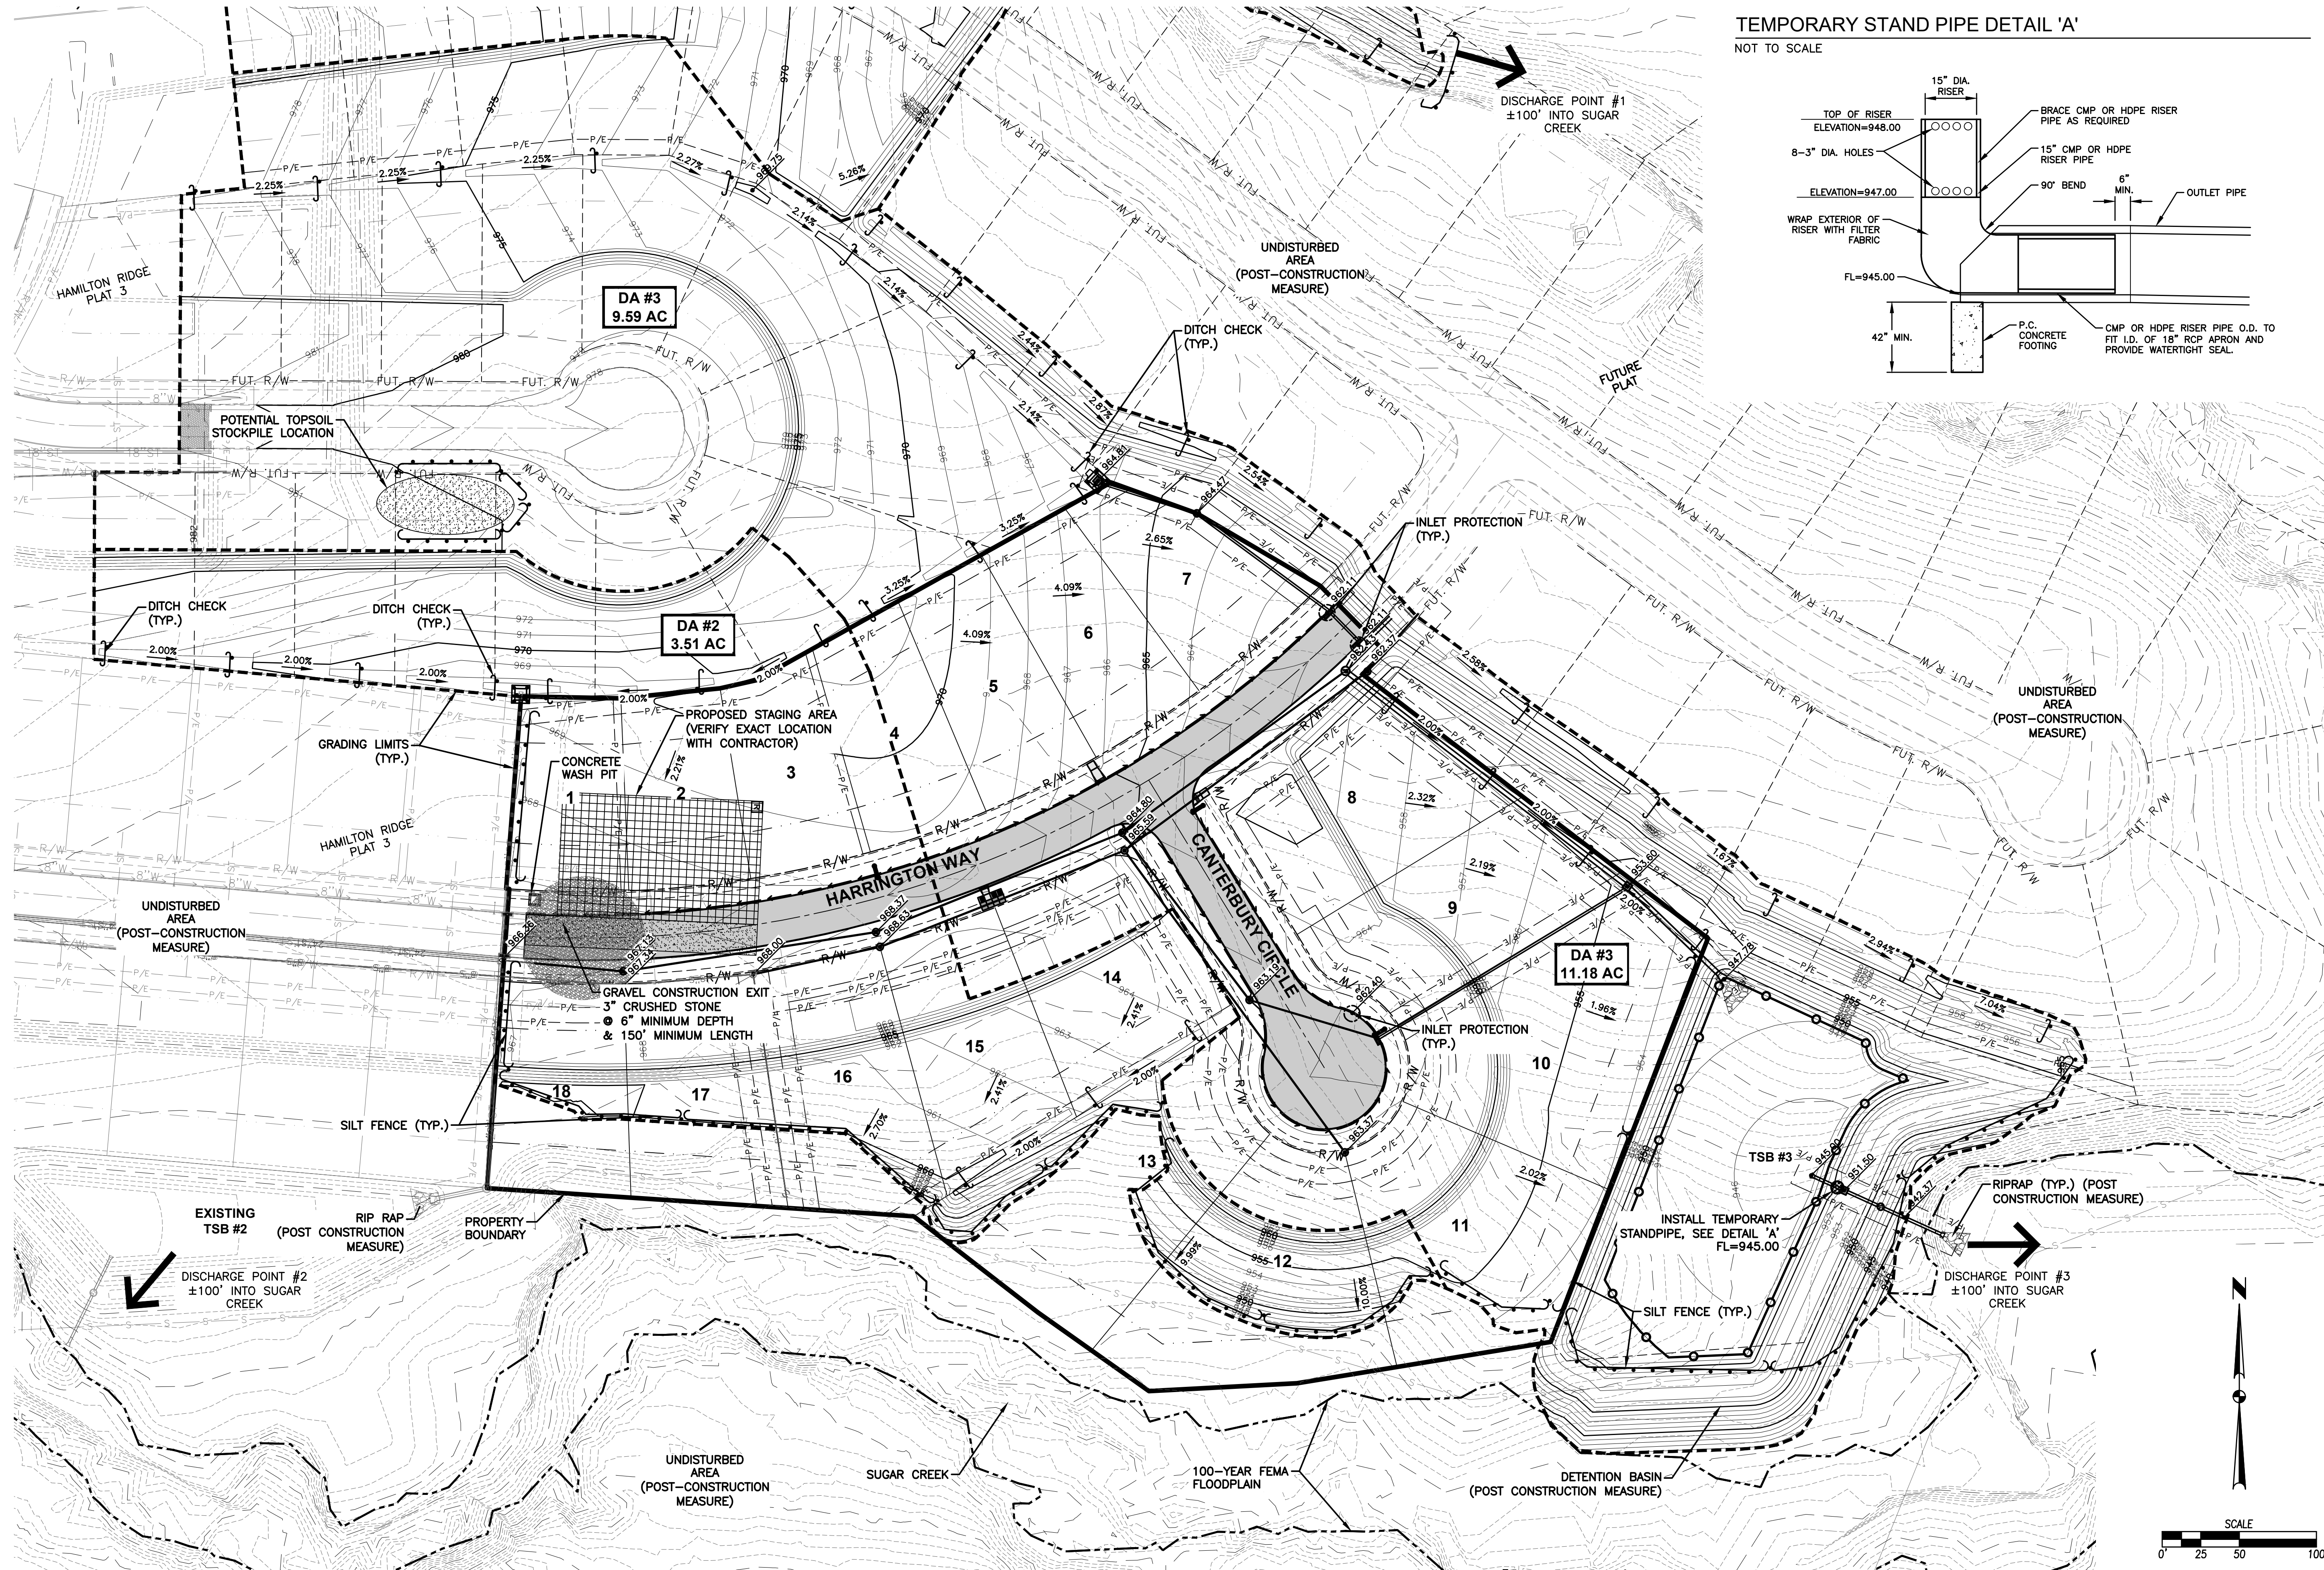

TEMPORARY STAND PIPE DETAIL 'A'

NOT TO SCALE

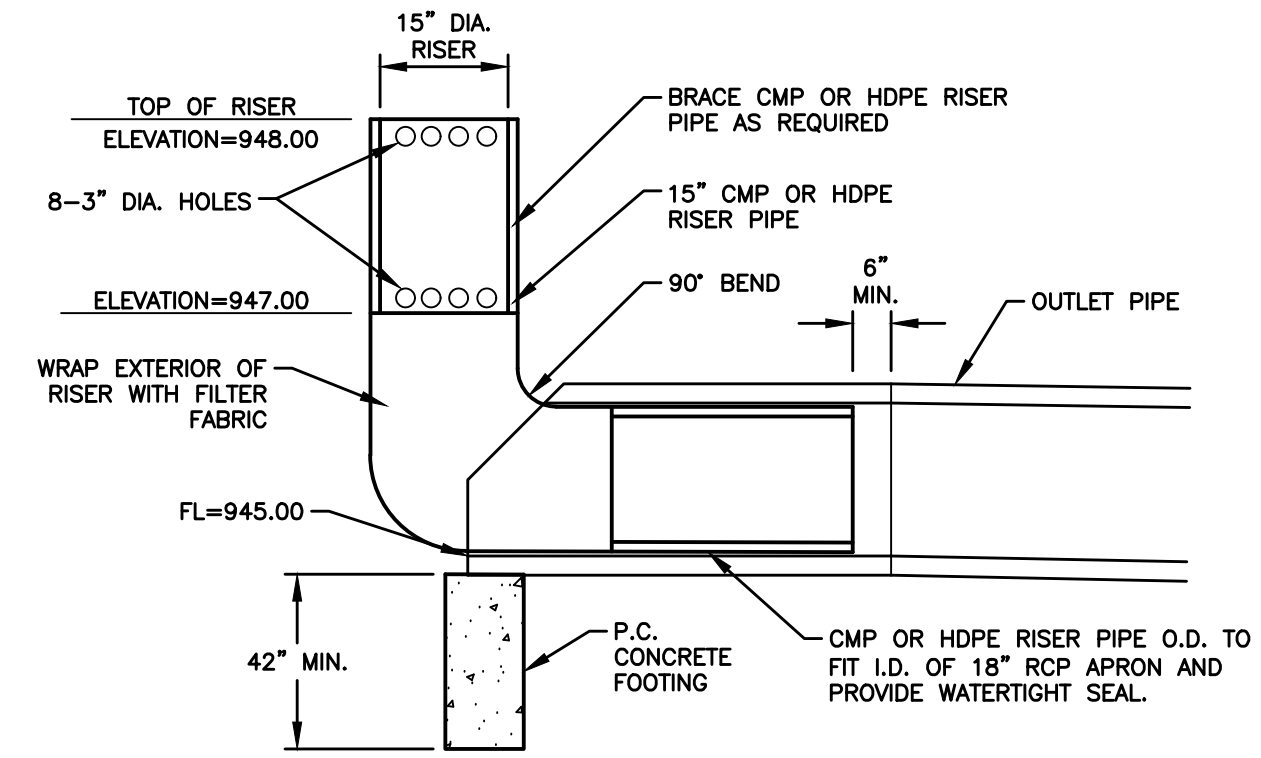

HAMILTON RIDGE PLAT 6

EROSION AND SEDIMENT CONTROL PLAN

WAUKEE, IOWA




CIVIL DESIGN ADVANTAGE

3405 S.E. CROSSROADS DRIVE, SUITE G
GRIMES, IOWA 50111
PHONE: (515) 369-4400 FAX: (515) 369-4410
ENGINEER: EKO

EI: JWM TECH: MST


REVISIONS

DATE	DESCRIPTION
11/01/2022	AS-BUILT SUBMITTAL
10/05/2021	REVISED FINAL SUBMITTAL
9/02/2021	FINAL SUBMITTAL
8/18/2021	THIRD SUBMITTAL
7/26/2021	SECOND SUBMITTAL
7/13/2021	FIRST SUBMITTAL

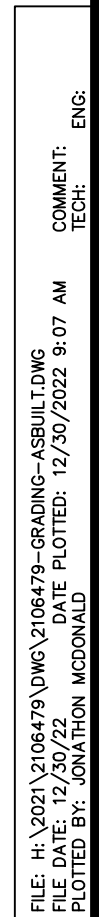

3405 S.E. CROSSROADS DRIVE, SUITE G
GRIMES, IOWA 50111
PHONE: (515) 369-4400 FAX: (515) 369-4410
ENGINEER: EKO EI: JWM TECH: MST


HAMILTON RIDGE PLAT 6
GRADING PLAN
 WAUKEE, IOWA
 CIVIL DESIGN ADVANTAGE

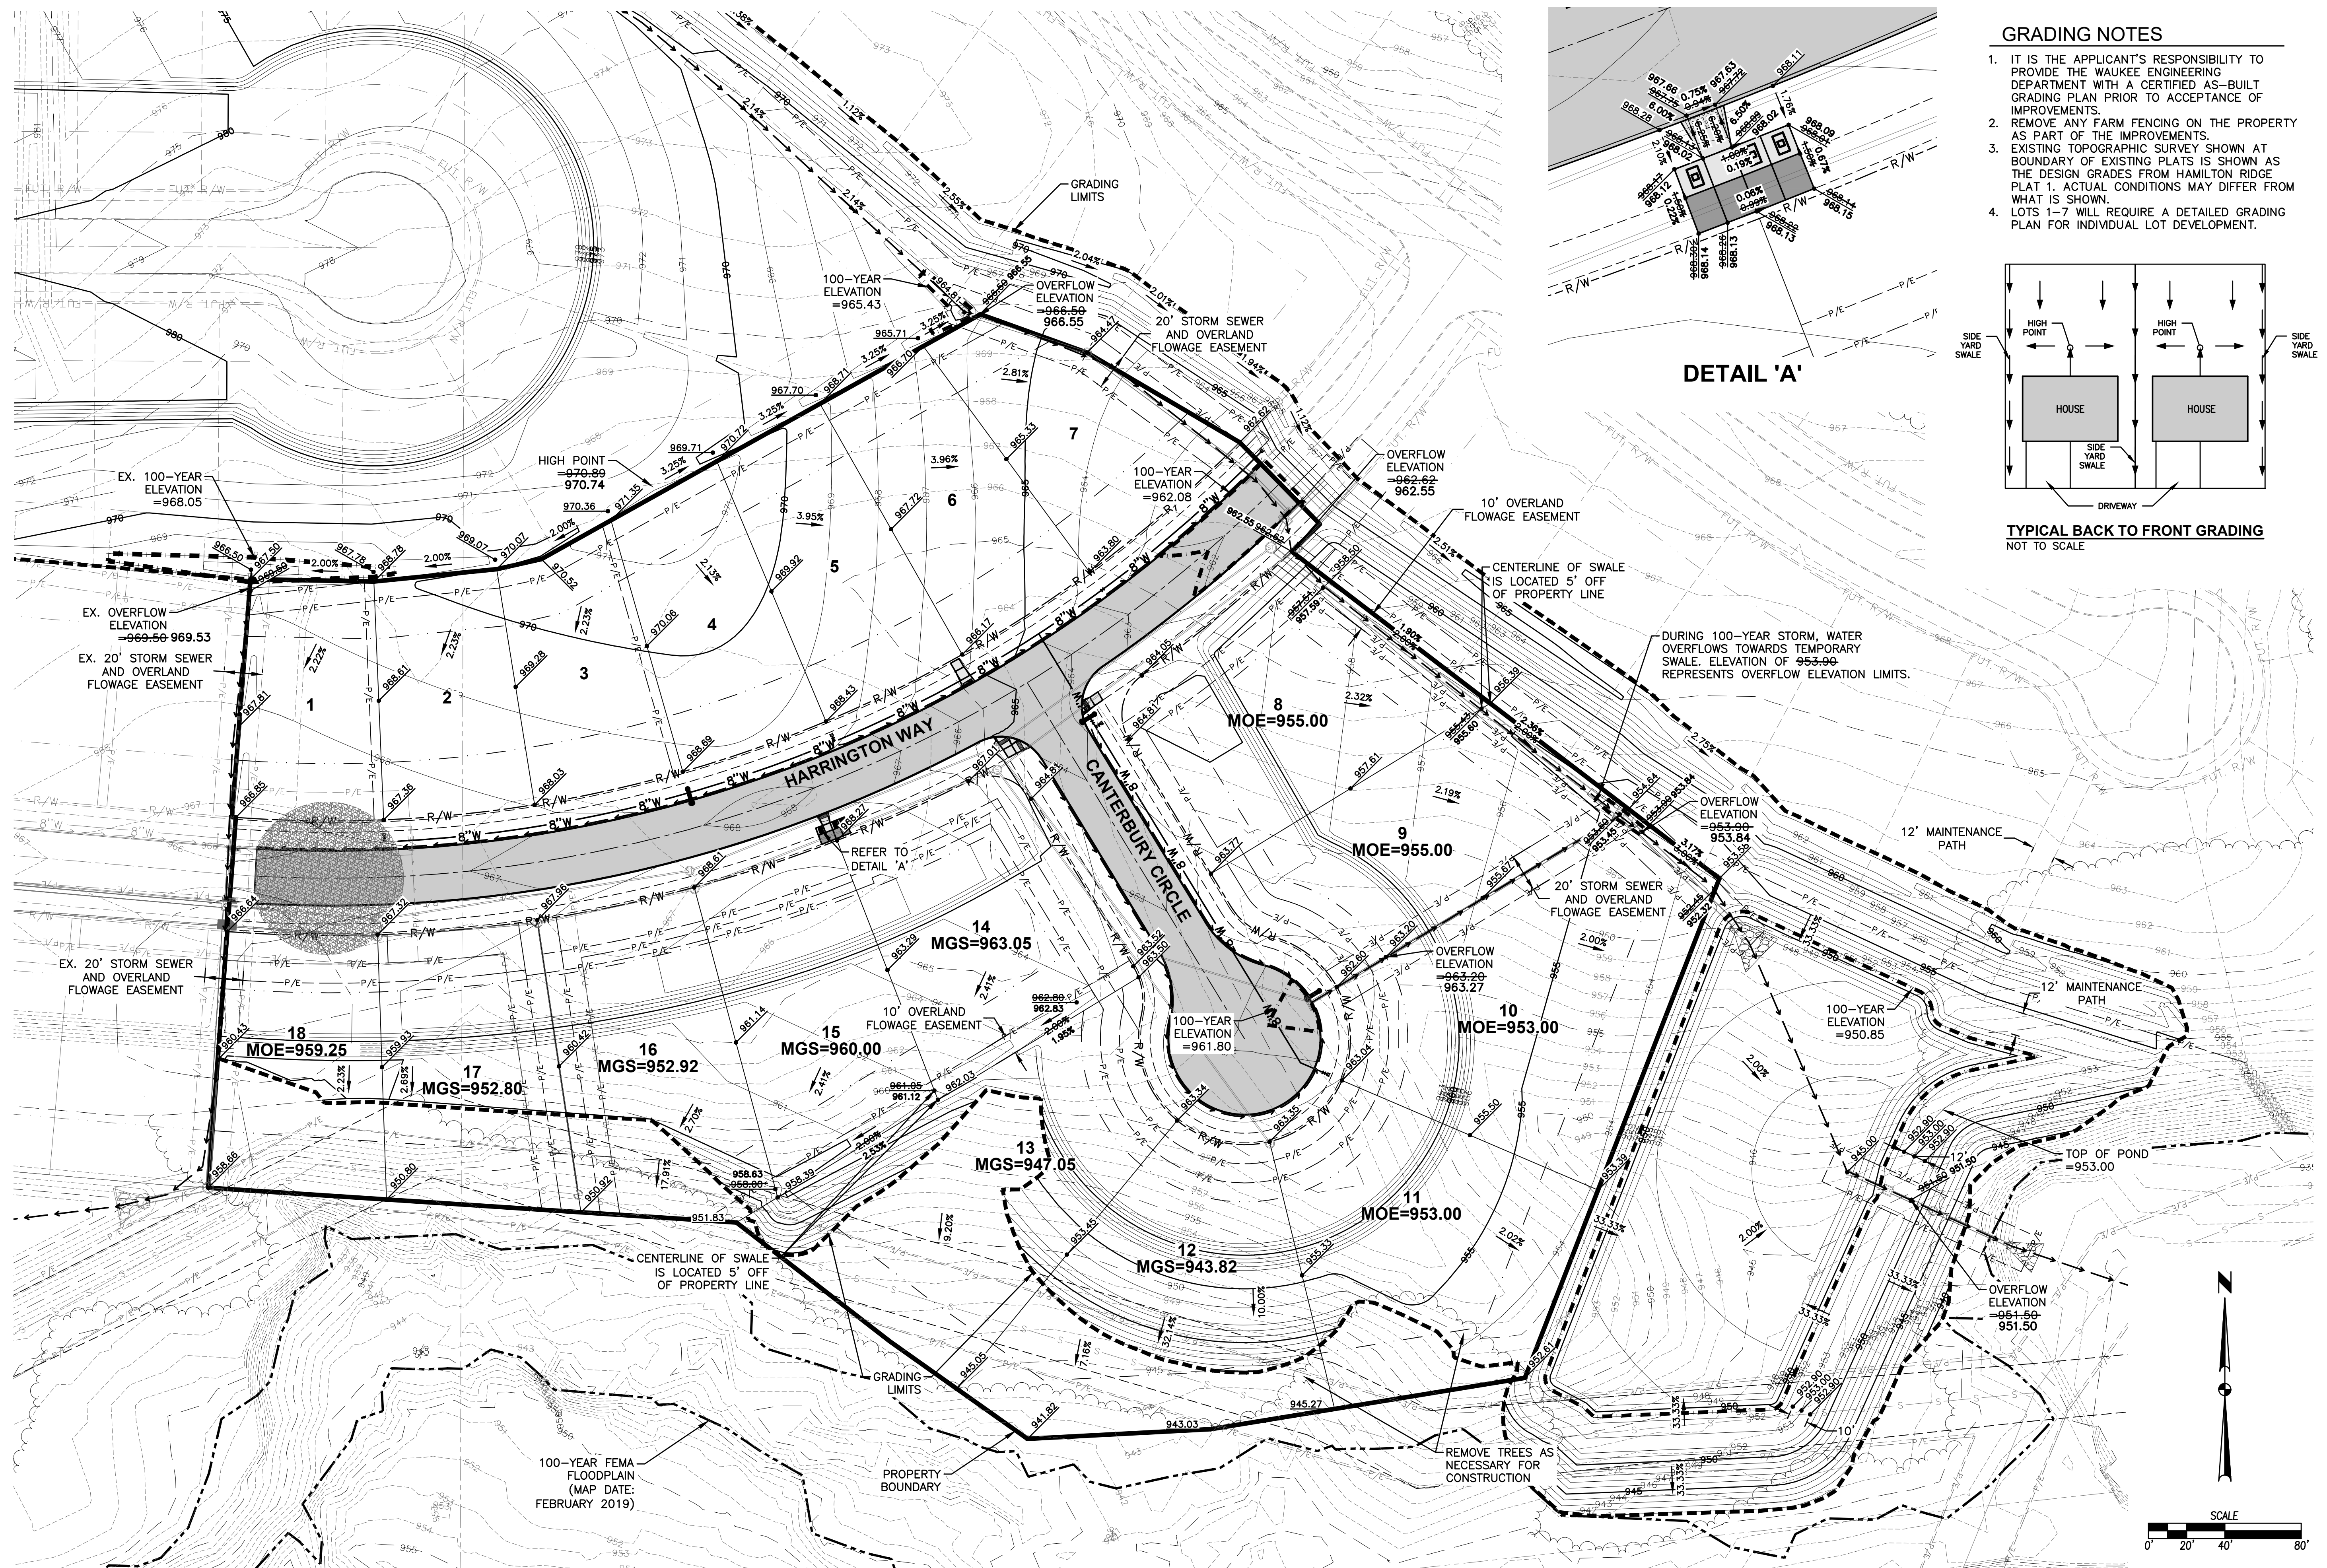

DETAIL 'A'

TYPICAL BACK TO FRONT GRADING
NOT TO SCALE

GRADING NOTES

REVISIONS	DATE
AS-BUILT SUBMITTAL	11/01/2022
REVISED FINAL SUBMITTAL	10/05/2021
FINAL SUBMITTAL	9/02/2021
THIRD SUBMITTAL	8/16/2021
SECOND SUBMITTAL	7/26/2021
FIRST SUBMITTAL	7/13/2021



3405 S.E. CROSSROADS DRIVE, SUITE G
GRIMES, IOWA 50111
PHONE: (515) 369-4400 FAX: (515) 369-4410
ENGINEER: EKO
EI: JWM TECH: MSH

T 6
WAUKEE, IOWA

HAMILTON RIDGE PLAT 6

GRADING PLAN

8/18
2106.479
GA

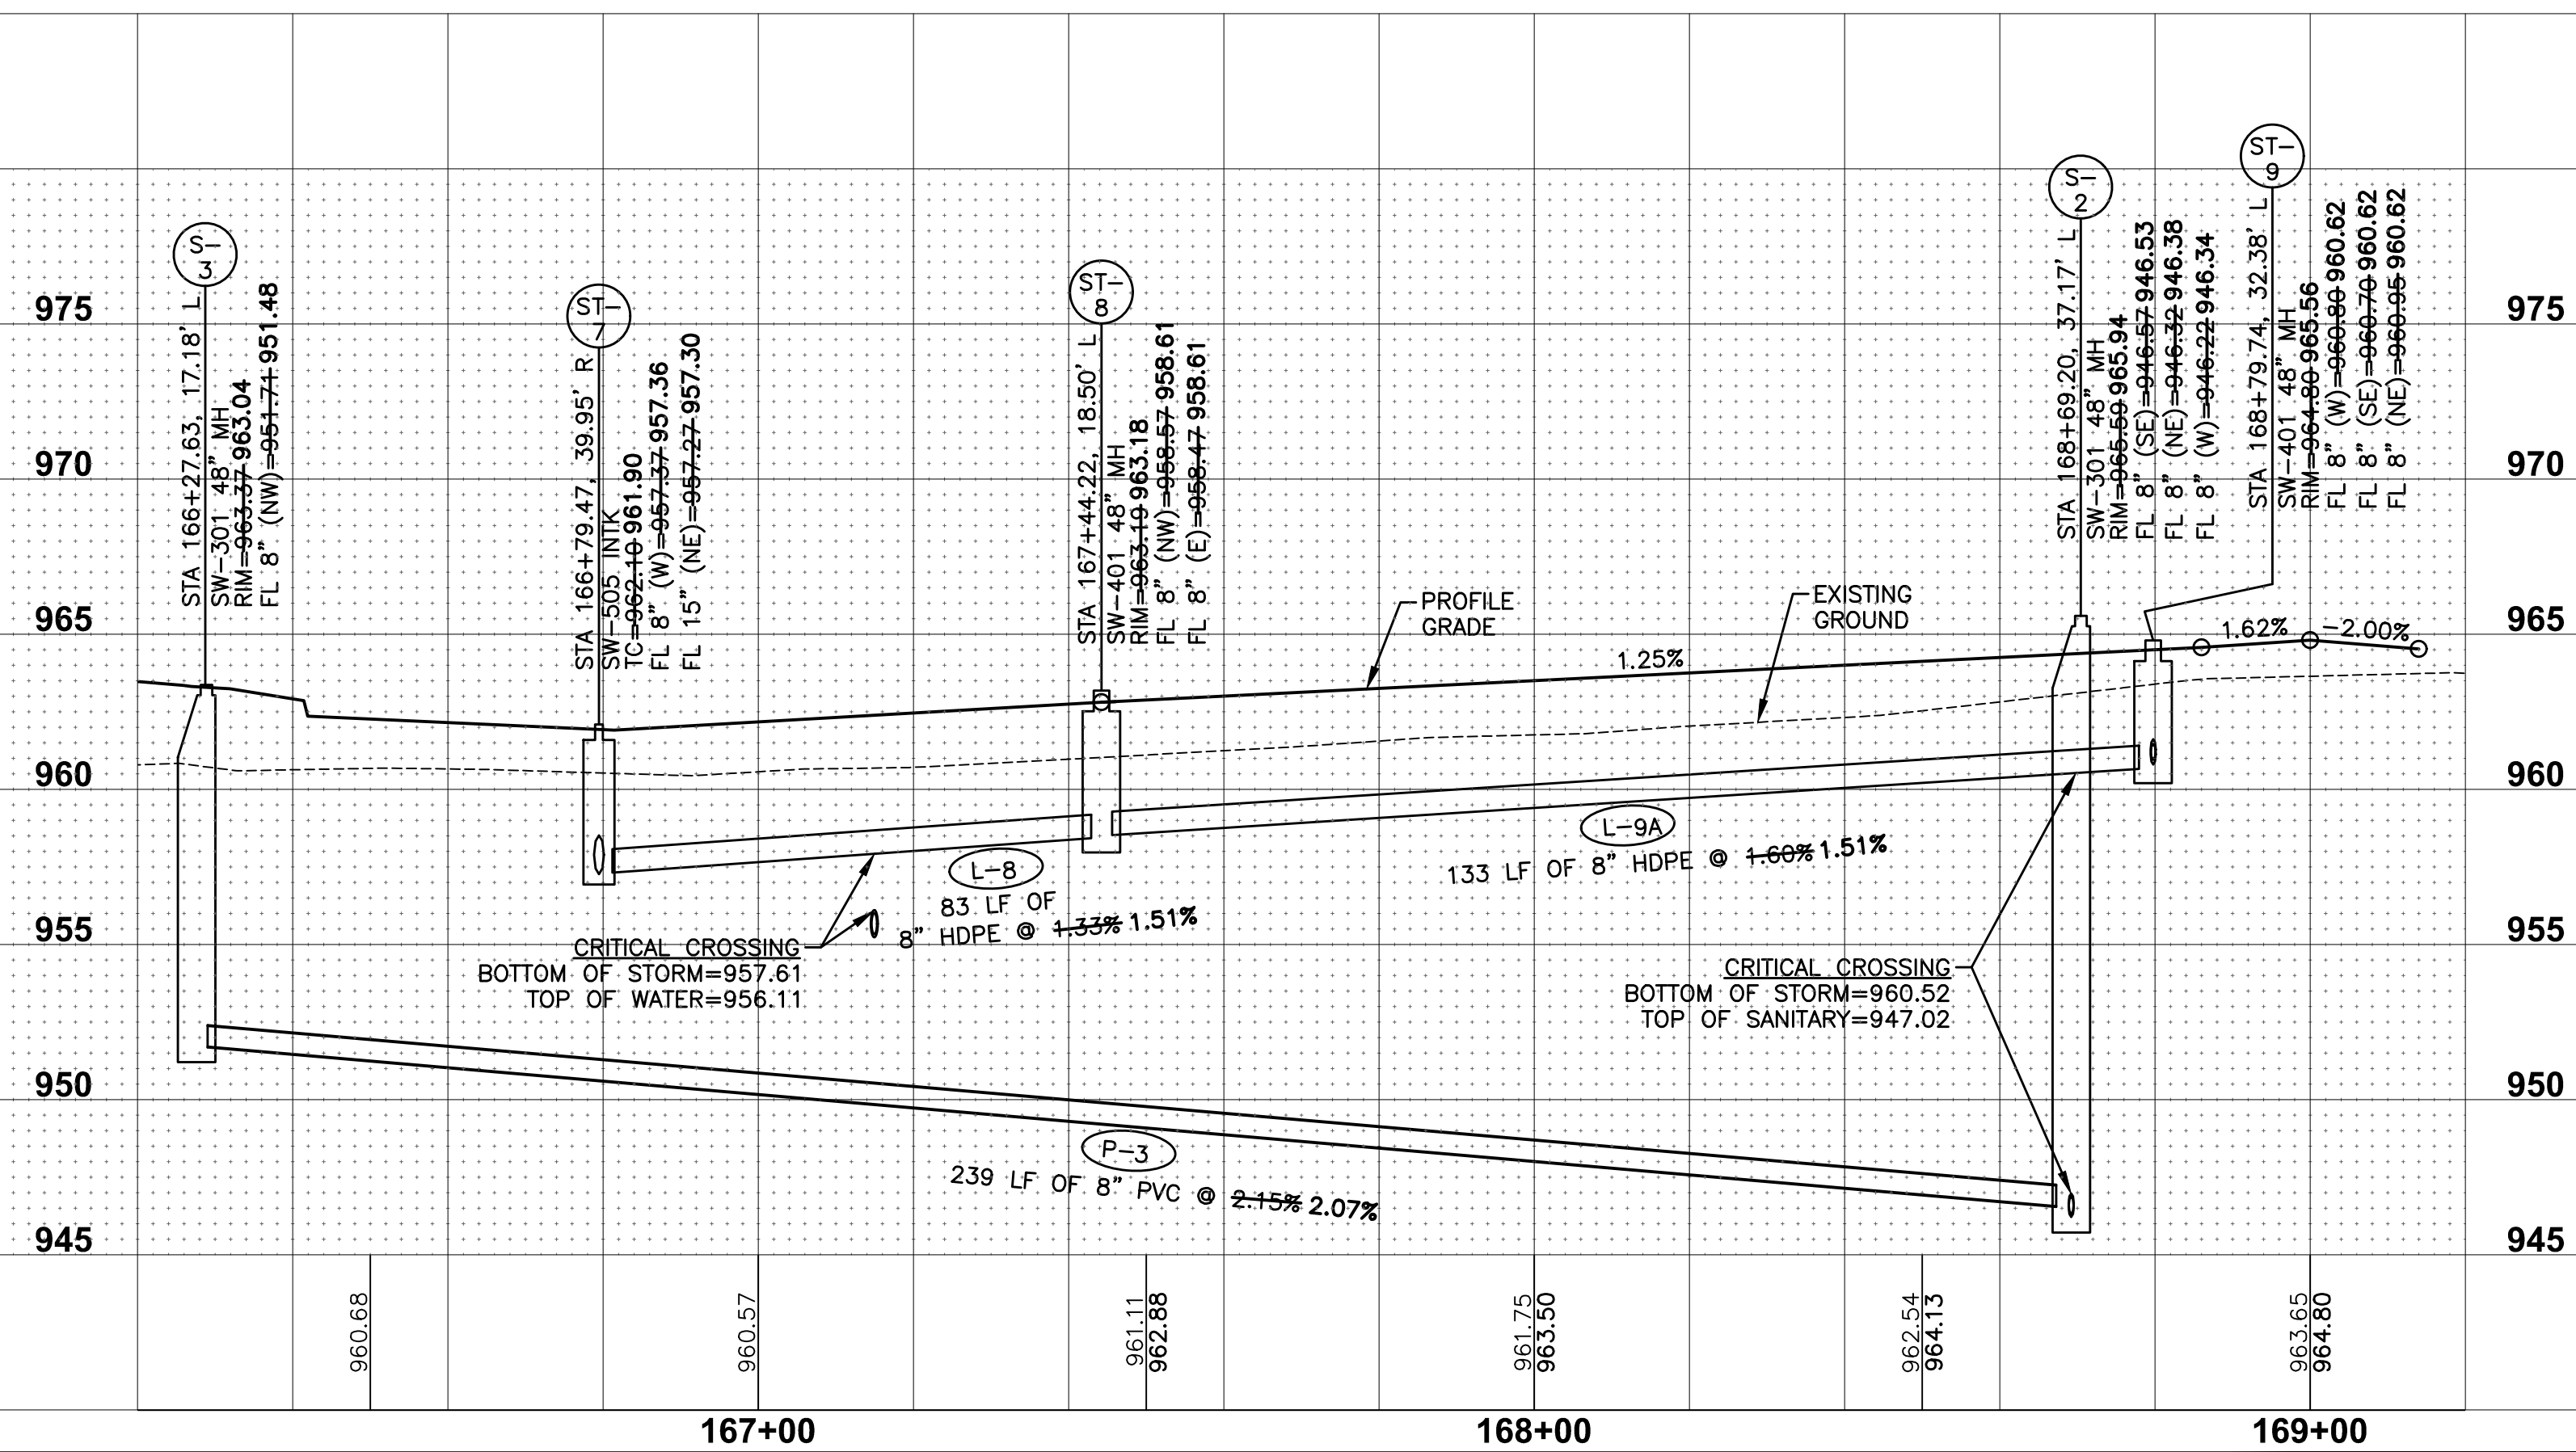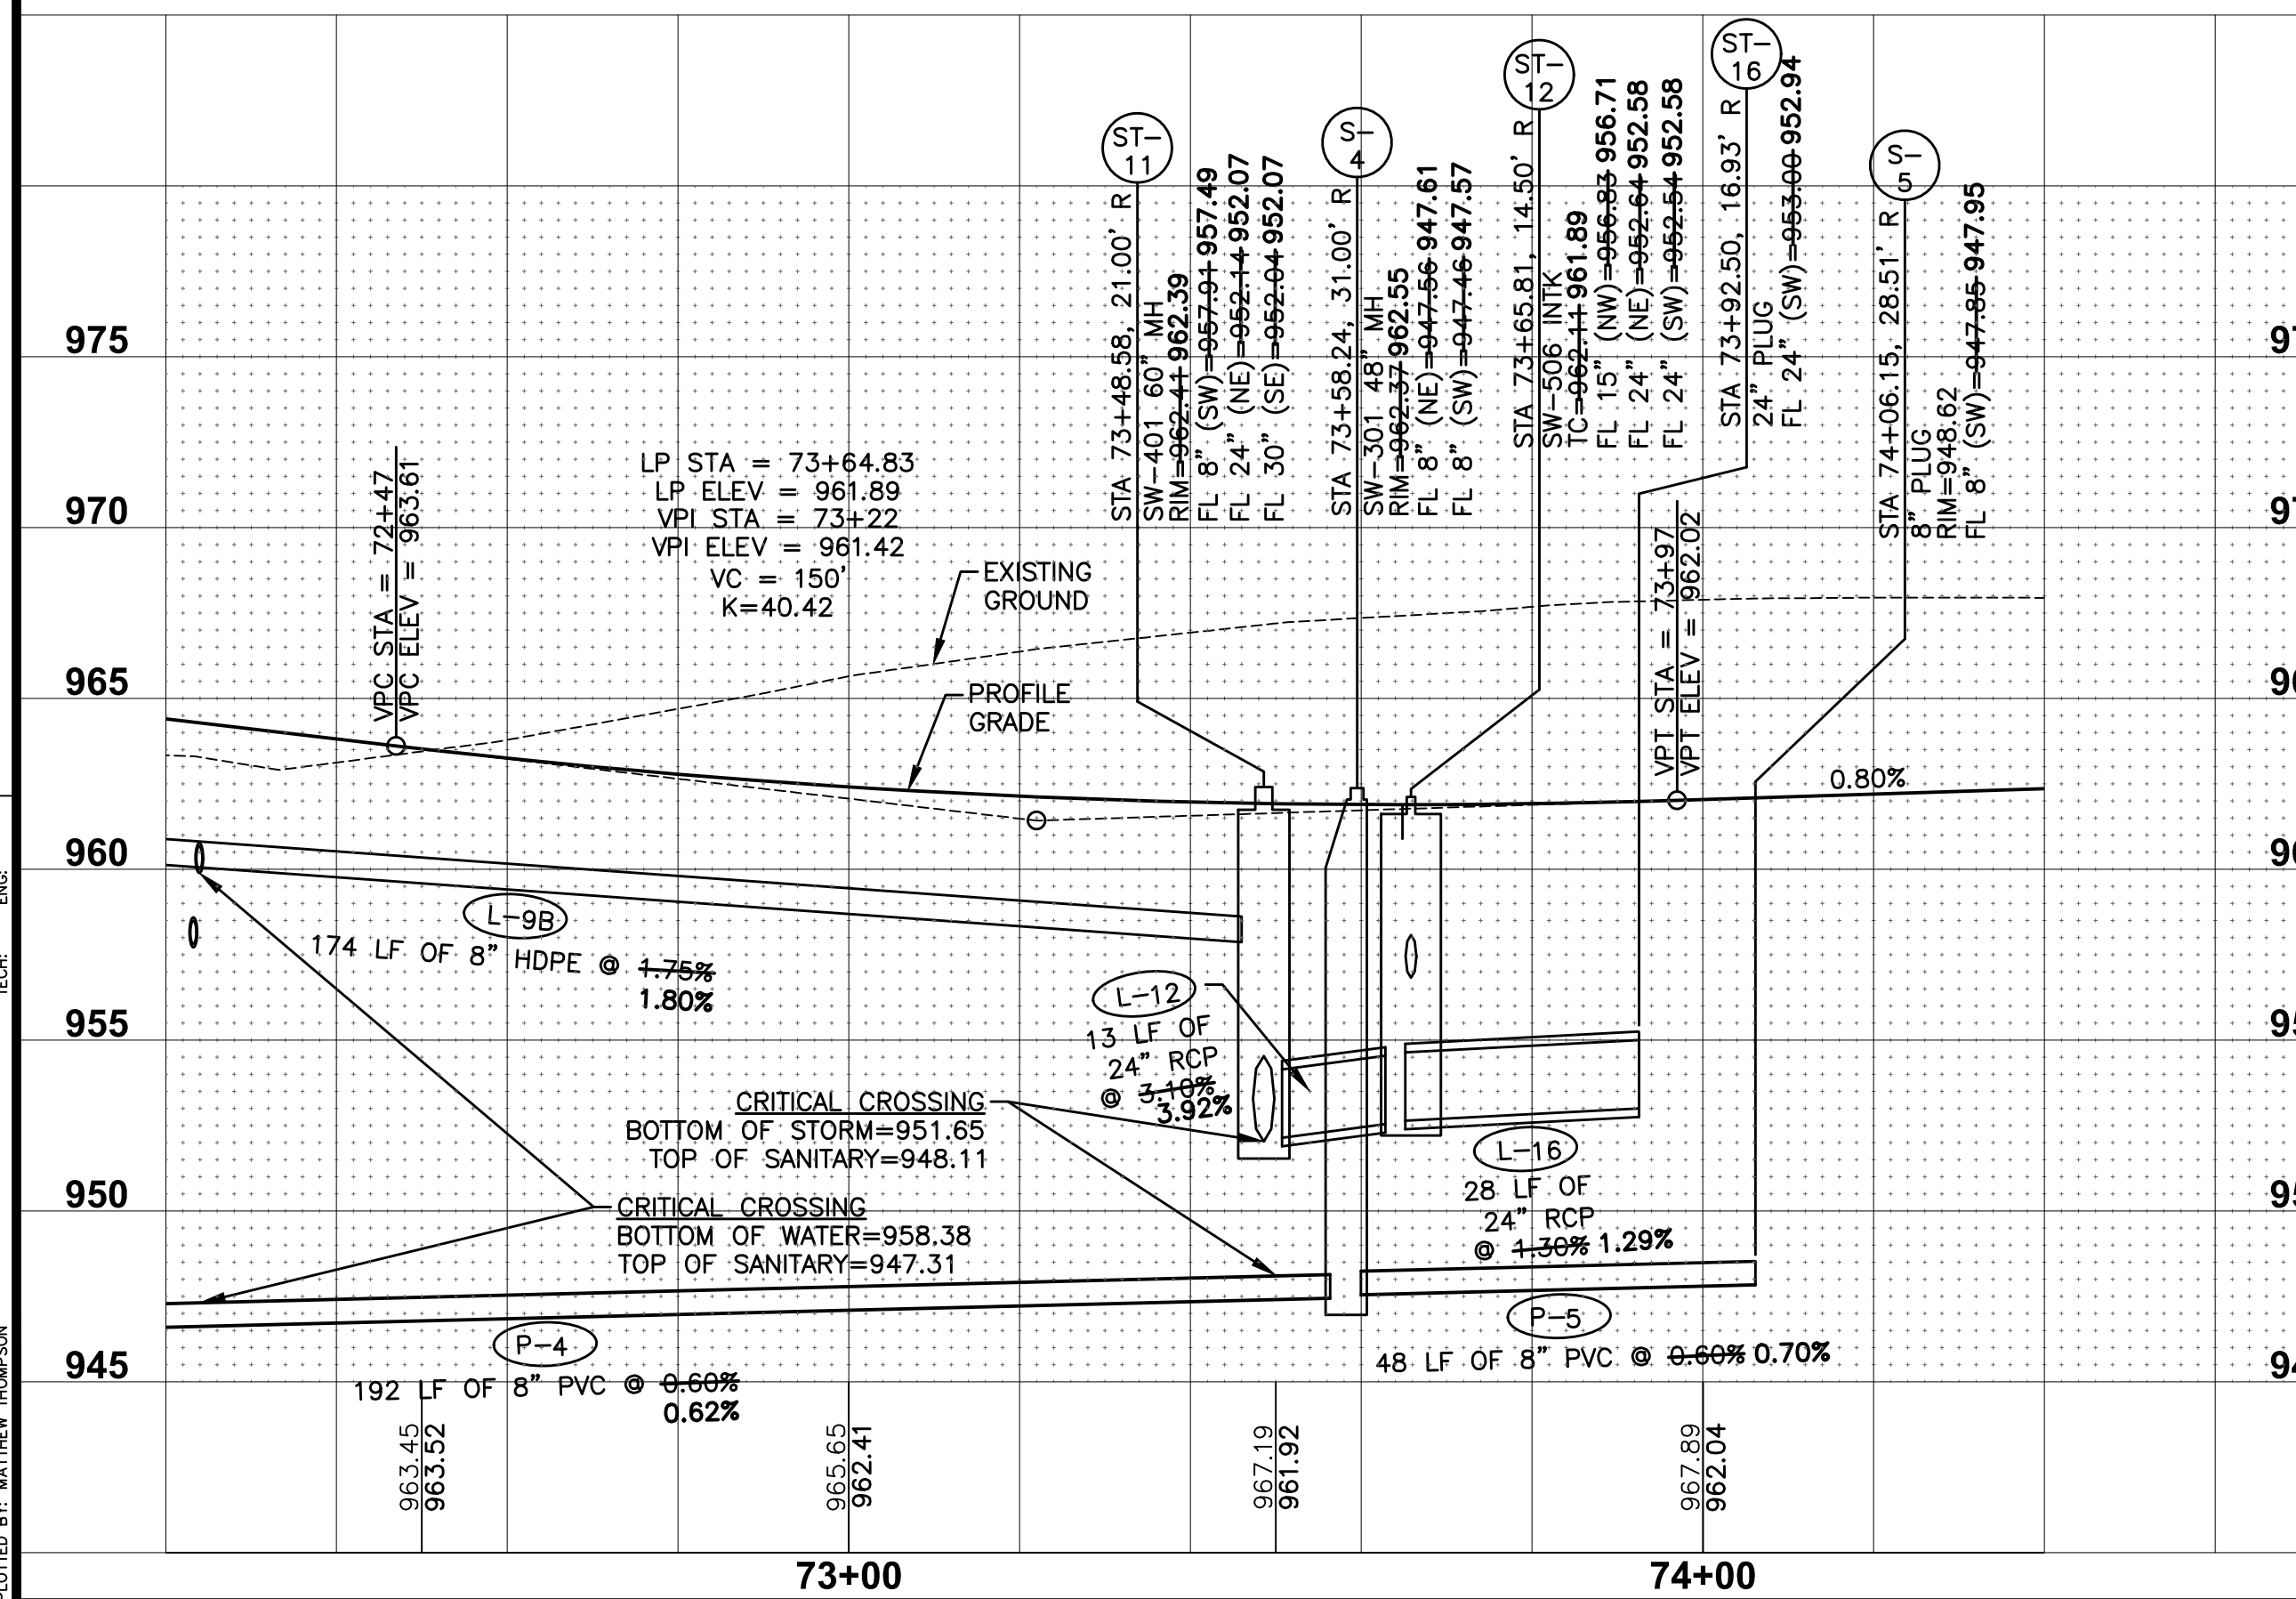



HAMILTON RIDGE PLAT 6
STORM & SANITARY SEWER PLAN AND PROFILE
 WAUKEE, IOWA





CIVIL DESIGN ADVANTAGE

3405 S.E. CROSSROADS DRIVE, SUITE G
 GRIMES, IOWA 50111
 PHONE: (515) 369-4400 FAX: (515) 369-4410

ENGINEER: EKO
 EI: JWM TECH: MST

REVISONS

DATE	REVISIONS
11/01/2022	AS-BUILT SUBMITTAL
10/05/2021	REVISED FINAL SUBMITTAL
9/02/2021	FINAL SUBMITTAL
8/18/2021	THIRD SUBMITTAL
7/26/2021	SECOND SUBMITTAL
7/13/2021	FIRST SUBMITTAL

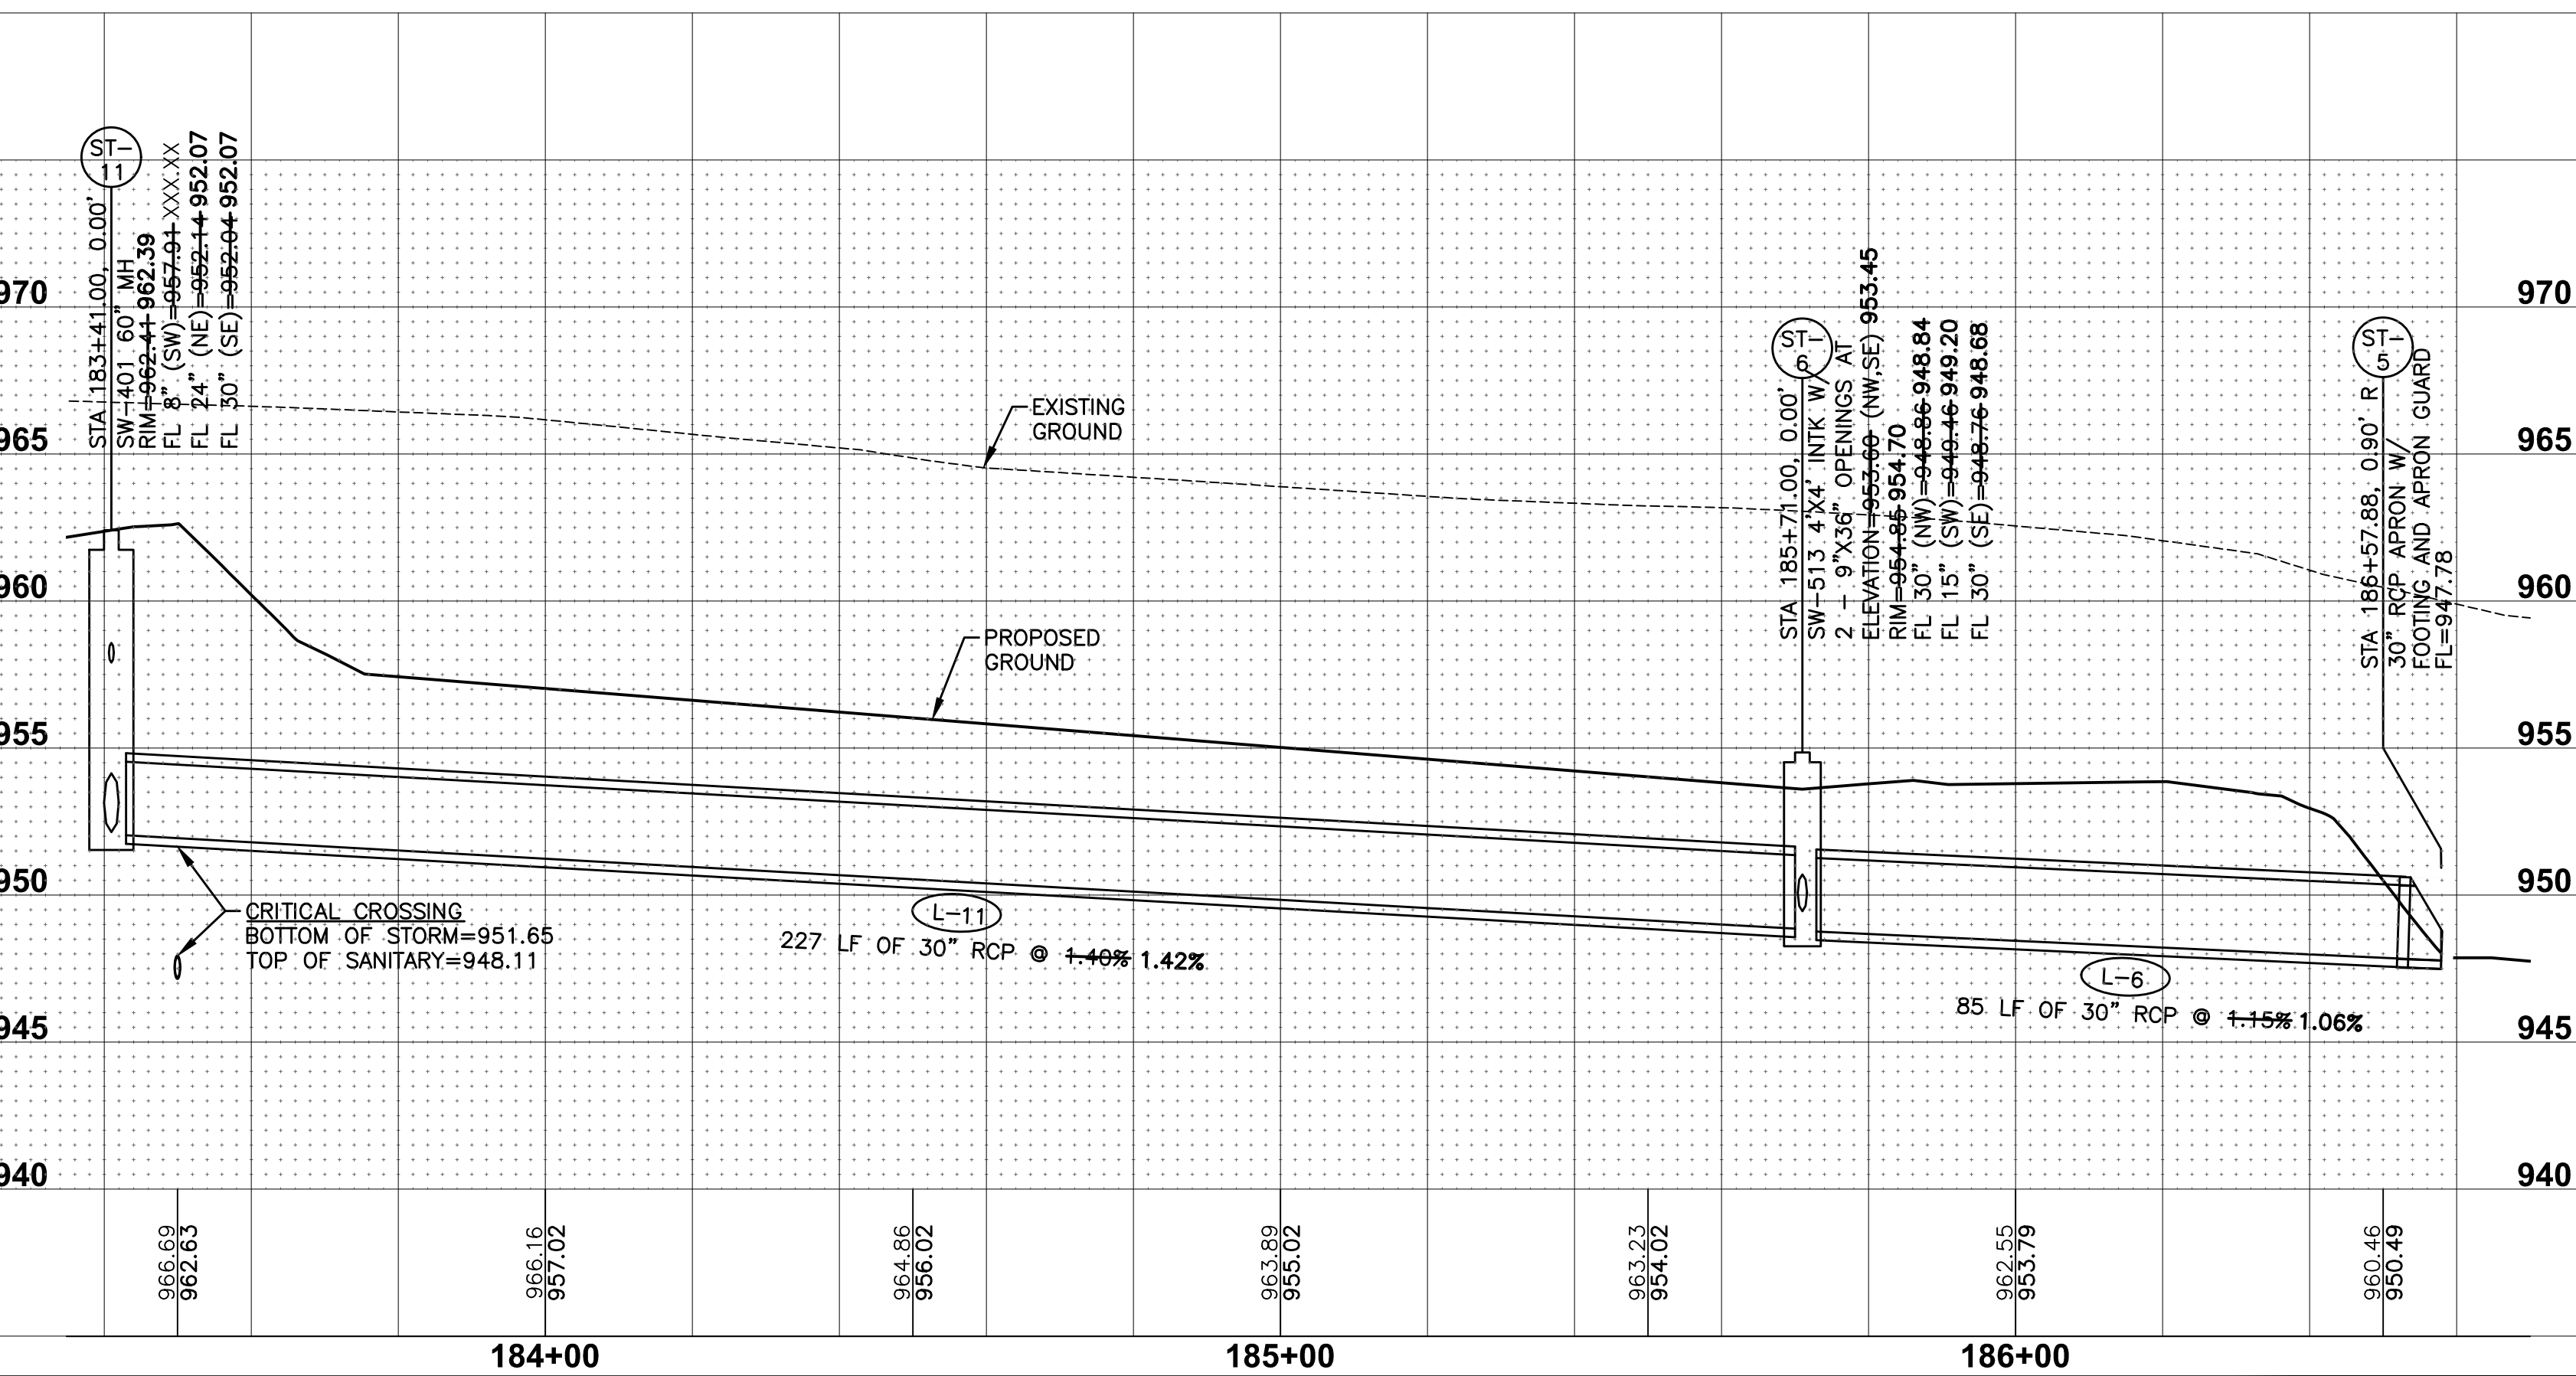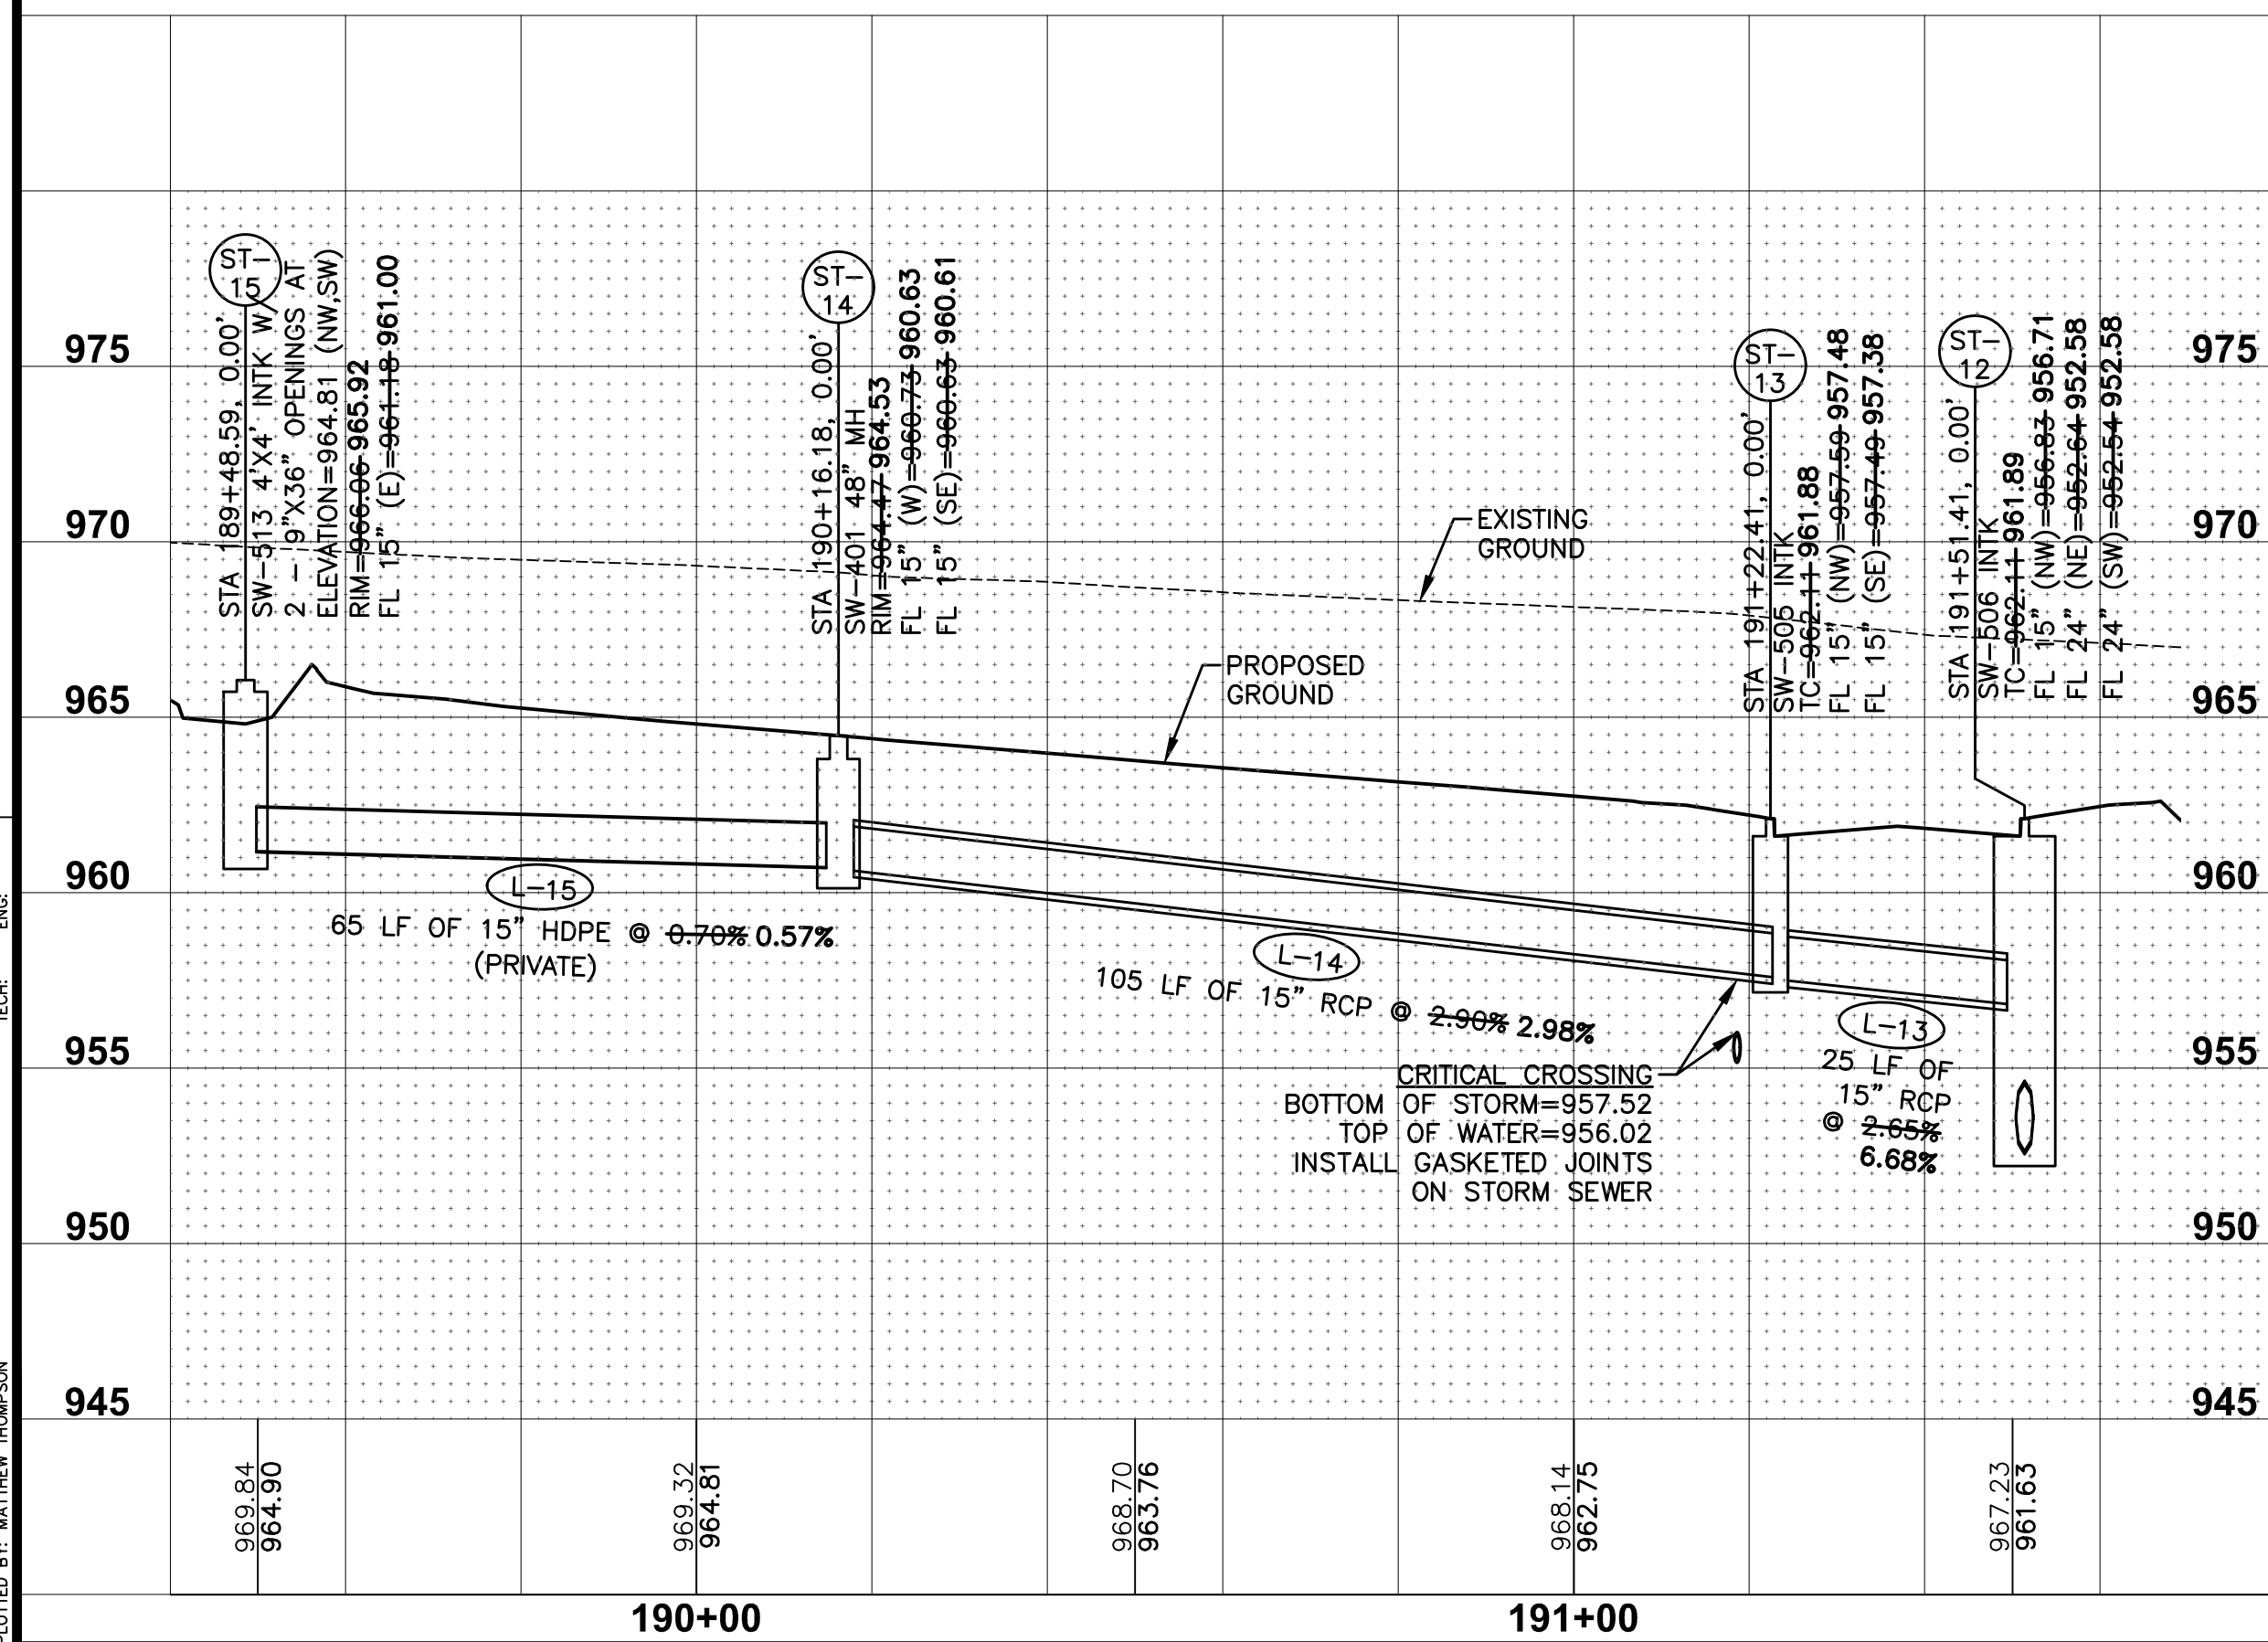

HAMILTON RIDGE PLAT 6

STORM & SANITARY SEWER PLAN AND PROFILE

WAUKEE, IOWA



CIVIL DESIGN ADVANTAGE





3405 S.E. CROSSROADS DRIVE, SUITE G
GRIMES, IOWA 50111

PHONE: (515) 369-4400 FAX: (515) 369-4410

ENGINEER: EKO

EI: JWM TECH: MST

REVISIONS	DATE
AS-BUILT SUBMITTAL	11/01/2022
REVISED FINAL SUBMITTAL	10/05/2021
FINAL SUBMITTAL	9/02/2021
THIRD SUBMITTAL	8/18/2021
SECOND SUBMITTAL	7/26/2021
FIRST SUBMITTAL	7/13/2021

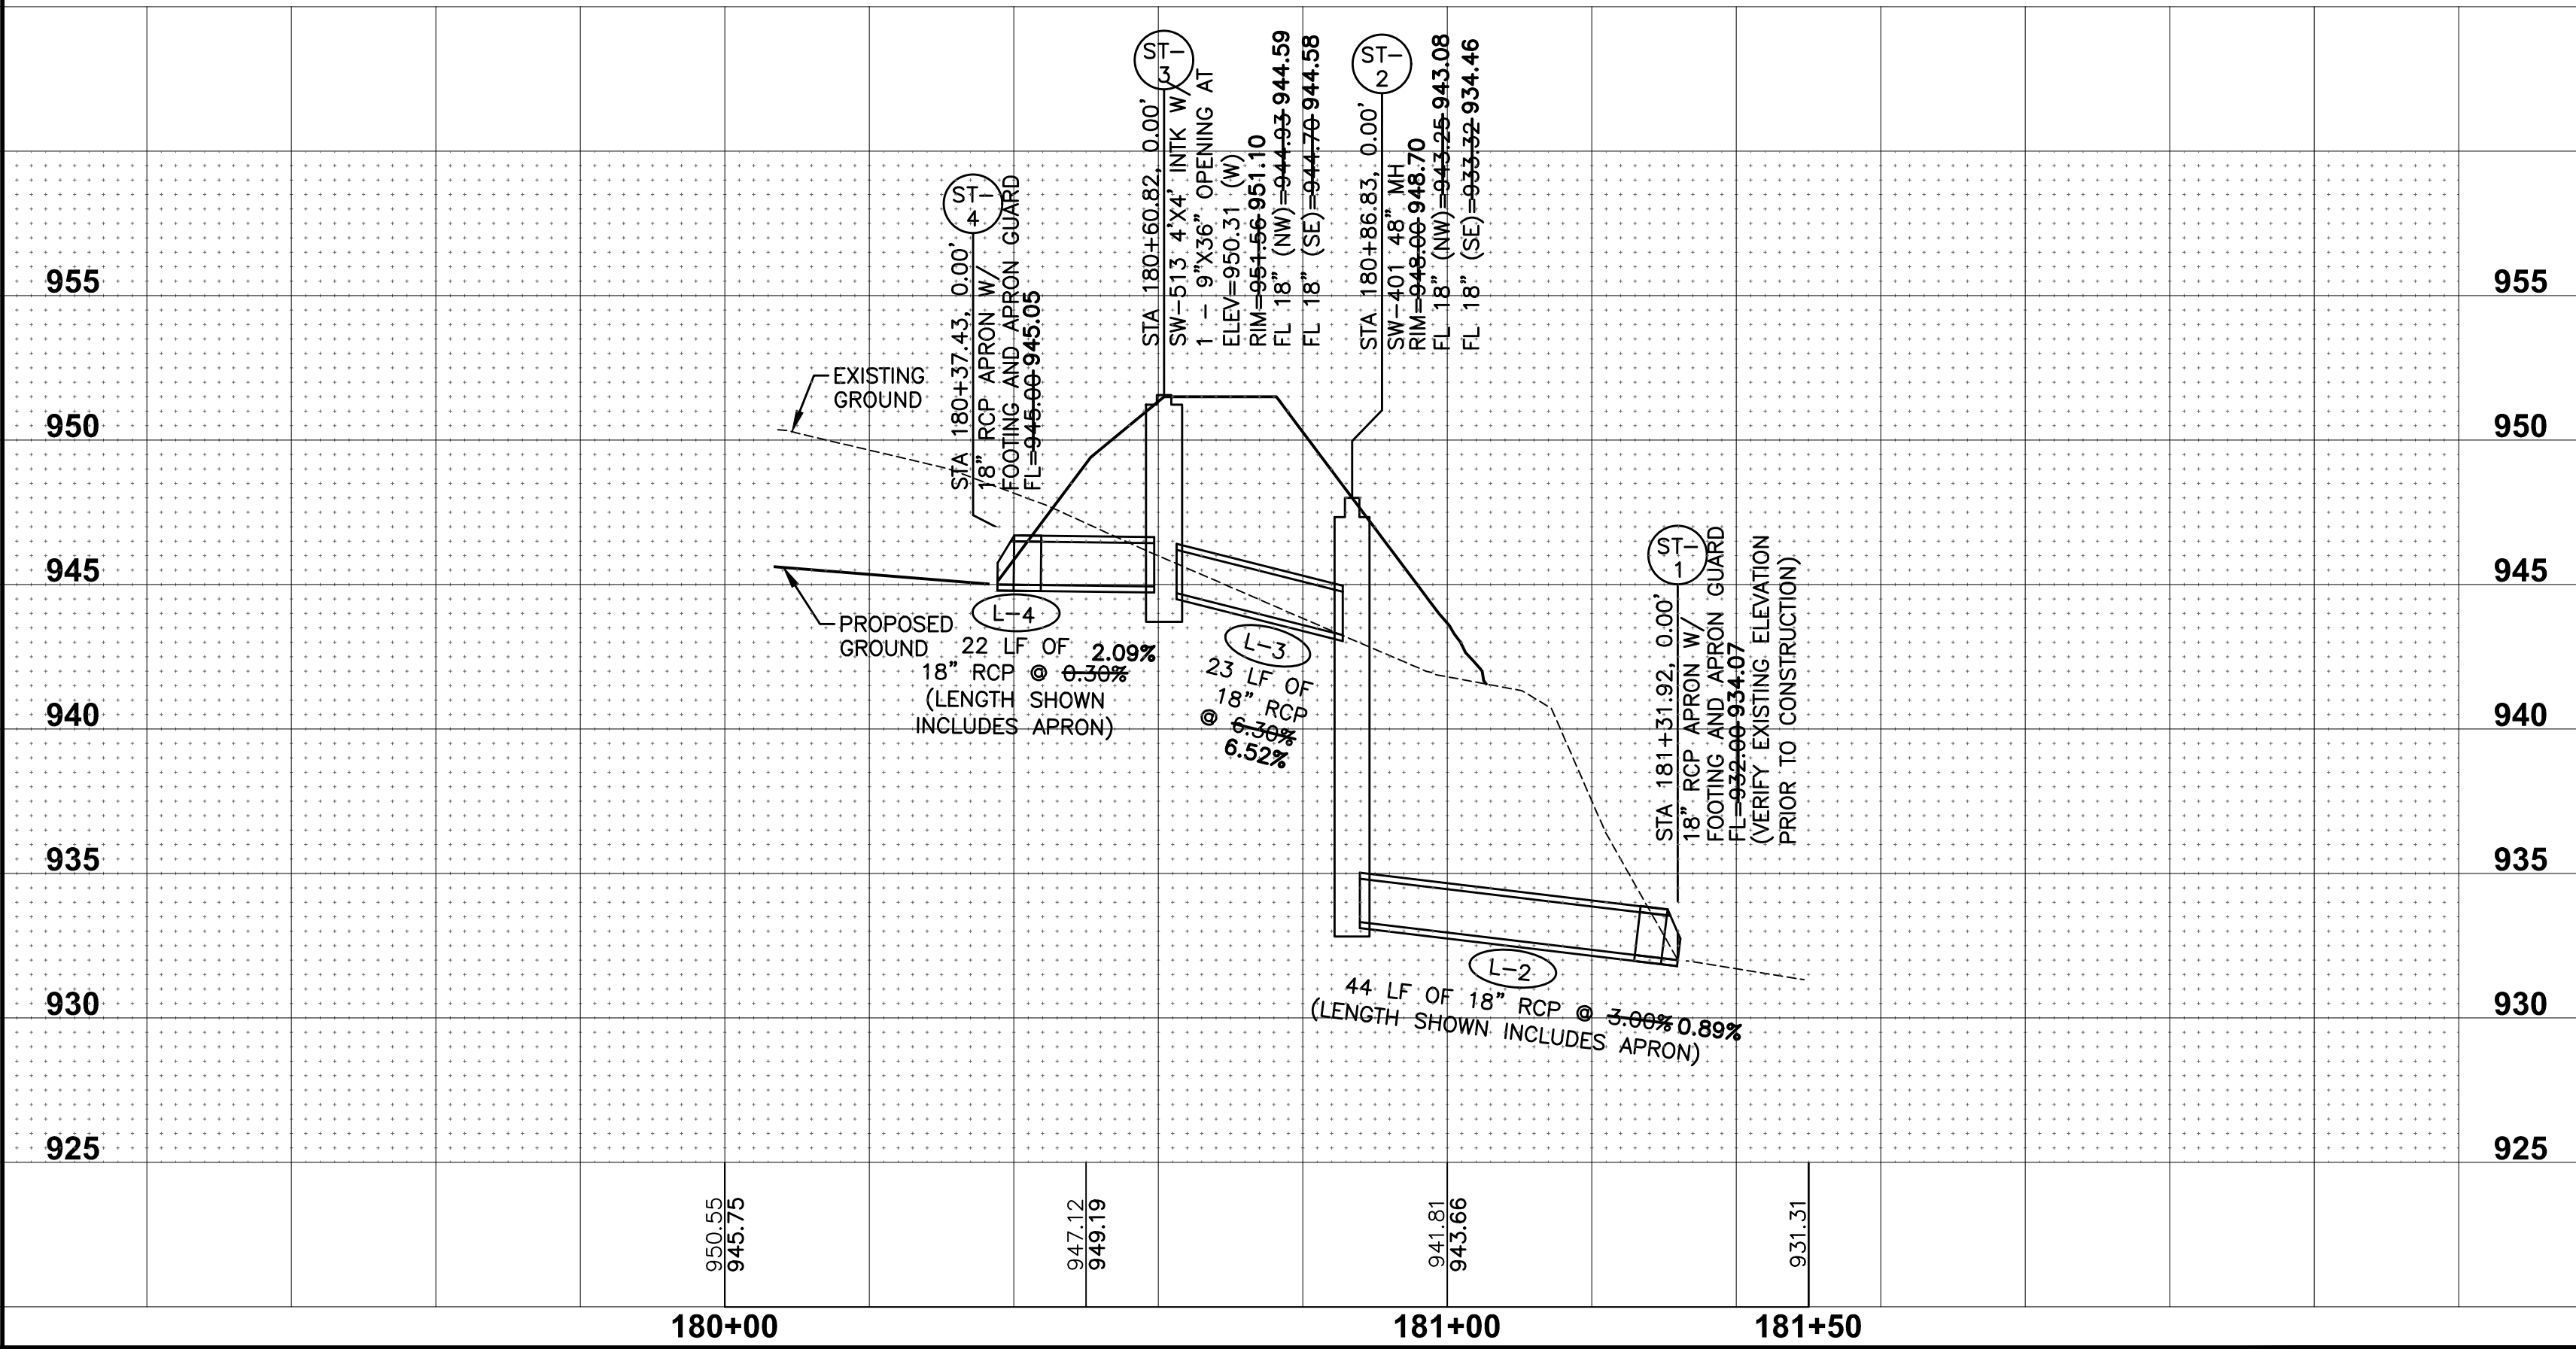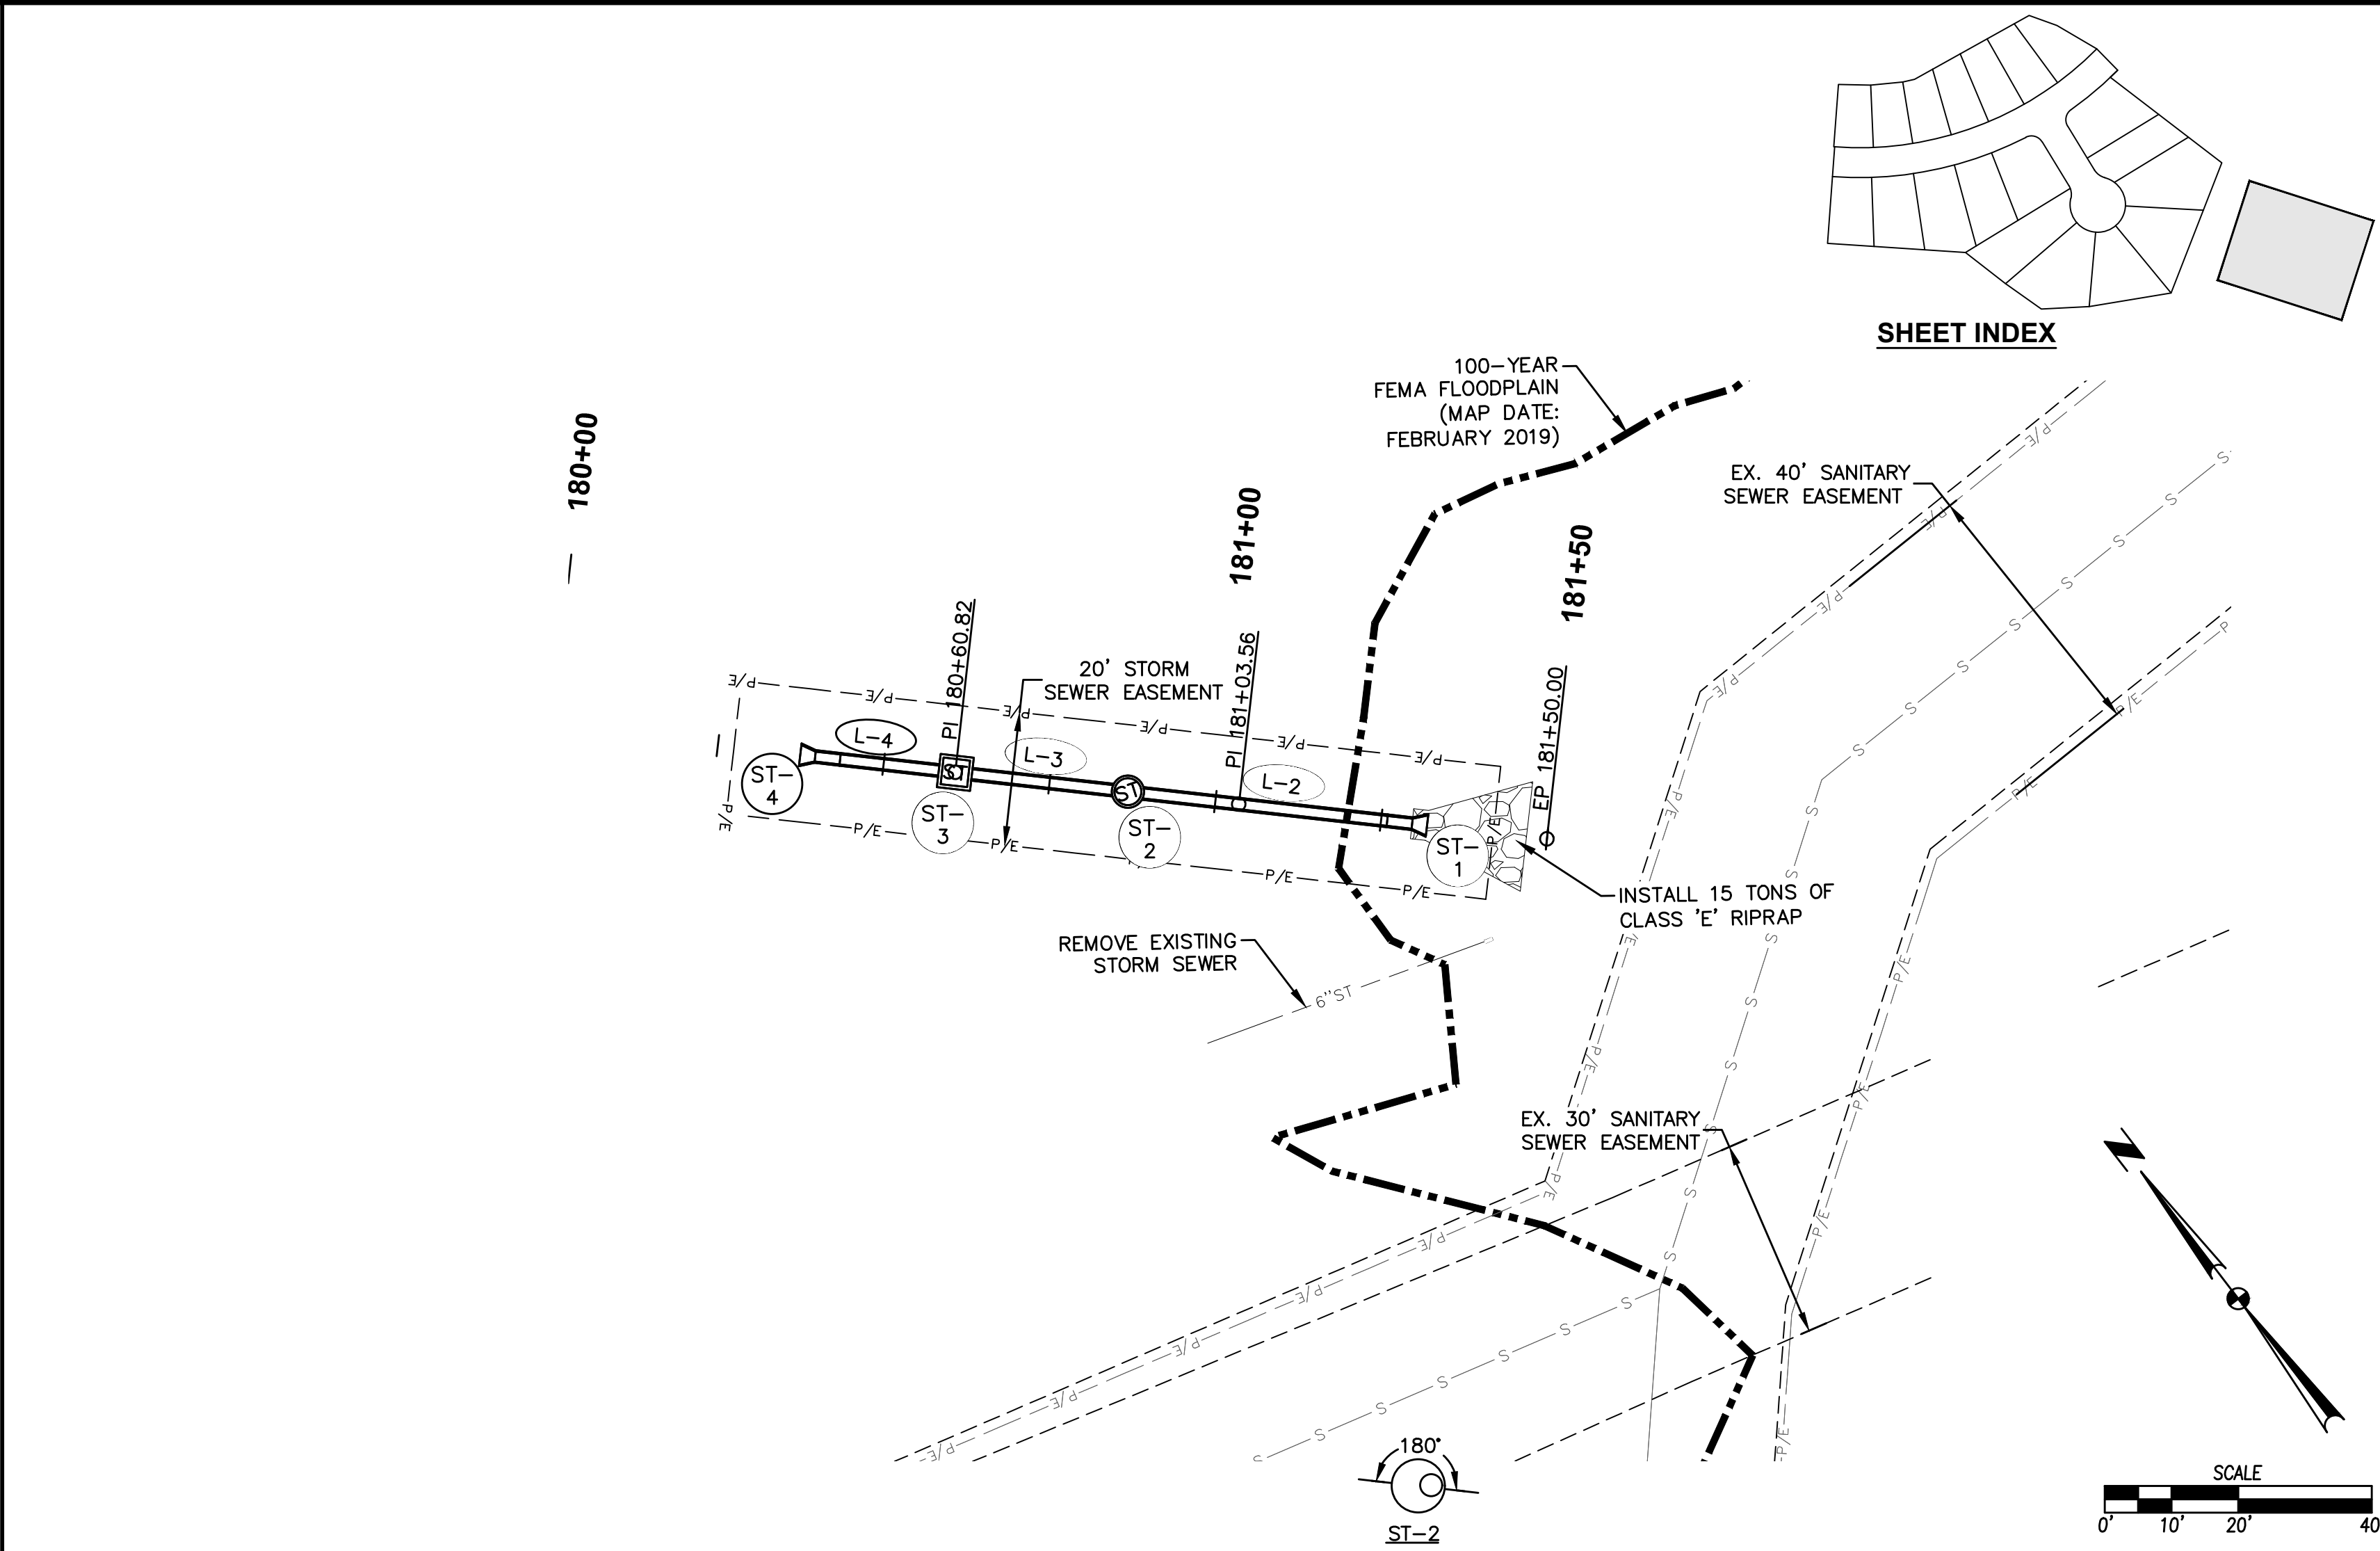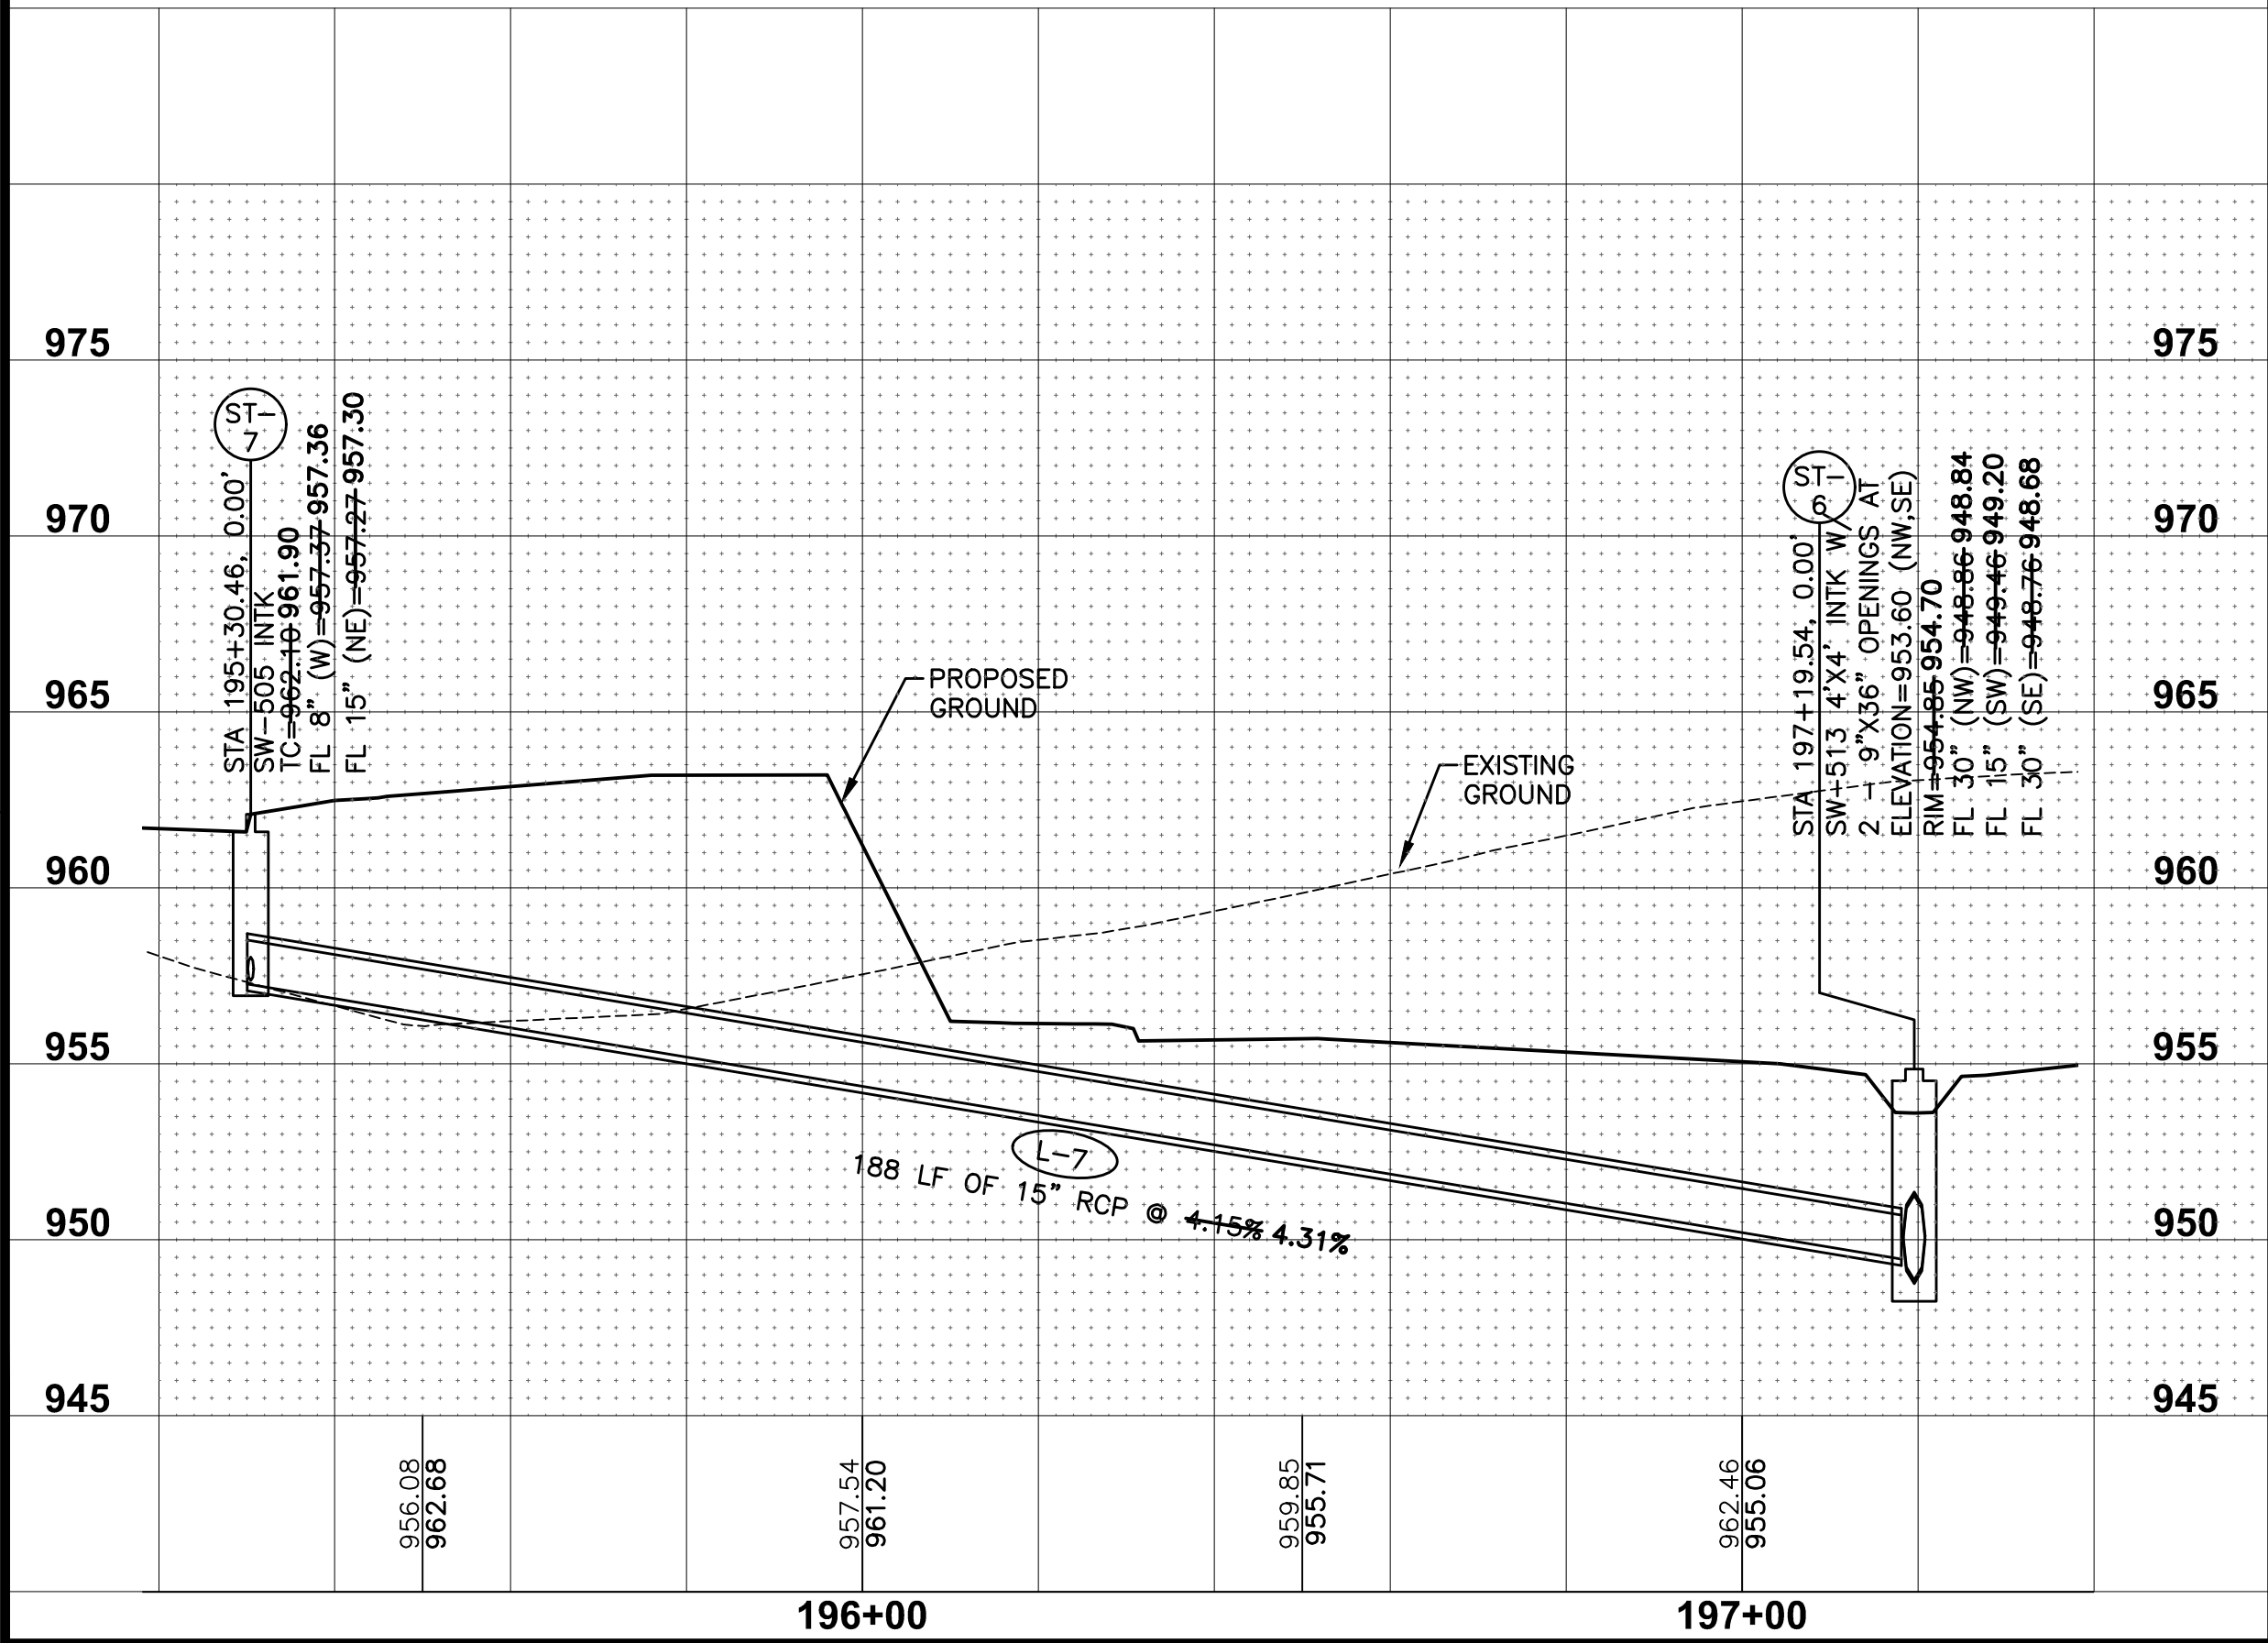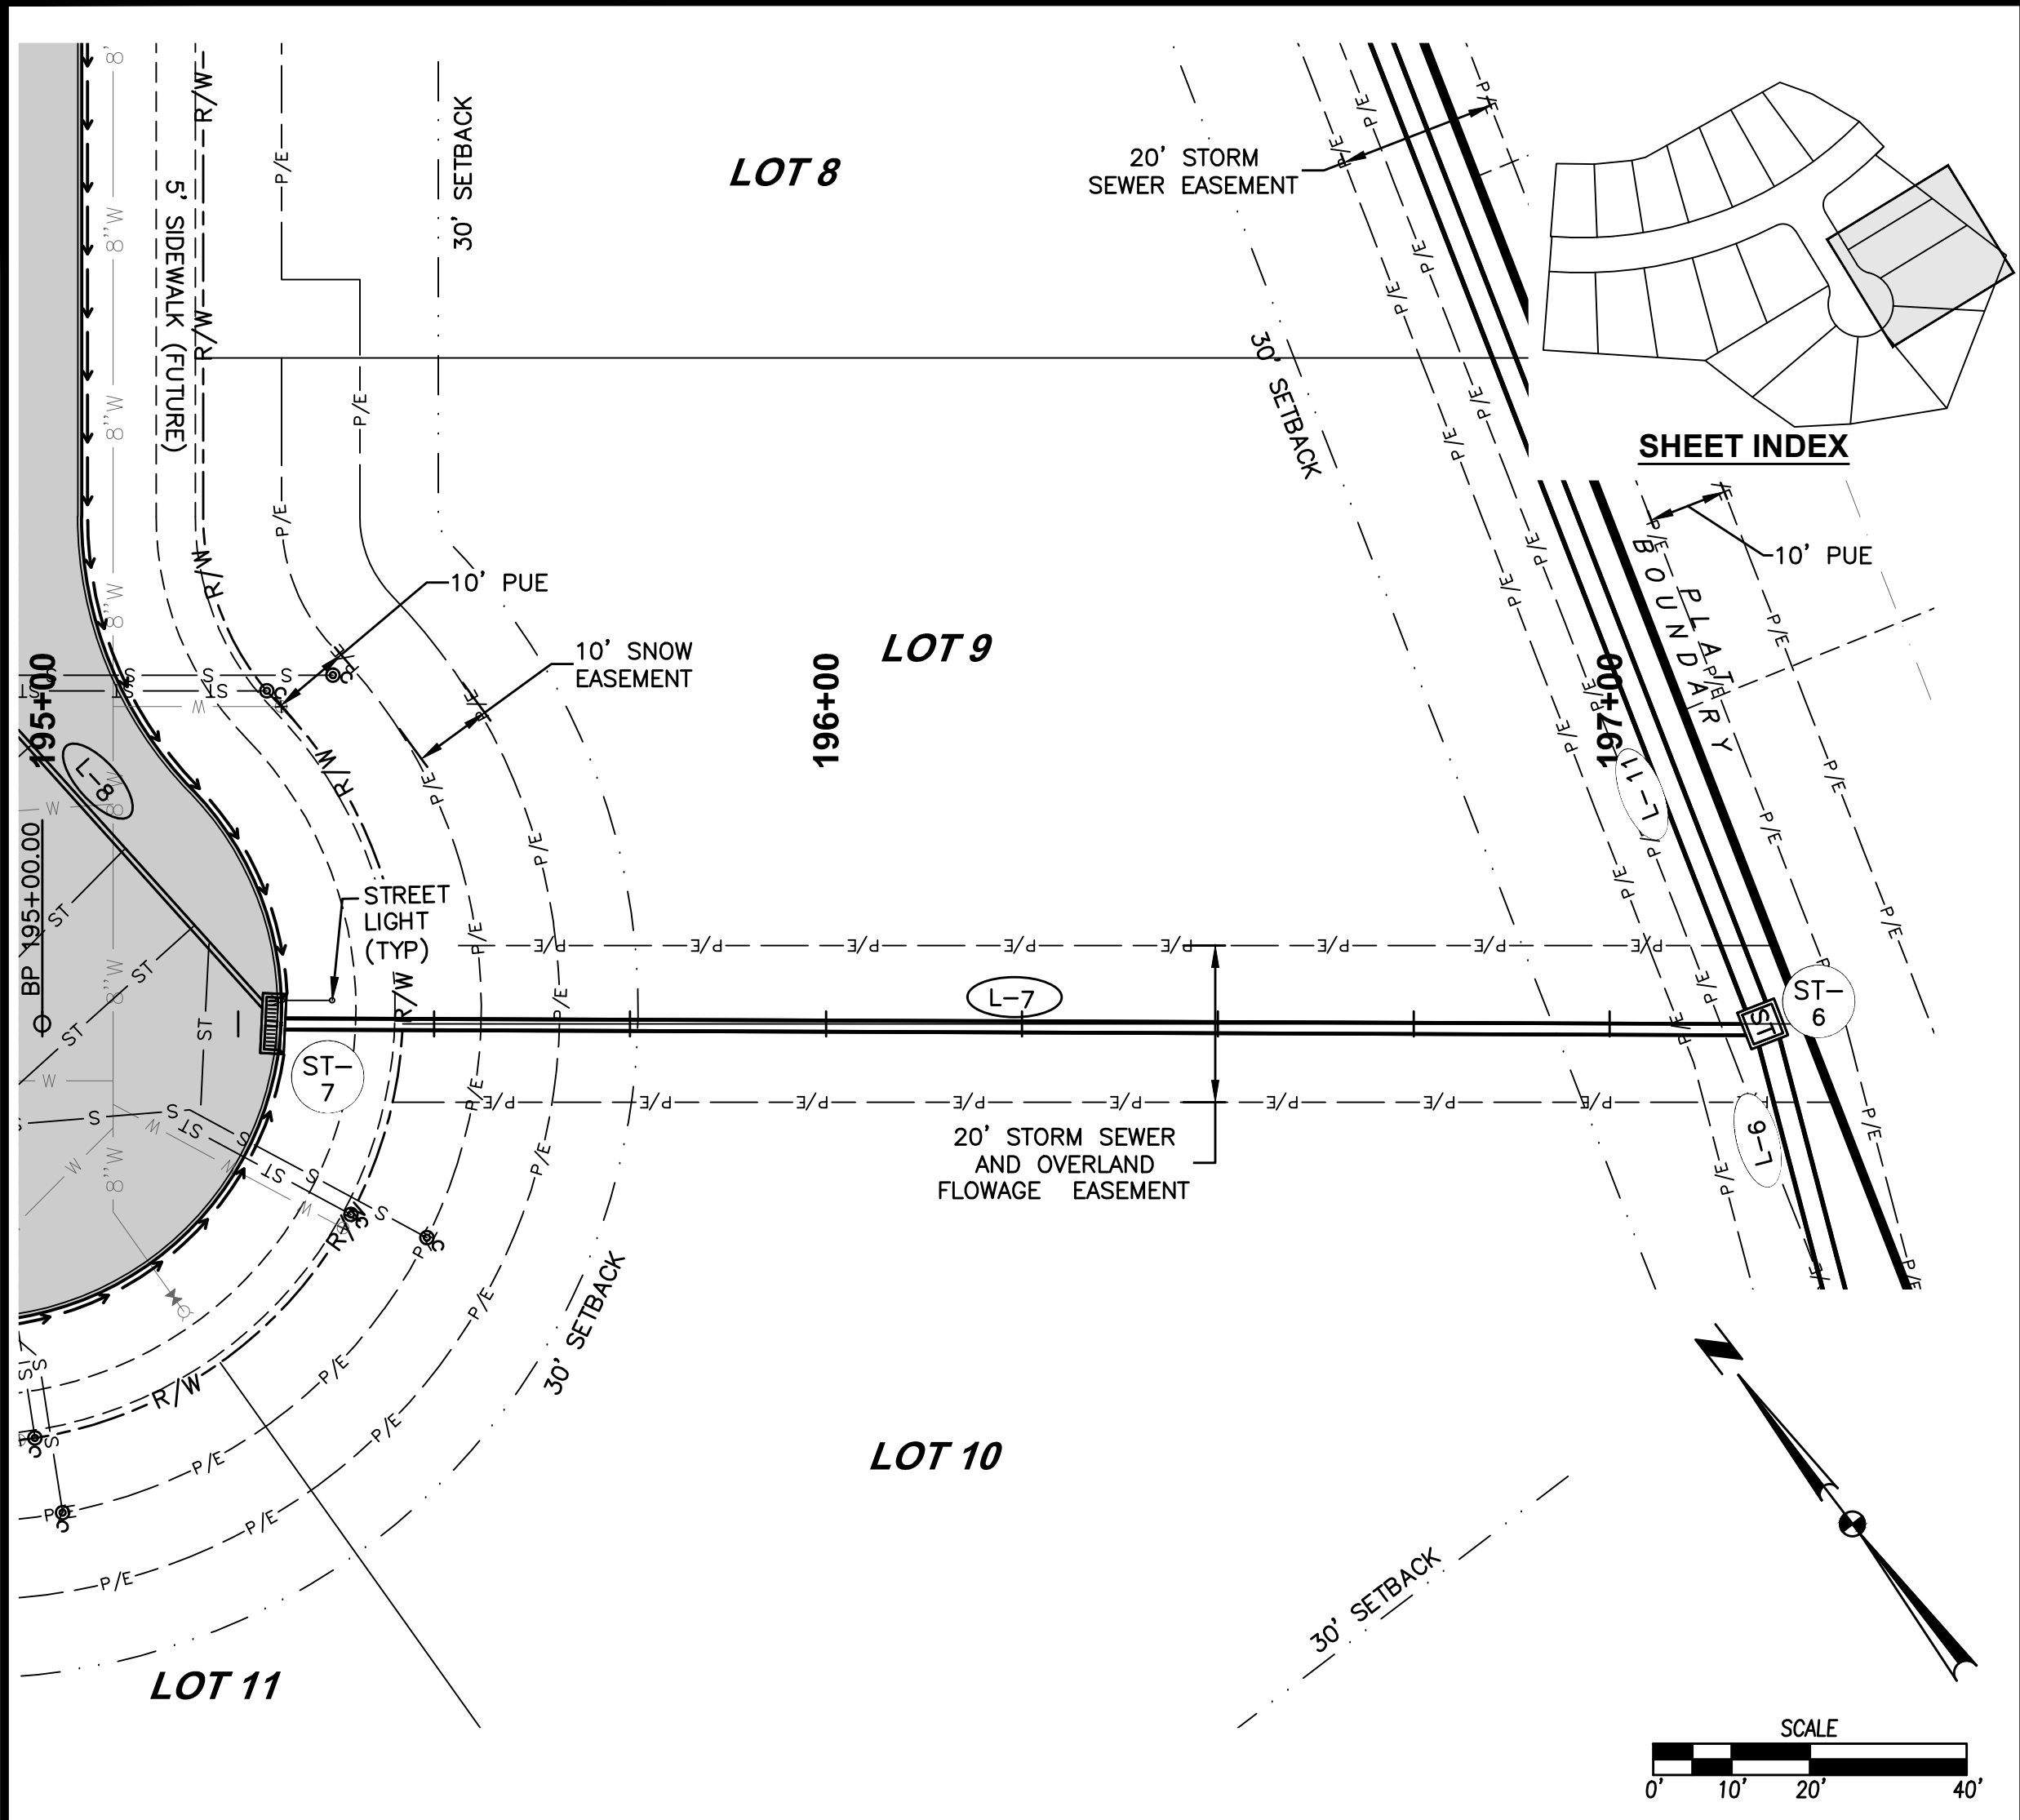

HAMILTON RIDGE PLAT 6

STORM & SANITARY SEWER PLAN AND PROFILE

WAUKEE, IOWA

DATE

11/01/2022

AS-BUILT SUBMITTAL

10/05/2021

REVISED FINAL SUBMITTAL

09/02/2021

FINAL SUBMITTAL

08/18/2021

THIRD SUBMITTAL

07/26/2021

SECOND SUBMITTAL

07/13/2021



FIRST SUBMITTAL

07/13/2021

REVISIONS

3405 S.E. CROSSROADS DRIVE, SUITE G
GRIMES, IOWA 50111
PHONE: (515) 369-4400 FAX: (515) 369-4410
ENGINEER: EKO
EI: JWM TECH: MST

FILE: H:\2021\2106479\DWG\2106479-PWP-WATERMAIN-ASBUILT.DWG
COMMENTS: AS-BUILT
PLOT DATE: 11/7/2022 3:20 PM
PLOT BY: WATKIN THOMPSON

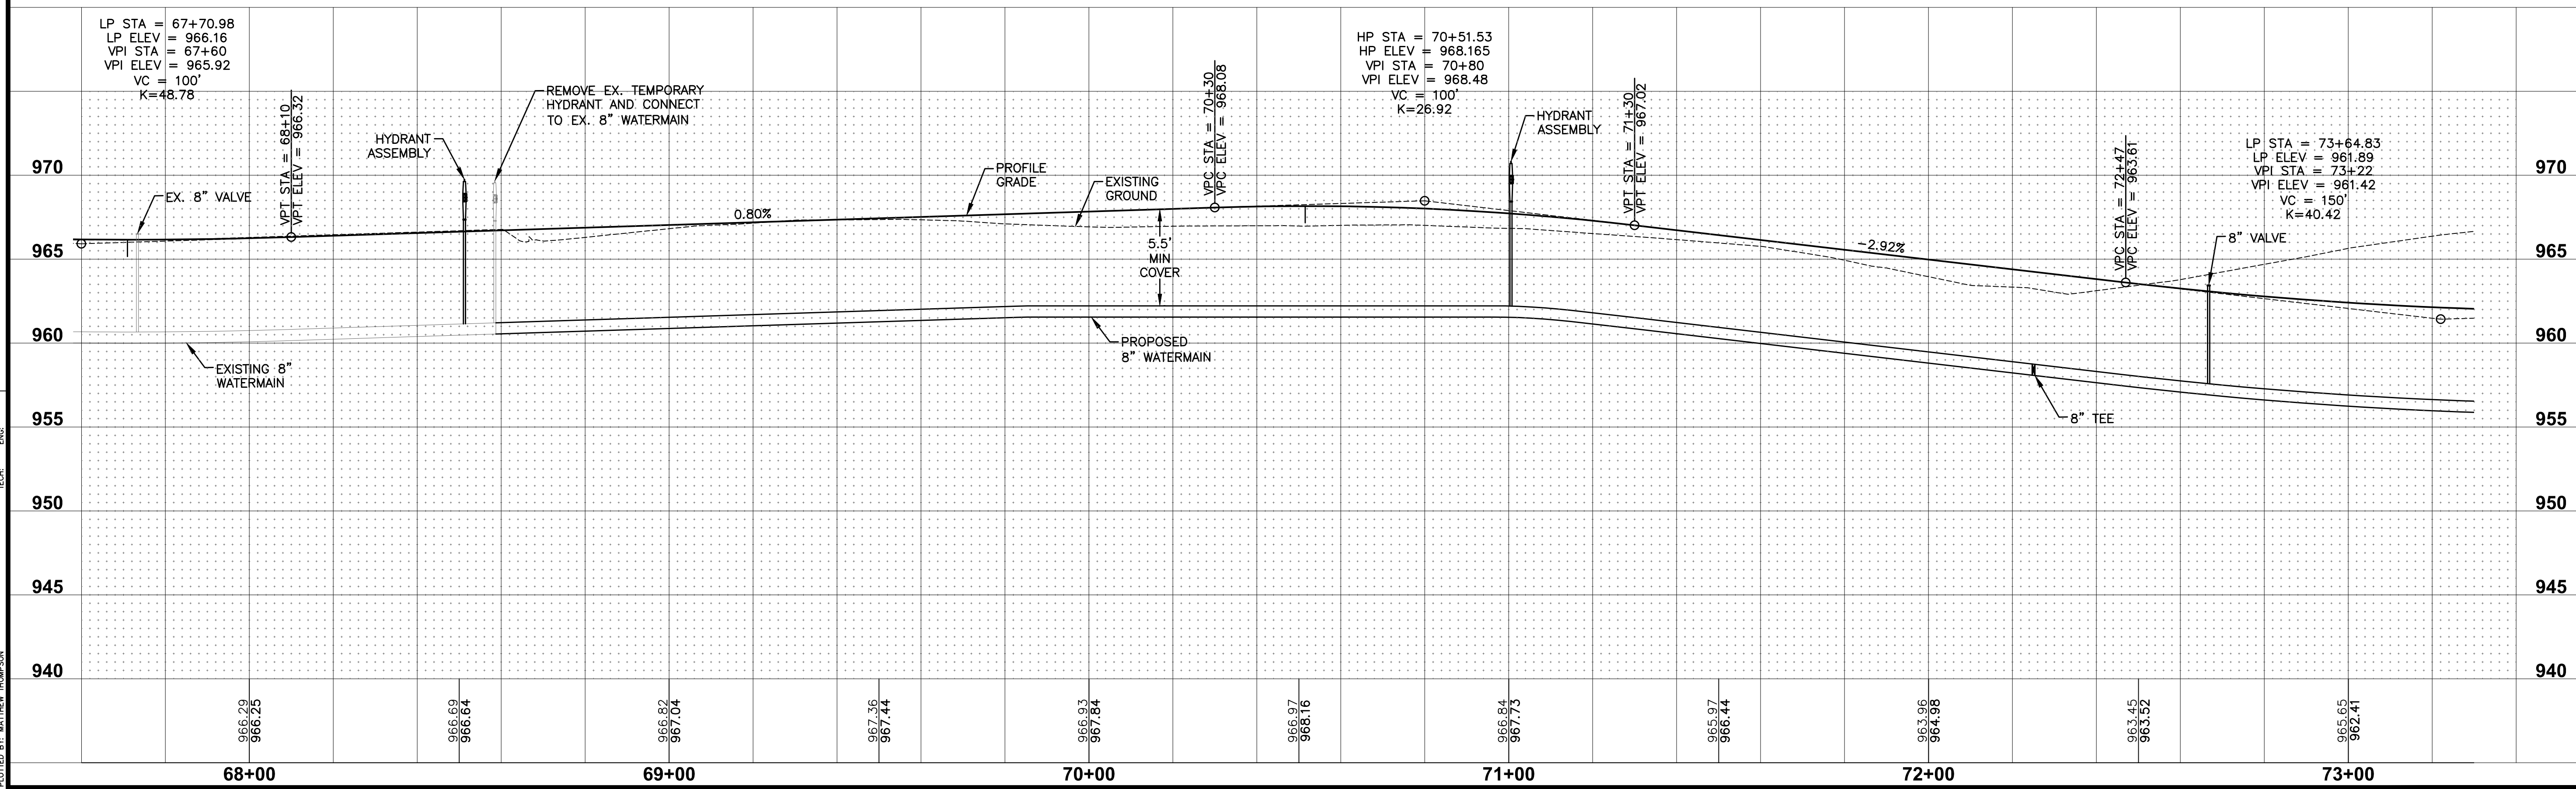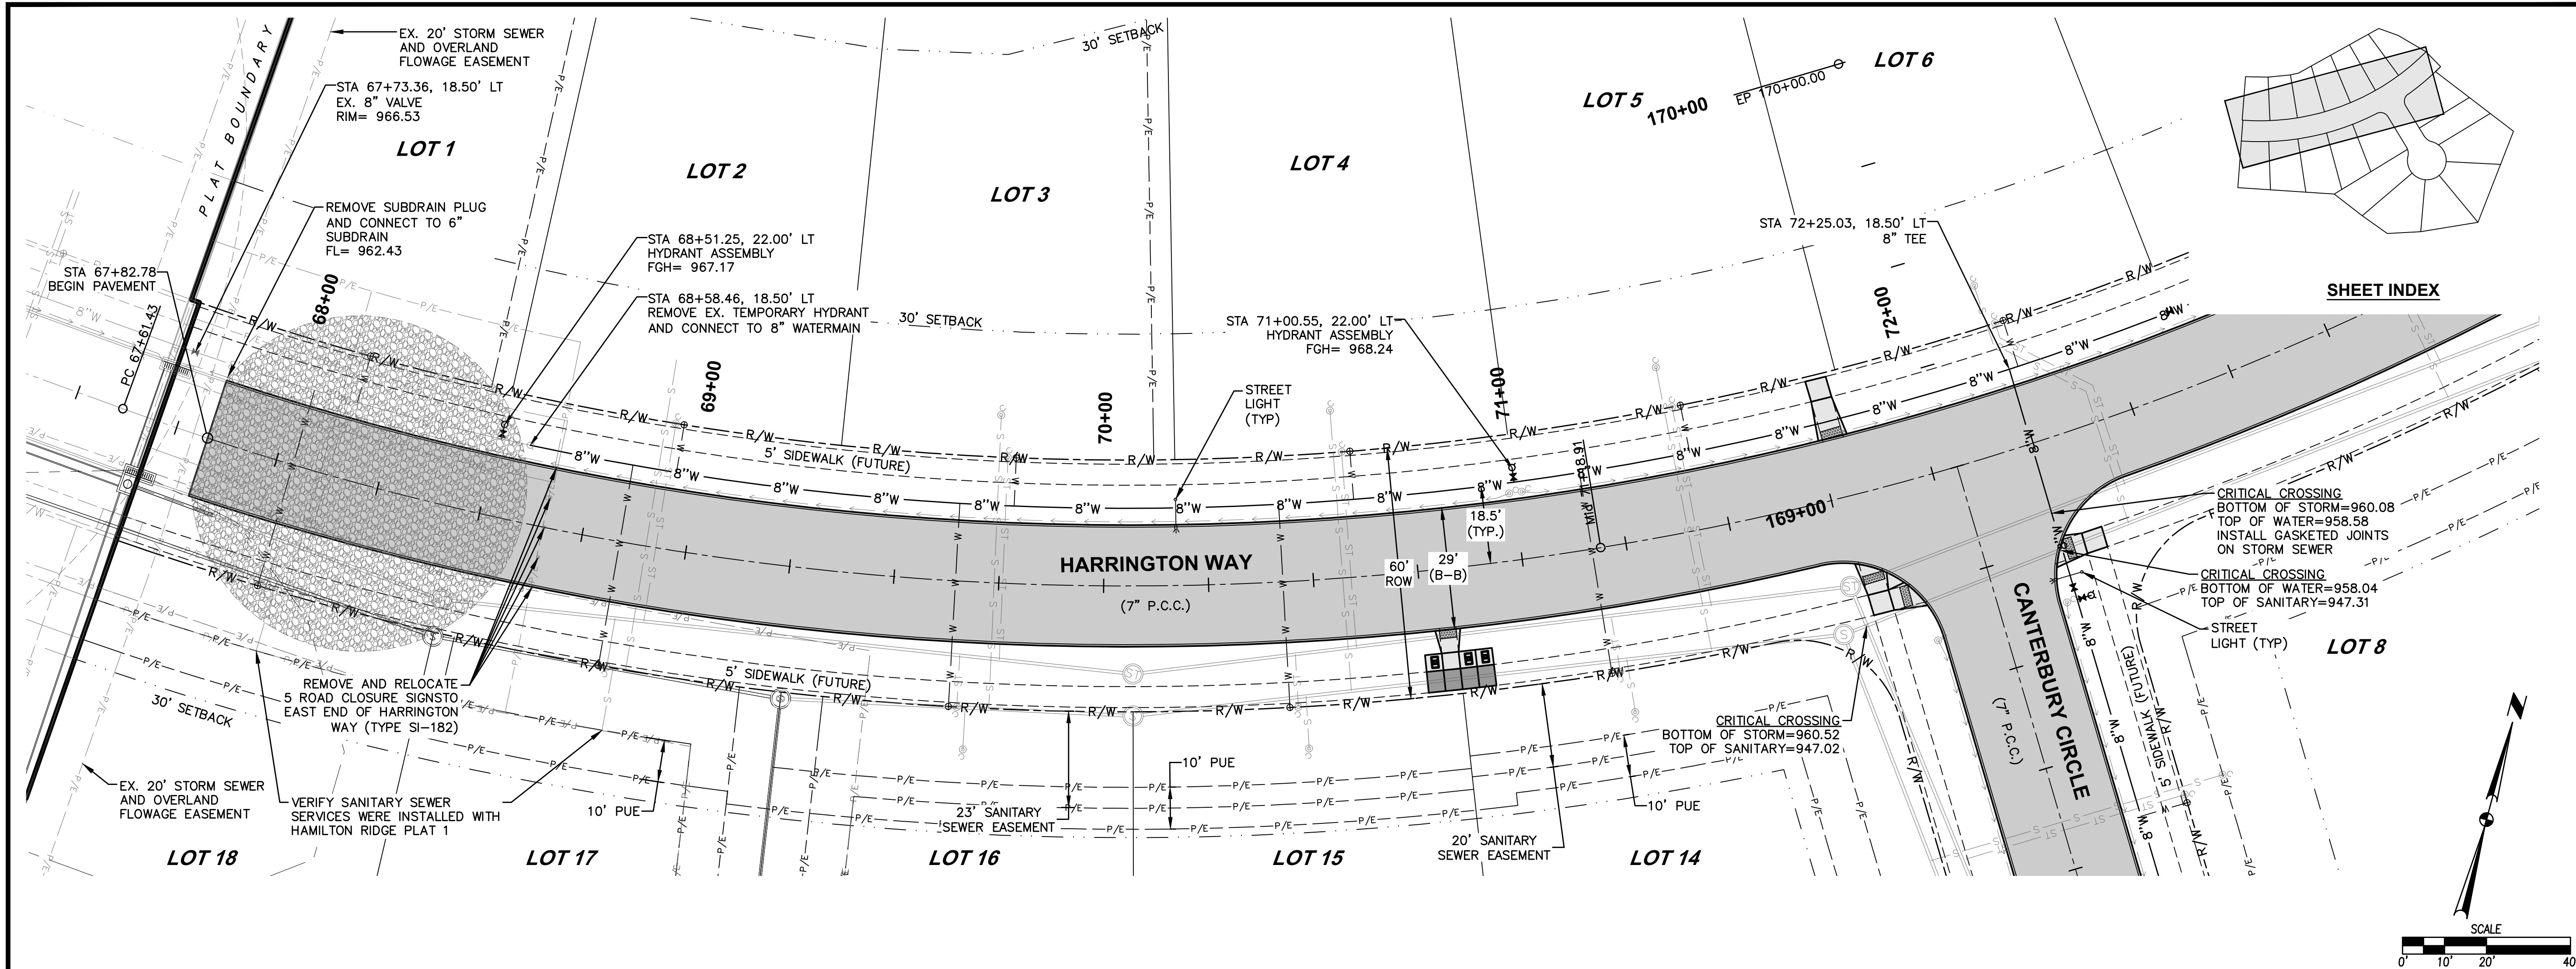

HAMILTON RIDGE PLAT 6

WATERMAIN PLAN AND PROFILE

15/18

2106.479

DATE

11/01/2022

AS-BUILT SUBMITTAL

10/05/2021

REVISED FINAL SUBMITTAL

09/02/2021

FINAL SUBMITTAL

08/18/2021

THIRD SUBMITTAL

07/26/2021

FIRST SUBMITTAL



07/13/2021

REVISIONS

3405 S.E. CROSSROADS DRIVE, SUITE G
GRIMES, IOWA 50111
PHONE: (515) 369-4400 FAX: (515) 369-4410

ENGINEER: EKO

EI: JWM TECH: MST

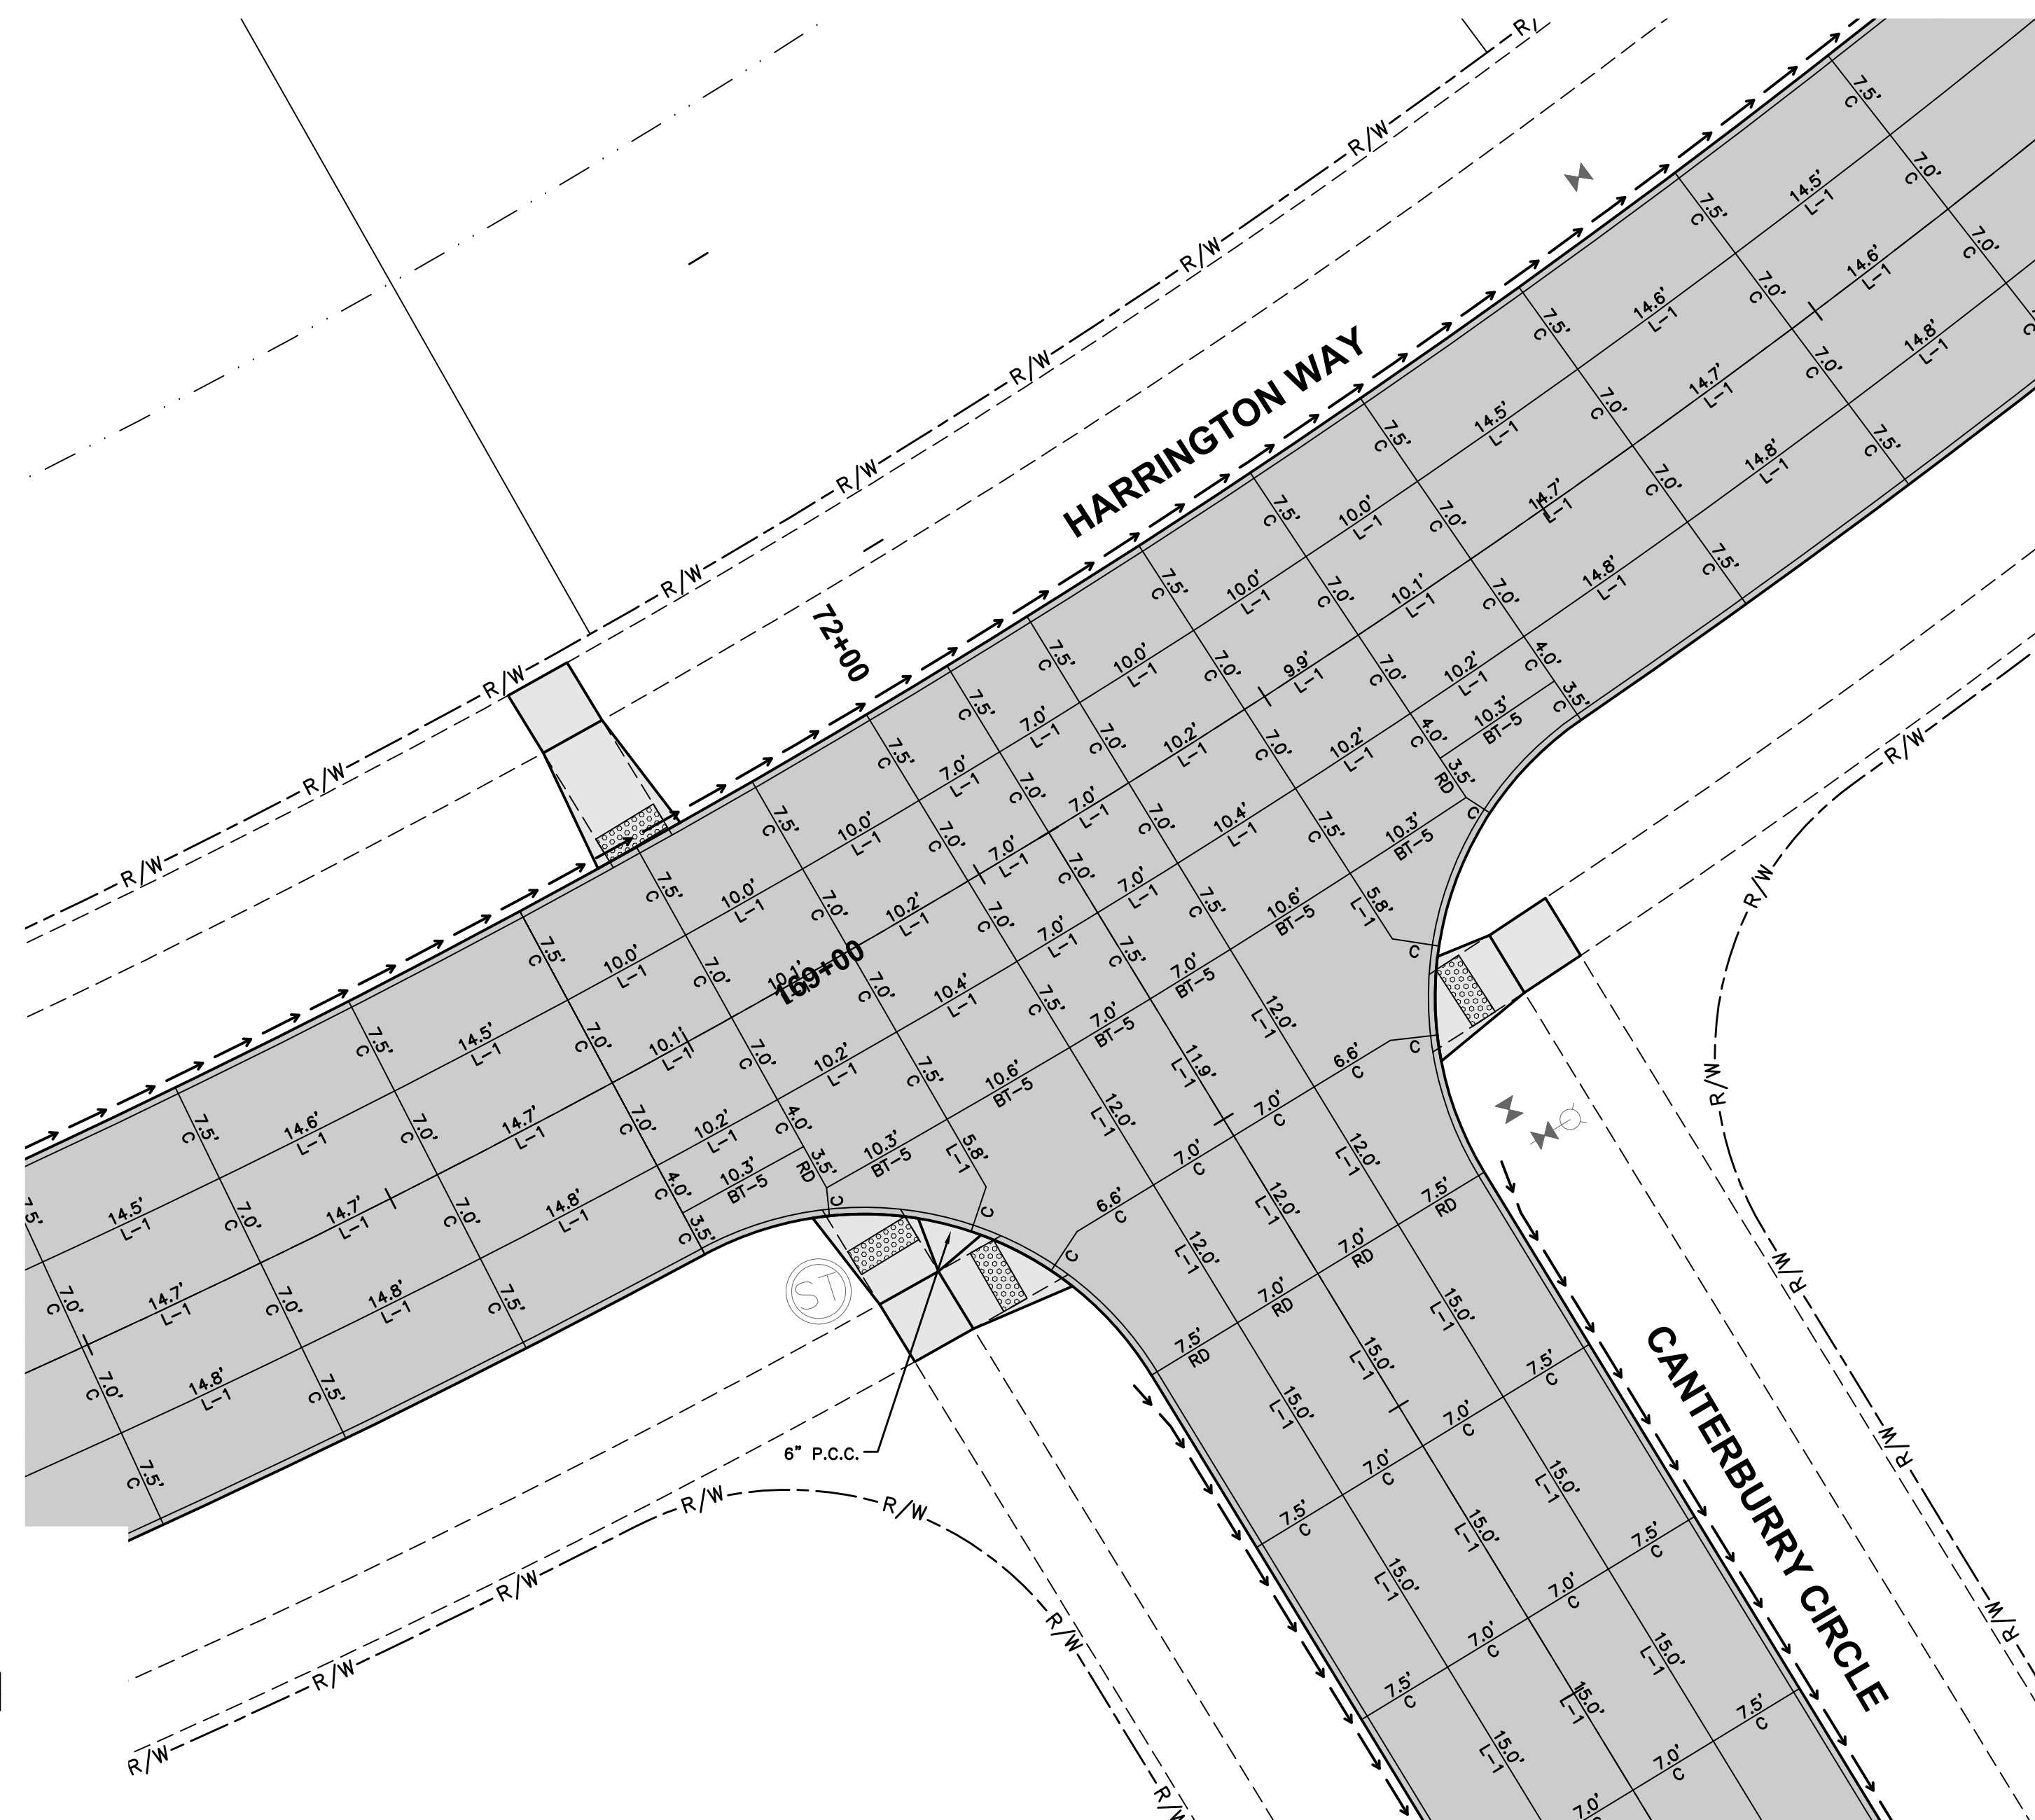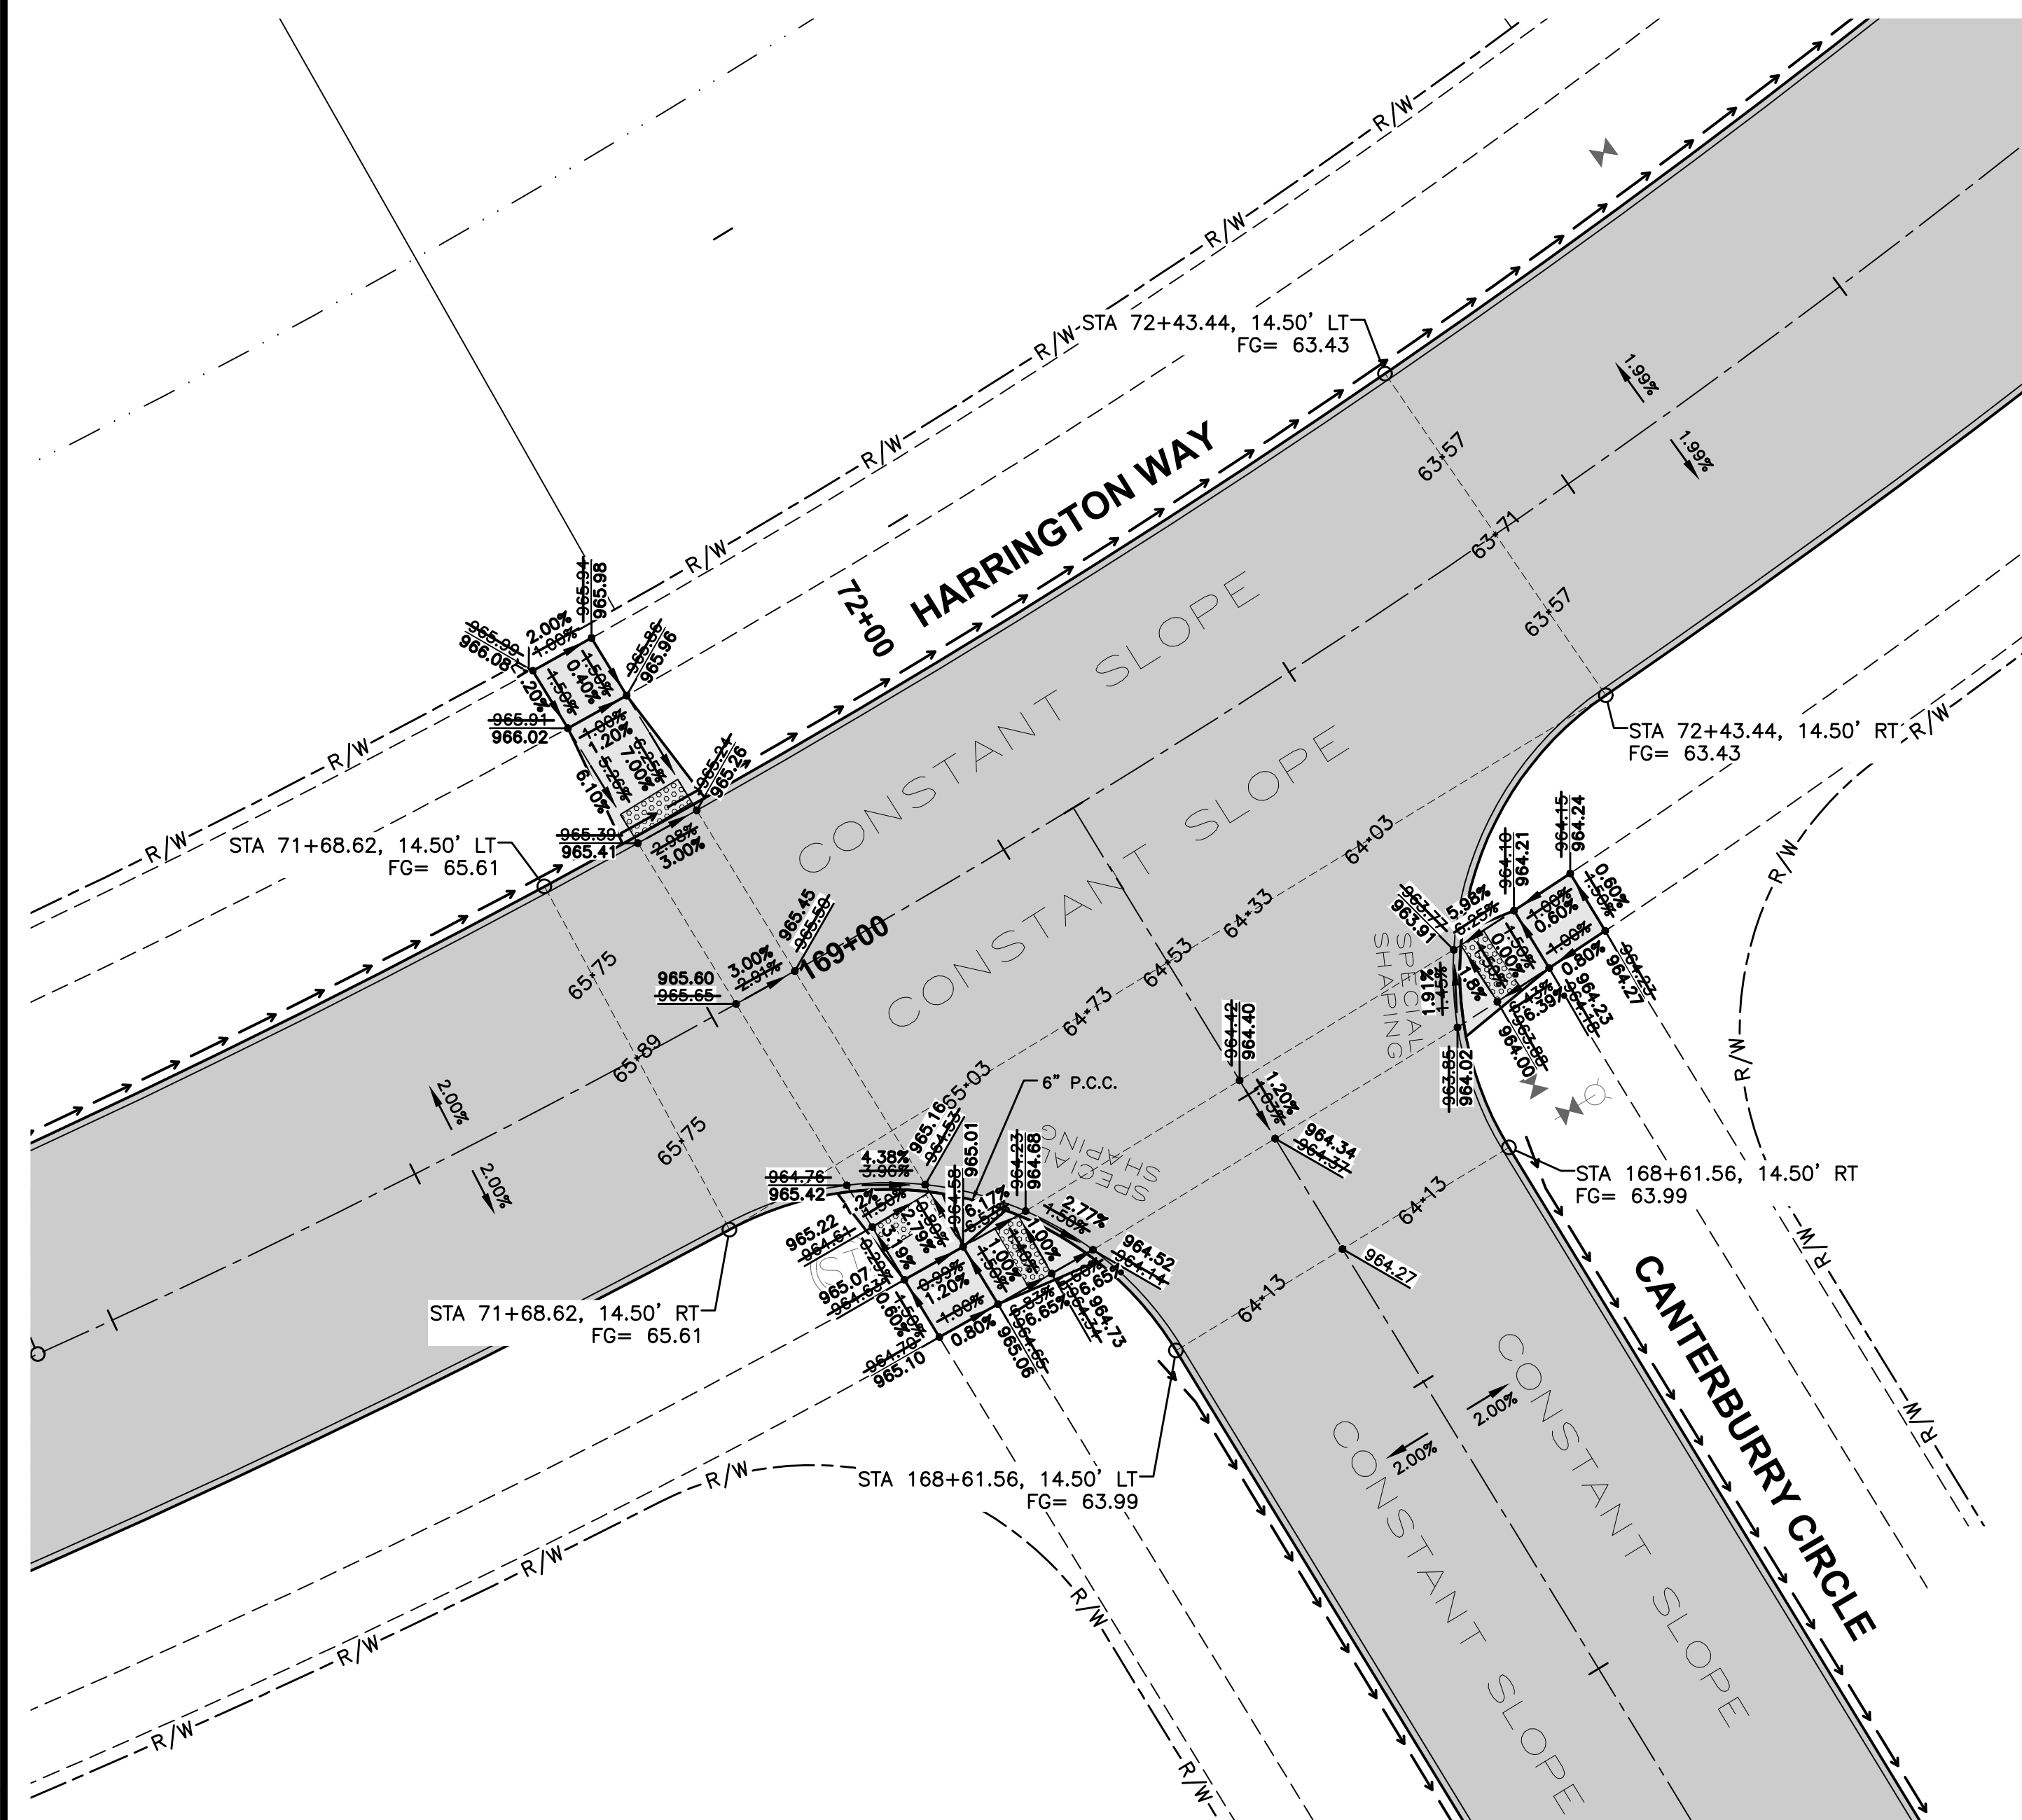


FILE: H: \2021\2106479\DWG\2106479-INTERSECTION-ASBUILT.DWG
FILE DATE: 11/1/22 DATE PLOTTED: 11/1/2022 3:20 PM
PLOTTED BY: MATTHEW THOMPSON
COMMENT: ENG:
TECH:


NOTES:

1. ELEVATIONS SHOWN ARE TOP OF SLAB AND/OR FORM GRADE.
2. INSTALL ACCESSIBLE CURB RAMPS AT LOCATIONS SHOWN.
3. REFER TO FIGURE 6010.514 FOR GRATE INTAKE BOXOUT FOR PCC PAVEMENT DETAILS.
4. ORIENT MANHOLE CONE SECTIONS TO KEEP CASTINGS OUT OF SIDEWALK RAMPS.
5. ADD 900 OR 1000 TO FOUR DIGIT SPOT ELEVATIONS TO OBTAIN PROJECT DATUM.


REVISIONS	DATE
AS-BUILT SUBMITTAL	11/01/2022
REVISED FINAL SUBMITTAL	10/05/2021
FINAL SUBMITTAL	9/02/2021
THIRD SUBMITTAL	8/18/2021
SECOND SUBMITTAL	7/26/2021
FIRST SUBMITTAL	7/13/2021

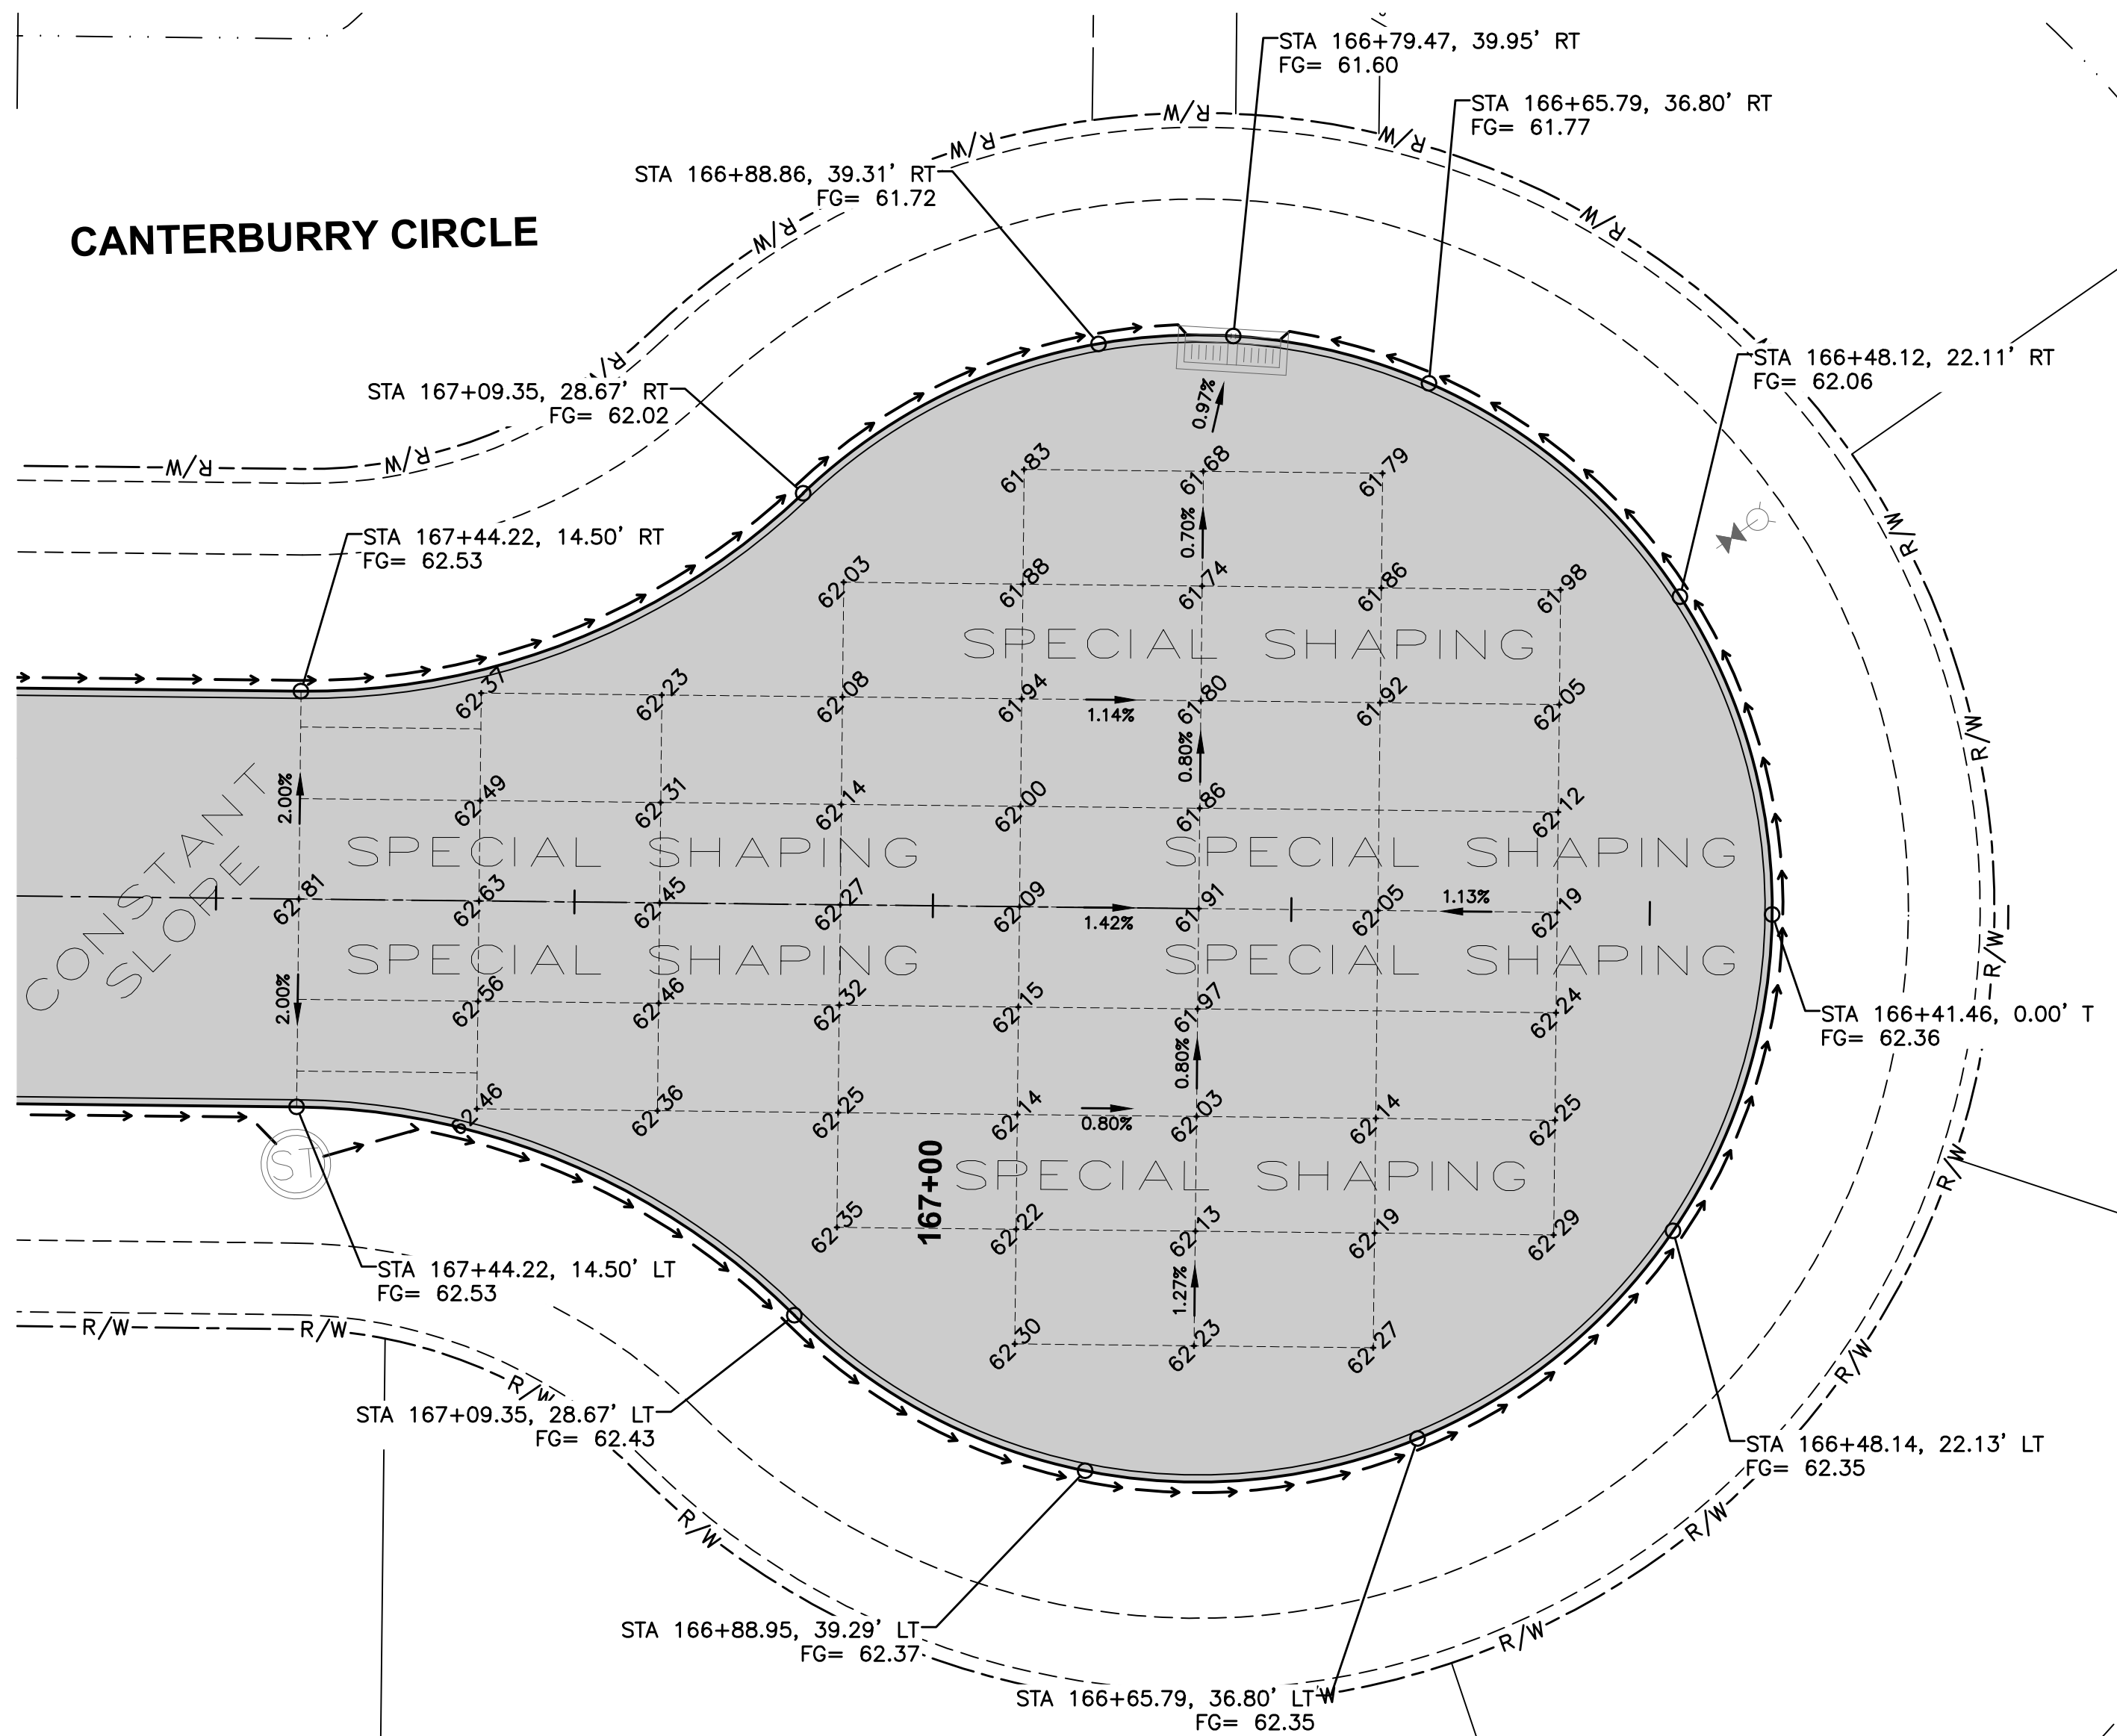

GEOMETRICS AND STAKING LAYOUT

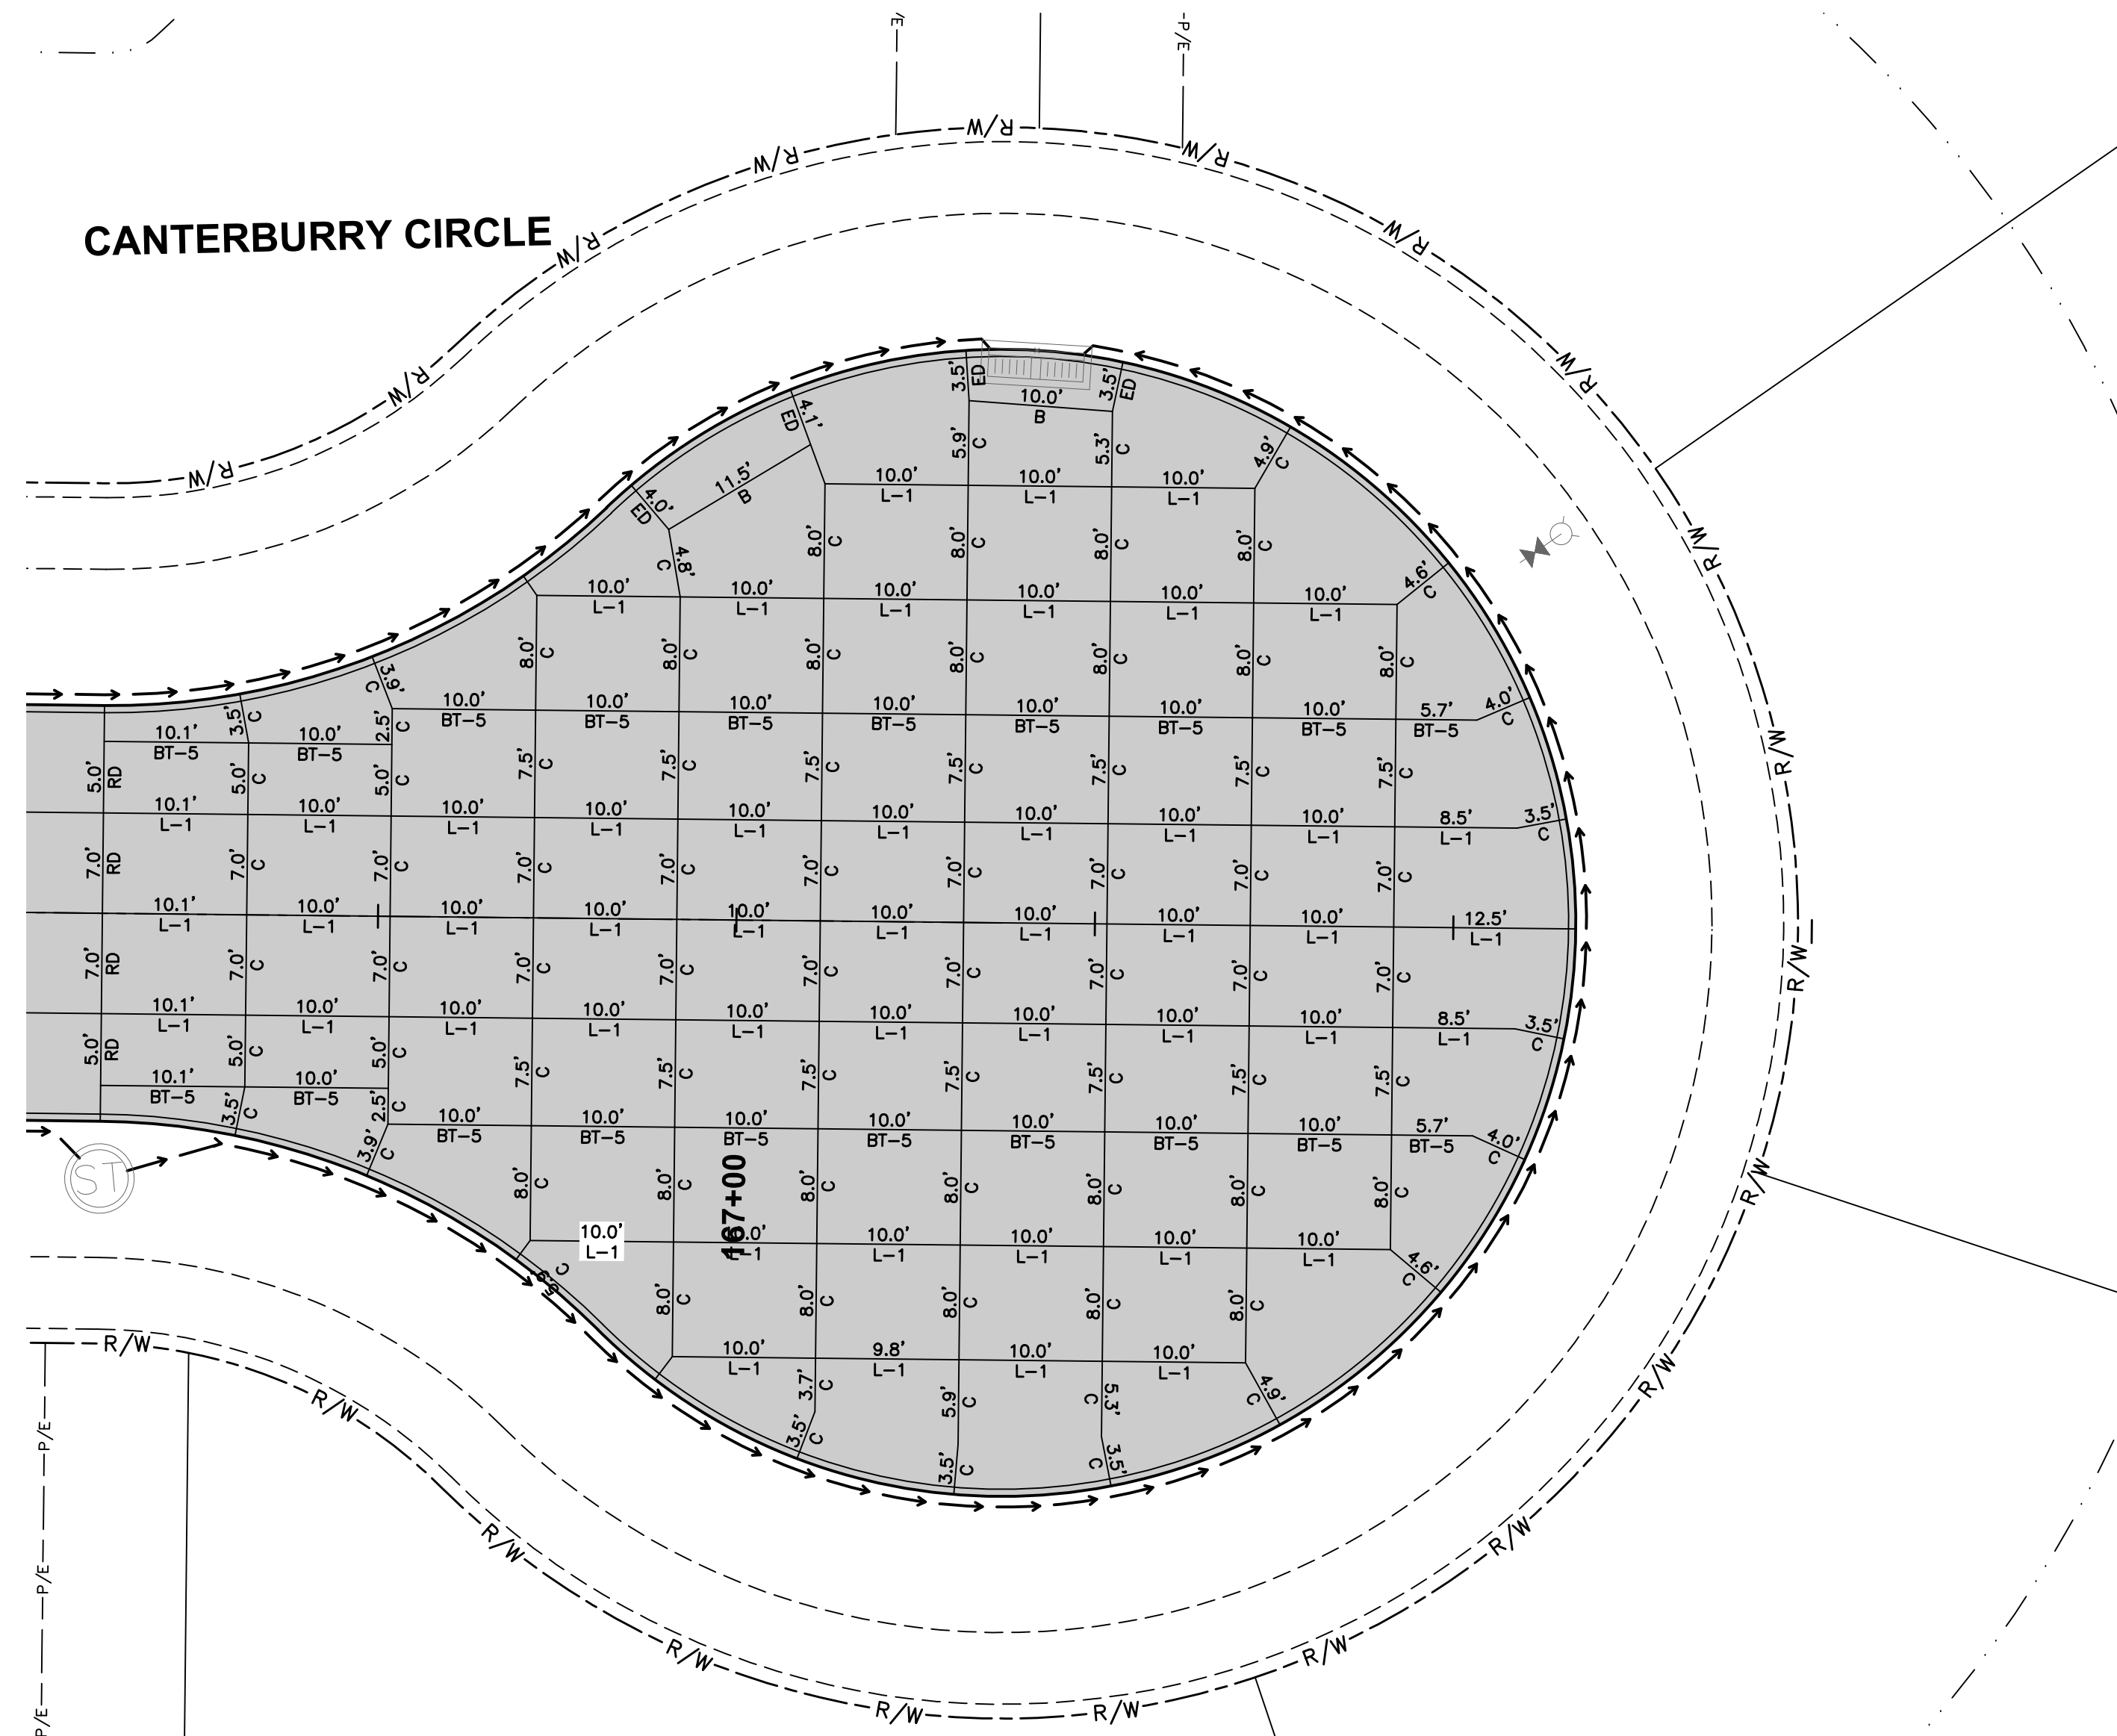

JOINTING LAYOUT

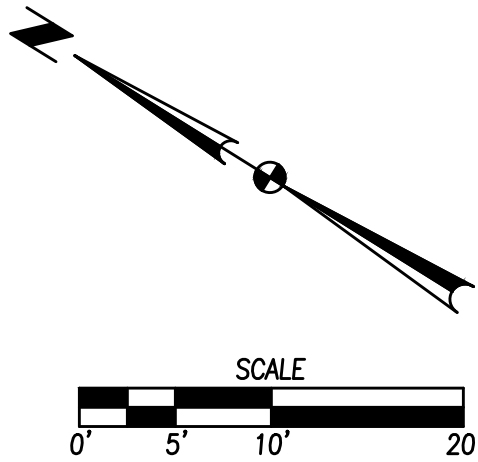

NOTES:

1. ELEVATIONS SHOWN ARE TOP OF SLAB AND/OR FORM GRADE.
2. INSTALL ACCESSIBLE CURB RAMPS AT LOCATIONS SHOWN.
3. REFER TO FIGURE 6010.514 FOR GRATE INTAKE BOXOUT FOR PCC PAVEMENT DETAILS.
4. ORIENT MANHOLE CONE SECTIONS TO KEEP CASTINGS OUT OF SIDEWALK RAMPS.
5. ADD 900 OR 1000 TO FOUR DIGIT SPOT ELEVATIONS TO OBTAIN PROJECT DATUM.