





Q:\A-FILES\A-1600\A1673_C3D Drawings\As-Built\ASBUILT.CDS\SANITARY - OFFSITE ASBUILT.dwg, 8/14/2015 5:08:40 PM, cmccann

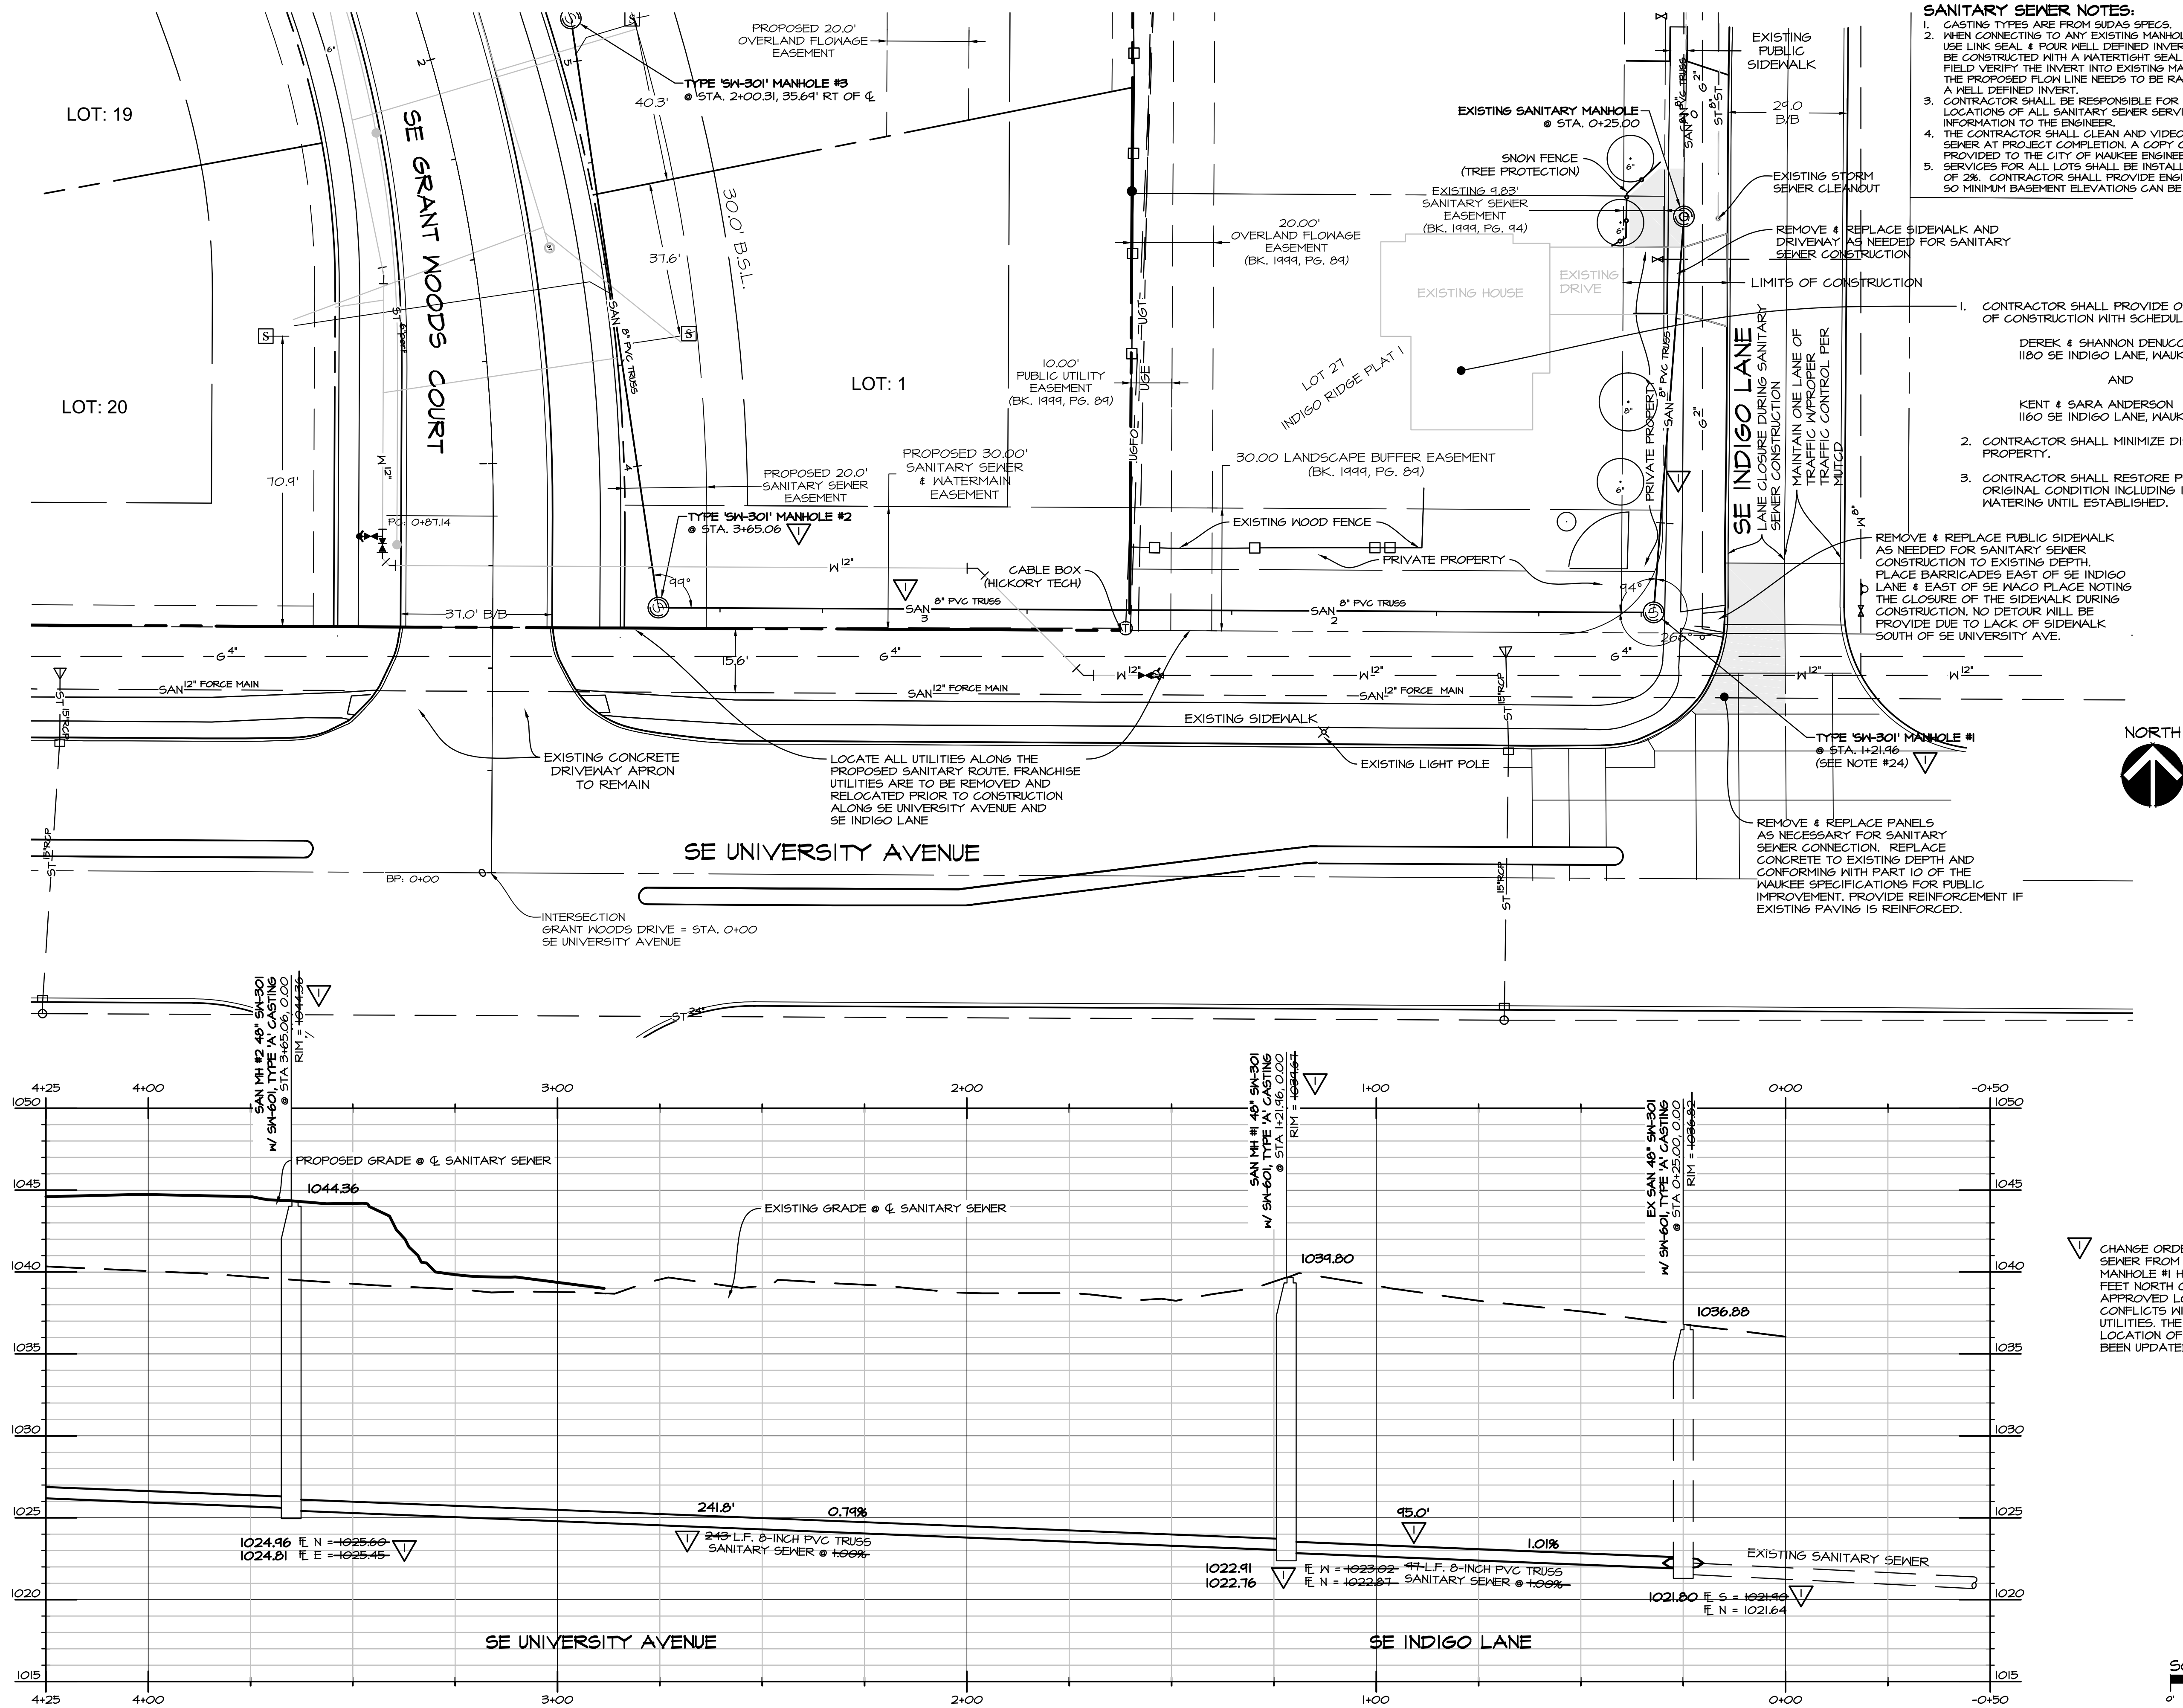

Q:\A-FILES\A-1600\A1673_C3D Drawings\As-Built\ASBUILT CD\SANITARY - STA (0+00 - 6+00) ASBUILT.dwg, 8/14/2015 6:09:28 PM, cnc:am

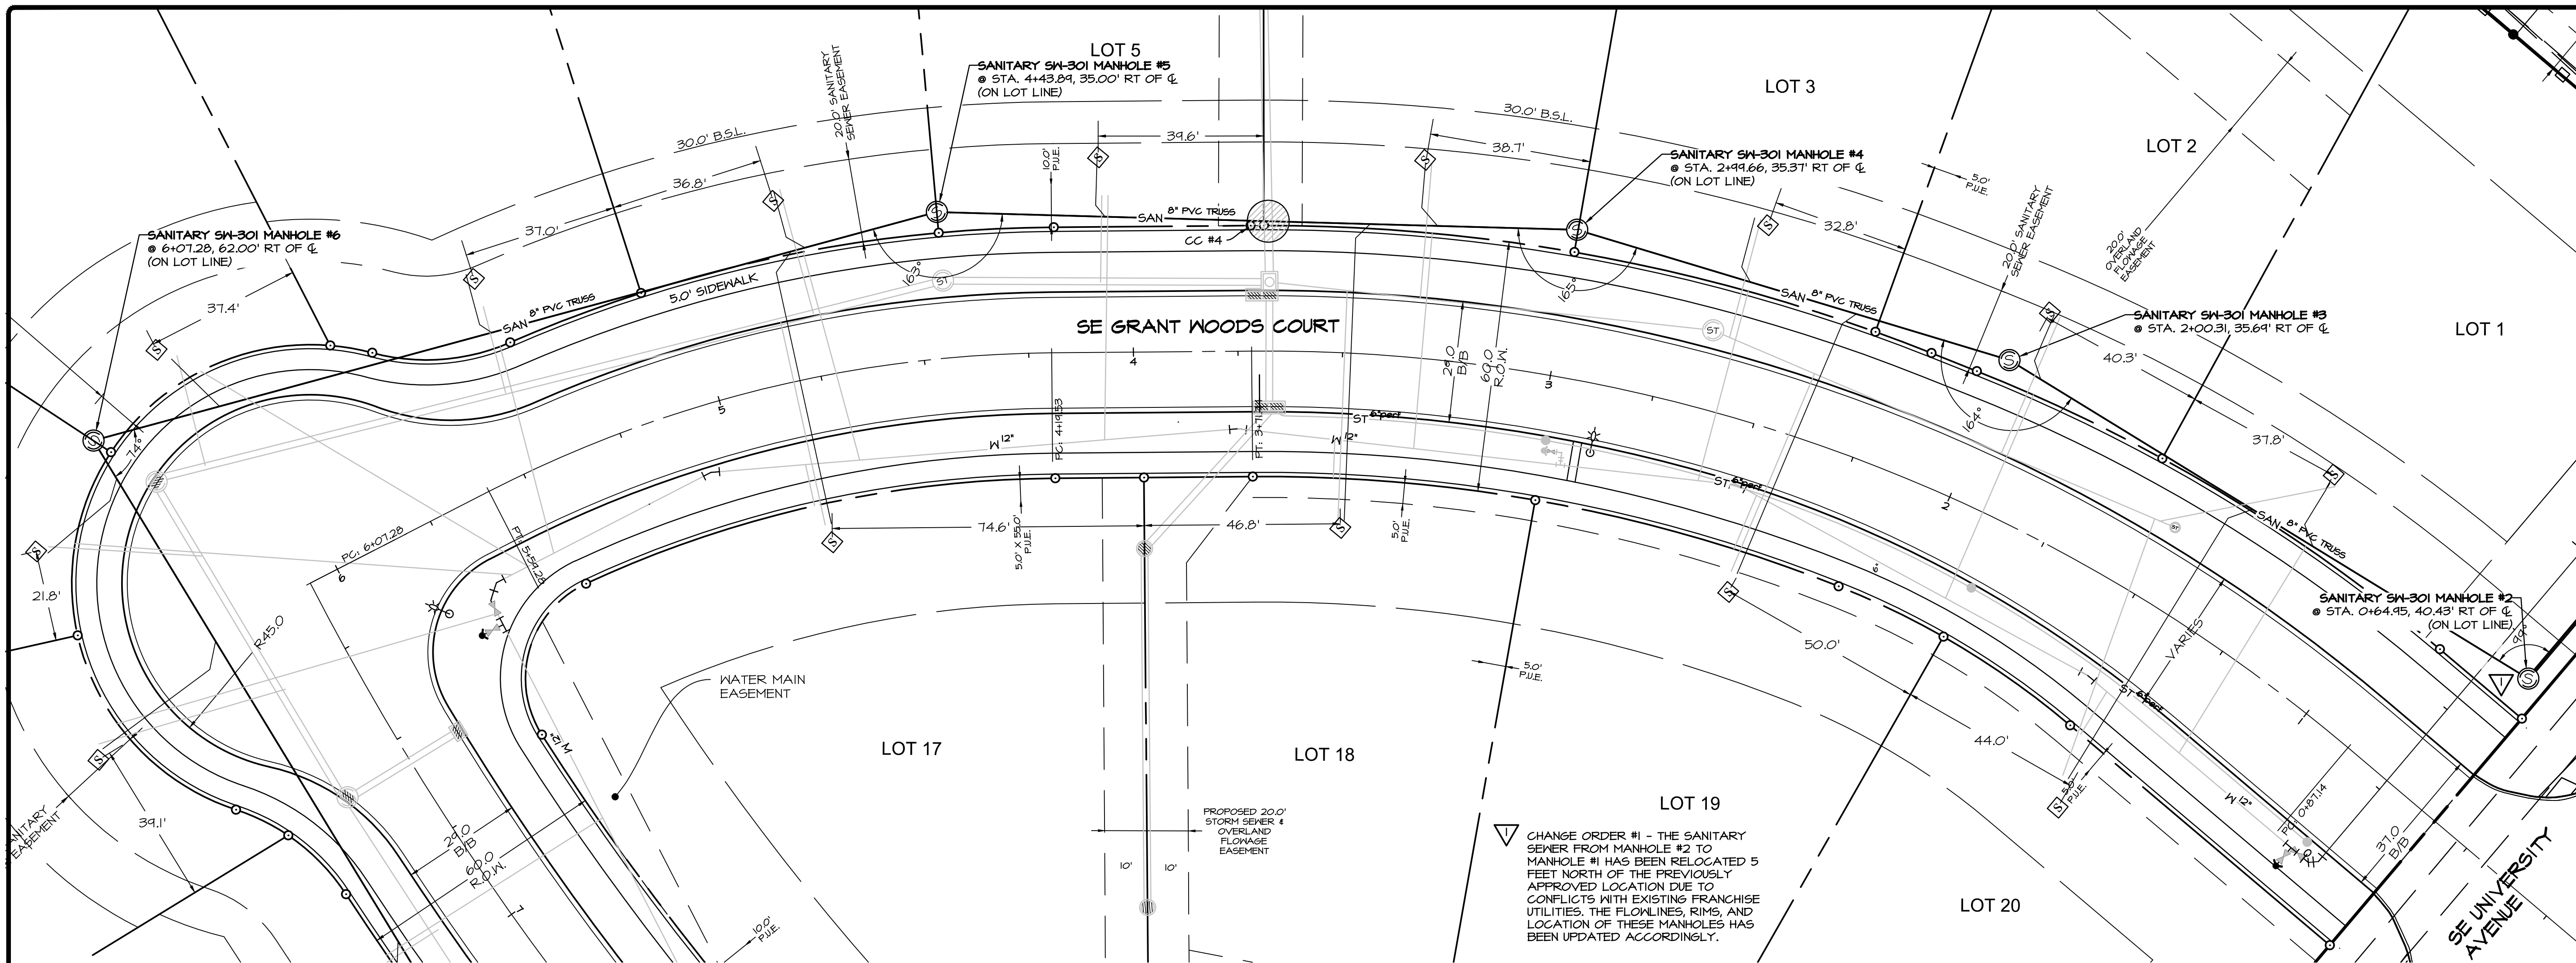

Q:\A-FILES\A-1600\A1673_C3D Drawings\As-Built\ASBUILT.C3D\SANITARY - STA (6+00 - 9+00) ASBUILT.dwg, 8/14/2015 6:10:14 PM, cnc:am

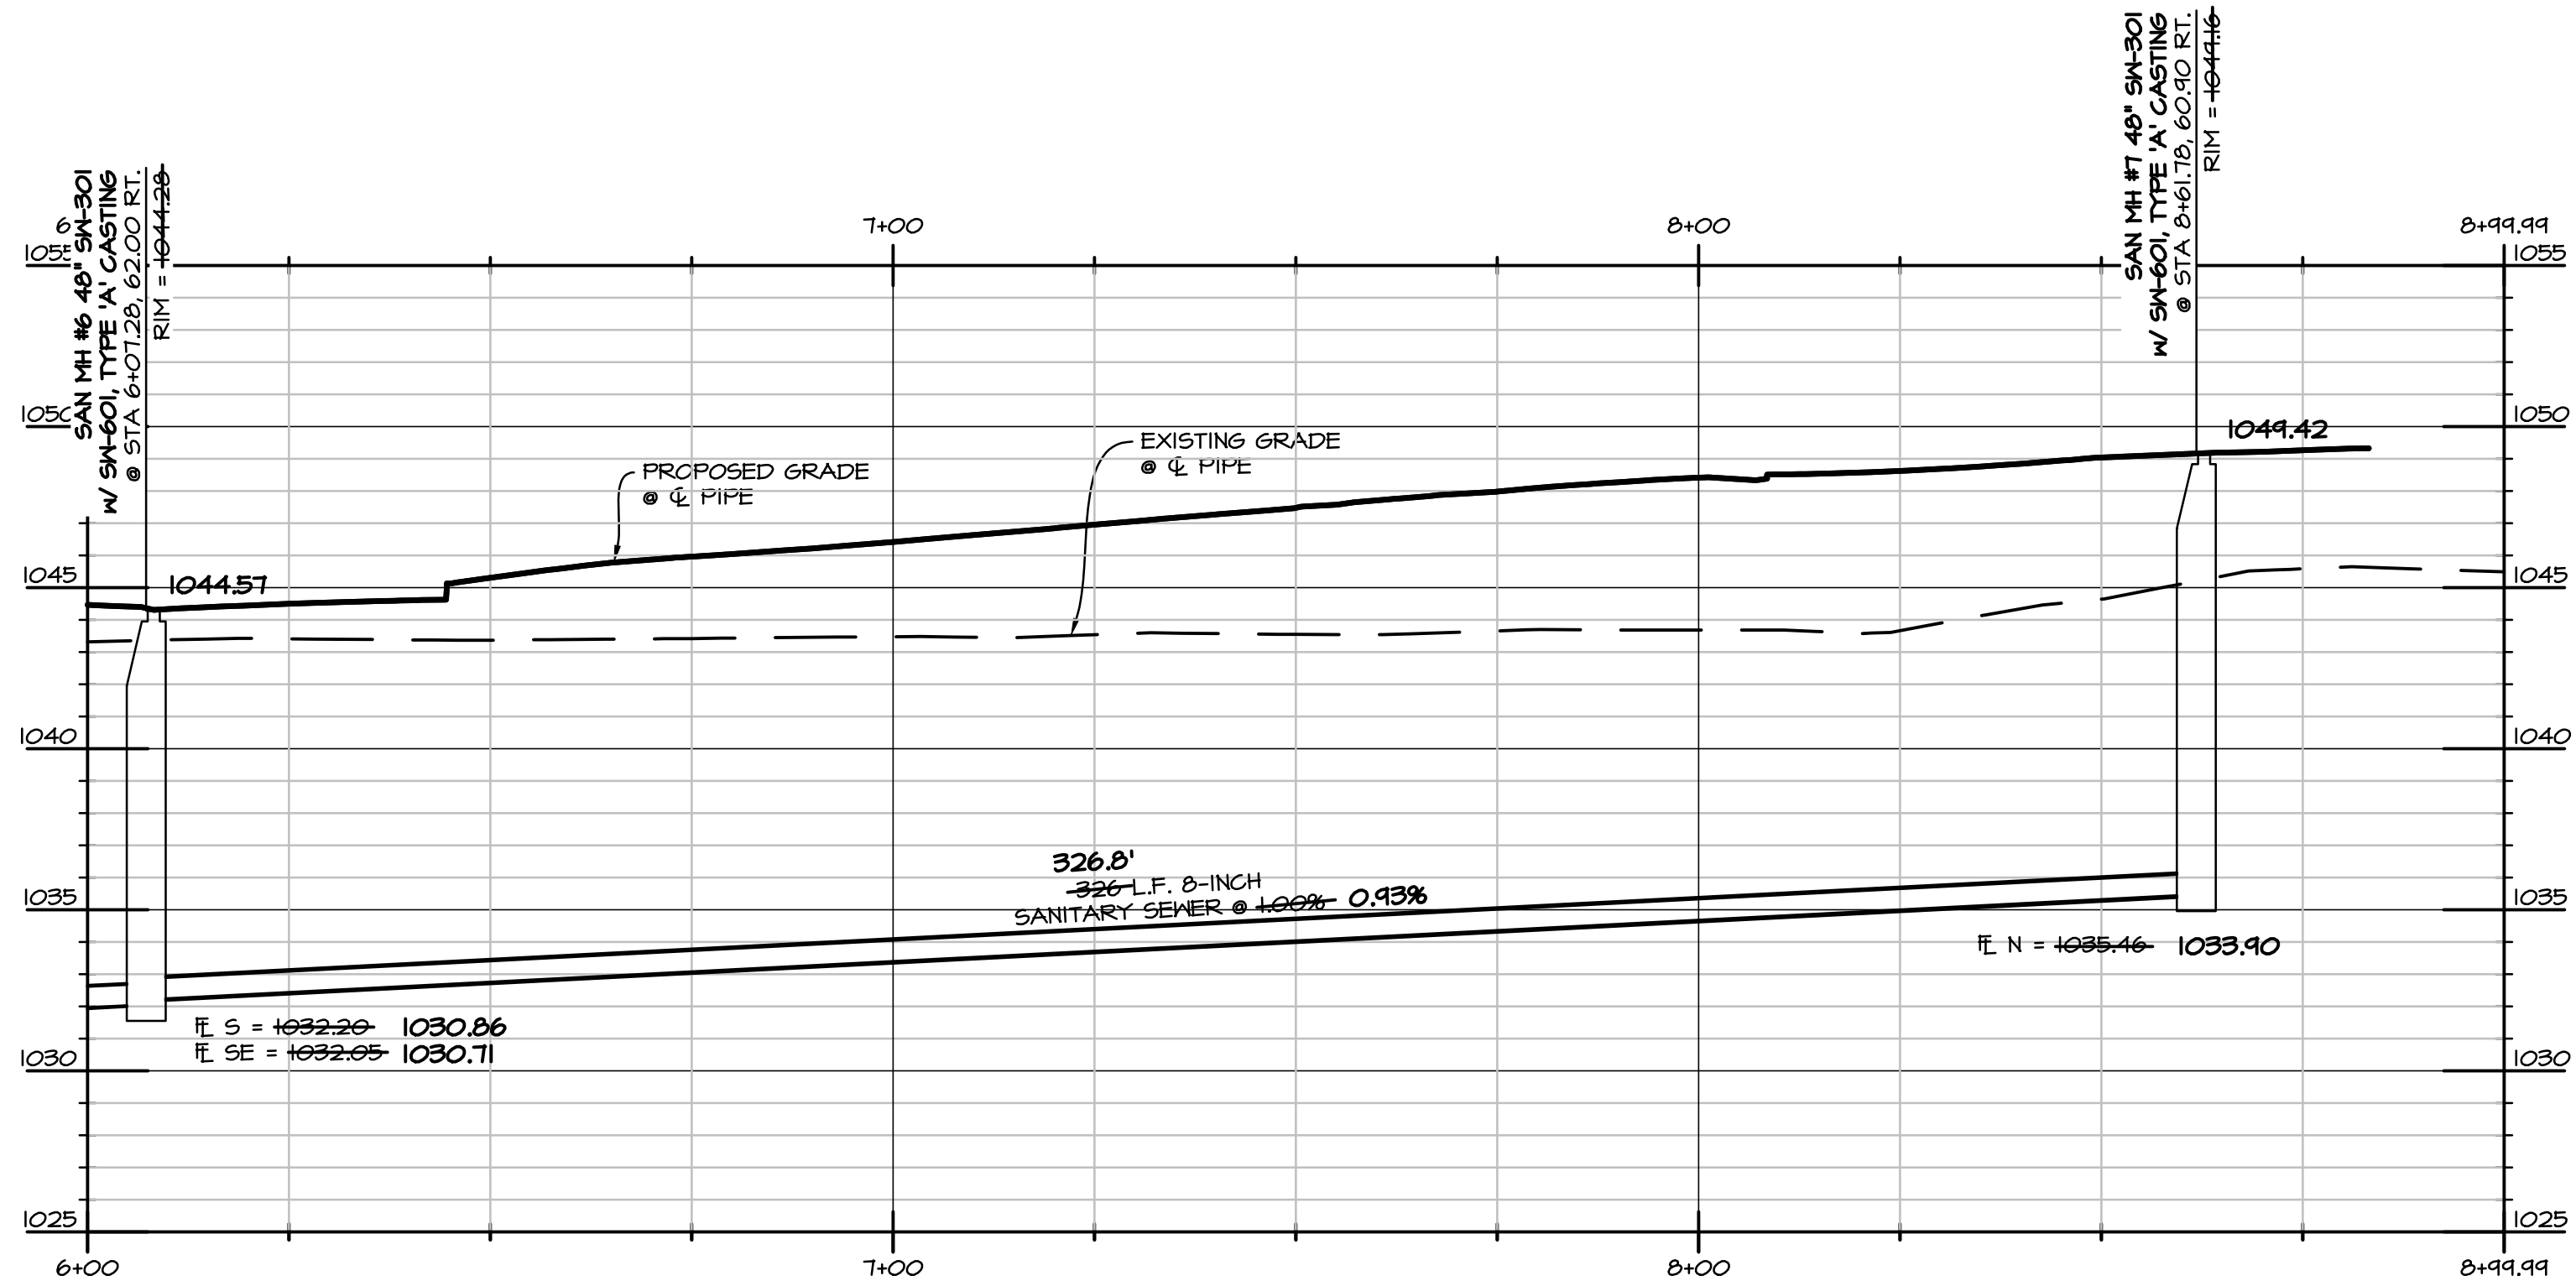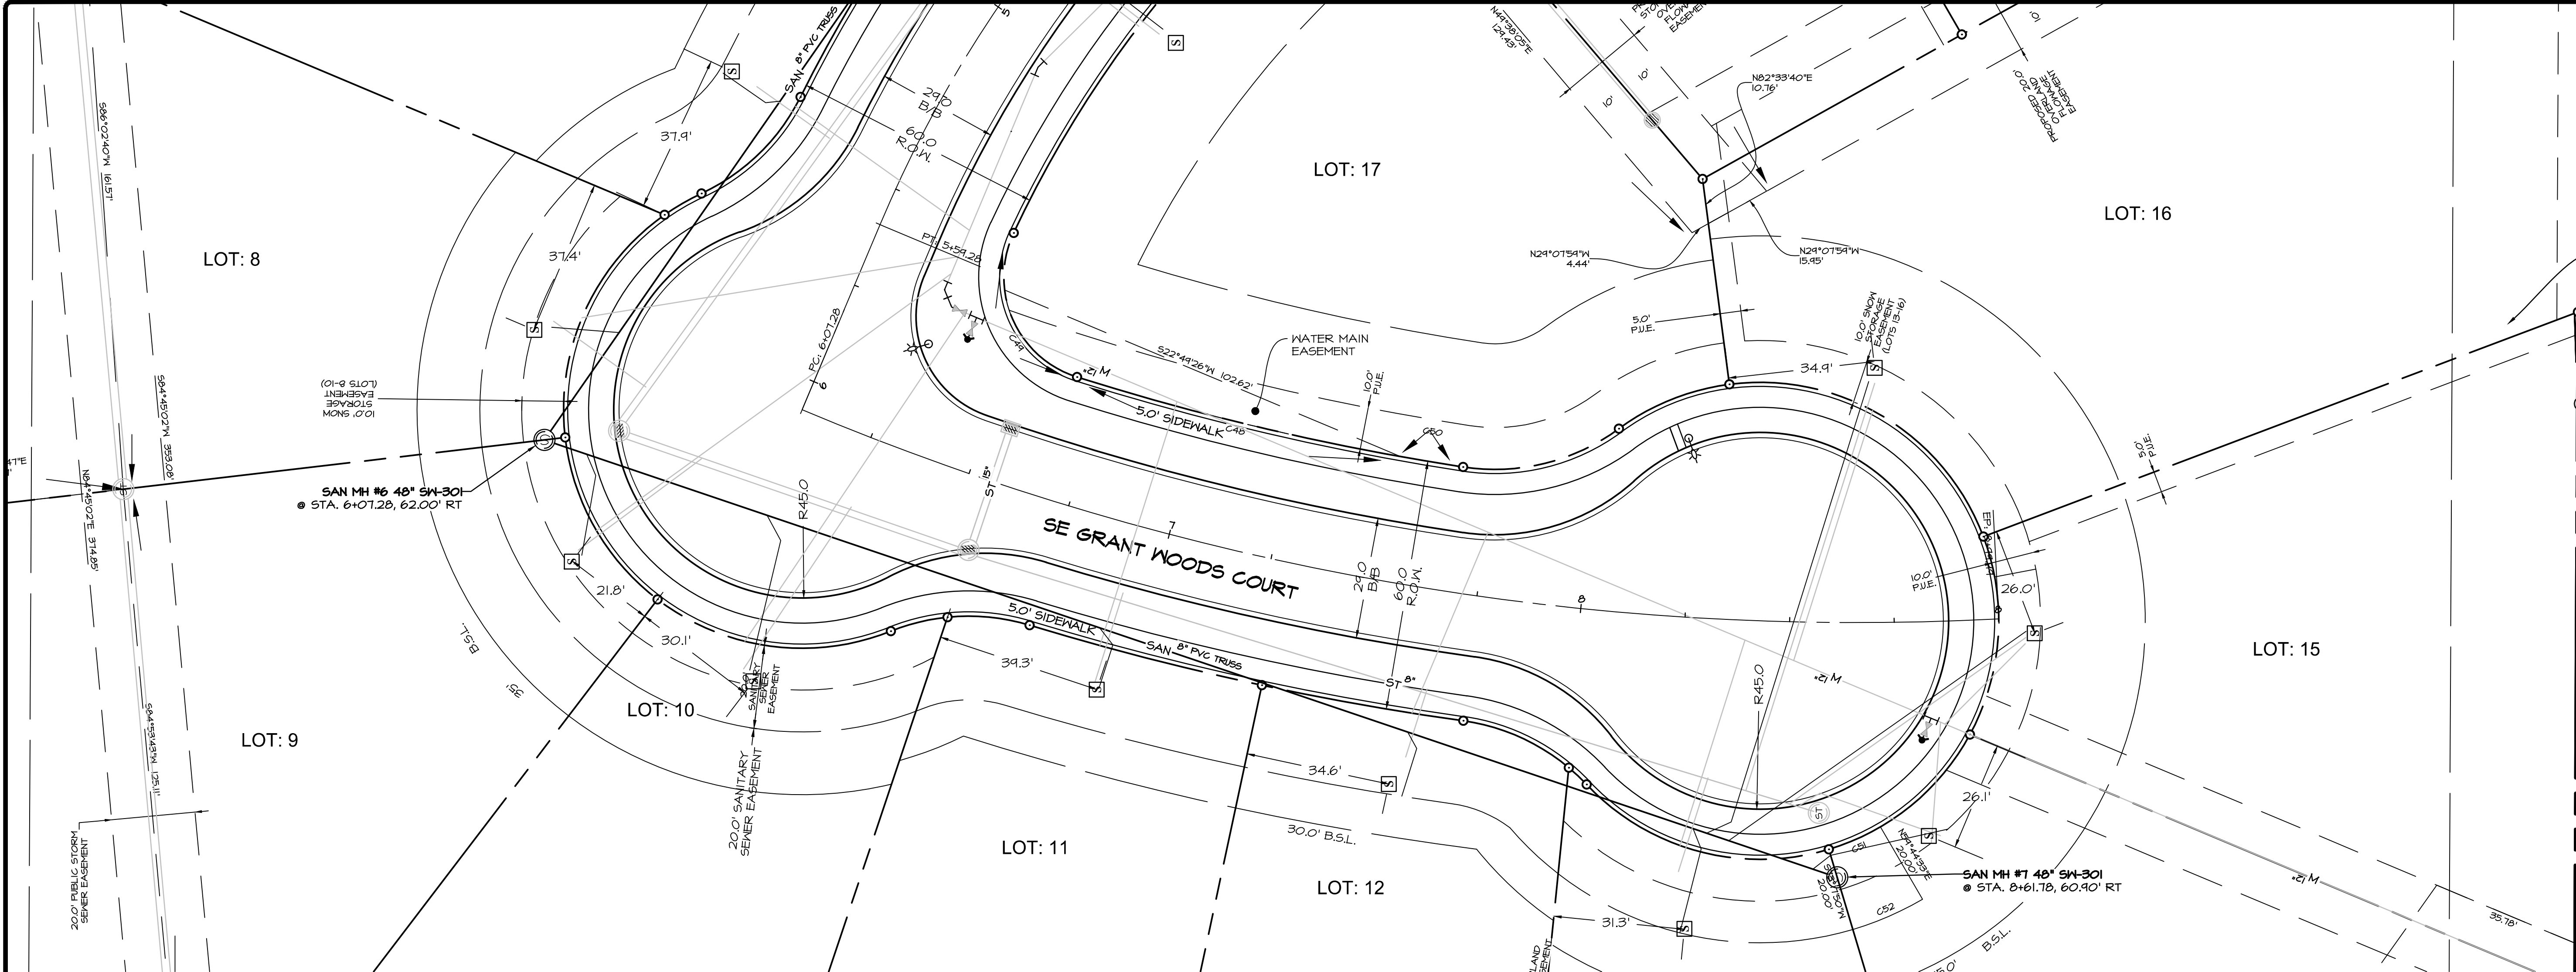

Q:\A-FILES\A-1600\A1673_C3D Drawings\As-Built\ASBUILT CD\WATER MAIN - OFFSITE ASBUILT.dwg, 8/14/2015 6:11:01 PM, cnc.ccm

