


AS-BUILTS CONSTRUCTION DRAWINGS SPYGLASS PLAT 2

WAUKEE, IOWA

Spyglass 2, LLC, 1360 NW 121st St, Suite A, Clive, Iowa 50325

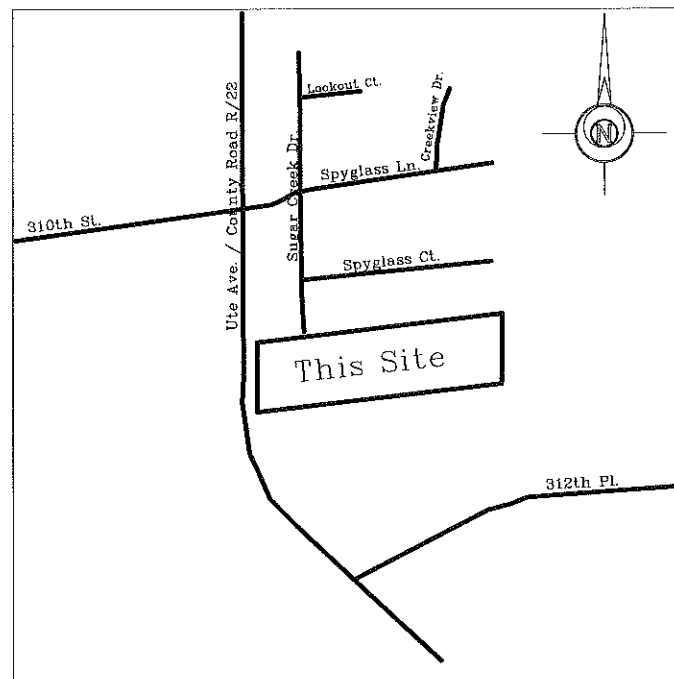

VICINITY SKETCH

Not To Scale

Utility Notes:

- 1) The proposed water service is provided by the City of Waukee (Contact Charles Waske, 515-987-4363, 805 University Ave, Waukee, IA 50263).
- 2) The proposed sanitary service is provided by the City of Waukee (Contact Charles Waske, 515-987-4363, 805 University Ave, Waukee, IA 50263).
- 3) The proposed electric service is provided by Mid-American Energy, Phone 1-888-427-6632.
- 4) The natural gas service is provided by the City of Waukee (Contact Dave Dezeuw, 515-987-4363, 805 University Ave, Waukee, IA 50263).



CALL 48 HOURS BEFORE YOU DIG
1-800-292-8989

DRAWING INDEX

- 1 Title Sheet
- 2 Grading and Erosion Control Plan
- 3 Sugar Creek Drive Sanitary Sewer & Water Main
- 4 Whistling Court (East) Sanitary Sewer & Water Main
- 5 Whistling Court Cul-de-sac (West) Sanitary Sewer & Water Main
- 6 Sanitary Sewer Outfall Plan and Profile
- 7 Sugar Creek Drive Paving & Storm Sewer
- 8 Whistling Court (East) Paving & Storm Sewer
- 9 Whistling Court Cul-de-sac (West) Paving & Storm Sewer
- 10 South Storm Sewer Plan and Profile
- 11 Storm Sewer Outfall Plan and Profile
- 12 Miscellaneous Details, Demolition Plan & Estimated Quantities
- 13 Miscellaneous Details
- 14 As-Built Grading Plan

All construction shall be in accordance with the Waukee Standard Specifications.


The City of Waukee Engineering Department shall be notified by the Contractor 48 hours prior to any weekend or holiday work being performed.

I HEREBY CERTIFY THAT THIS ENGINEERING DOCUMENT WAS PREPARED BY ME OR UNDER MY DIRECT PERSONAL SUPERVISION AND THAT I AM A DULY LICENSED PROFESSIONAL ENGINEER UNDER THE LAWS OF THE STATE OF IOWA.


Mark A. McMurphy 8/9/14
MARK A. MCMURPHY, IOWA LIC. NO. 14674 DATE

MY LICENSE RENEWAL DATE IS DECEMBER 31, 2014.

ADDITIONAL PAGES COVERED BY THIS SEAL (NONE UNLESS INDICATED HERE): Sheets 1 through 14

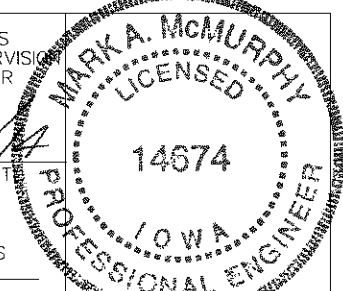

ABACI CONSULTING INC, 101 NE CIRCLE DR, GRIMES, IOWA, 50111
CIVIL ENGINEERING and LAND SURVEYING

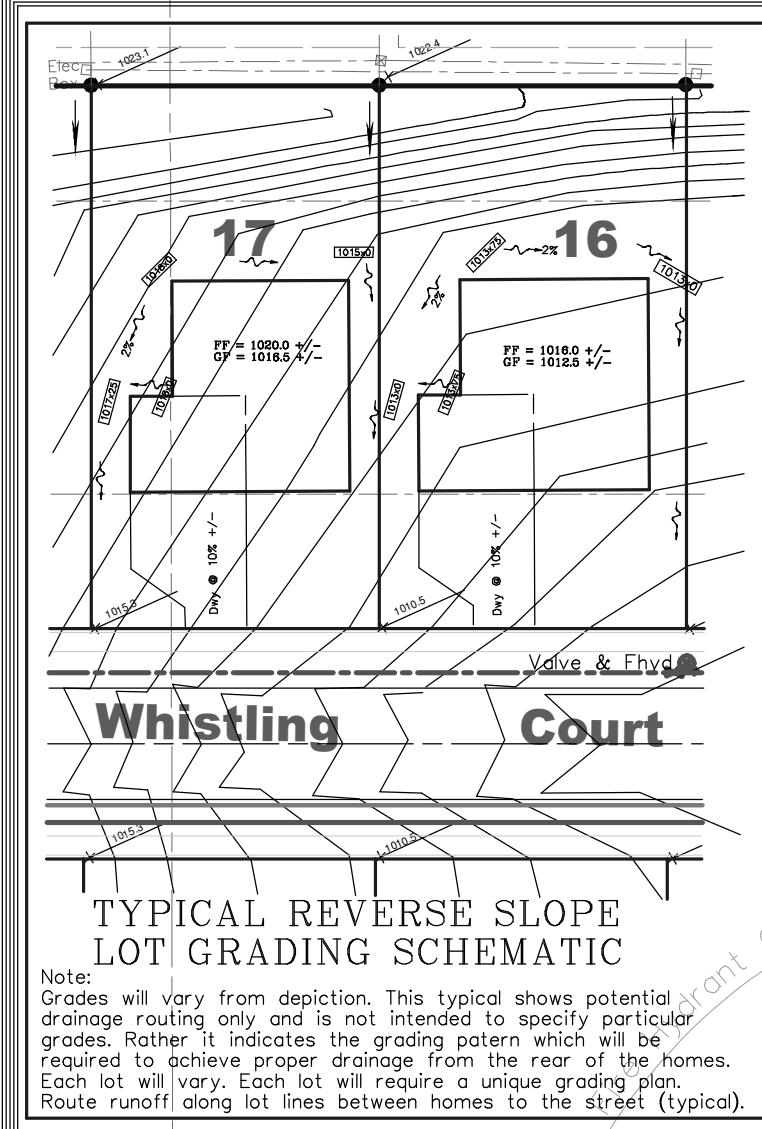

Symbol	Common Name	Botanical Name	Size	No.
(A)	Blue Spruce	Picea pungens var. Glauca	6 ft. B&S	6 ea.
(B)	Autumn Blaze Maple	Acer Freemanii Jeffersred	8 Ft. B&S	3 ea.
(C)	Common Serviceberry	Amelanchier arborea	6 ft. B&S	3 ea.
(D)	Spring Red Viburnum	viburnum trilobum	5-gallon	12 ea.
(E)	Scotch Pine	Pinus Sylvestrius	6 ft. B&S	6 ea.
(F)	Pin Oak	Quercus palustris	8 Ft. B&S	2 ea.
(G)	Prairiefire Crabapple	Malus sp. "Prairiefire"	6 ft. B&S	2 ea.
(H)	Burning bush	Euonymus alatus	5-gallon	12 ea.

Site Notes:

S1) This project is the development of a residential subdivision. This includes grading, shoring, trenching and pipe installation, paving and building construction. The site is 10.38 acres of which 9.38 will be disturbed. Additionally, 0.48 acres of off-site will be disturbed. Total area of disturbance is 9.86 acres.

S2) The contractor shall protect adjoining properties from any damage resulting from the movement of soil or debris from the project site.

S3) Preserve any existing vegetation until construction is necessary in that area.

S4) Seed all areas (temporary or permanent) upon completion of final grading as soon as possible. If construction activity is not planned to occur for at least 21 days in a disturbed area, stabilize with temporary erosion control within 14 days of ceasing work in the area.

S5) The contractor is required to maintain all erosion control measures (temporary and permanent) and keep them in working order. Clearing of siltation controls shall occur no later than when they have lost 50% of the capacity.

S7) The project and erosion control devices shall be inspected every 7 days. Record the findings of the inspection and take any actions necessary to ensure that the erosion control measures are working properly.

S8) Final stabilization means: the point at which all soil disturbing activities at the site have been completed, and a uniform perennial vegetative cover with a density of 70% of the cover for upland areas and areas not covered by permanent structures has been established or equivalent permanent stabilization measures (such as the use of riprap, gabions, or geotextiles) have been employed.

S9) Runoff during the initial development will drain the western portion of this site into the proposed detention basin. This will serve as the siltation/sedimentation basin.

S10) Provide additional silt fence, silt basins, earth dikes, ditch checks, and various other control measures as needed.

S11) This site is in Zone X "Areas determined to be outside of the 500-year flood plain" per FEMA FIRN Map Number 19049C0335E with a revision date of December 4, 2007.

PROPERTY OWNER:	Key:	LEGAL DESCRIPTION:	MAILING ADDRESS:
(1) GUARD, ARLENE		SPYGLASS LOT 69	520 SPYGLASS CT WAUKEE, IA 50263
(2) POTTOFF, STARLA & KEVIN		SPYGLASS LOT 68	530 SPYGLASS CT WAUKEE, IA 50263
(3) TEEJE, EHREN & SARA		SPYGLASS LOT 67	540 SPYGLASS CT WAUKEE, IA 50263
(4) SCHULTE, BENJAMIN & KARYN		SPYGLASS LOT 66	550 SPYGLASS CT WAUKEE, IA 50263
(5) GIRARD, EUGENE & STEPHANIE		SPYGLASS LOT 65	865 4TH ST WAUKEE, IA 50263
(6) COSE, JEFFREY & AMY		SPYGLASS LOT 64	580 SPYGLASS CT WAUKEE, IA 50263
(7) SCHAFER, PAUL & KRISTIN		SPYGLASS LOT 63	580 SPYGLASS CT WAUKEE, IA 50263
(8) ROWLAND, BRYAN & KELLY		SPYGLASS LOT 62	27503 307TH WAY ADEL, IA 50003
(9) SCHRAUTH, BRANDON & HOLLY		SPYGLASS LOT 61	620 SPYGLASS CT WAUKEE, IA 50263
(10) PREMIER HOME NETWORK INC		SPYGLASS LOT 60	9005 LTIS DR URBANDALE, IA 50322
(11) BERMAN, ELI & STEPHANIE		SPYGLASS LOT 59	640 SPYGLASS CT WAUKEE, IA 50263
(12) HUBBELL METROPOLITAN DEVELOPMENT FUND, LLC		GOV LOT 11 / EX PUMP STATION/ PARCEL A LOT 2 GOV LOT 12 LYING E OF ROAD	6900 WESTOWN PARKWAY WEST DES MOINES IA 50319
(13) A & L BEAN FAMILY LIMITED PARTNERSHIP		PARCEL A LOT 2 GOV LOT 12	29782 310TH ST WAUKEE, IA 50263
(14) A & L BEAN FAMILY LIMITED PARTNERSHIP		PARCEL A LOT 2 GOV LOT 12	29782 310TH ST WAUKEE, IA 50263
(15) O'MALLEY, SHANE & LISA		SPYGLASS LOT 1	2140 SUGAR CREEK DR WAUKEE, IA 50263



Lot	MOE/MPE/MGS	Elevation
1	MPE	1017.0
2	MPE	1016.0
3	MPE	1013.0
4	MPE	1010.5
5	MPE	1008.0
6	MPE	999.0
7	MPE	998.0
8	MPE	999.0
9	MPE	1003.0
10	MPE	1005.0
11	MPE	1002.0
12	MGS	1013.5
13	MGS	1012.0
14	MGS	1009.8
15	MGS	1009.8
16	MGS	1011.5
17	MGS	1014.0
18	MGS	1017.9
19	MGS	1022.1
20	MGS	1024.0
21	MGS	1026.0
22	MPE	1031.0
23	MPE	1030.0
24	MPE	1027.5
25	MPE	1023.5

STANDARD SYMBOLS LEGEND:			
● IRON ROD FOUND	W-WATER MAIN	S-SANITARY SEWER	
○ 1/2" DIA. x 30" IRON PIN SET	G-GAS MAIN	ST-STORM SEWER	
W-#14674 CAP	U-UNDERGROUND ELECTRIC	SF-SILT FENCE	
▲ SECTION CORNER MONUMENT FOUND	O-OVERHEAD ELECTRIC	XX-PROPOSED CONTOUR	
△ SECTION CORNER MONUMENT SET	U-UNDERGROUND TELEPHONE	[1027x0] PROPOSED SPOT ELEV (●)	
*-FENCE LINE	+/- MORE OR LESS	OFF Overland Flowage Easement	
CLF CHAIN LINK FENCE	~ FLOW DIRECTION	CO Clean-out	
		FGH Finish Grade @ Hydrant	

- Construction Notes:**
- The contractor is responsible for the protection of all utilities. Call Iowa One Call before digging 1-800-292-8989.
 - Strip topsoil in excavated and fill areas. Remove all vegetation and organic materials prior to placing and compacting the fill.
 - All cut and fill areas shall be maintained for proper drainage at all times.
 - All fill shall be placed in lifts no greater than 8 inches and compacted to a minimum of 95% of Standard Proctor or unless otherwise specified in the construction plans. Obtain required compaction within a soil moisture content range of optimum moisture to 4 percentage points above optimum moisture.
 - The contractor is responsible for any and all materials testing required to assure compliance with the project specifications. This testing shall be incidental to construction.
 - In the event of a discrepancy between these specs. and the detailed construction drawings, the detailed construction drawings shall govern.
 - Any cohesionless soils encountered shall be compacted to 98% of Standard Proctor beneath pavements and critical backfill areas.
 - Proof-roll the pavement subgrade prior to placing pavement. Remove and replace any unsuitable soils to a depth of 2 feet.
 - Maintain moisture content of pavement subgrade soils consisting of clays/silts between 9 and 4 percentage points above optimum until the pavement is placed.
 - Curb backfill shall be compacted and sloped to provide adequate drainage and preventing water from ponding and infiltrating beneath the pavement.
 - Disturb as little area as possible during grading procedures.
 - Stockpile all stripped topsoil and all excess cut in the area shown on this plan (or in a suitable location). Strip any available topsoil to a minimum depth of 6" (respread (4" min.) available topsoil over all disturbed areas after final grades are reached (except under pavement/building pads).
 - See the Storm Water Pollution Prevention Plan (SWPPP) for the initial erosion control measures.
 - Post development runoff will not adversely affect downstream properties or facilities.
 - It shall be the developer's responsibility to apply for and obtain any storm water discharge permits from the Iowa Department of Natural Resources.
 - Riprap shall be provided by the developer at the storm sewer outlets and at the detention basin outlet.
 - The contractor and subcontractors must maintain proper erosion control throughout the entire project.
 - Site soil material must be retained on site by preventing erosion. This includes soil excavations for foundations on each respective lot.
 - Contractor must promptly remove all mud, soil and debris tracked onto city streets. Cleaning shall be performed before the end of a work day or prior to a rain event.
 - Overland flowage shall be routed along the lot lines to the street and/or overland flowage easement.
 - Maintain 6.0" minimum cover at all water lines. At sewer crossing maintain 18" minimum clearance.
 - The existing home will be moved off-site. The existing barn will be razed. The existing driveway walks and other improvements appurtenant to the existing home will be removed. The existing well will be capped and plugged per DNR regulations. Refer to Demolition Plan - sheet 12.
 - Maintain a minimum horizontal clearance of 24 inches from the edge of sidewalks.
 - The applicant is responsible to provide the City of Waukee with a certified grading plan prior to acceptance of the public improvements.
 - All fire hydrants shall have a 2" x 2" fitting.
 - The holder of NPDES General Permit No. 2 shall provide the City of Waukee with a written certification of compliance with the GP No. 2 requirement to provide a minimum topsoil respread of 4 inches across the entire plot prior to acceptance of the public improvements.
 - All construction staking shall be performed under the supervision of an Iowa licensed Professional Surveyor.
 - The results of the Geotechnical Report shall be provided to the city and this plan set shall be subject to any changes required by the report.
 - The proposed staging and waste management area shall include any required items such as: waste dumpsters, portable toilets, chemicals, construction materials and other related items.


- General Notes:**
- The contractor shall comply with all erosion control requirements of the Iowa code, the Iowa Department of Natural Resources NPDES permit, the Environmental Protection Agency, and local ordinances.
 - It is the contractor's responsibility to take all the necessary measures to eliminate erosion from the project site and borrow or fill areas including the controls shown on this plan.
 - The contractor shall be responsible for any and all claims of any type whatsoever resulting from damages to adjoining properties.
 - All sediment or debris must be removed from adjoining properties promptly or the Owner will remove the items and deduct the cost from the amount due to the contractor.
 - The SWPPP and all documents associated with it and the permit shall be kept onsite at all times and be available to present to the Iowa Department of Natural Resources upon request.
 - Upon final completion and stabilization of the site, a notice of discontinuation must be filed by the Owner. The Owner must retain all documents associated with the permit and SWPPP for three years.
 - The contractor shall provide all documents including the originals and inspection records to the Owner upon issuance of the notice of discontinuation.

ABACI CONSULTING, INC.
CIVIL ENGINEERING - LAND SURVEYING
101 NE CIRCLE DR., GRIMES, IOWA 50111, PH. (515)986-5048

DATE PREPARED: 5-16-13
REVISIONS:
1-16-13: Initial
2-16-13: Second Submittal
3-16-13: Per City Comments
4-16-13: Client Review
5-16-13: Per City Review



SEAL: [Signature]
ENGINEER
STATE OF IOWA
NO. 13-00865

SCALE: (As Shown on Site)
DRAWING NO. 13-00865
SHEET NO. 2 OF 14

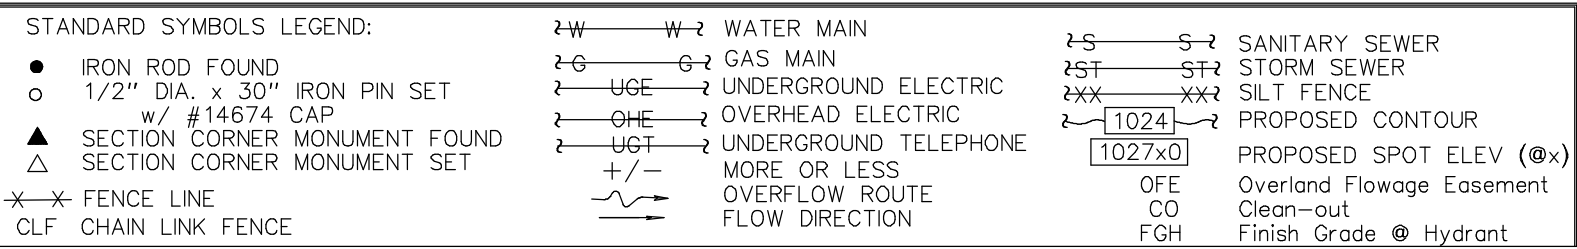


R-22/UTE AVENUE

Lot C (Street)

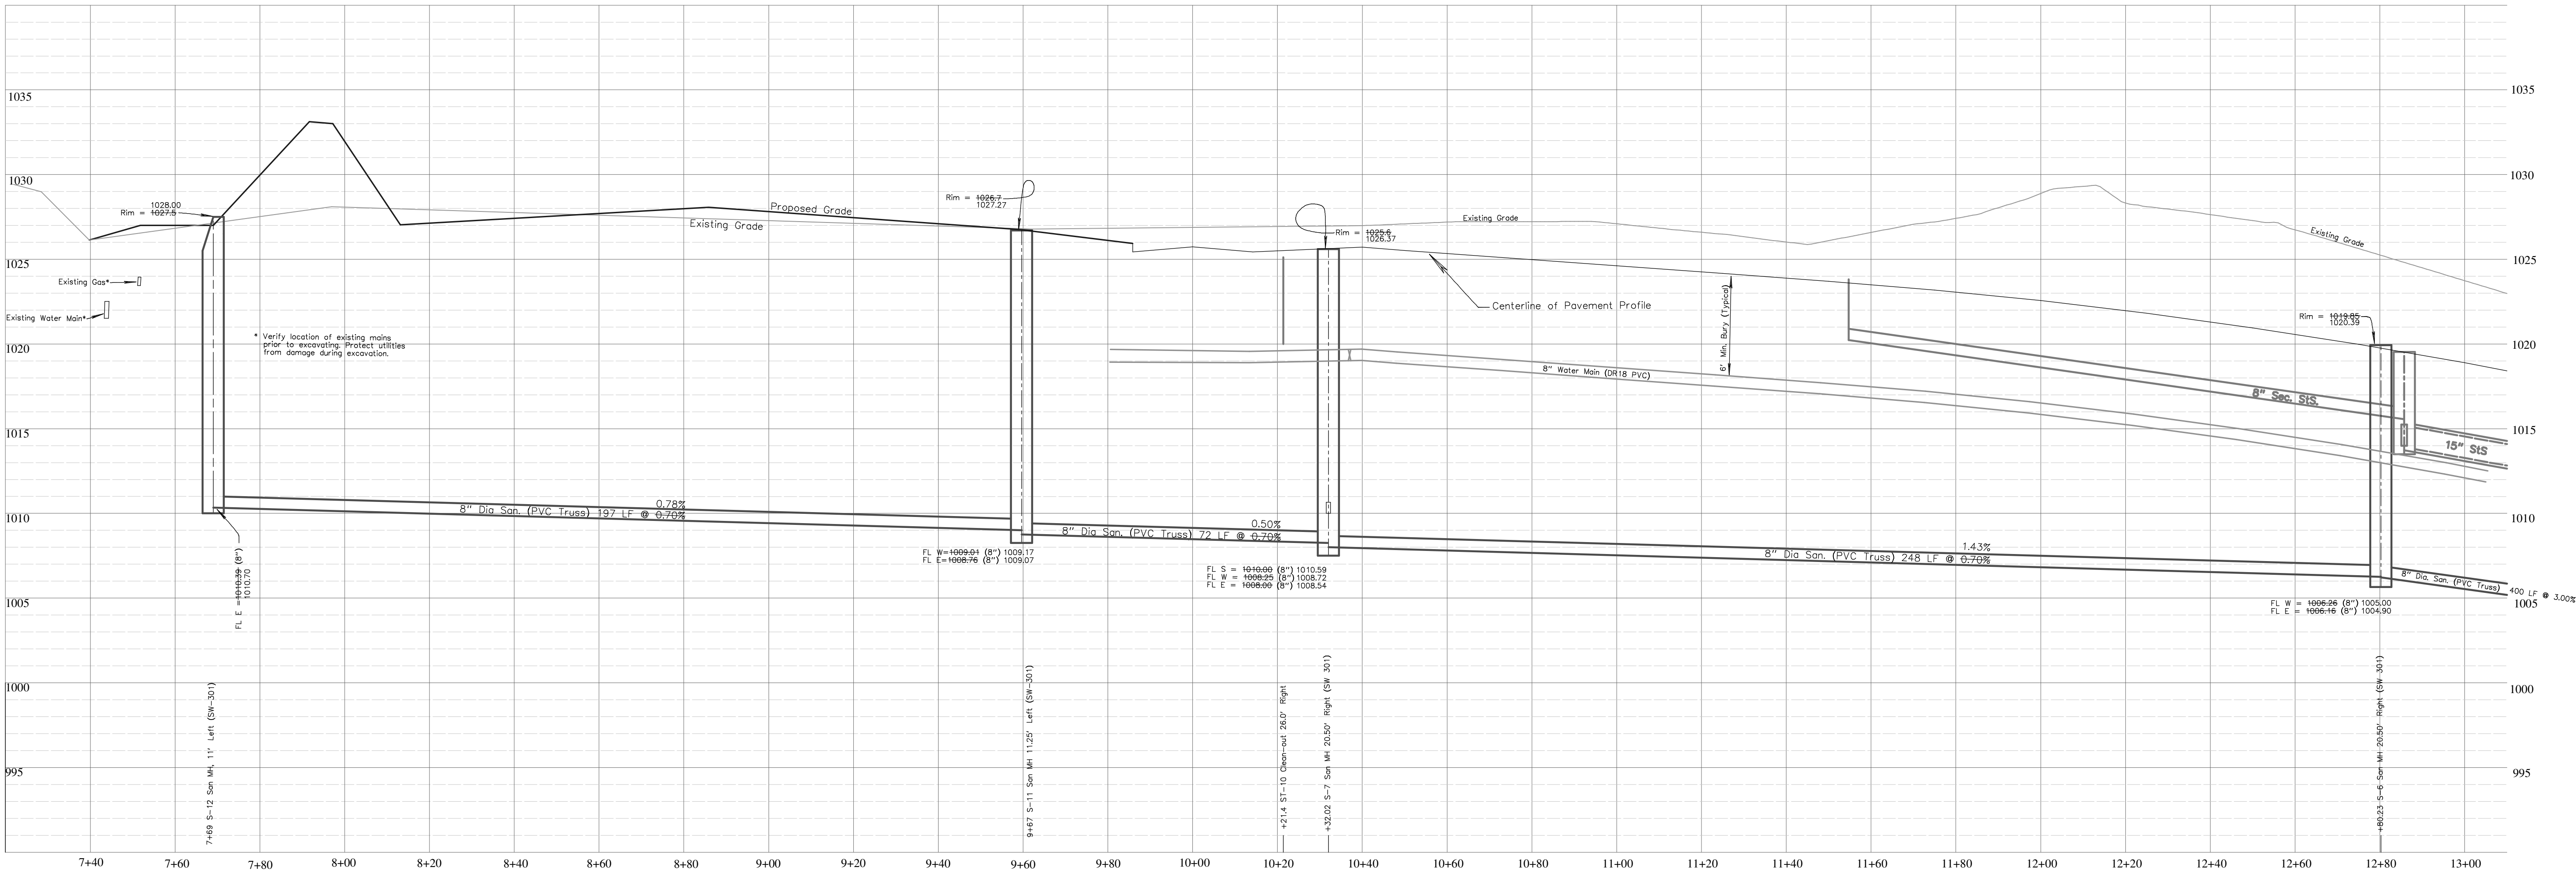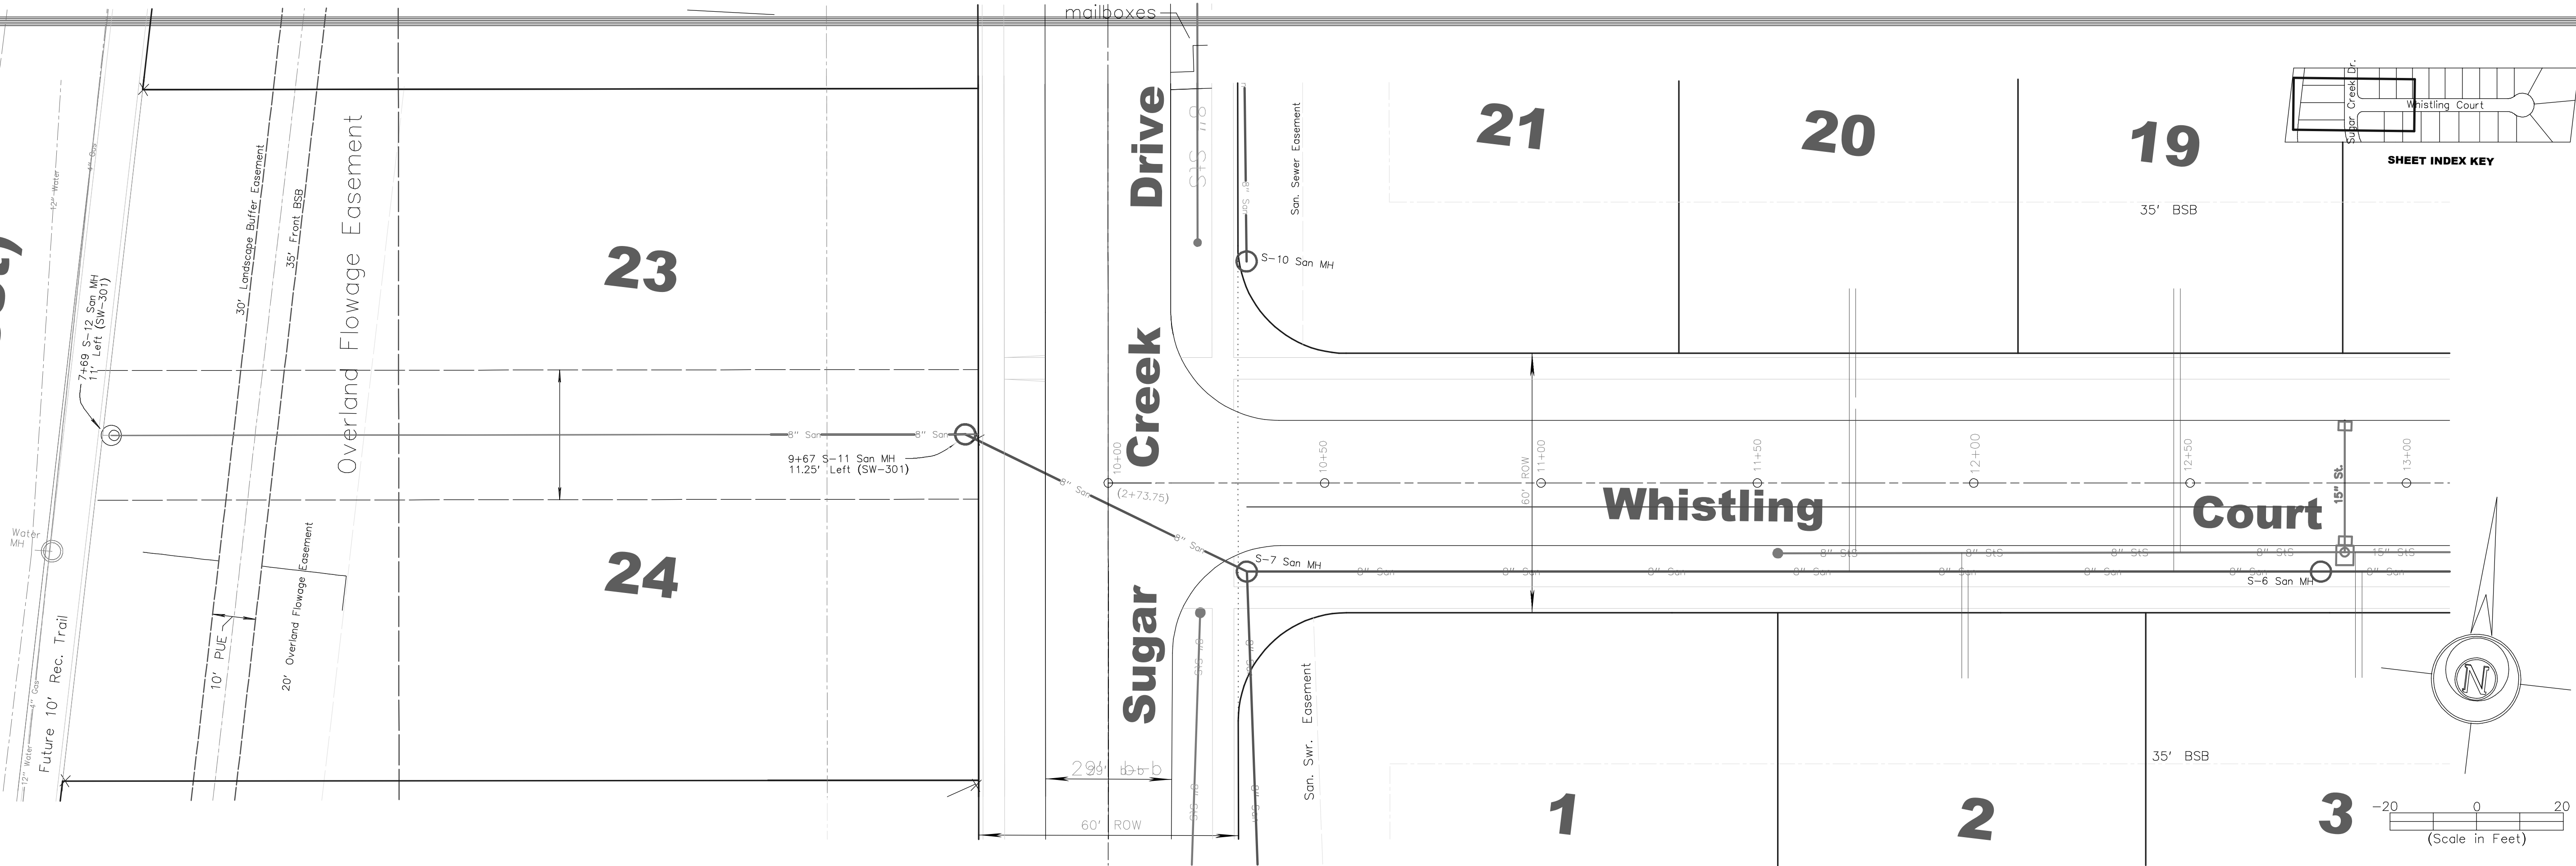

ABACI CONSULTING, INC.
CIVIL ENGINEERING - LAND SURVEYING
101 NE CIRCLE DR., GRIMES, IOWA 50111, PH. (515)986-5048

DATE PREPARED: 05-16-13
REVISIONS: 1-13-13, 2-13-13, 3-13-13, 4-13-13, 5-13-13, 6-13-13, 7-13-13, 8-13-13, 9-13-13, 10-13-13, 11-13-13, 12-13-13, 1-14-14, 2-14-14, 3-14-14, 4-14-14, 5-14-14, 6-14-14, 7-14-14, 8-14-14, 9-14-14, 10-14-14, 11-14-14, 12-14-14, 1-15-15, 2-15-15, 3-15-15, 4-15-15, 5-15-15, 6-15-15, 7-15-15, 8-15-15, 9-15-15, 10-15-15, 11-15-15, 12-15-15, 1-16-16, 2-16-16, 3-16-16, 4-16-16, 5-16-16, 6-16-16, 7-16-16, 8-16-16, 9-16-16, 10-16-16, 11-16-16, 12-16-16, 1-17-17, 2-17-17, 3-17-17, 4-17-17, 5-17-17, 6-17-17, 7-17-17, 8-17-17, 9-17-17, 10-17-17, 11-17-17, 12-17-17, 1-18-18, 2-18-18, 3-18-18, 4-18-18, 5-18-18, 6-18-18, 7-18-18, 8-18-18, 9-18-18, 10-18-18, 11-18-18, 12-18-18, 1-19-19, 2-19-19, 3-19-19, 4-19-19, 5-19-19, 6-19-19, 7-19-19, 8-19-19, 9-19-19, 10-19-19, 11-19-19, 12-19-19, 1-20-20, 2-20-20, 3-20-20, 4-20-20, 5-20-20, 6-20-20, 7-20-20, 8-20-20, 9-20-20, 10-20-20, 11-20-20, 12-20-20, 1-21-21, 2-21-21, 3-21-21, 4-21-21, 5-21-21, 6-21-21, 7-21-21, 8-21-21, 9-21-21, 10-21-21, 11-21-21, 12-21-21, 1-22-22, 2-22-22, 3-22-22, 4-22-22, 5-22-22, 6-22-22, 7-22-22, 8-22-22, 9-22-22, 10-22-22, 11-22-22, 12-22-22, 1-23-23, 2-23-23, 3-23-23, 4-23-23, 5-23-23, 6-23-23, 7-23-23, 8-23-23, 9-23-23, 10-23-23, 11-23-23, 12-23-23, 1-24-24, 2-24-24, 3-24-24, 4-24-24, 5-24-24, 6-24-24, 7-24-24, 8-24-24, 9-24-24, 10-24-24, 11-24-24, 12-24-24, 1-25-25, 2-25-25, 3-25-25, 4-25-25, 5-25-25, 6-25-25, 7-25-25, 8-25-25, 9-25-25, 10-25-25, 11-25-25, 12-25-25, 1-26-26, 2-26-26, 3-26-26, 4-26-26, 5-26-26, 6-26-26, 7-26-26, 8-26-26, 9-26-26, 10-26-26, 11-26-26, 12-26-26, 1-27-27, 2-27-27, 3-27-27, 4-27-27, 5-27-27, 6-27-27, 7-27-27, 8-27-27, 9-27-27, 10-27-27, 11-27-27, 12-27-27, 1-28-28, 2-28-28, 3-28-28, 4-28-28, 5-28-28, 6-28-28, 7-28-28, 8-28-28, 9-28-28, 10-28-28, 11-28-28, 12-28-28, 1-29-29, 2-29-29, 3-29-29, 4-29-29, 5-29-29, 6-29-29, 7-29-29, 8-29-29, 9-29-29, 10-29-29, 11-29-29, 12-29-29, 1-30-30, 2-30-30, 3-30-30, 4-30-30, 5-30-30, 6-30-30, 7-30-30, 8-30-30, 9-30-30, 10-30-30, 11-30-30, 12-30-30, 1-31-31, 2-31-31, 3-31-31, 4-31-31, 5-31-31, 6-31-31, 7-31-31, 8-31-31, 9-31-31, 10-31-31, 11-31-31, 12-31-31, 1-32-32, 2-32-32, 3-32-32, 4-32-32, 5-32-32, 6-32-32, 7-32-32, 8-32-32, 9-32-32, 10-32-32, 11-32-32, 12-32-32, 1-33-33, 2-33-33, 3-33-33, 4-33-33, 5-33-33, 6-33-33, 7-33-33, 8-33-33, 9-33-33, 10-33-33, 11-33-33, 12-33-33, 1-34-34, 2-34-34, 3-34-34, 4-34-34, 5-34-34, 6-34-34, 7-34-34, 8-34-34, 9-34-34, 10-34-34, 11-34-34, 12-34-34, 1-35-35, 2-35-35, 3-35-35, 4-35-35, 5-35-35, 6-35-35, 7-35-35, 8-35-35, 9-35-35, 10-35-35, 11-35-35, 12-35-35, 1-36-36, 2-36-36, 3-36-36, 4-36-36, 5-36-36, 6-36-36, 7-36-36, 8-36-36, 9-36-36, 10-36-36, 11-36-36, 12-36-36, 1-37-37, 2-37-37, 3-37-37, 4-37-37, 5-37-37, 6-37-37, 7-37-37, 8-37-37, 9-37-37, 10-37-37, 11-37-37, 12-37-37, 1-38-38, 2-38-38, 3-38-38, 4-38-38, 5-38-38, 6-38-38, 7-38-38, 8-38-38, 9-38-38, 10-38-38, 11-38-38, 12-38-38, 1-39-39, 2-39-39, 3-39-39, 4-39-39, 5-39-39, 6-39-39, 7-39-39, 8-39-39, 9-39-39, 10-39-39, 11-39-39, 12-39-39, 1-40-40, 2-40-40, 3-40-40, 4-40-40, 5-40-40, 6-40-40, 7-40-40, 8-40-40, 9-40-40, 10-40-40, 11-40-40, 12-40-40, 1-41-41, 2-41-41, 3-41-41, 4-41-41, 5-41-41, 6-41-41, 7-41-41, 8-41-41, 9-41-41, 10-41-41, 11-41-41, 12-41-41, 1-42-42, 2-42-42, 3-42-42, 4-42-42, 5-42-42, 6-42-42, 7-42-42, 8-42-42, 9-42-42, 10-42-42, 11-42-42, 12-42-42, 1-43-43, 2-43-43, 3-43-43, 4-43-43, 5-43-43, 6-43-43, 7-43-43, 8-43-43, 9-43-43, 10-43-43, 11-43-43, 12-43-43, 1-44-44, 2-44-44, 3-44-44, 4-44-44, 5-44-44, 6-44-44, 7-44-44, 8-44-44, 9-44-44, 10-44-44, 11-44-44, 12-44-44, 1-45-45, 2-45-45, 3-45-45, 4-45-45, 5-45-45, 6-45-45, 7-45-45, 8-45-45, 9-45-45, 10-45-45, 11-45-45, 12-45-45, 1-46-46, 2-46-46, 3-46-46, 4-46-46, 5-46-46, 6-46-46, 7-46-46, 8-46-46, 9-46-46, 10-46-46, 11-46-46, 12-46-46, 1-47-47, 2-47-47, 3-47-47, 4-47-47, 5-47-47, 6-47-47, 7-47-47, 8-47-47, 9-47-47, 10-47-47, 11-47-47, 12-47-47, 1-48-48, 2-48-48, 3-48-48, 4-48-48, 5-48-48, 6-48-48, 7-48-48, 8-48-48, 9-48-48, 10-48-48, 11-48-48, 12-48-48, 1-49-49, 2-49-49, 3-49-49, 4-49-49, 5-49-49, 6-49-49, 7-49-49, 8-49-49, 9-49-49, 10-49-49, 11-49-49, 12-49-49, 1-50-50, 2-50-50, 3-50-50, 4-50-50, 5-50-50, 6-50-50, 7-50-50, 8-50-50, 9-50-50, 10-50-50, 11-50-50, 12-50-50, 1-51-51, 2-51-51, 3-51-51, 4-51-51, 5-51-51, 6-51-51, 7-51-51, 8-51-51, 9-51-51, 10-51-51, 11-51-51, 12-51-51, 1-52-52, 2-52-52, 3-52-52, 4-52-52, 5-52-52, 6-52-52, 7-52-52, 8-52-52, 9-52-52, 10-52-52, 11-52-52, 12-52-52, 1-53-53, 2-53-53, 3-53-53, 4-53-53, 5-53-53, 6-53-53, 7-53-53, 8-53-53, 9-53-53, 10-53-53, 11-53-53, 12-53-53, 1-54-54, 2-54-54, 3-54-54, 4-54-54, 5-54-54, 6-54-54, 7-54-54, 8-54-54, 9-54-54, 10-54-54, 11-54-54, 12-54-54, 1-55-55, 2-55-55, 3-55-55, 4-55-55, 5-55-55, 6-55-55, 7-55-55, 8-55-55, 9-55-55, 10-55-55, 11-55-55, 12-55-55, 1-56-56, 2-56-56, 3-56-56, 4-56-56, 5-56-56, 6-56-56, 7-56-56, 8-56-56, 9-56-56, 10-56-56, 11-56-56, 12-56-56, 1-57-57, 2-57-57, 3-57-57, 4-57-57, 5-57-57, 6-57-57, 7-57-57, 8-57-57, 9-57-57, 10-57-57, 11-57-57, 12-57-57, 1-58-58, 2-58-58, 3-58-58, 4-58-58, 5-58-58, 6-58-58, 7-58-58, 8-58-58, 9-58-58, 10-58-58, 11-58-58, 12-58-58, 1-59-59, 2-59-59, 3-59-59, 4-59-59, 5-59-59, 6-59-59, 7-59-59, 8-59-59, 9-59-59, 10-59-59, 11-59-59, 12-59-59, 1-60-60, 2-60-60, 3-60-60, 4-60-60, 5-60-60, 6-60-60, 7-60-60, 8-60-60, 9-60-60, 10-60-60, 11-60-60, 12-60-60, 1-61-61, 2-61-61, 3-61-61, 4-61-61, 5-61-61, 6-61-61, 7-61-61, 8-61-61, 9-61-61, 10-61-61, 11-61-61, 12-61-61, 1-62-62, 2-62-62, 3-62-62, 4-62-62, 5-62-62, 6-62-62, 7-62-62, 8-62-62, 9-62-62, 10-62-62, 11-62-62, 12-62-62, 1-63-63, 2-63-63, 3-63-63, 4-63-63, 5-63-63, 6-63-63, 7-63-63, 8-63-63, 9-63-63, 10-63-63, 11-63-63, 12-63-63, 1-64-64, 2-64-64, 3-64-64, 4-64-64, 5-64-64, 6-64-64, 7-64-64, 8-64-64, 9-64-64, 10-64-64, 11-64-64, 12-64-64, 1-65-65, 2-65-65, 3-65-65, 4-65-65, 5-65-65, 6-65-65, 7-65-65, 8-65-65, 9-65-65, 10-65-65, 11-65-65, 12-65-65, 1-66-66, 2-66-66, 3-66-66, 4-66-66, 5-66-66, 6-66-66, 7-66-66, 8-66-66, 9-66-66, 10-66-66, 11-66-66, 12-66-66, 1-67-67, 2-67-67, 3-67-67, 4-67-67, 5-67-67, 6-67-67, 7-67-67, 8-67-67, 9-67-67, 10-67-67, 11-67-67, 12-67-67, 1-68-68, 2-68-68, 3-68-68, 4-68-68, 5-68-68, 6-68-68, 7-68-68, 8-68-68, 9-68-68, 10-68-68, 11-68-68, 12-68-68, 1-69-69, 2-69-69, 3-69-69, 4-69-69, 5-69-69, 6-69-69, 7-69-69, 8-69-69, 9-69-69, 10-69-69, 11-69-69, 12-69-69, 1-70-70, 2-70-70, 3-70-70, 4-70-70, 5-70-70, 6-70-70, 7-70-70, 8-70-70, 9-70-70, 10-70-70, 11-70-70, 12-70-70, 1-71-71, 2-71-71, 3-71-71, 4-71-71, 5-71-71, 6-71-71, 7-71-71, 8-71-71, 9-71-71, 10-71-71, 11-71-71, 12-71-71, 1-72-72, 2-72-72, 3-72-72, 4-72-72, 5-72-72, 6-72-72, 7-72-72, 8-72-72, 9-72-72, 10-72-72, 11-72-72, 12-72-72, 1-73-73, 2-73-73, 3-73-73, 4-73-73, 5-73-73, 6-73-73, 7-73-73, 8-73-73, 9-73-73, 10-73-73, 11-73-73, 12-73-73, 1-74-74, 2-74-74, 3-74-74, 4-74-74, 5-74-74, 6-74-74, 7-74-74, 8-74-74, 9-74-74, 10-74-74, 11-74-74, 12-74-74, 1-75-75, 2-75-75, 3-75-75, 4-75-75, 5-75-75, 6-75-75, 7-75-75, 8-75-75, 9-75-75, 10-75-75, 11-75-75, 12-75-75, 1-76-76, 2-76-76, 3-76-76, 4-76-76, 5-76-76, 6-76-76, 7-76-76, 8-76-76, 9-76-76, 10-76-76, 11-76-76, 12-76-76, 1-77-77, 2-77-77, 3-77-77, 4-77-77, 5-77-77, 6-77-77, 7-77-77, 8-77-77, 9-77-77, 10-77-77, 11-77-77, 12-77-77, 1-78-78, 2-78-78, 3-78-78, 4-78-78, 5-78-78, 6-78-78, 7-78-78, 8-78-78, 9-78-78, 10-78-78, 11-78-78, 12-78-78, 1-79-79, 2-79-79, 3-79-79, 4-79-79, 5-79-79, 6-79-79, 7-79-79, 8-79-79, 9-79-79, 10-79-79, 11-79-79, 12-79-79, 1-80-80, 2-80-80, 3-80-80, 4-80-80, 5-80-80, 6-80-80, 7-80-80, 8-80-80, 9-80-80, 10-80-80, 11-80-80, 12-80-80, 1-81-81, 2-81-81, 3-81-81, 4-81-81, 5-81-81, 6-81-81, 7-81-81, 8-81-81, 9-81-81, 10-81-81, 11-81-81, 12-81-81, 1-82-82, 2-82-82, 3-82-82, 4-82-82, 5-82-82, 6-82-82, 7-82-82, 8-82-82, 9-82-82, 10-82-82, 11-82-82, 12-82-82, 1-83-83, 2-83-83, 3-83-83, 4-83-83, 5-83-83, 6-83-83, 7-83-83, 8-83-83, 9-83-83, 10-83-83, 11-83-83, 12-83-83, 1-84-84, 2-84-84, 3-84-84, 4-84-84, 5-84-84, 6-84-84, 7-84-84, 8-84-84, 9-84-84, 10-84-84, 11-84-84, 12-84-84, 1-85-85, 2-85-85, 3-85-85, 4-85-85, 5-85-85, 6-85-85, 7-85-85, 8-85-85, 9-85-85, 10-85-85, 11-85-85, 12-85-85, 1-86-86, 2-86-86, 3-86-86, 4-86-86, 5-86-86, 6-86-86, 7-86-86, 8-86-86, 9-86-86, 10-86-86, 11-86-86, 12-86-86, 1-87-87, 2-87-87, 3-87-87, 4-87-87, 5-87-87, 6-87-87, 7-87-87, 8-87-87, 9-87-87, 10-87-87, 11-87-87, 12-87-87, 1-88-88, 2-88-88, 3-88-88, 4-88-88, 5-88-88, 6-88-88, 7-88-88, 8-88-88, 9-88-88, 10-88-88, 11-88-88, 12-88-88, 1-89-89, 2-89-89, 3-89-89, 4-89-89, 5-89-89, 6-89-89, 7-89-89, 8-89-89, 9-89-89, 10-89-89, 11-89-89, 12-89-89, 1-90-90, 2-90-90, 3-90-90, 4-90-90, 5-90-90, 6-90-90, 7-90-90, 8-90-90, 9-90-90, 10-90-90, 11-90-90, 12-90-90, 1-91-91, 2-91-91, 3-91-91, 4-91-91, 5-91-91, 6-91-91, 7-91-91, 8-91-91, 9-91-91, 10-91-91, 11-91-91, 12-91-91, 1-92-92, 2-92-92, 3-92-92, 4-92-92, 5-92-92, 6-92-92, 7-92-92, 8-92-92, 9-92-92, 10-92-92, 11-92-92, 12-92-92, 1-93-93, 2-93-93, 3-93-93, 4-93-93, 5-93-93, 6-93-93, 7-93-93, 8-93-93, 9-93-93, 10-93-93, 11-93-93, 12-93-93, 1-94-94, 2-94-94, 3-94-94, 4-94-94, 5-94-94, 6-94-94, 7-94-94, 8-94-94, 9-94-94, 10-94-94, 11-94-94, 12-94-94, 1-95-95, 2-95-95, 3-95-95, 4-95-95, 5-95-95, 6-95-95, 7-95-95, 8-95-95, 9-95-95, 10-95-95, 11-95-95, 12-95-95, 1-96-96, 2-96-96, 3-96-96, 4-96-96, 5-96-96, 6-96-96, 7-96-96, 8-96-96, 9-96-96, 10-96-96, 11-96-96, 12-96-96, 1-97-97, 2-97-97, 3-97-97, 4-97-97, 5-97-97, 6-97-97, 7-97-97, 8-97-97, 9-97-97, 10-97-97, 11-97-97, 12-97-97, 1-98-98, 2-98-98, 3-98-98, 4-98-98, 5-98-98, 6-98-98, 7-98-98, 8-98-98, 9-98-98, 10-98-98, 11-98-98, 12-98-98, 1-99-99, 2-99-99, 3-99-99, 4-99-99, 5-99-99, 6-99-99, 7-99-99, 8-99-99, 9-99-99, 10-99-99, 11-99-99, 12-99-99, 1-100-100, 2-100-100, 3-100-100, 4-100-100, 5-100-100, 6-100-100, 7-100-100, 8-100-100, 9-100-100, 10-100-100, 11-100-100, 12-100-100, 1-101-101, 2-101-101, 3-101-101, 4-101-101, 5-101-101, 6-101-101, 7-101-101, 8-101-101, 9-101-101, 10-101-101, 11-101-101, 12-101-101, 1-102-102, 2-102-102, 3-102-102, 4-102-102, 5-102-102, 6-102-102, 7-102-102, 8-102-102, 9-102-102, 10-102-102, 11-102-102, 12-102-102, 1-103-103, 2-103-103, 3-103-103, 4-103-103, 5-103-103, 6-103-103, 7-103-103, 8-103-103, 9-103-103, 10-103-103, 11-103-103, 12-103-103, 1-104-104, 2-104-104, 3-104-104, 4-104-104, 5-104-104, 6-104-104, 7-104-104, 8-104-104, 9-104-104, 10-104-104, 11-104-104, 12-104-104, 1-105-105, 2-105-105, 3-105-105, 4-105-105, 5-105-105, 6-105-105, 7-105-105, 8-105-105, 9-111-111, 10-111-111, 11-111-111, 12-111-111, 1-112-112, 2-112-112, 3-112-112, 4-112-112, 5-112-112, 6-112-112, 7-112-112, 8-112-112, 9-112-112, 10-112-112, 11-112-112, 12-112-112, 1-113-113, 2-113-113, 3-113-113, 4-113-113, 5-113-113, 6-113-113, 7-113-113, 8-113-113, 9-113-113, 10-113-113, 11-113-113, 12-113-113, 1-114-114, 2-114-114, 3-114-114, 4-114-114, 5-114-114, 6-114-114, 7-114-114, 8-114-114, 9-114-114, 10-114-114, 11-114-114, 12-114-114, 1-115-115, 2-115-115, 3-115-115, 4-115-115, 5-115-115, 6-115-115, 7-115-115, 8-115-115, 9-115-115, 10-115-115, 11-115-11

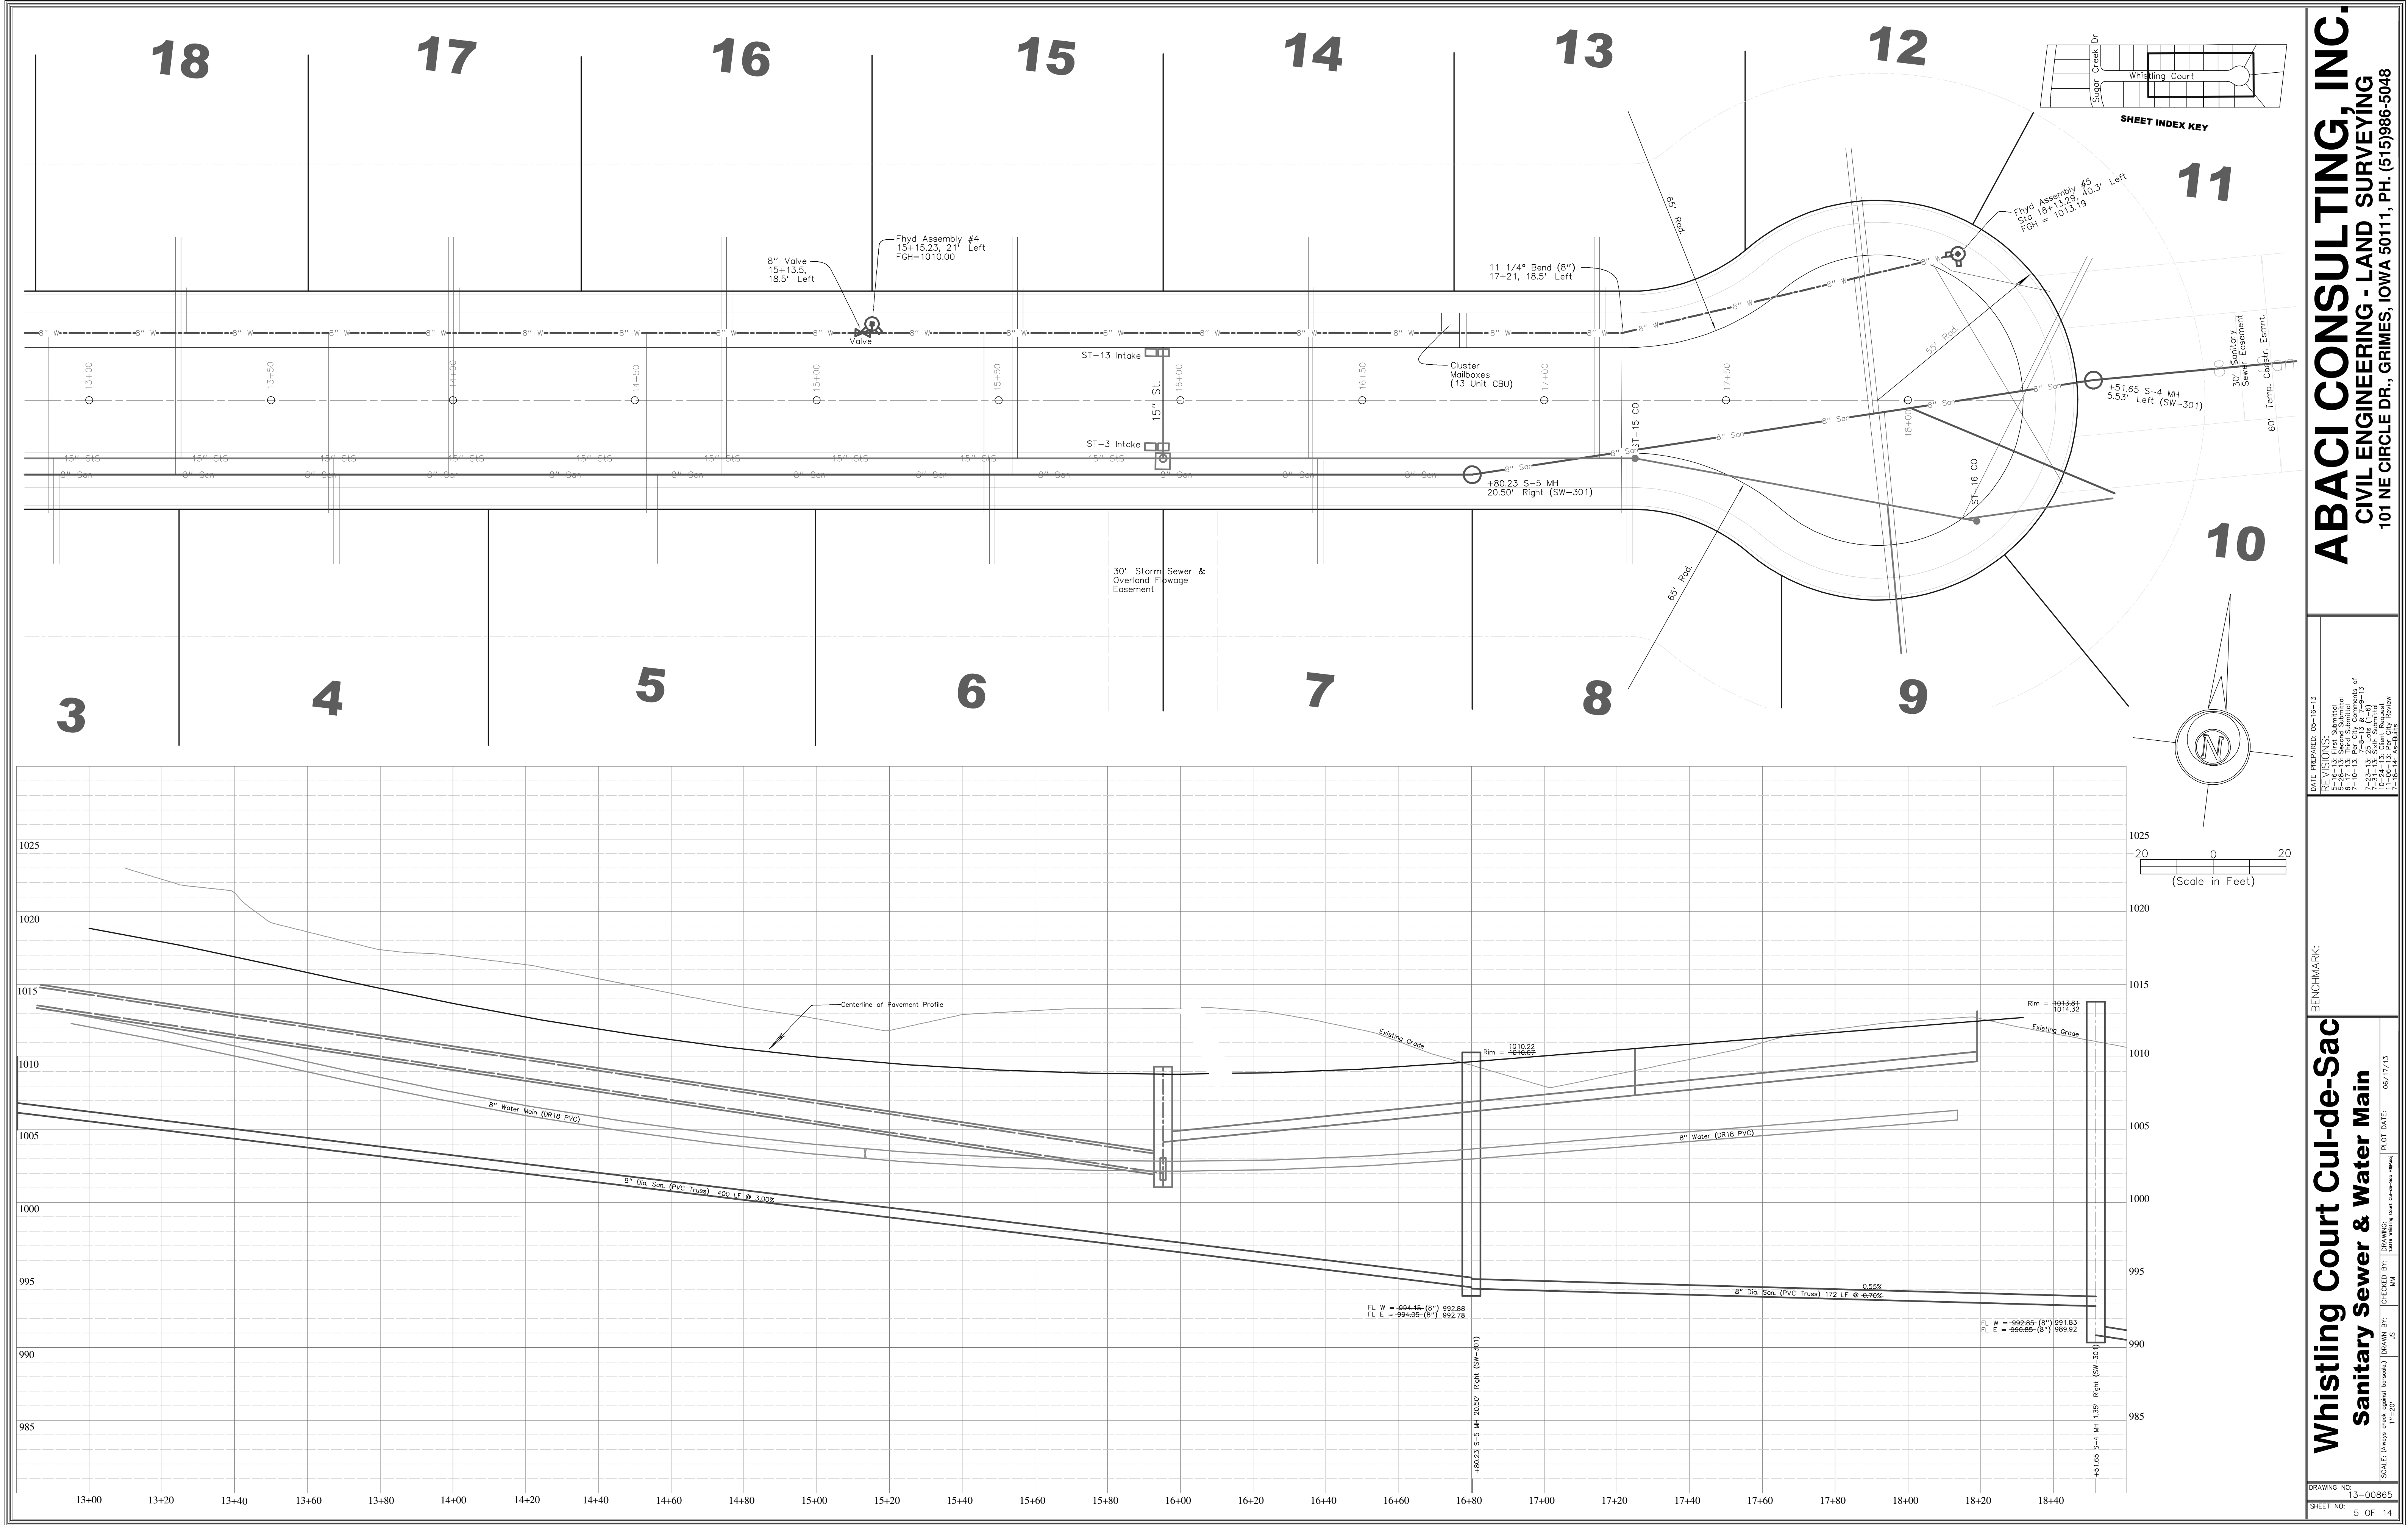

18

17

16

18

17

16

18

17

16

15

14

13


12

11

10

9

<

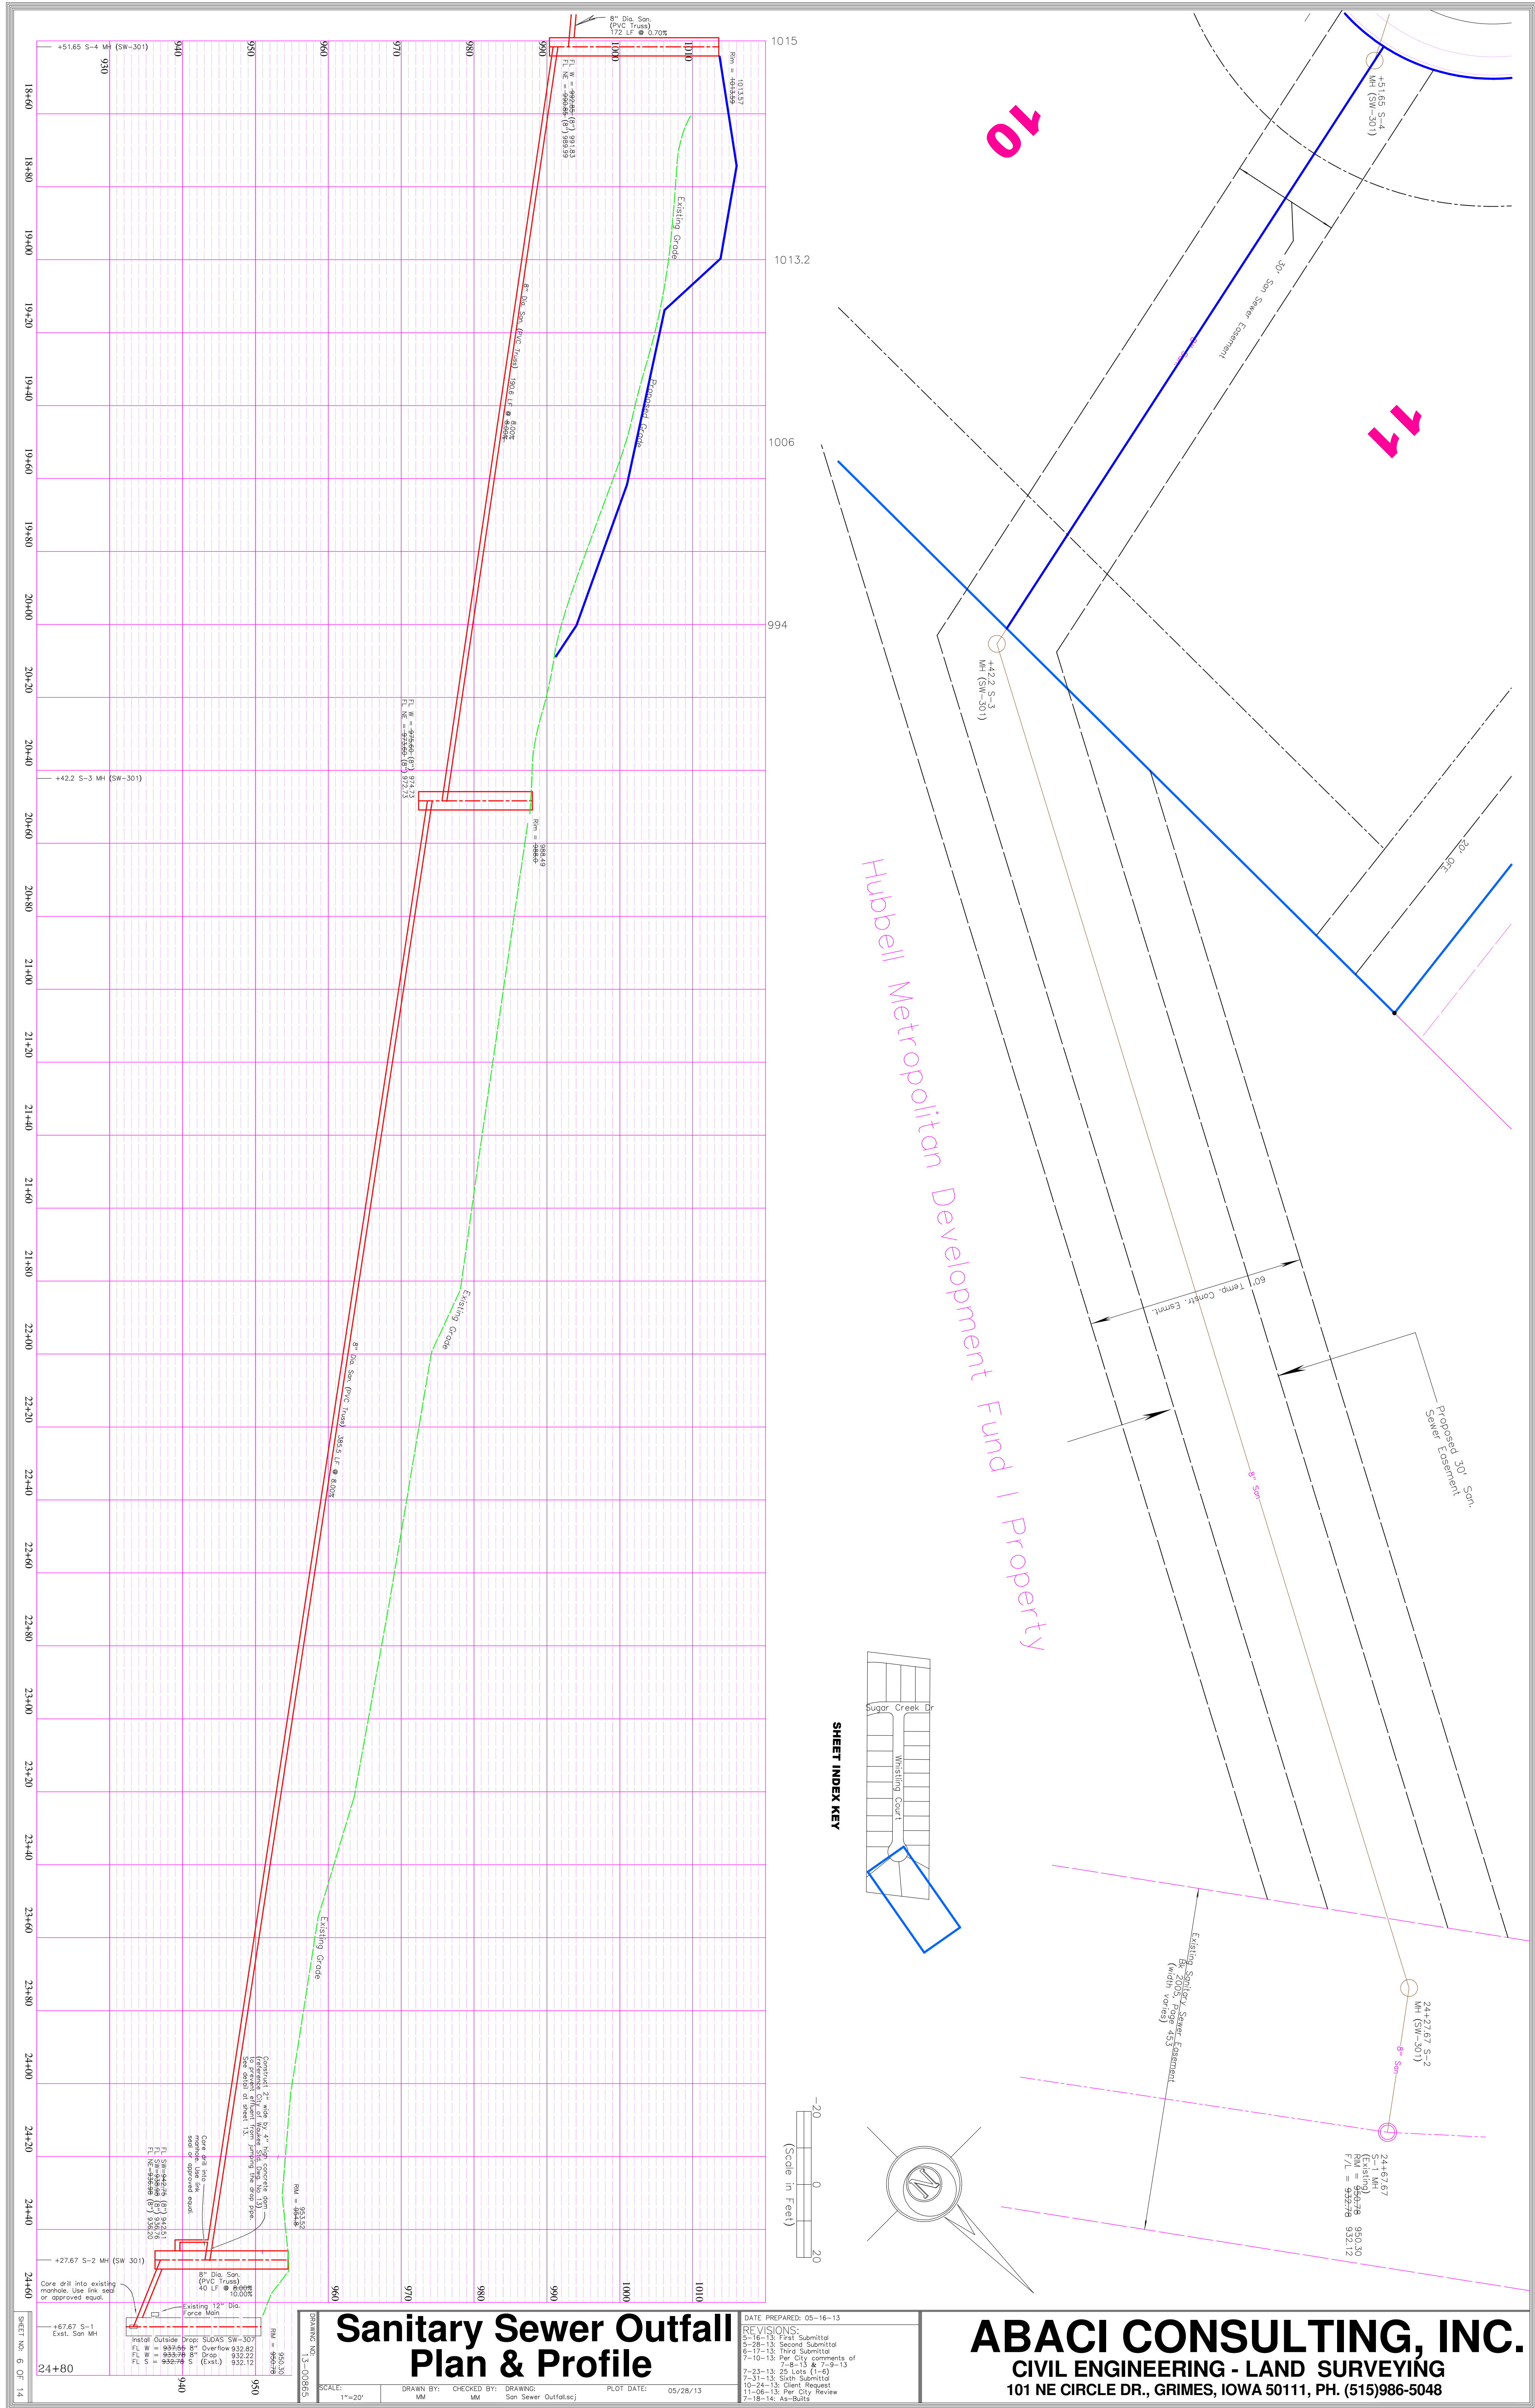



ABACI CONSULTING, INC.
CIVIL ENGINEERING - LAND SURVEYING
101 NE CIRCLE DR., GRIMES, IOWA 50111, PH. (515)986-5048

DATE PREPARED: 05-16-13
REVISIONS:
1-16-13: First Submit
2-16-13: Second Submit
3-16-13: Third Submit
4-16-13: Per City comments of
5-16-13: 29 Lots (1-6)
6-16-13: Sixth Submit
7-16-13: Client Request
8-16-13: Per City Review
9-16-13: As-Built

SCALE: 1"=20'
DRAWN BY: MM
CHECKED BY: MM
DRAWING: San Sewer Outfall.sci
PLOT DATE: 05/28/13
DRAWING NO: 13-00865

SHEET NO. 6 OF 14

R-22/UTE AVENUE

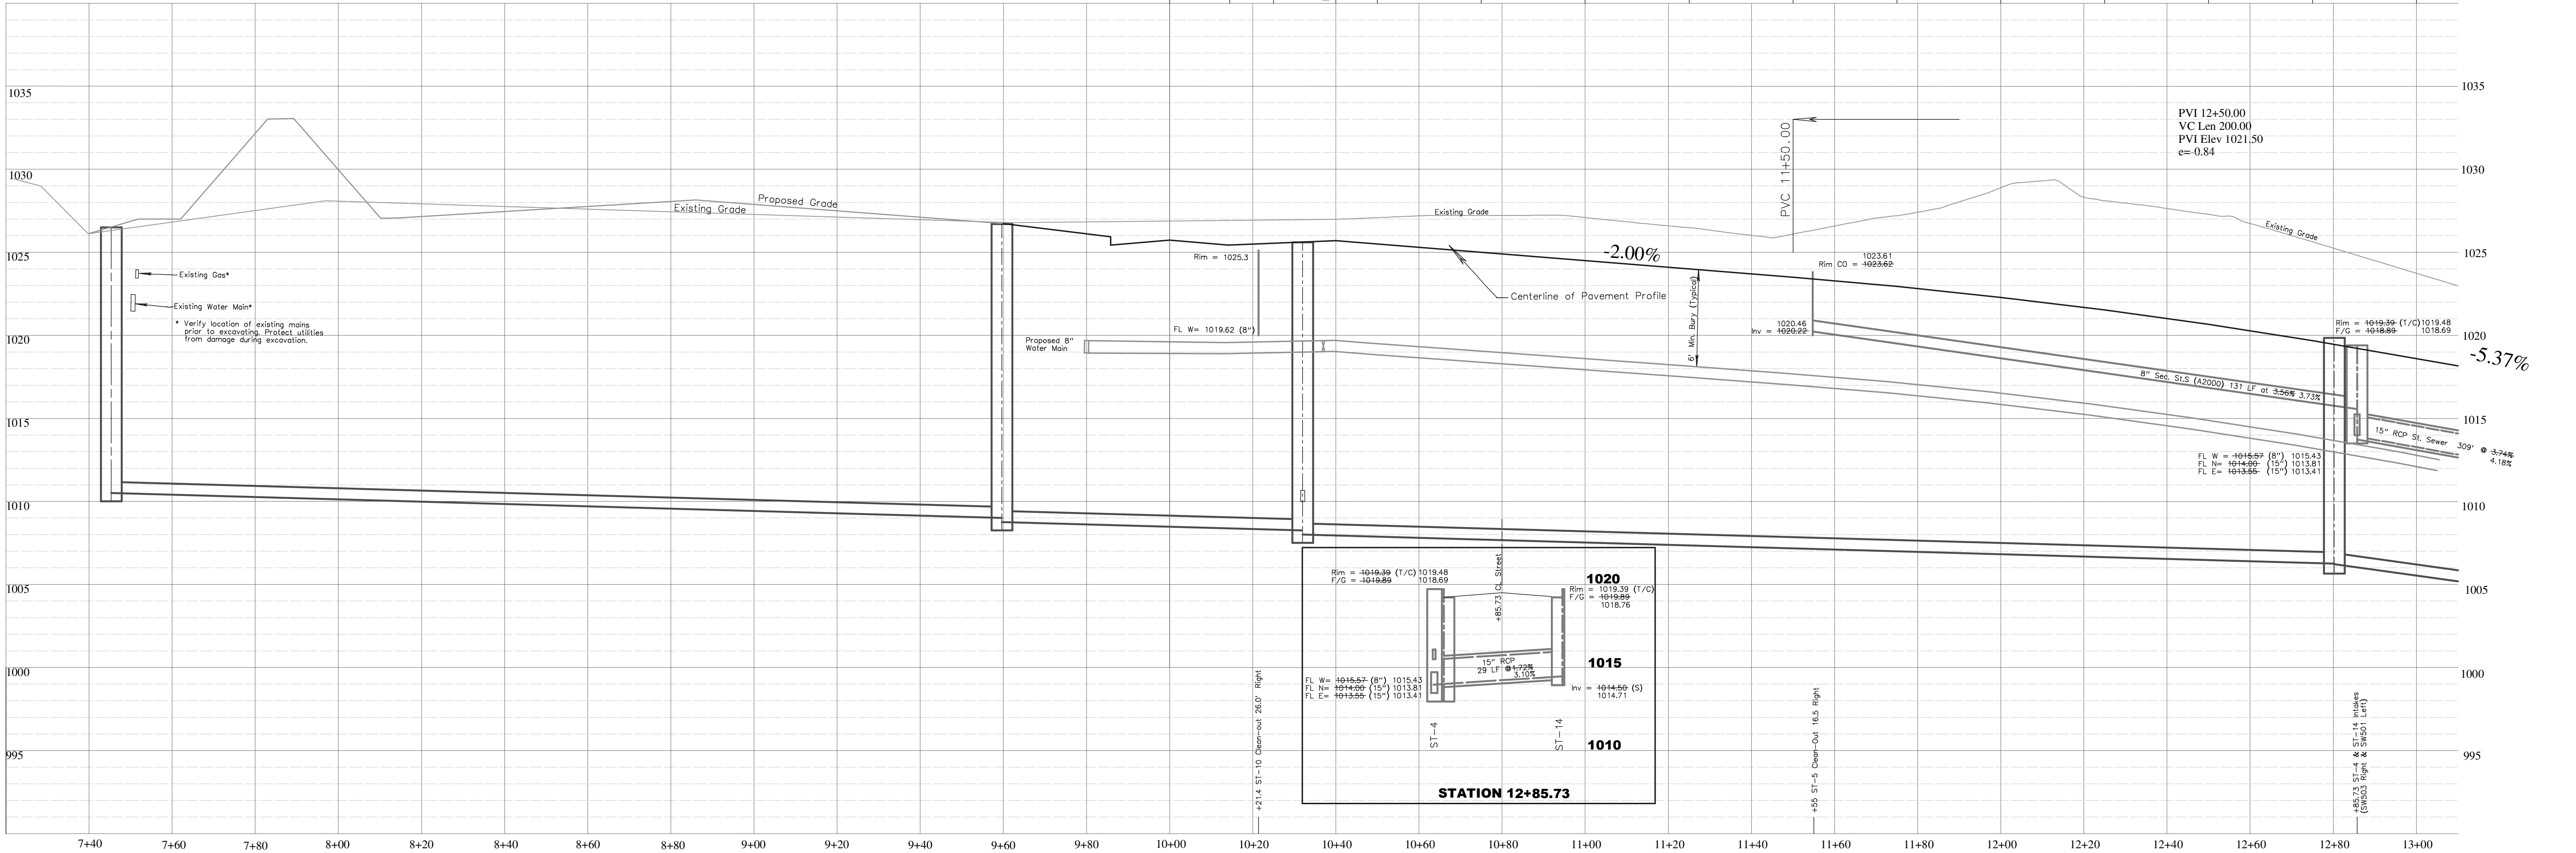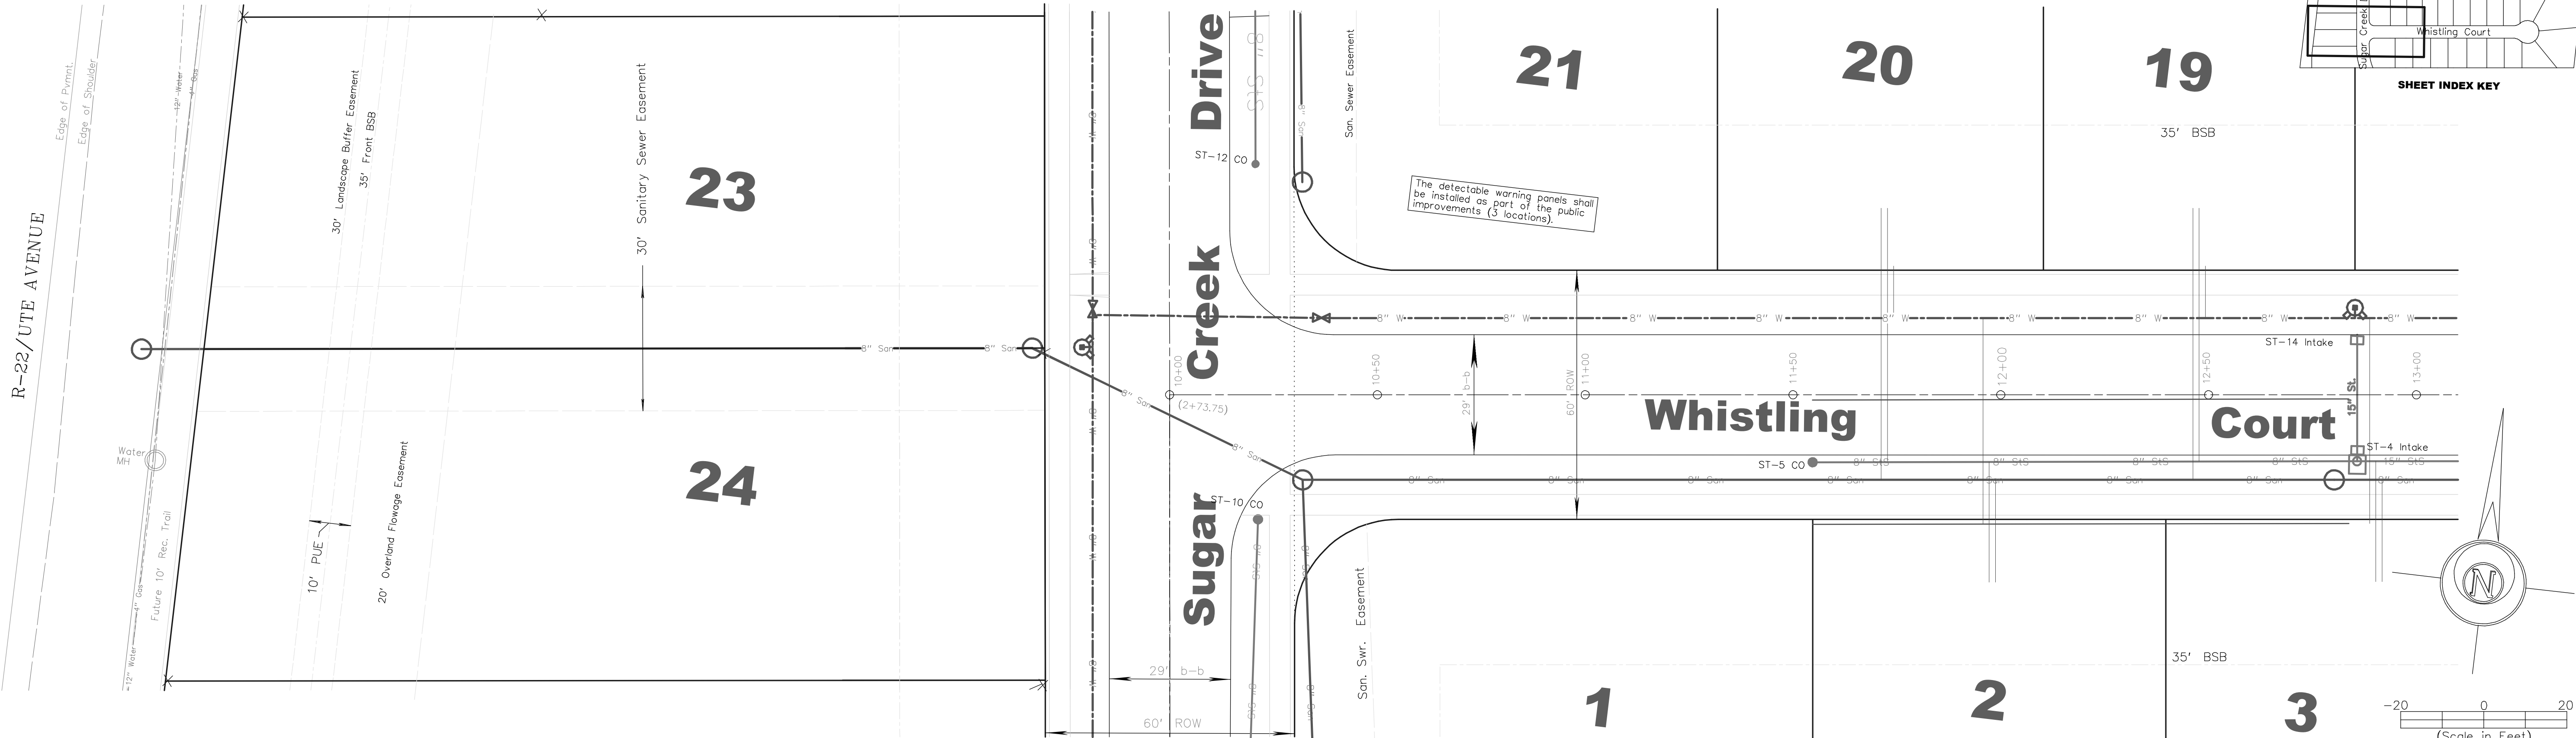

ABACI CONSULTING, INC.
CIVIL ENGINEERING - LAND SURVEYING
101 NE CIRCLE DR., GRIMES, IOWA 50111, PH. (515)986-5048




DATE PREPARED: 05-15-13
DESIGNED BY: [Signature]
CHECKED BY: [Signature]
DRAWN BY: [Signature]
SCALE: (Always check against standard) (8"x11")
PLOT DATE: 06/17/13

BENCHMARK:


**Whistling Court
Paving & Storm Sewer**

DRAWING NO: 13-00865
SHEET NO: 8 OF 14

STANDARD SYMBOLS LEGEND:		
● IRON ROD FOUND	W-2 WATER MAIN	S-2 SANITARY SEWER
○ 1/2" DIA. x 30" IRON PIN SET	G-2 GAS MAIN	S-1 STORM SEWER
▲ SECTION CORNER MONUMENT FOUND	U-2 UNDERGROUND ELECTRIC	XX-XX SILT FENCE
△ SECTION CORNER MONUMENT SET	O-2 OVERHEAD ELECTRIC	1024 PROPOSED CONTOUR
✕ FENCE LINE	U-1 UNDERGROUND TELEPHONE	OFE Overland Flowage Easement
CLF CHAIN LINK FENCE	+/- MOORE OR LESS	CO Clean-out
	~ OVERFLOW ROUTE	FGH Finish Grade @ Hydrant
	→ FLOW DIRECTION	

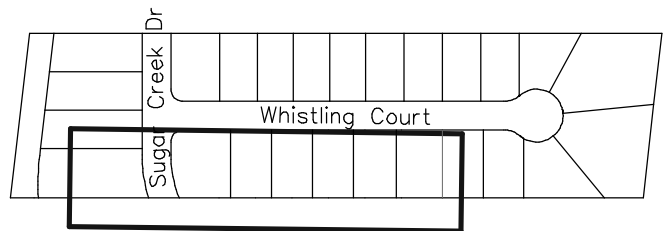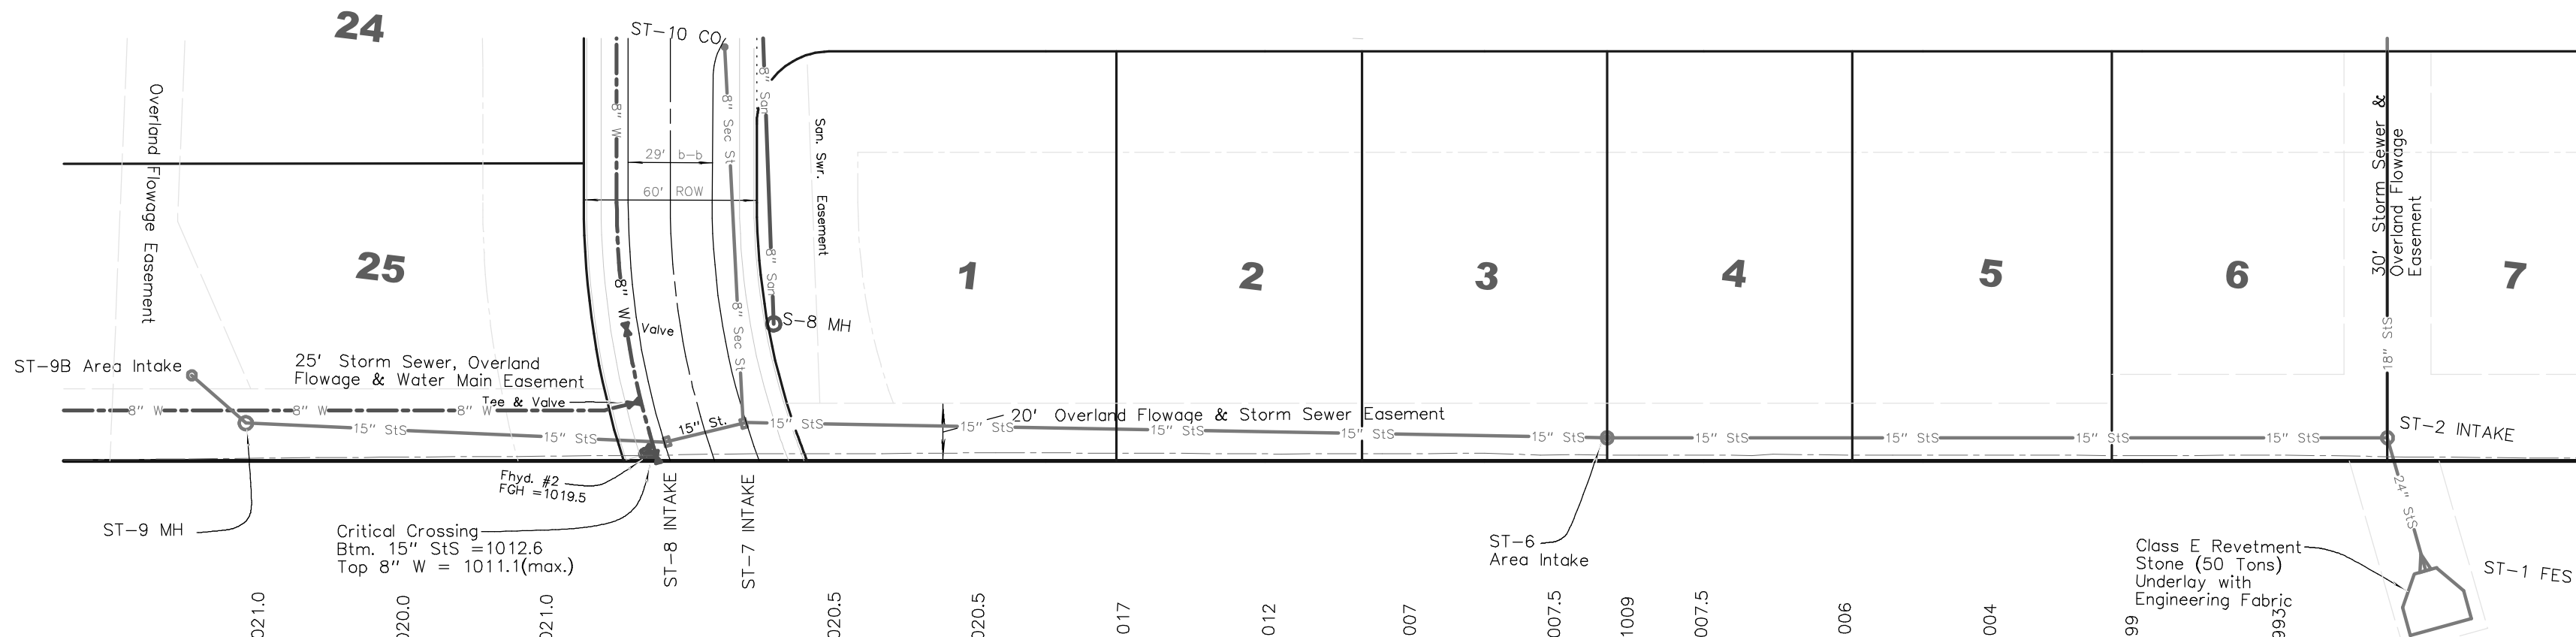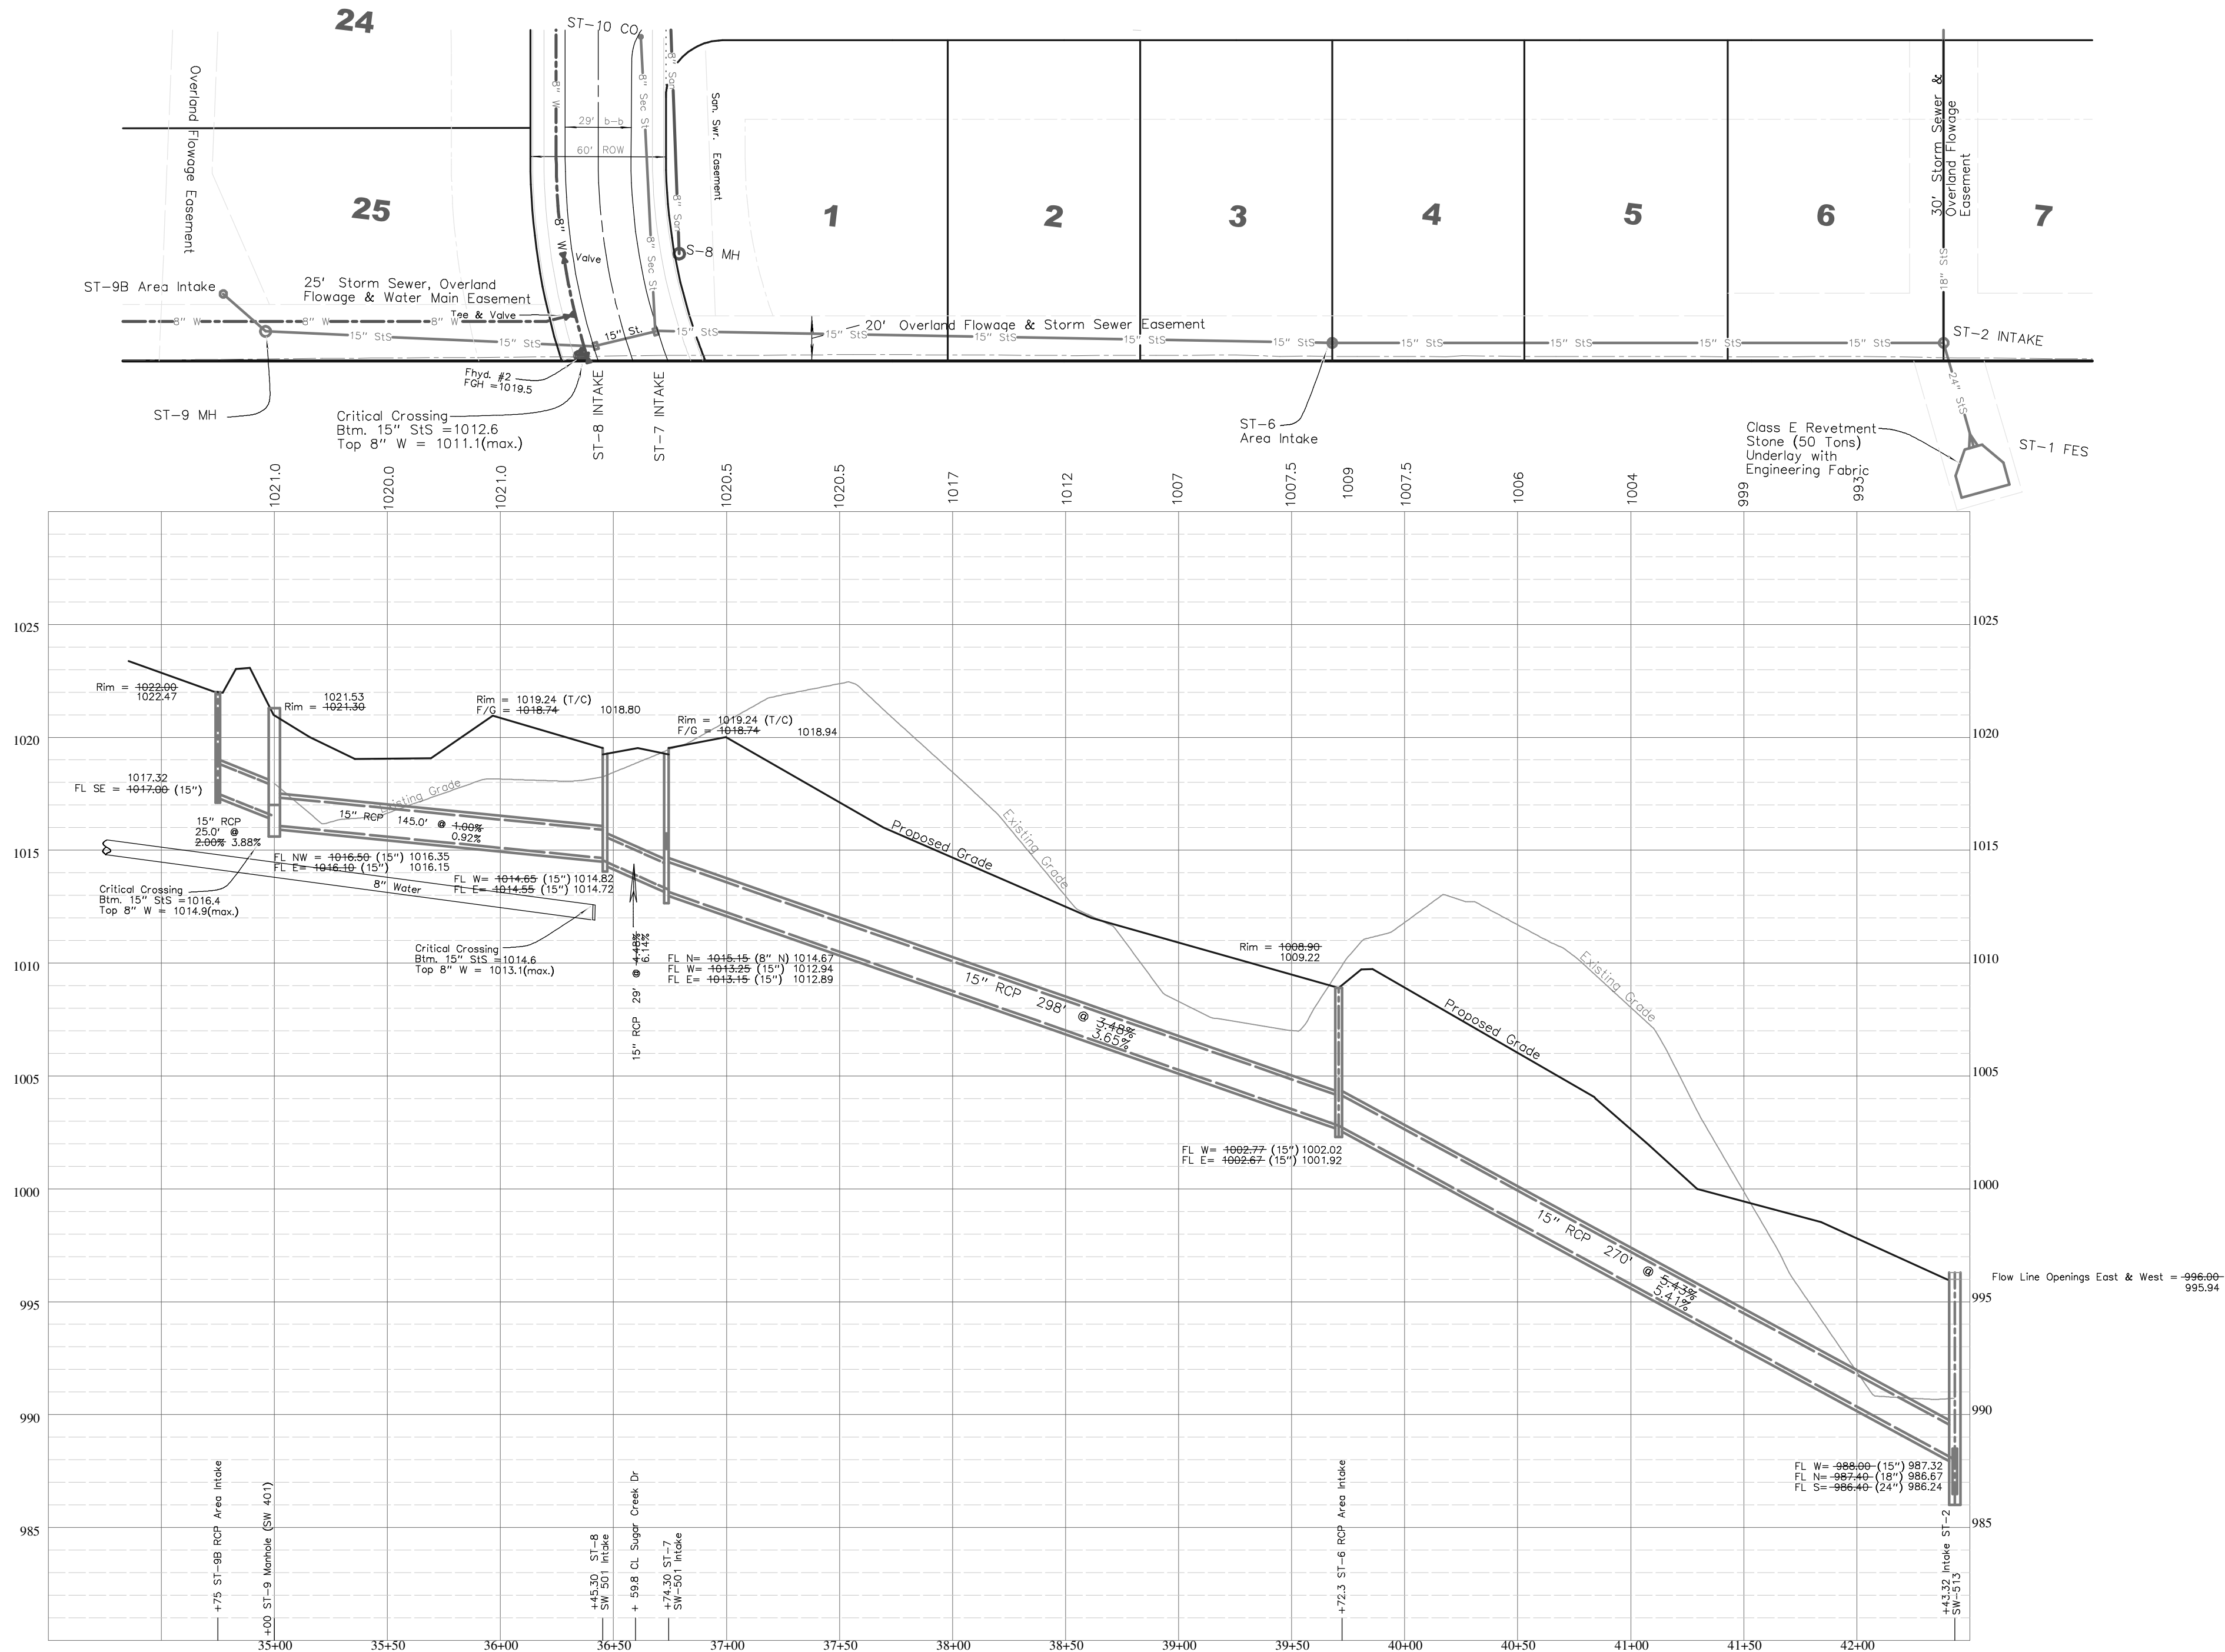

SHEET INDEX KEY

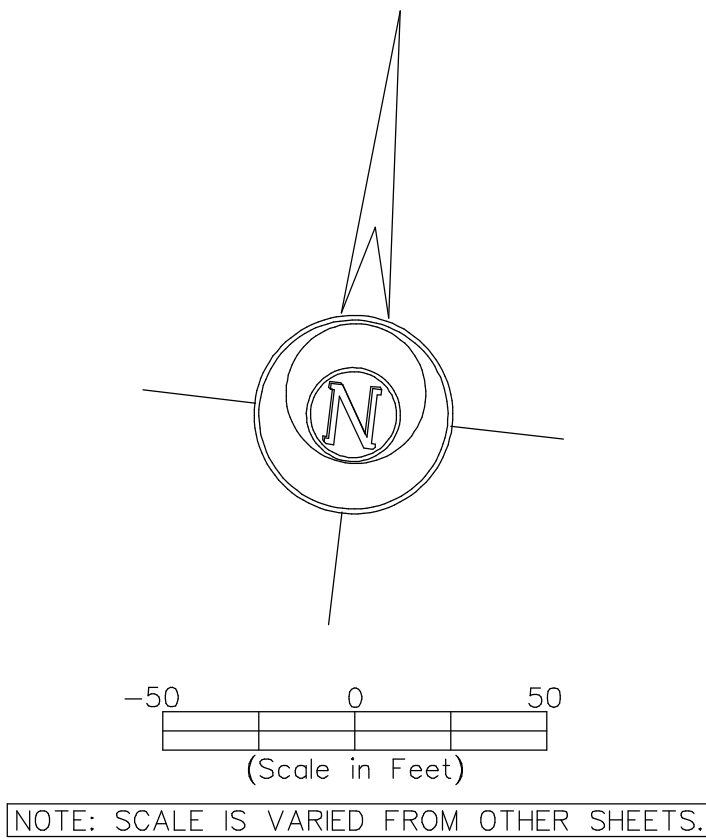

South Storm Sewer Plan & Profile

BENCHMARK:

DATE PREPARED: 05-18-13
REVISIONS:
1. 05-18-13: Original
2. 05-18-13: Second
3. 05-18-13: Third
4. 05-18-13: Fourth
5. 05-18-13: Fifth
6. 05-18-13: Sixth
7. 05-18-13: Seventh
8. 05-18-13: Eighth
9. 05-18-13: Ninth
10. 05-18-13: Tenth



DRAWING NO: 13-00865
SHEET NO: 10 OF 14
DRAWN BY: [Name]
CHECKED BY: [Name]
DATE: 06/17/13
SCALE: (unless noted, 1"=50')

ABACI CONSULTING, INC.
CIVIL ENGINEERING - LAND SURVEYING
101 NE CIRCLE DR., GRIMES, IOWA 50111, PH. (515)986-5048



Storm Outfall
Plan & Profile

SCALE: (Plan) 1"=20'	DATE: 05/16/13
DATE PREPARED: 05-18-13	REVISIONS:
10-24-13: Client Request	7-18-14: AS-Built
7-31-13: Sixth Submitted	10-24-13: Permit Review
7-23-13: Fifth Submitted	7-31-13: Sixth Submitted
6-17-13: Fourth Submitted	7-23-13: Fifth Submitted
5-28-13: Third Submitted	6-17-13: Fourth Submitted
4-16-13: Second Submitted	5-28-13: Third Submitted
3-15-13: First Submitted	4-16-13: Second Submitted

ABACI CONSULTING, INC.
CIVIL ENGINEERING - LAND SURVEYING
101 NE CIRCLE DR., GRIMES, IOWA 50111, PH. (515)986-5048

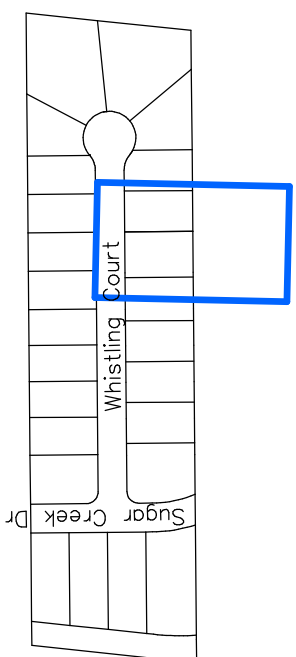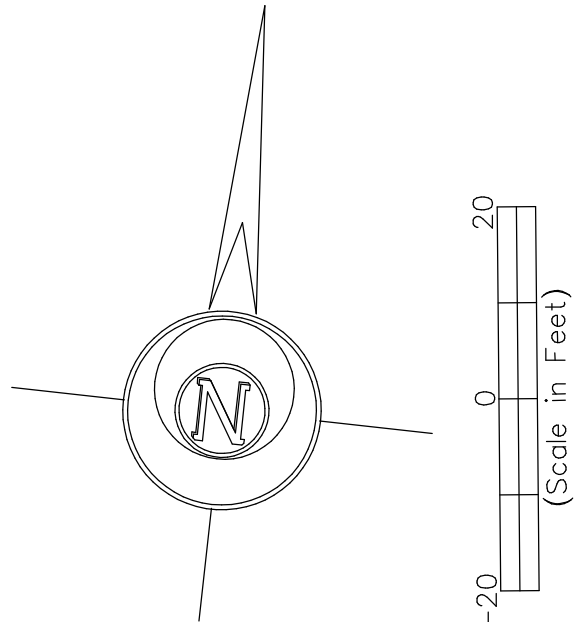

SHEET INDEX KEY

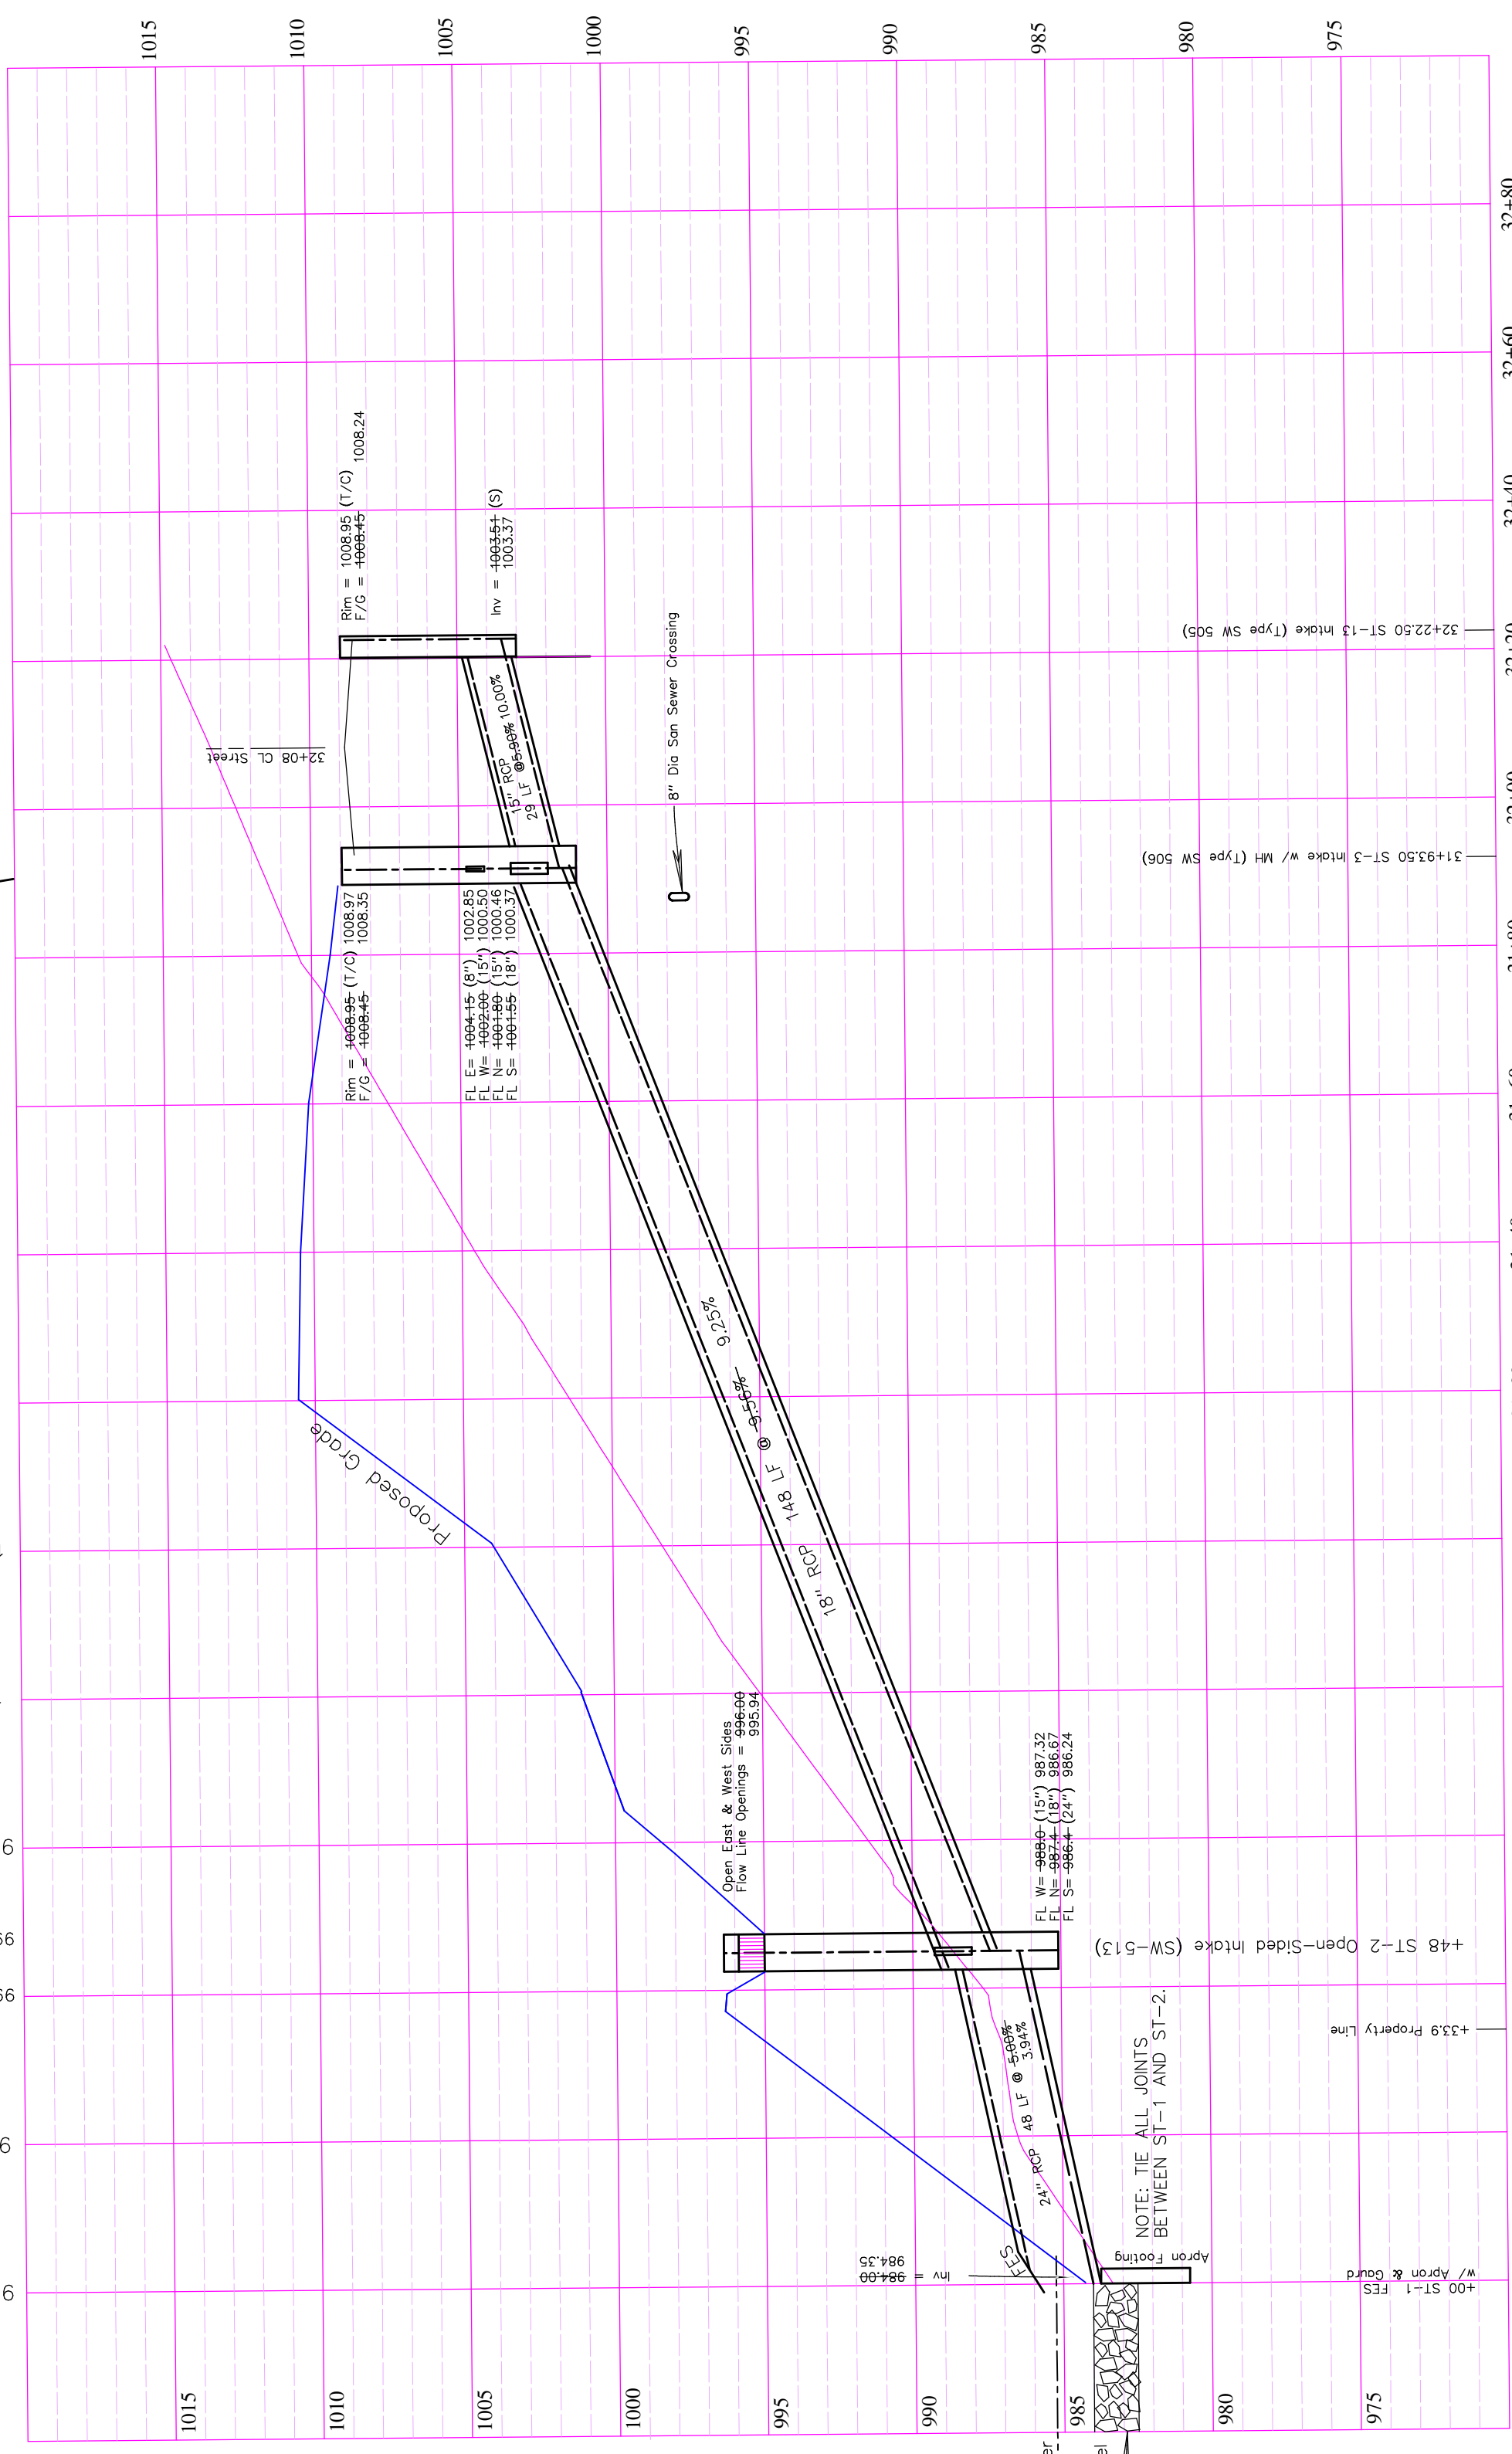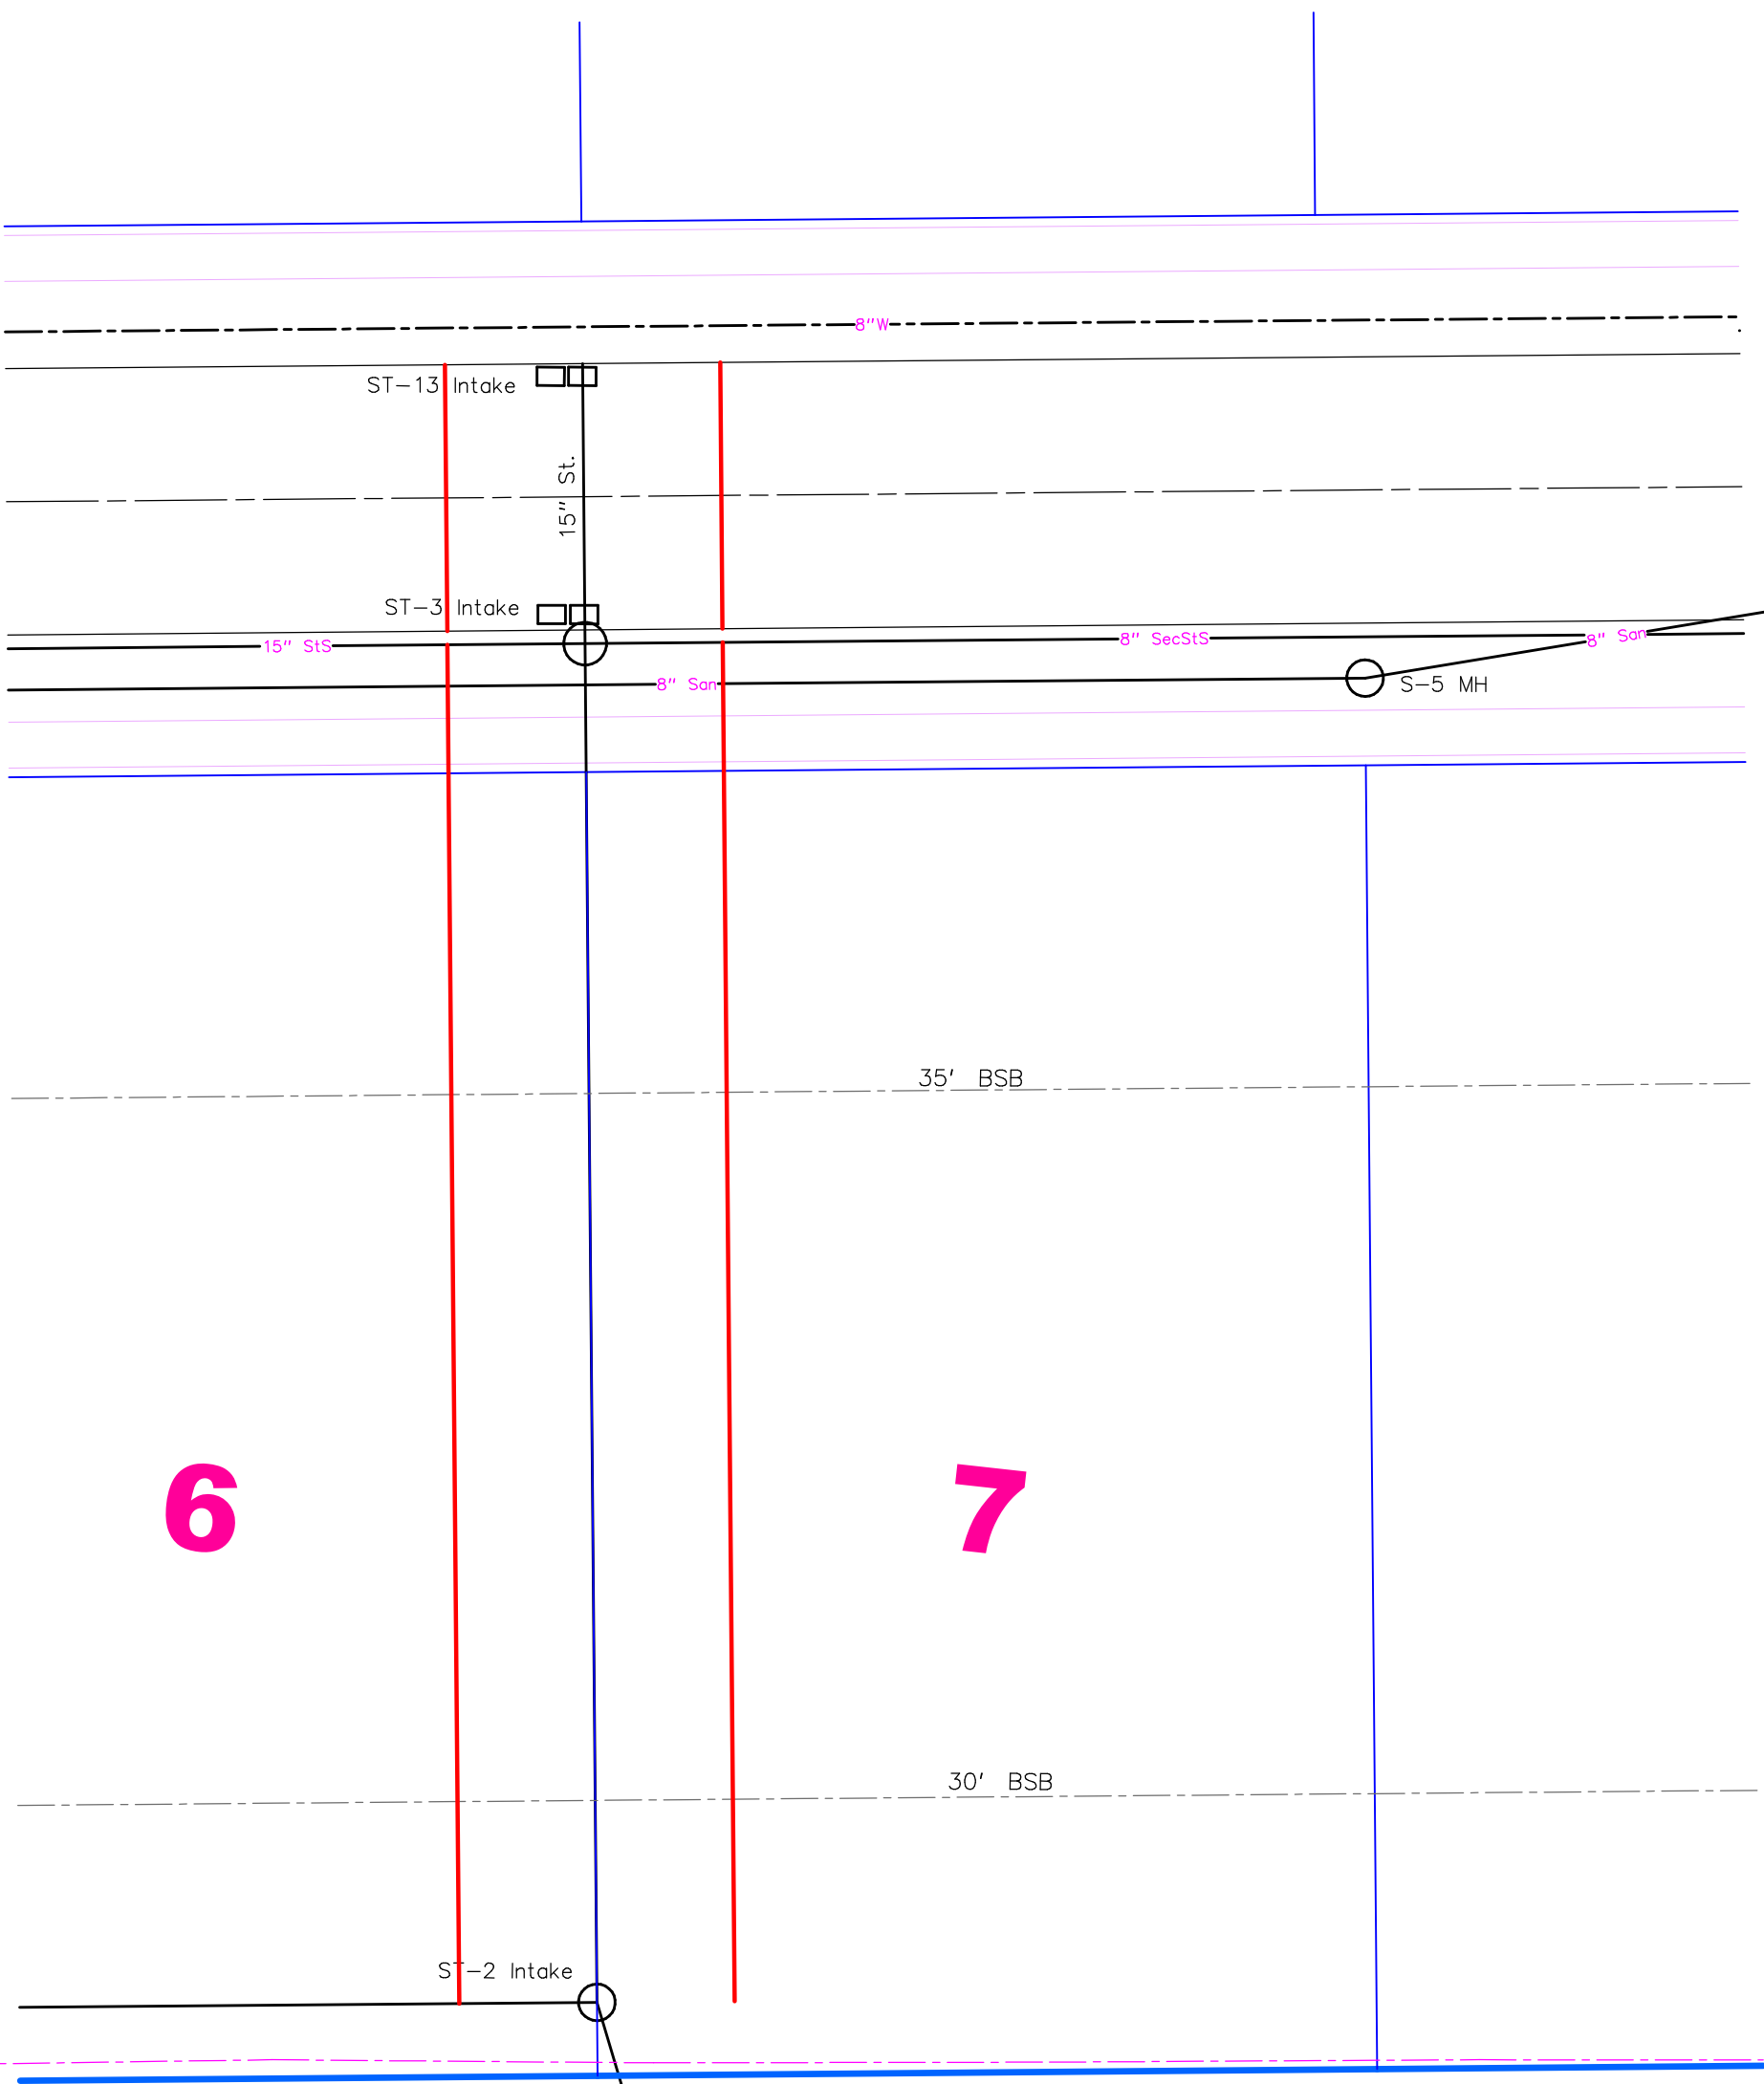

A & L Bean Family Ltd. Partnership

NOTE: TIE ALL JOINTS BETWEEN ST-1 AND ST-2.

Class E (12 inch) Revetment Stone (50 Tons), Underlay with Engineering Fabric

Existing Pond: to be used for Detention Basin


100-Year High Water Level = 985.24

Install Portland or Aquablock over 100 feet beyond the disturbed area and installation be in accordance with the manufacturer's recommendations.

Minimum Existing Pond Outfall as Emergency Overflow Elev. = 985.4








1' x 8' x 10' (5 Tons) Stone with Engineering Fabric

Head Wall for Annular or Spiral CM Pipe per NBCS Standard DWG. A-1211.

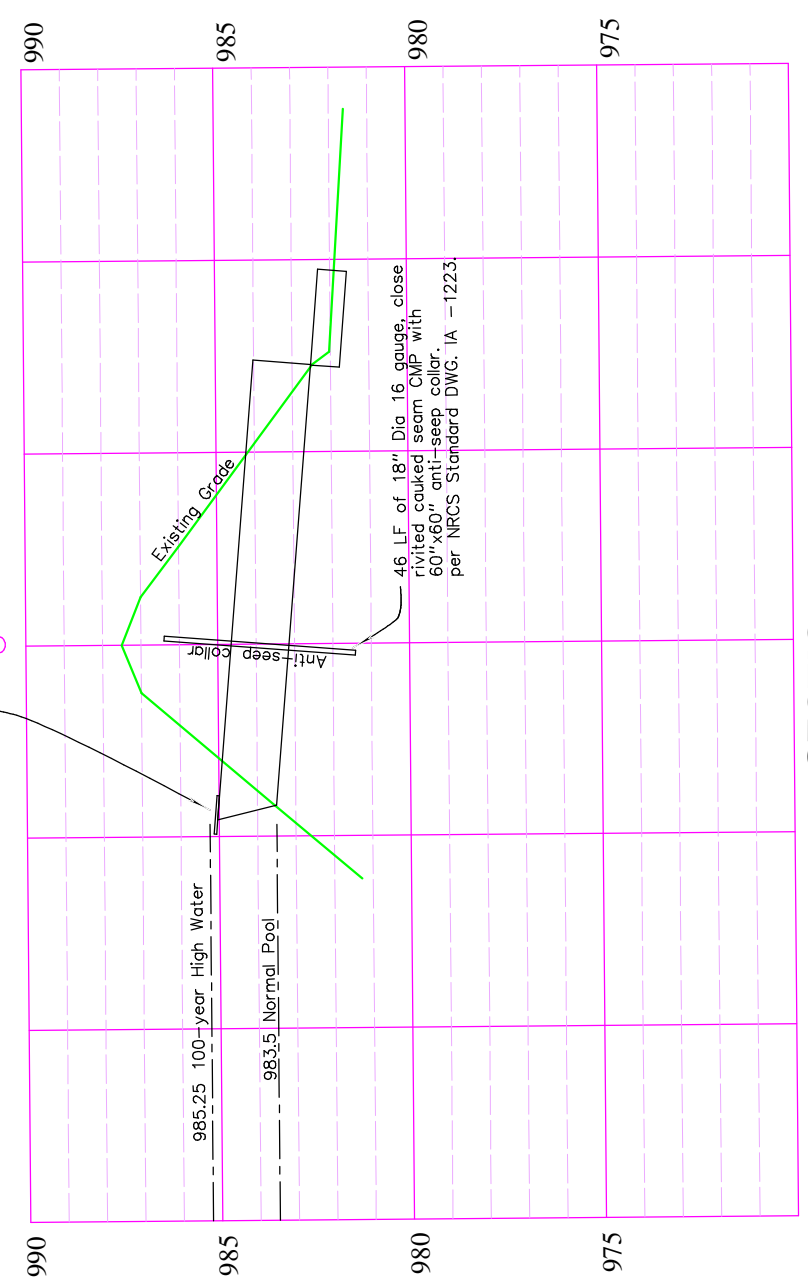

SECTION A-A

Scale: 1"=20' Vertical

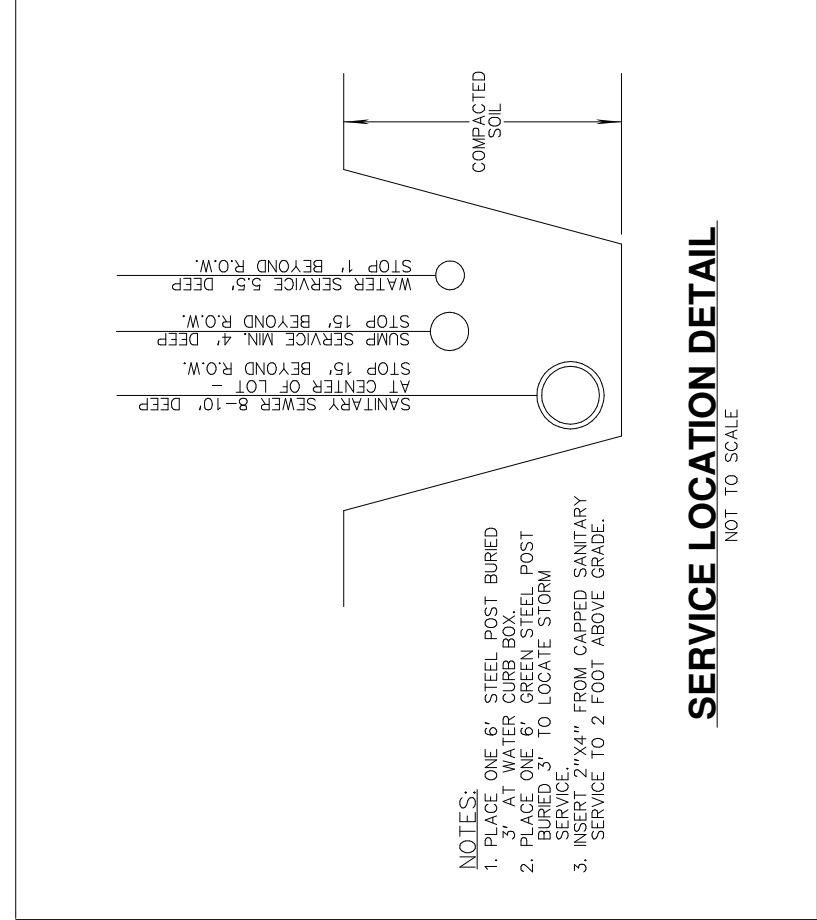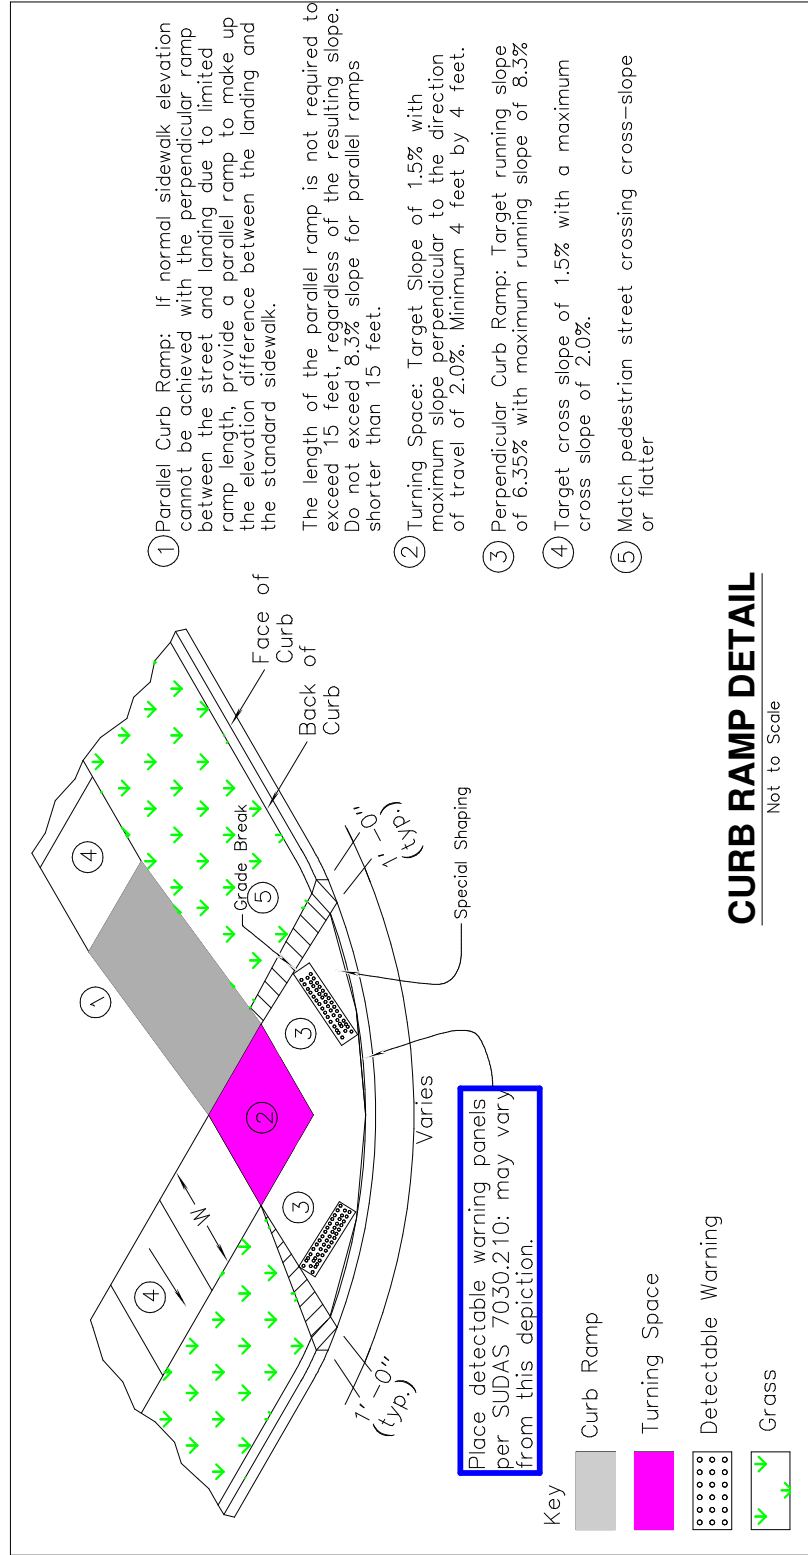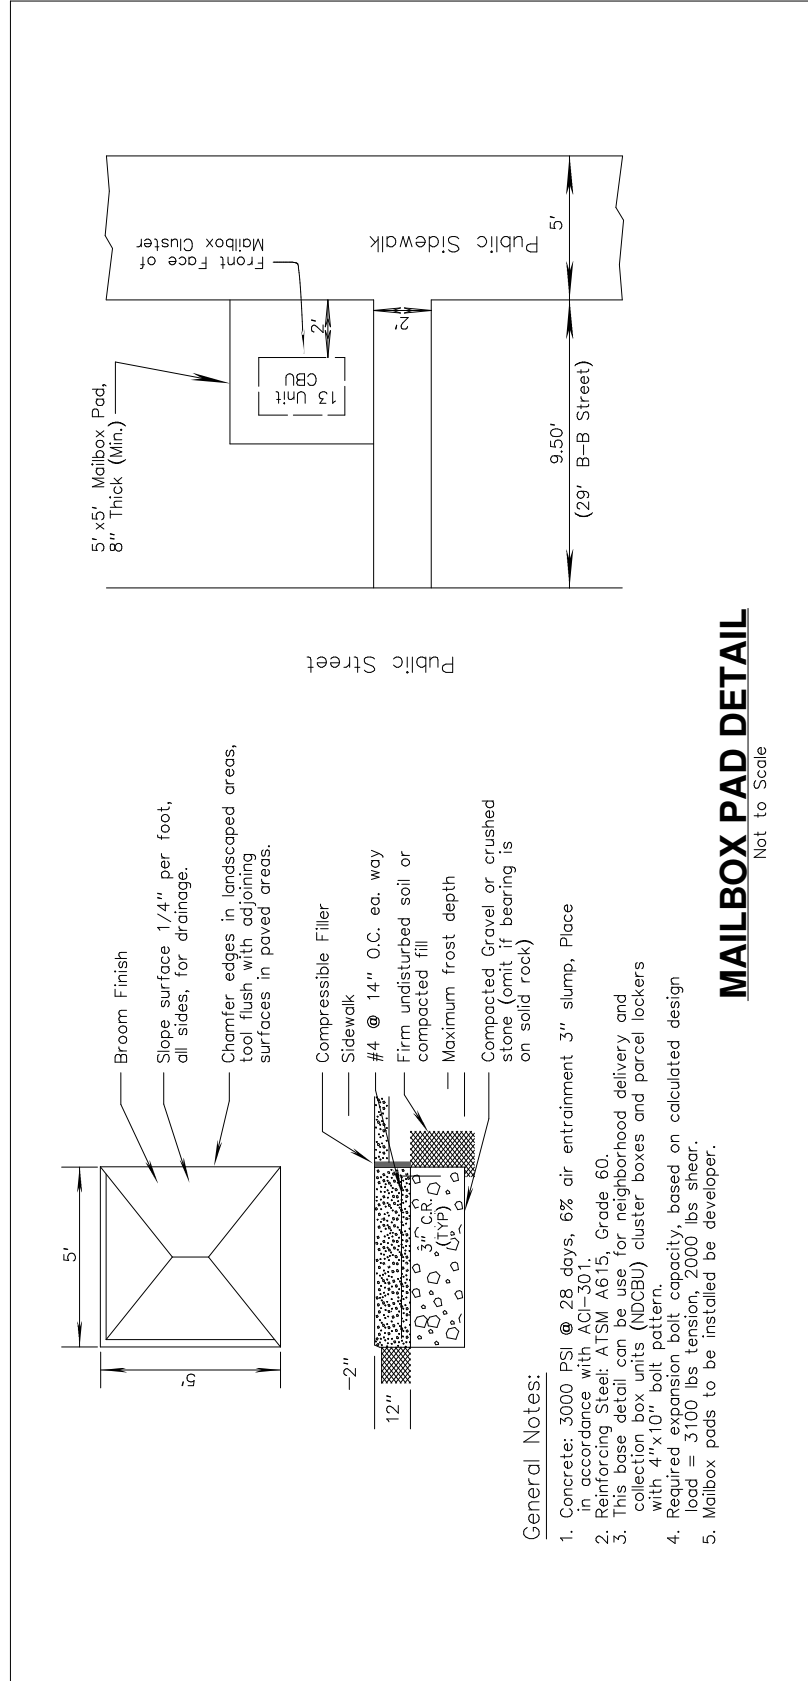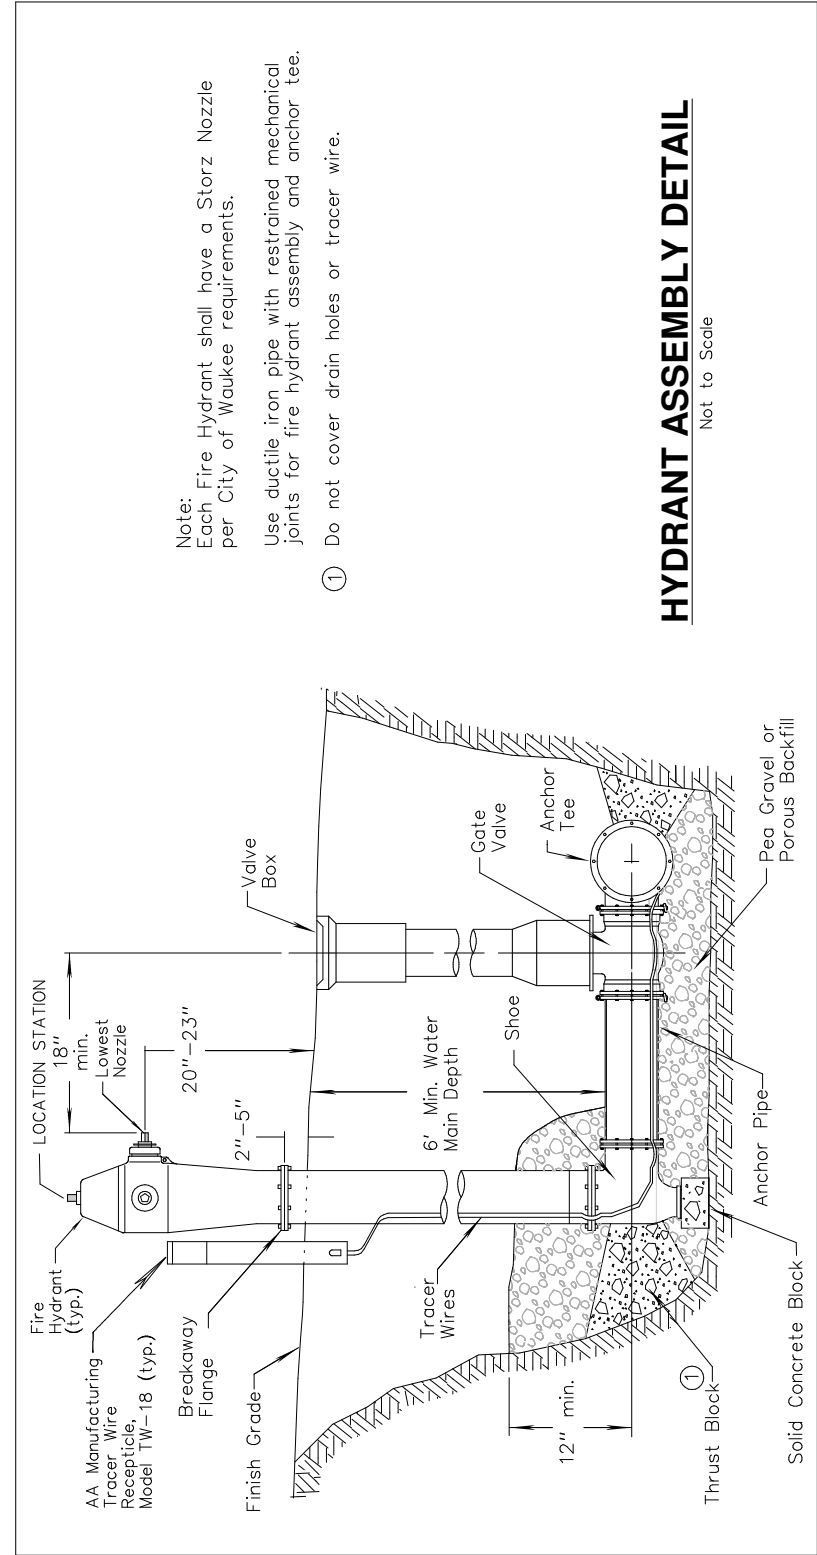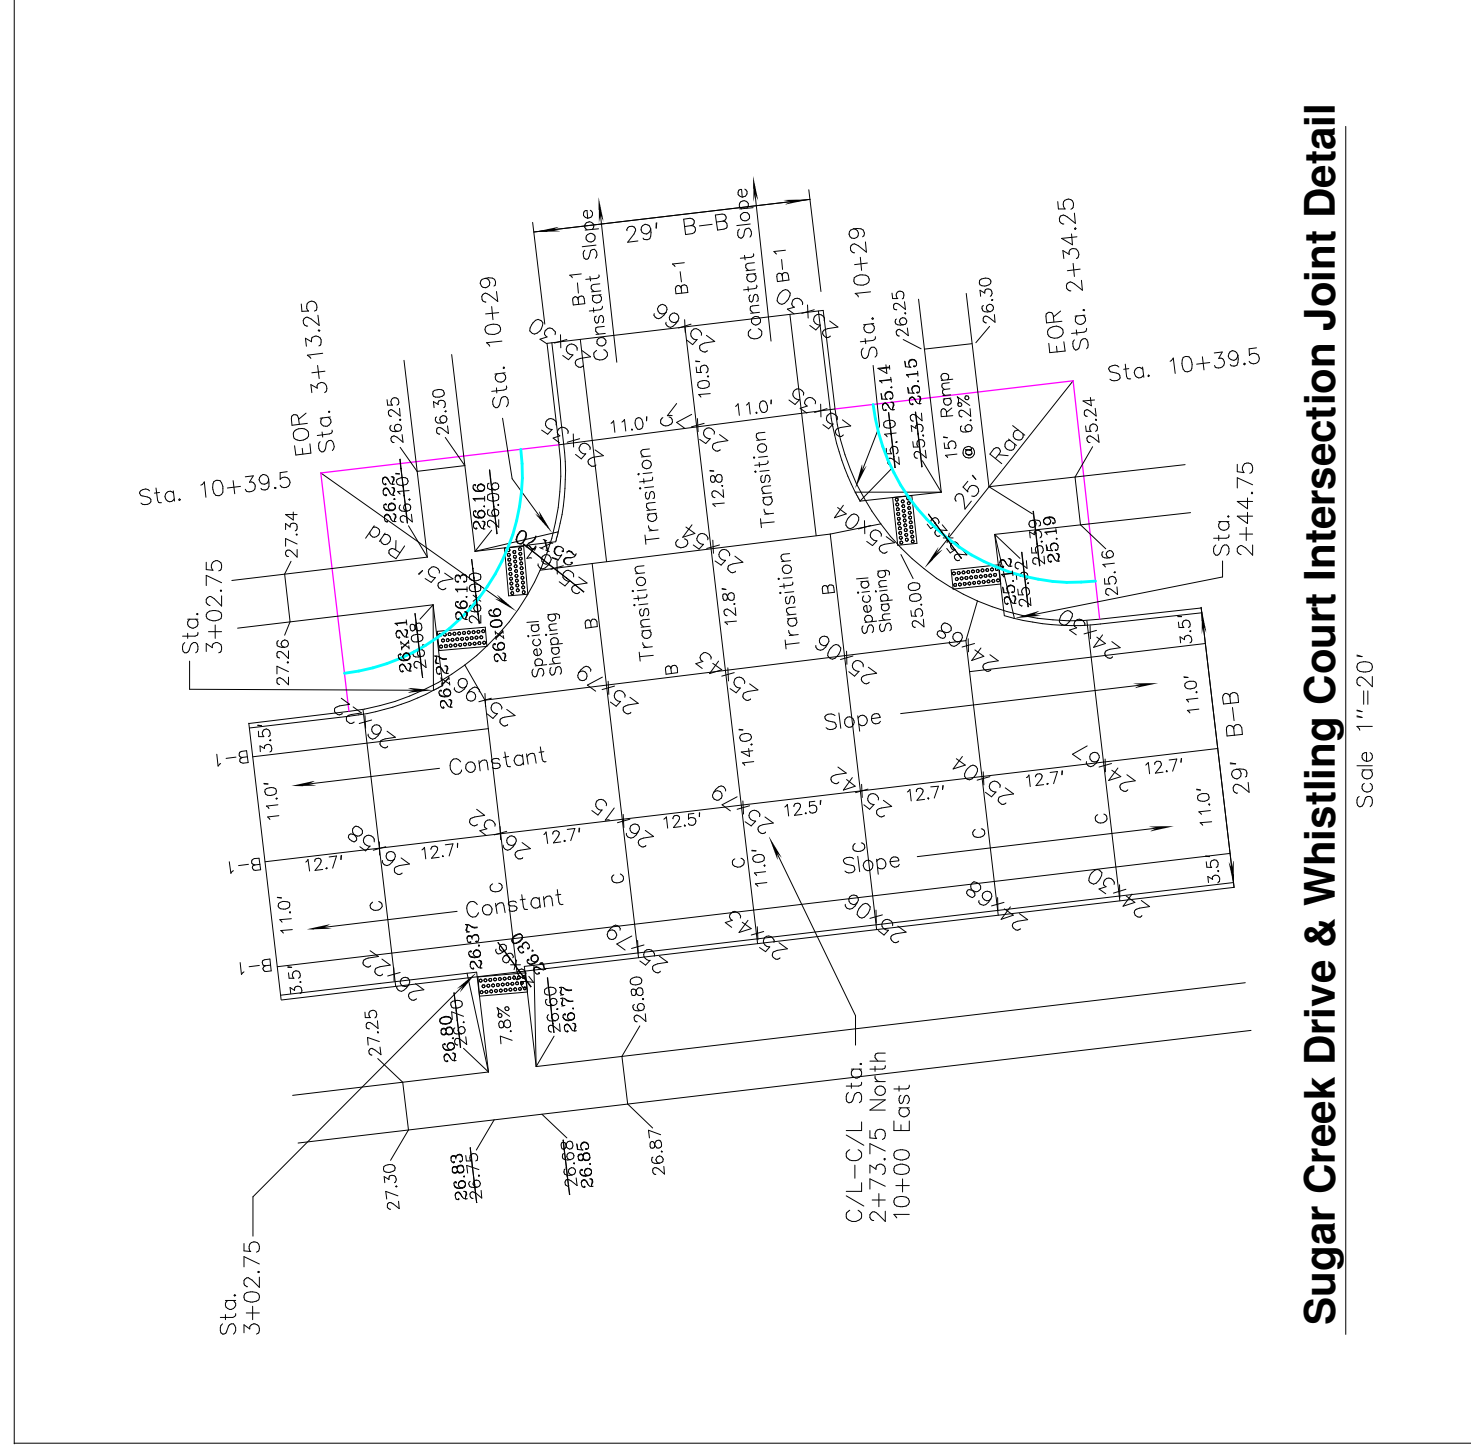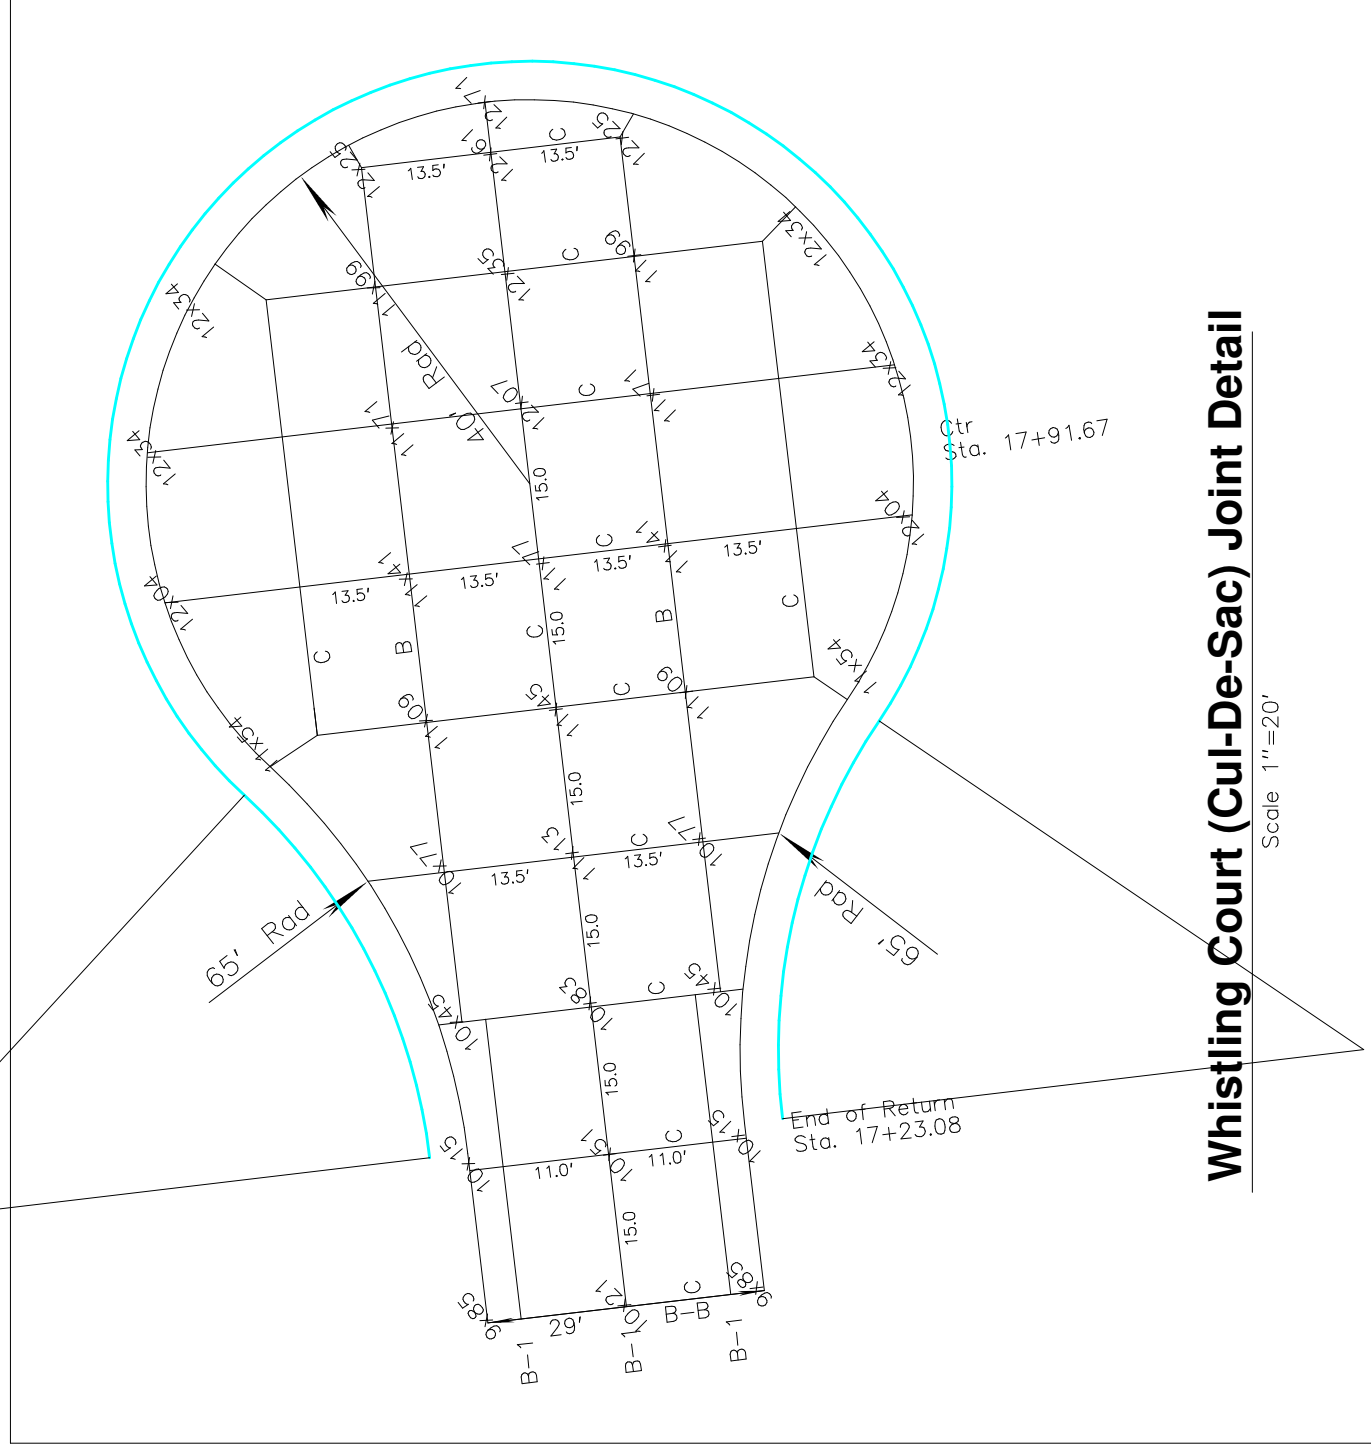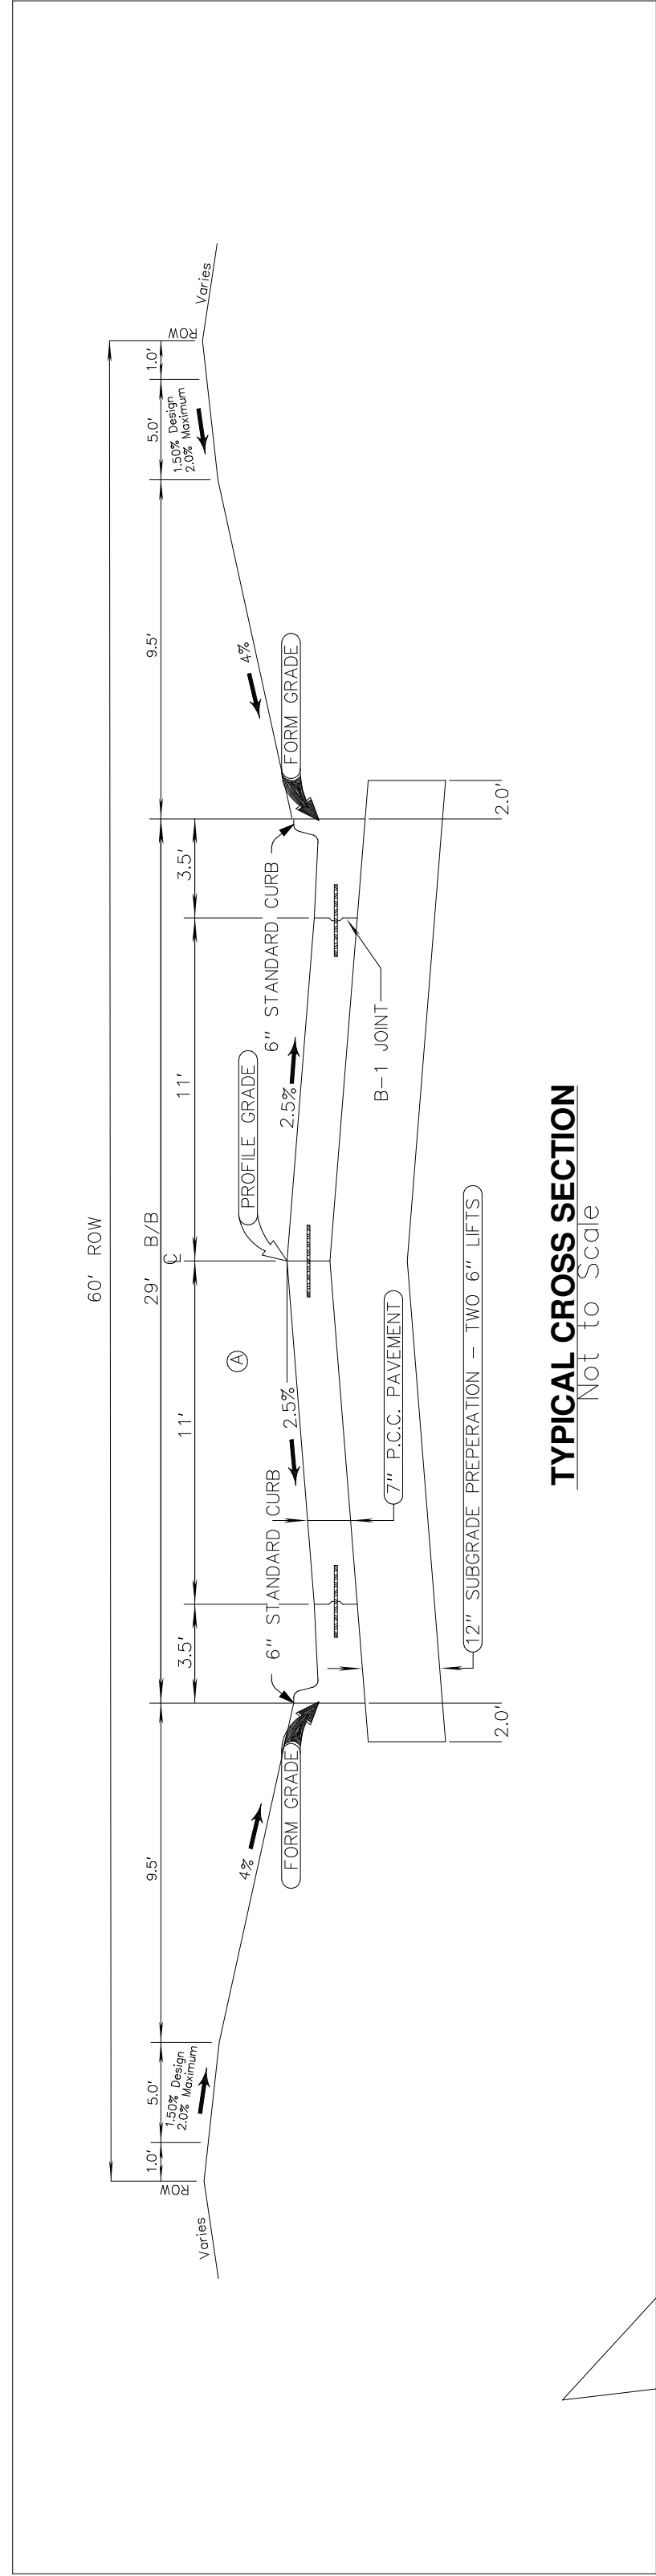












SUDAS DETAIL REFERENCES*


Figure	Title
7010.904	Paving
PW 101	Typical Jointing Layout
7010.102	PCC Curb Details
Storm Sewer	
6010.501	Single Grate Intake
6010.502	Single Grate Intake with Manhole
6010.503	Double Grate Intake
6010.505	Double Grate Intake with Manhole
6010.506	Coatings for Storm Sewer Manholes
6010.602	Coatings for Grate Intakes
6010.603	Box-outs for Grate Intakes
6010.514	Circular Storm Sewer Manhole
6010.401	Subdrain Clean-outs
6010.232	Subdrain Outlets
6010.233	RCP Apron Section Footing
6030.221	
Sanitary Sewer	
6010.301	Circular Sanitary Manhole (48" Dia.)
6010.306	Sanitary Sewer Service Stub
6010.201	Coatings for Sanitary Sewer Manholes
6010.601	SW-601

Estimated Quantities*

Barthwork		34,000 CY
<u>Pavement</u>		
6" RCP w/ Curb & Gutter	4,115 SY	
6" RCP Sidewalk Approaches	26 SY	
Detectable Warning Panels	2 Each	
Concrete Curb, Walks & C&Bs	1 Each	
Barricade relocation		
<u>Sanitary Sewer</u>		
Manholes (48" Dia.)	4 EA	10 EA
Manhole Drop Connection	25 EA	
Dis. Service Laterals (SR 23.5)		
3" gravity Saver (PVC Hous)	1,559 LF	1,952 LF
<u>Storm Sewer</u>		
15" RCP Storm Sewer	1,122 LF	1,134 LF
18" RCP Storm Sewer	148 LF	48 LF
24" RCP Storm Sewer	4 EA	
24" Flared End Sections	46 LF	
18" Dia. Corrugated Metal Pipe w/ FES & Cols		
18" Dia. Inlet Manhole w/ grate	2 EA	
24" Dia. Inlet Manhole w/ grate	3 EA	
3" Storm Sewer	3 EA	
5" Single Grade Inlet	1 EA	
5" Single Grade Inlet with Manhole	1 EA	
5" Double Grade Inlet	1 EA	
5" Double Grade Inlet with Manhole	1 EA	
5" Open Sided Inlet	1 EA	
5" Secondary Storm Sewer (perforated) (conen 2006 (w esd))	744 LF	605 LF
3" Storm Sewer	25 EA	
1" Dia (SR 23.5) Sump Service Laterals		
** Length excludes Flared End Sections		
<u>Water</u>		
3" DR18 PVC Water Main* (G900)	1,450 LF	1,447 LF
3" Gate Valve	6 EA	
Fire Hydrant Assemblies	5 EA	
12" x 8" Tapping Valve & Sleeve	1 EA	
Service Laterals	25 EA	
8" x 8" x 18" Tee	4 EA	
All bends and fittings are incidental to main construction.		
<u>Flow Control</u>		
GLASS E REVEIMENT STONE	50 Ton	
PERGOL STONE	2,595 LF	
NET PROTECTION DEVICE	1 EA	

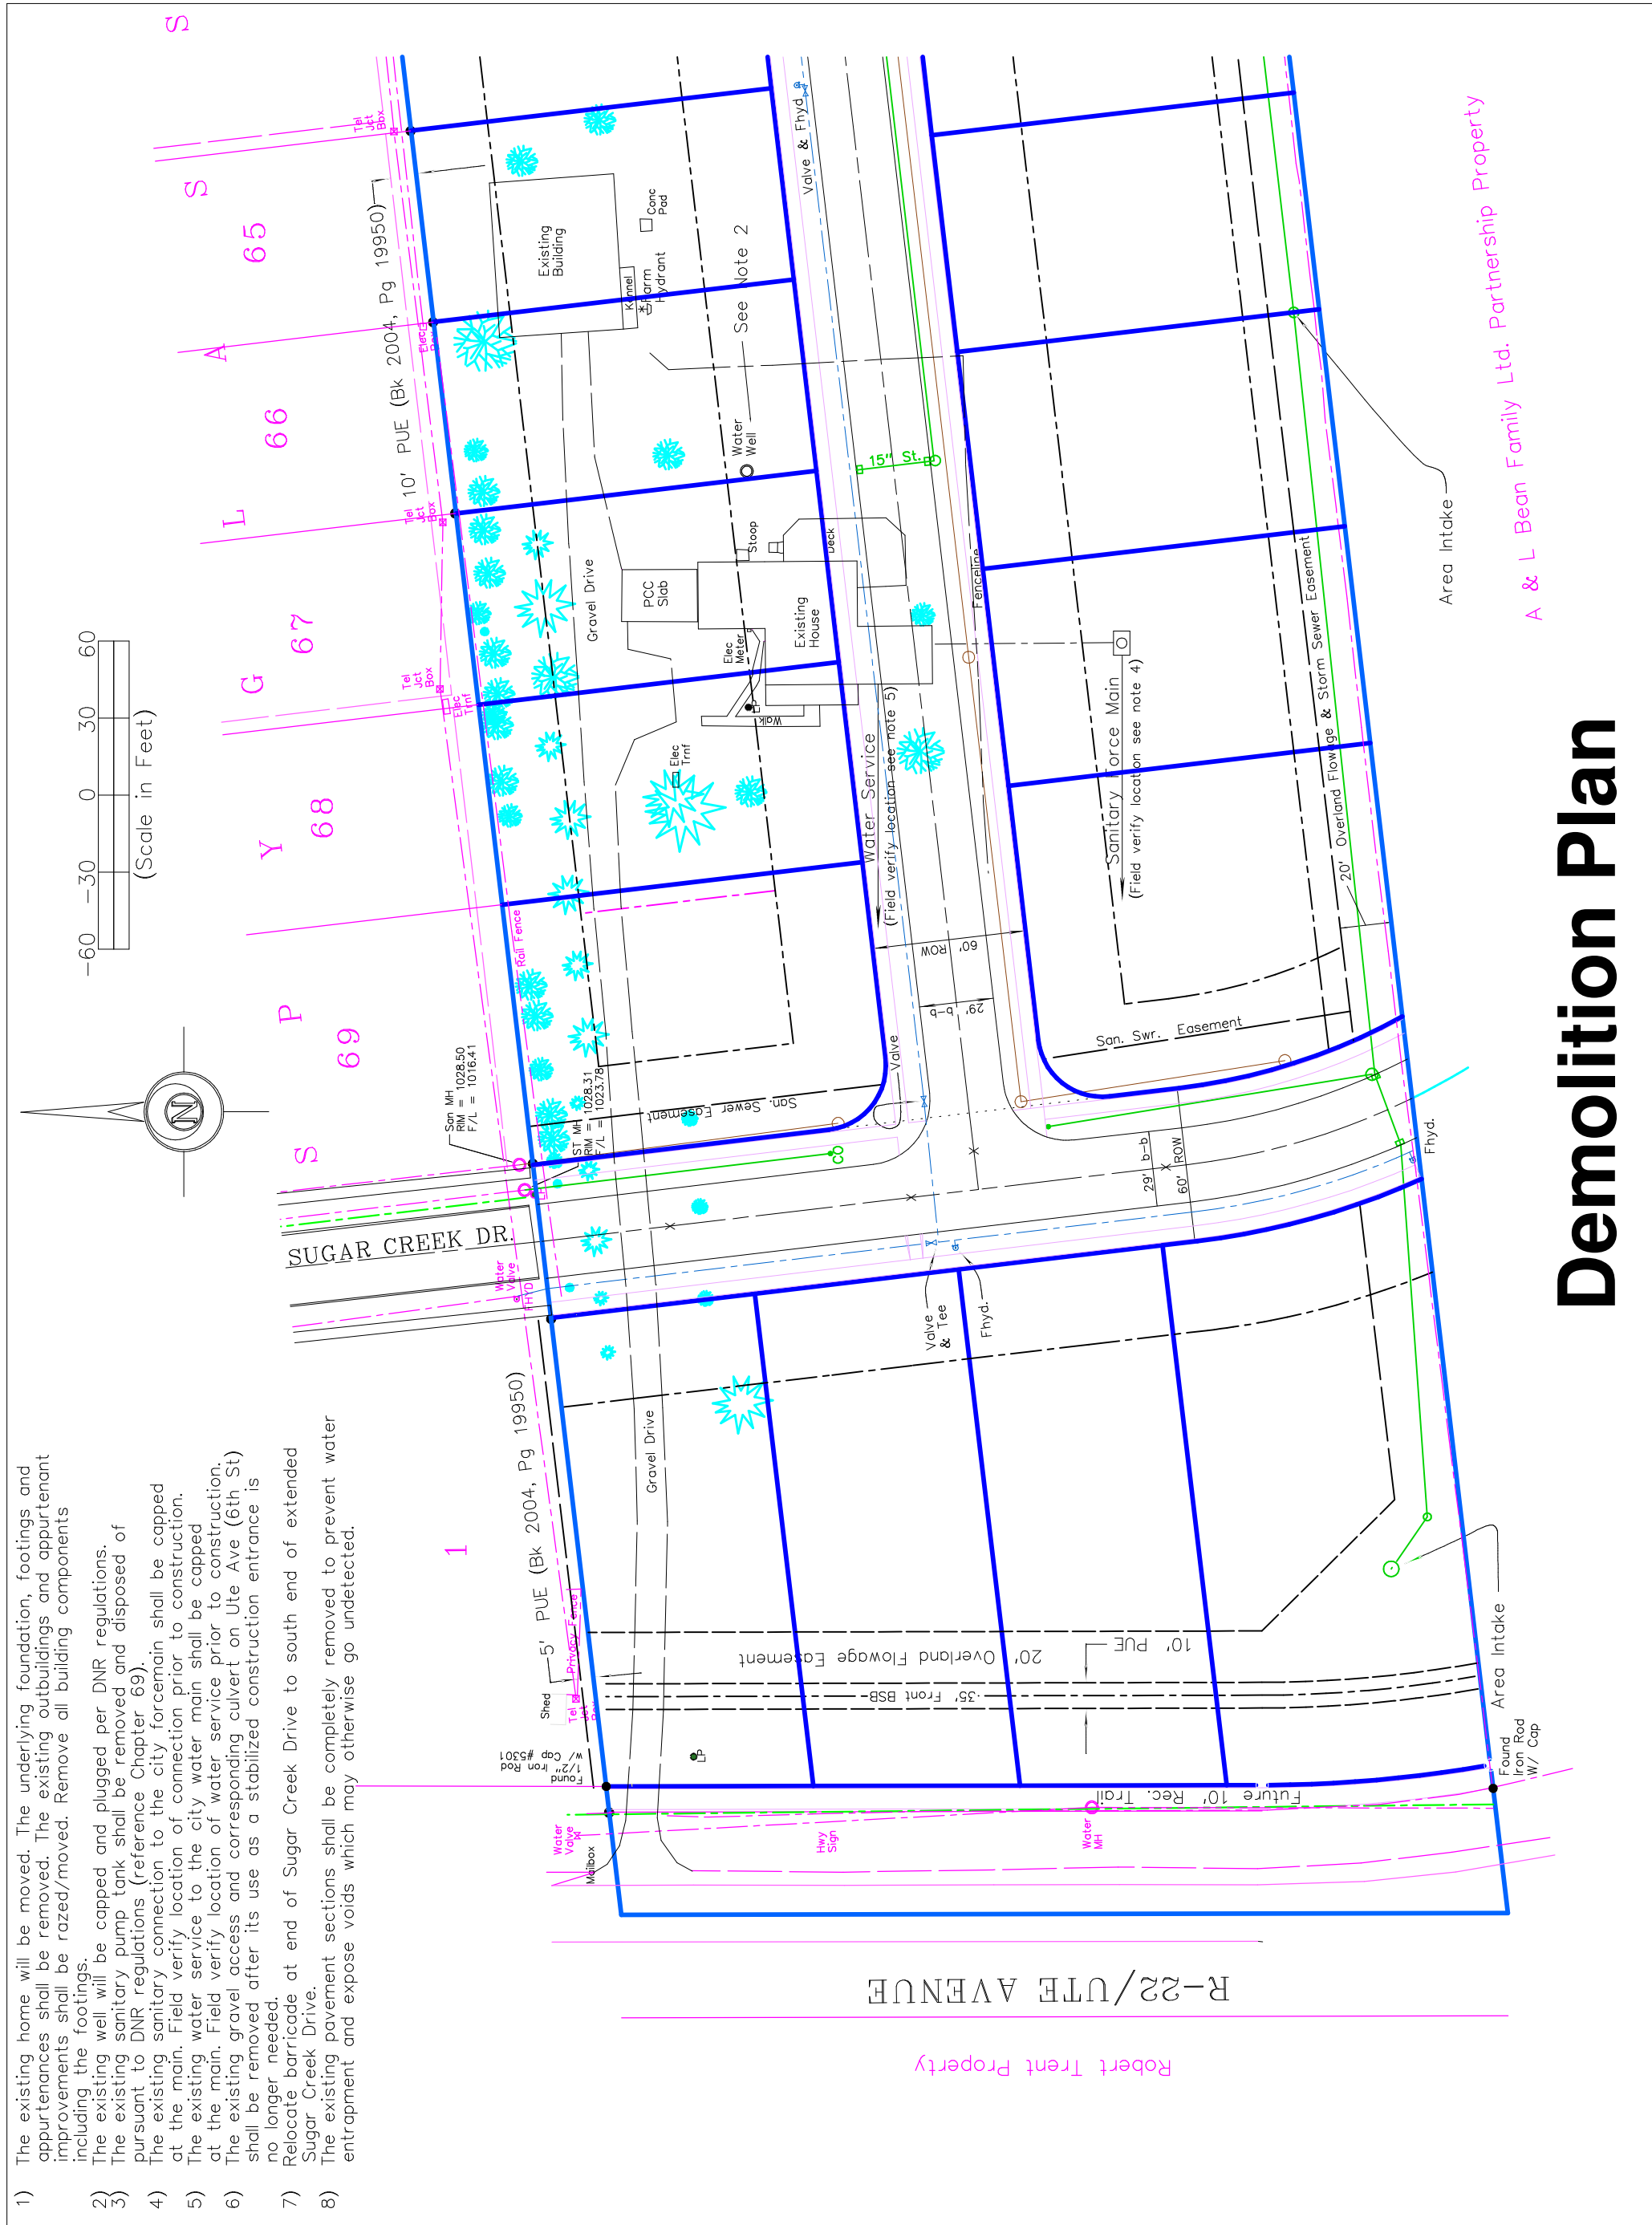

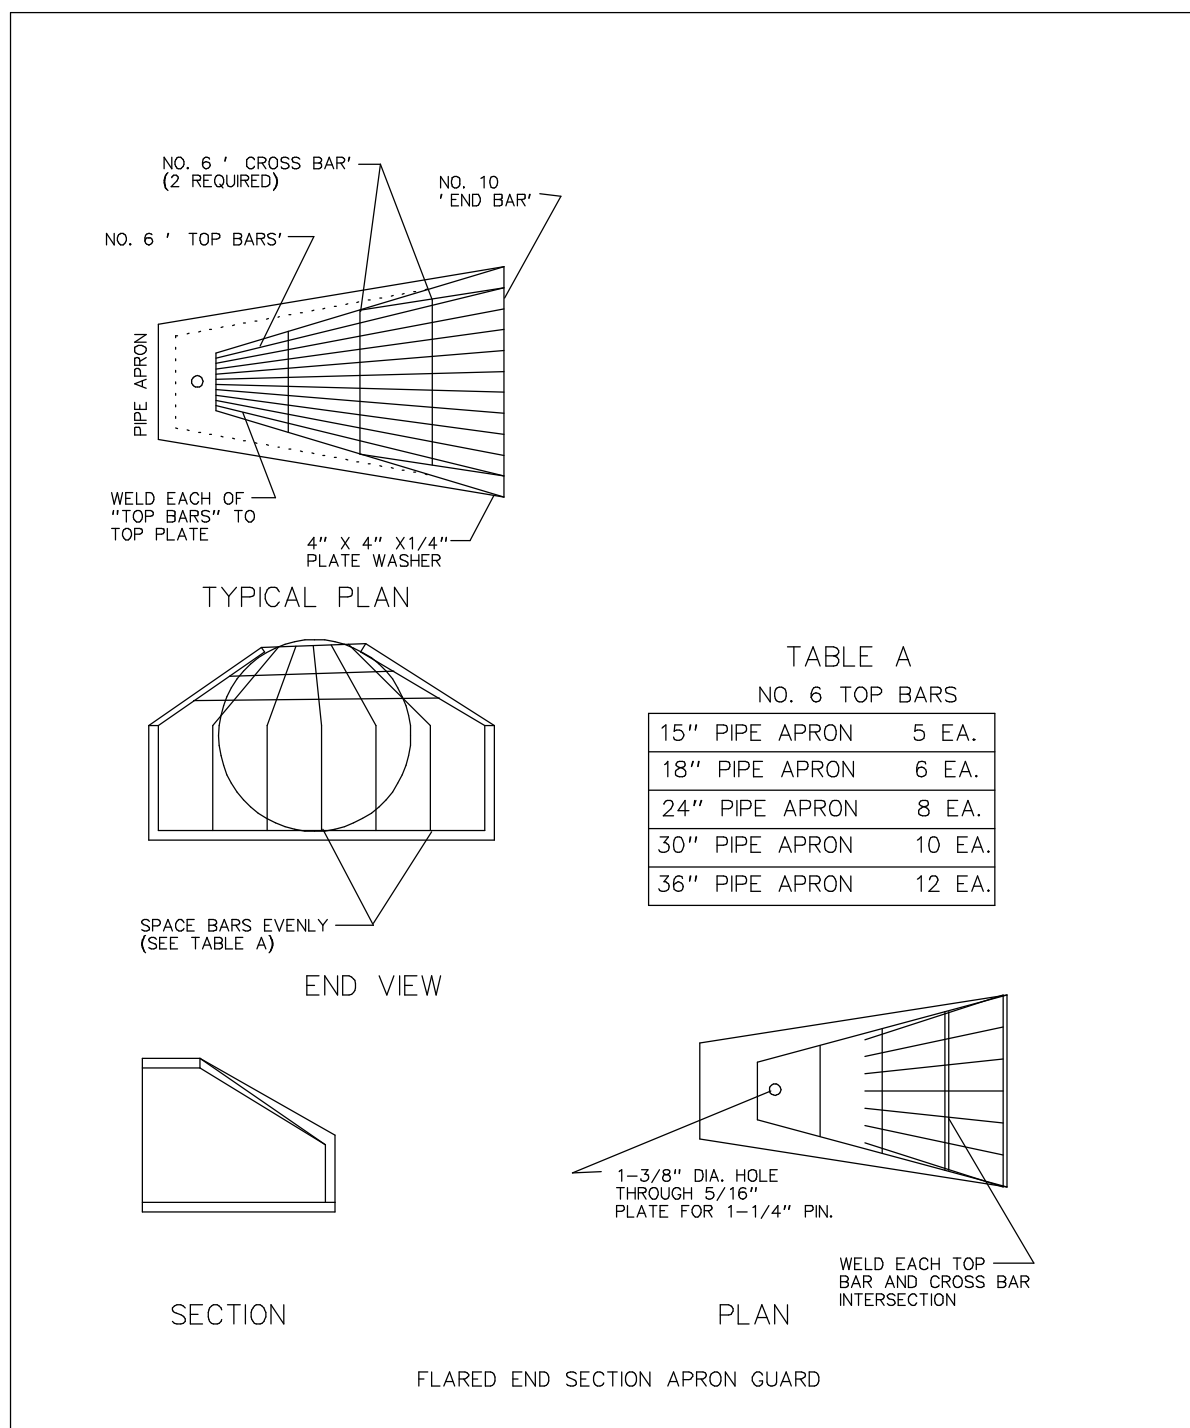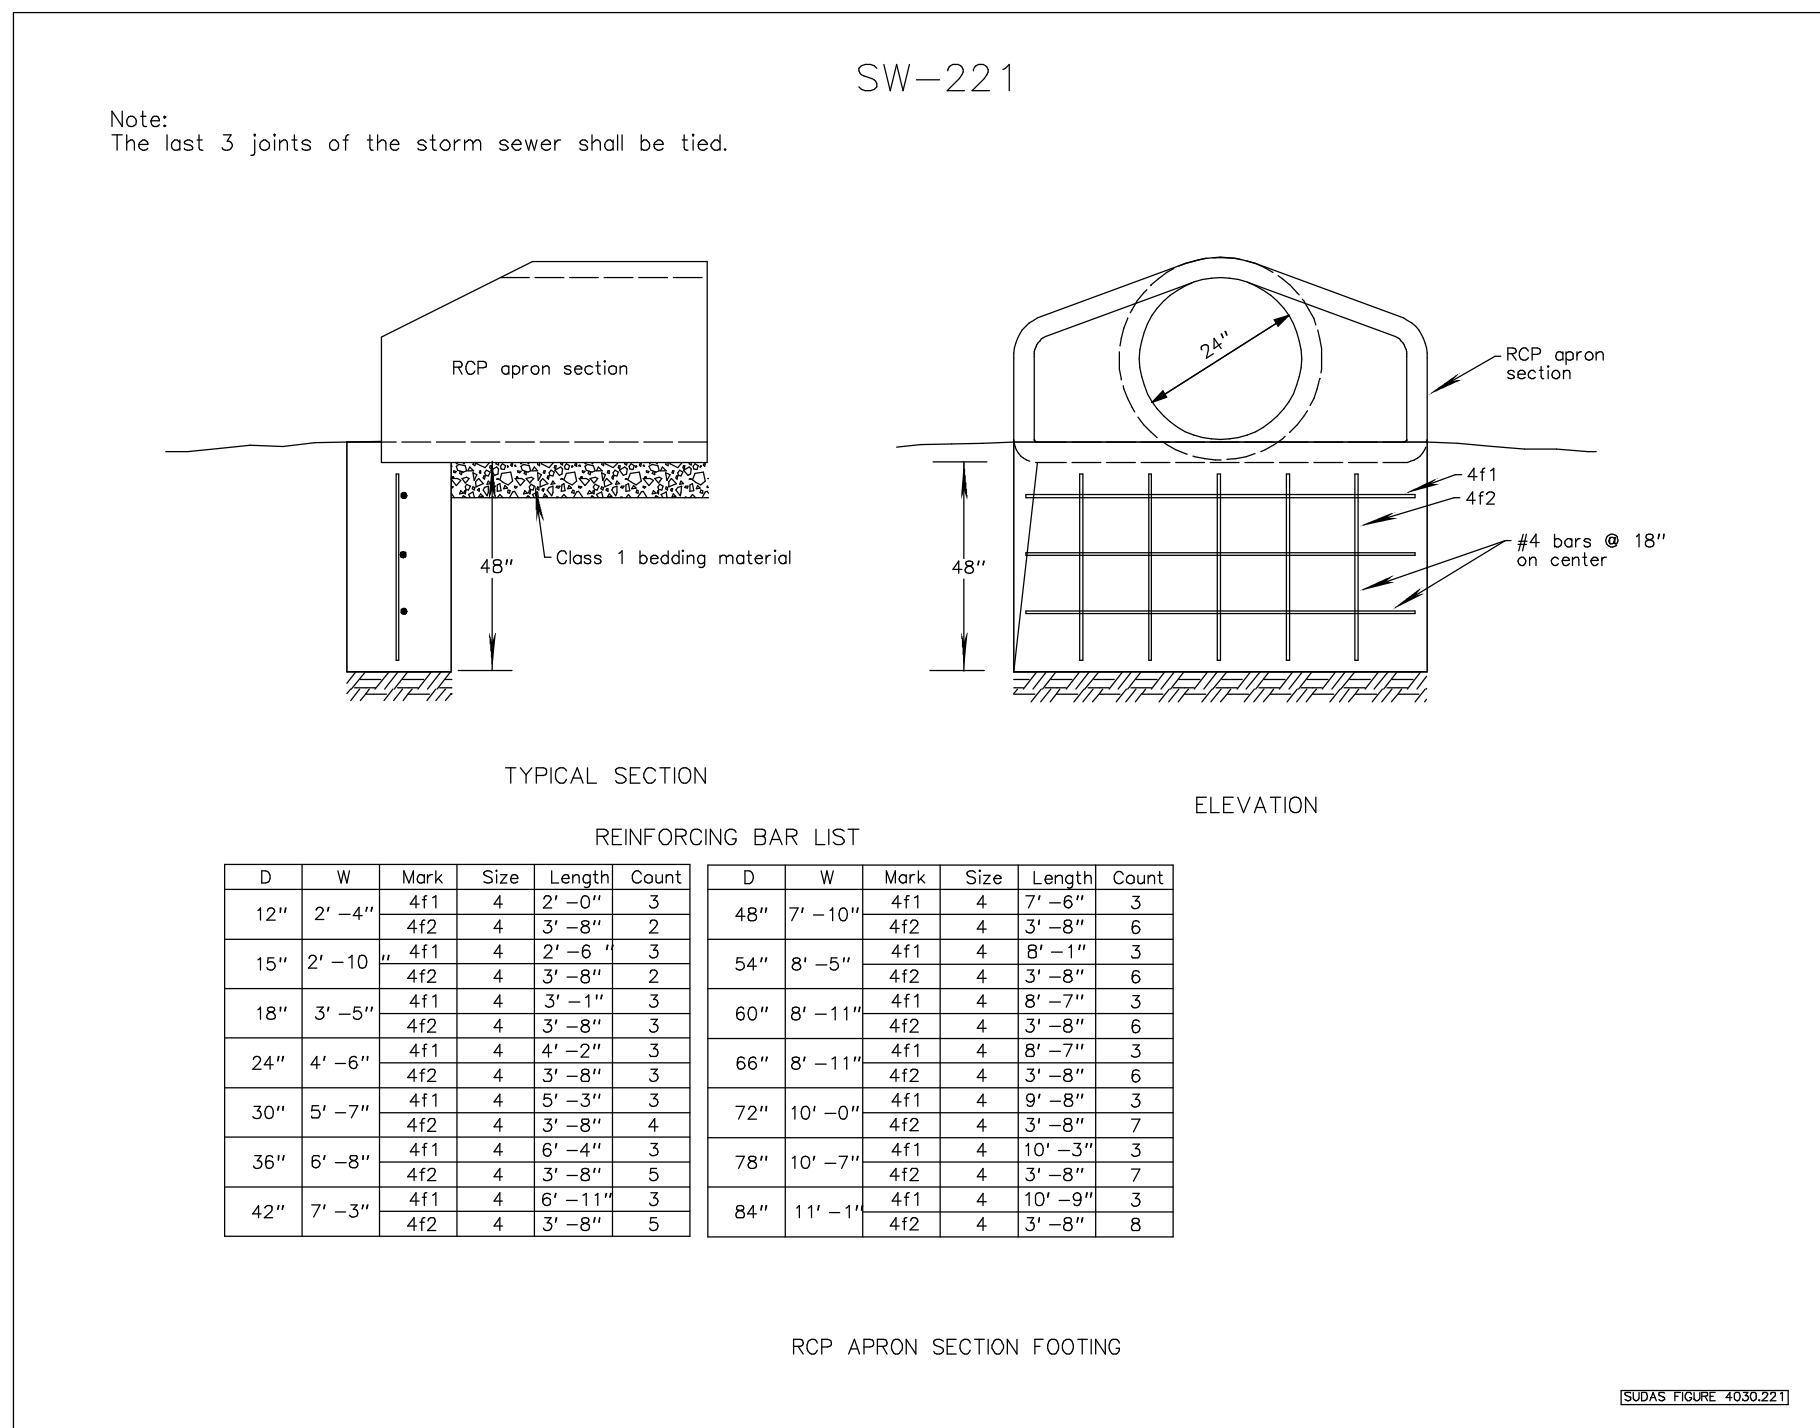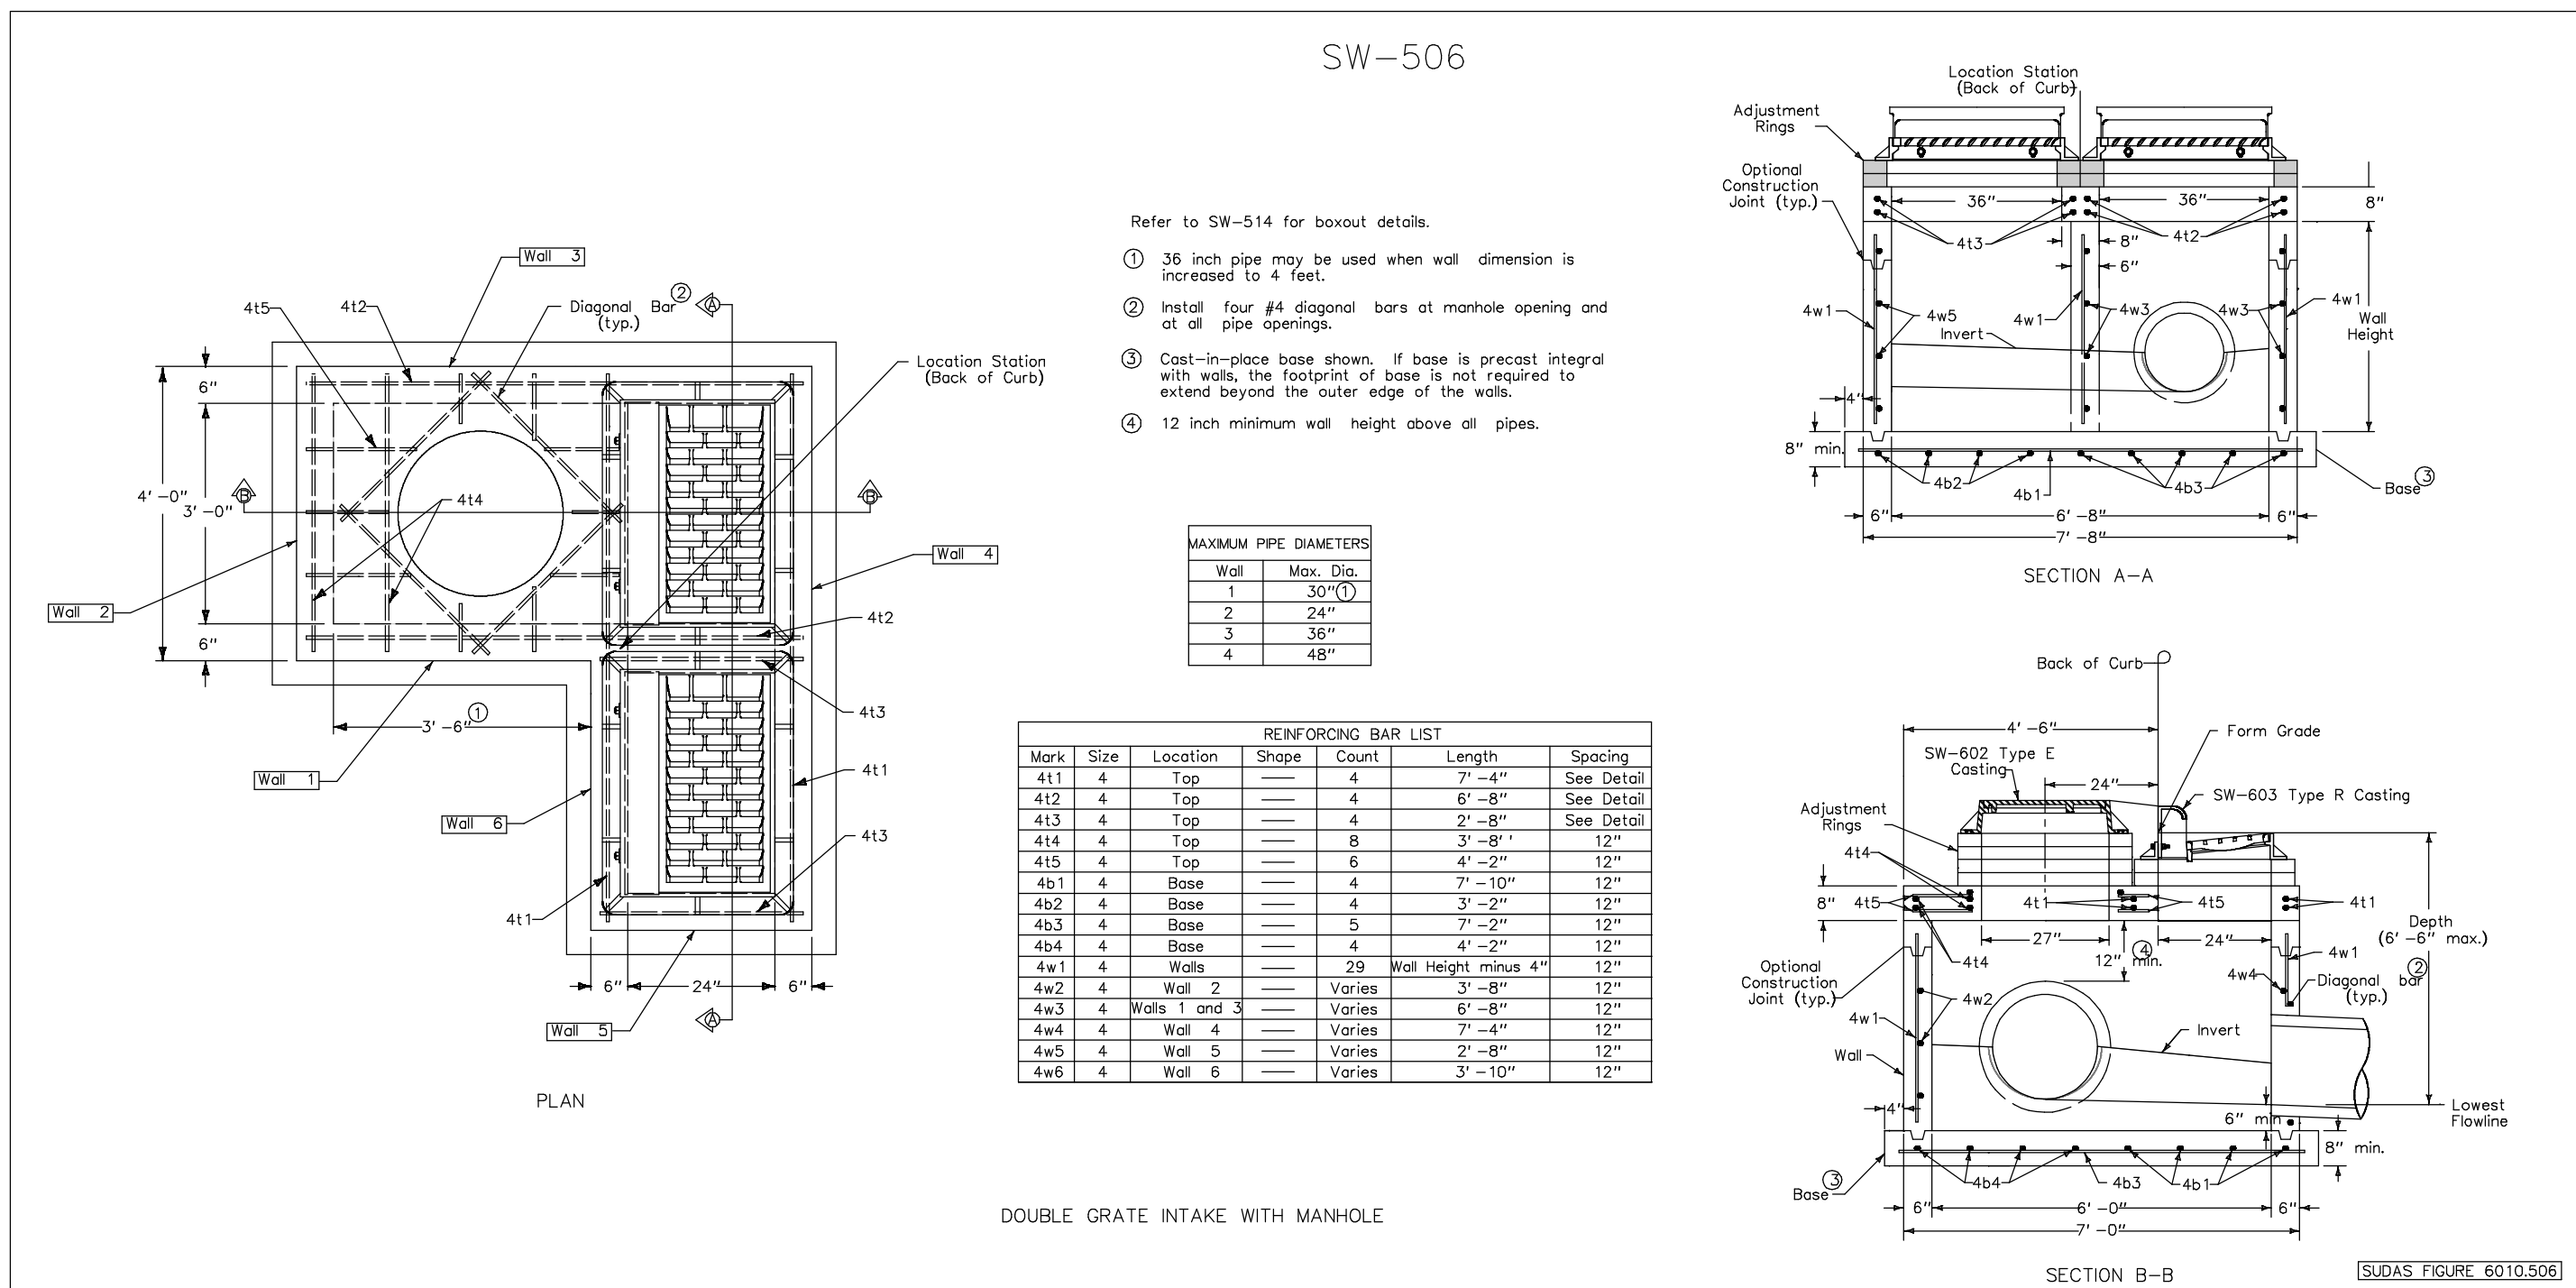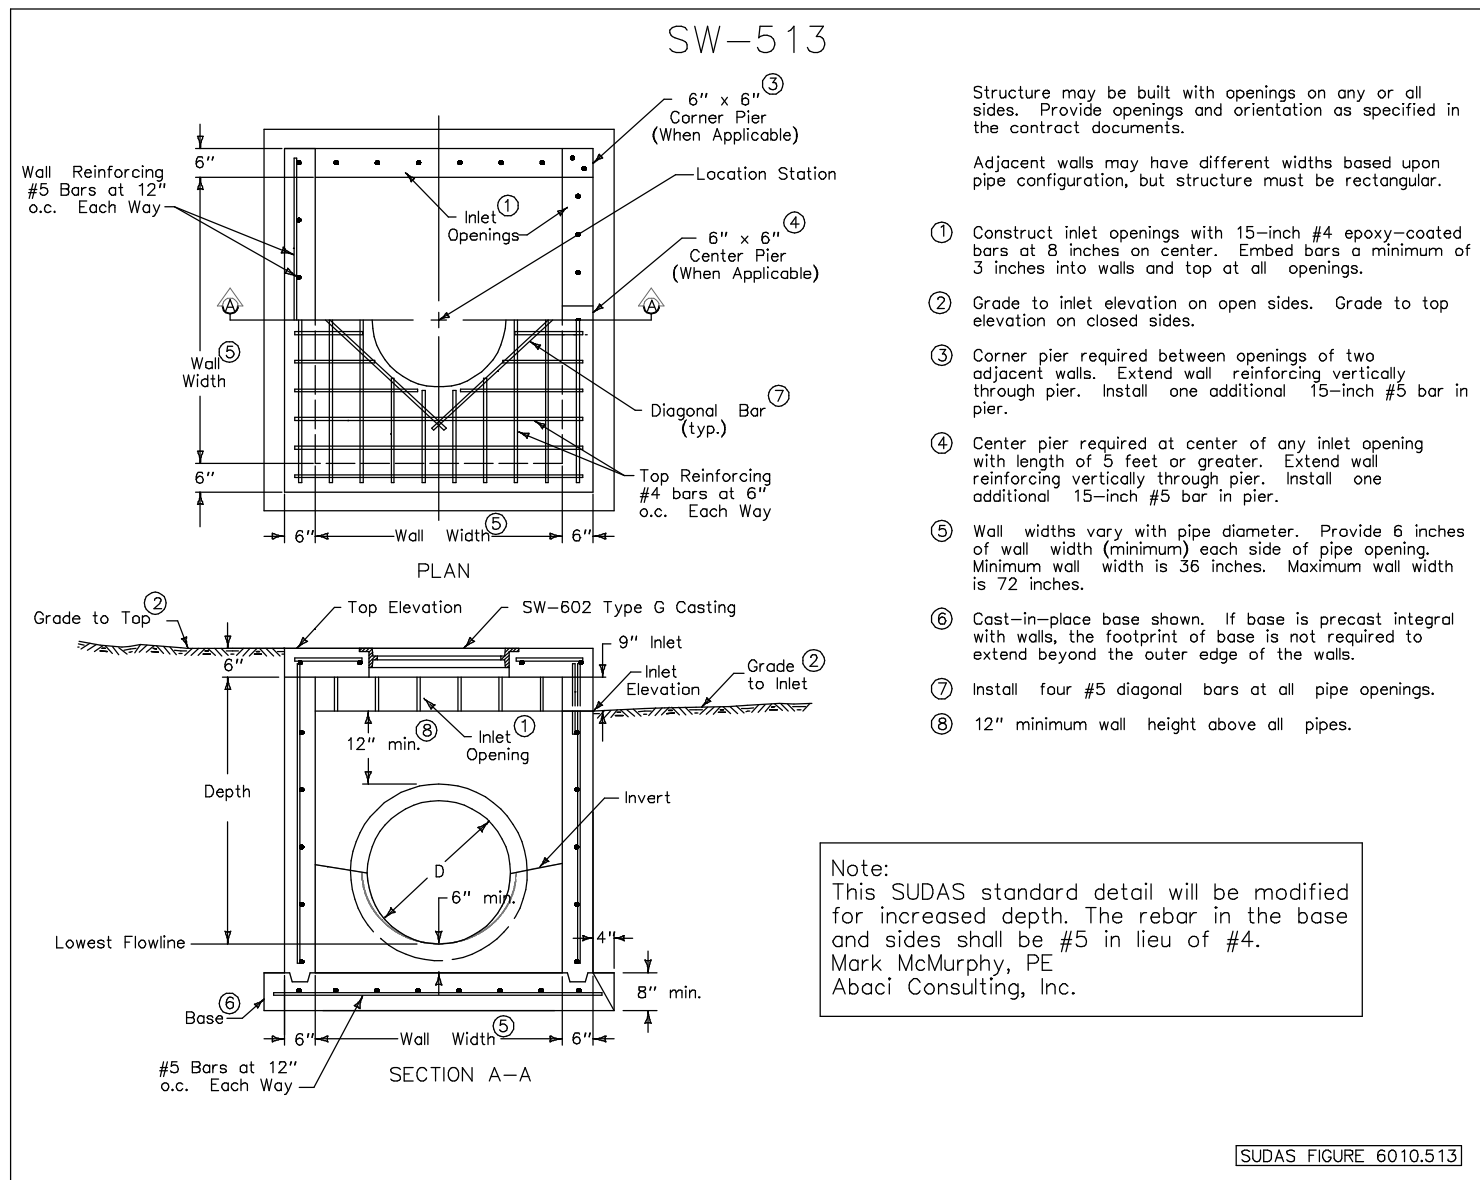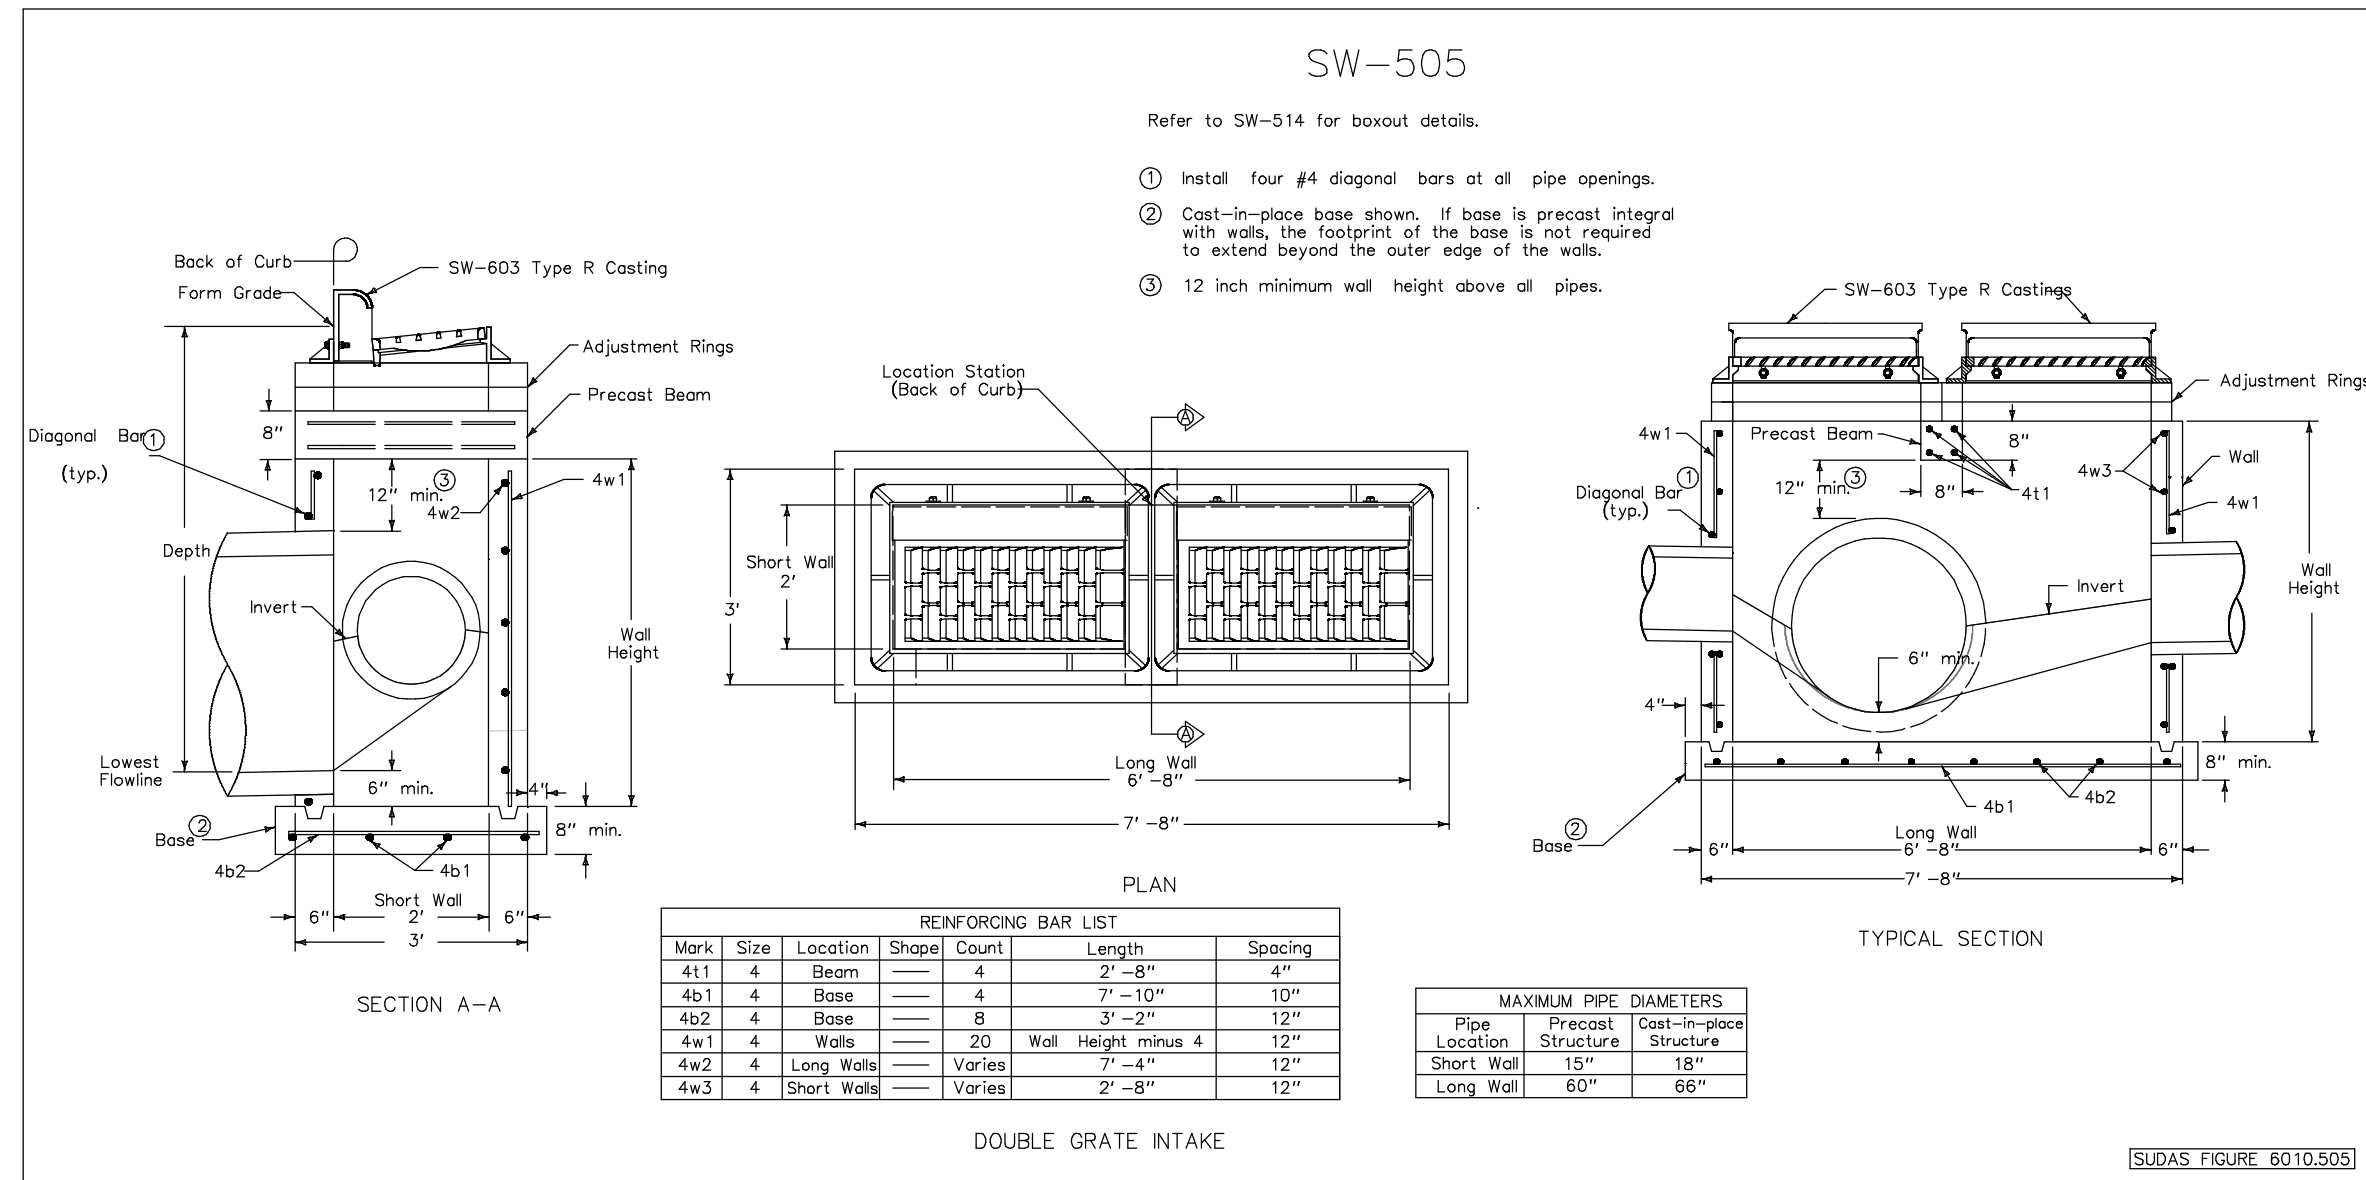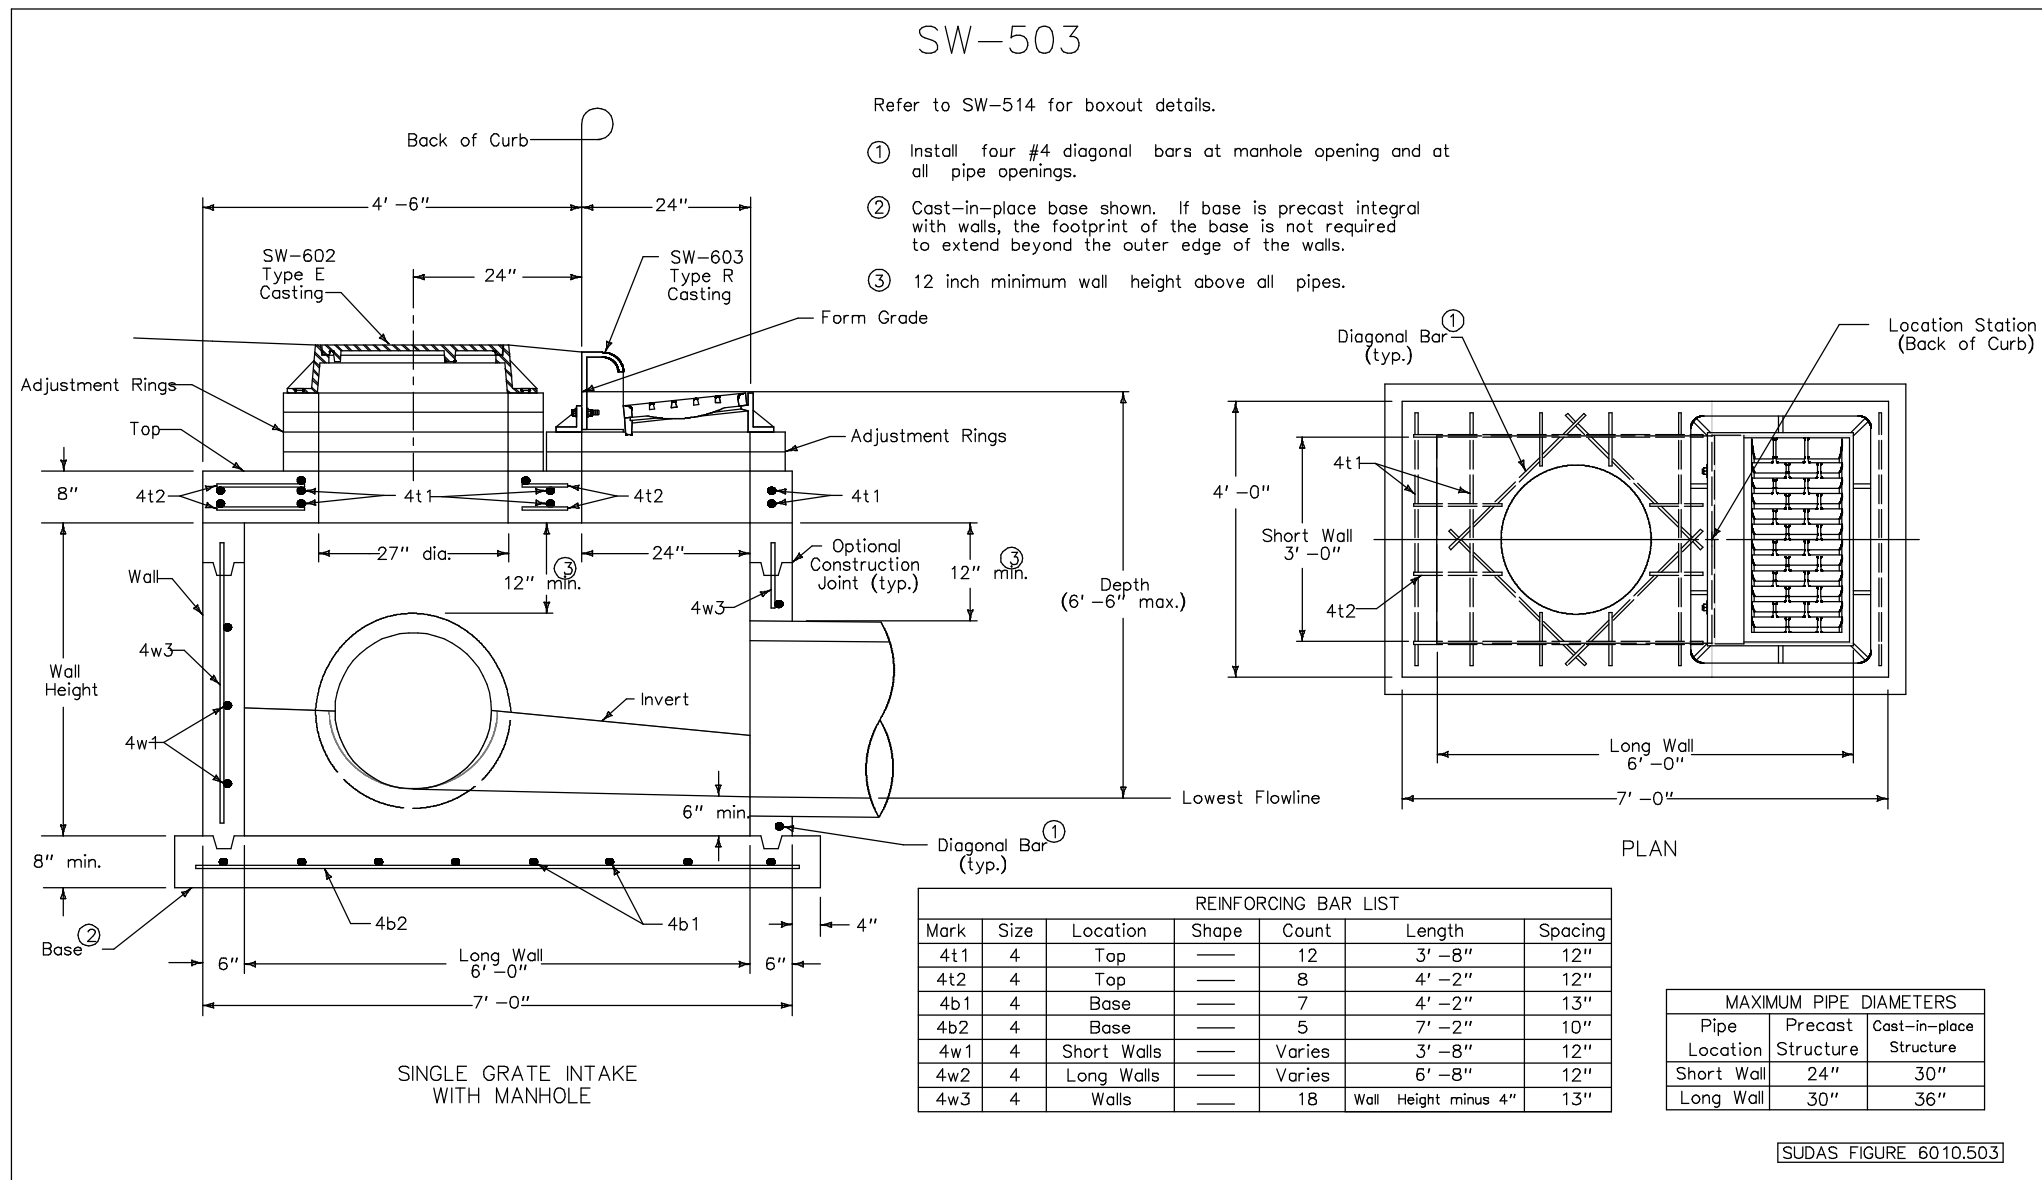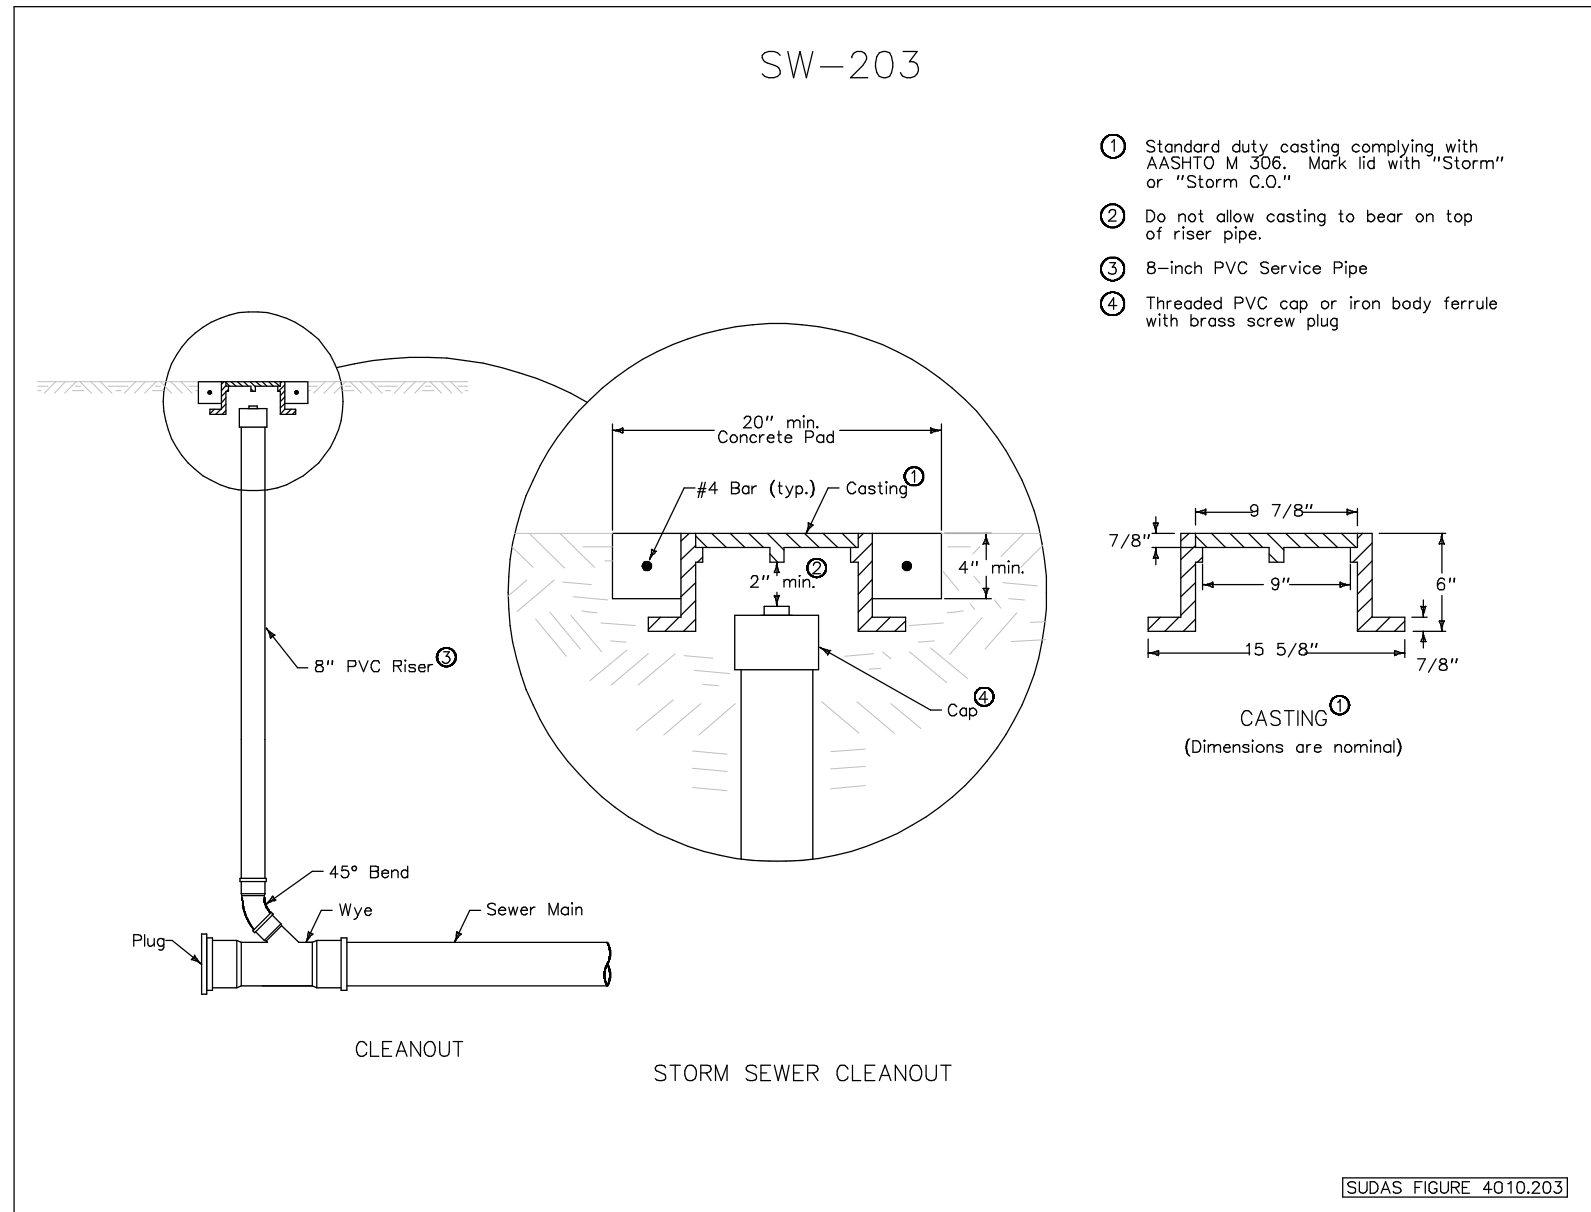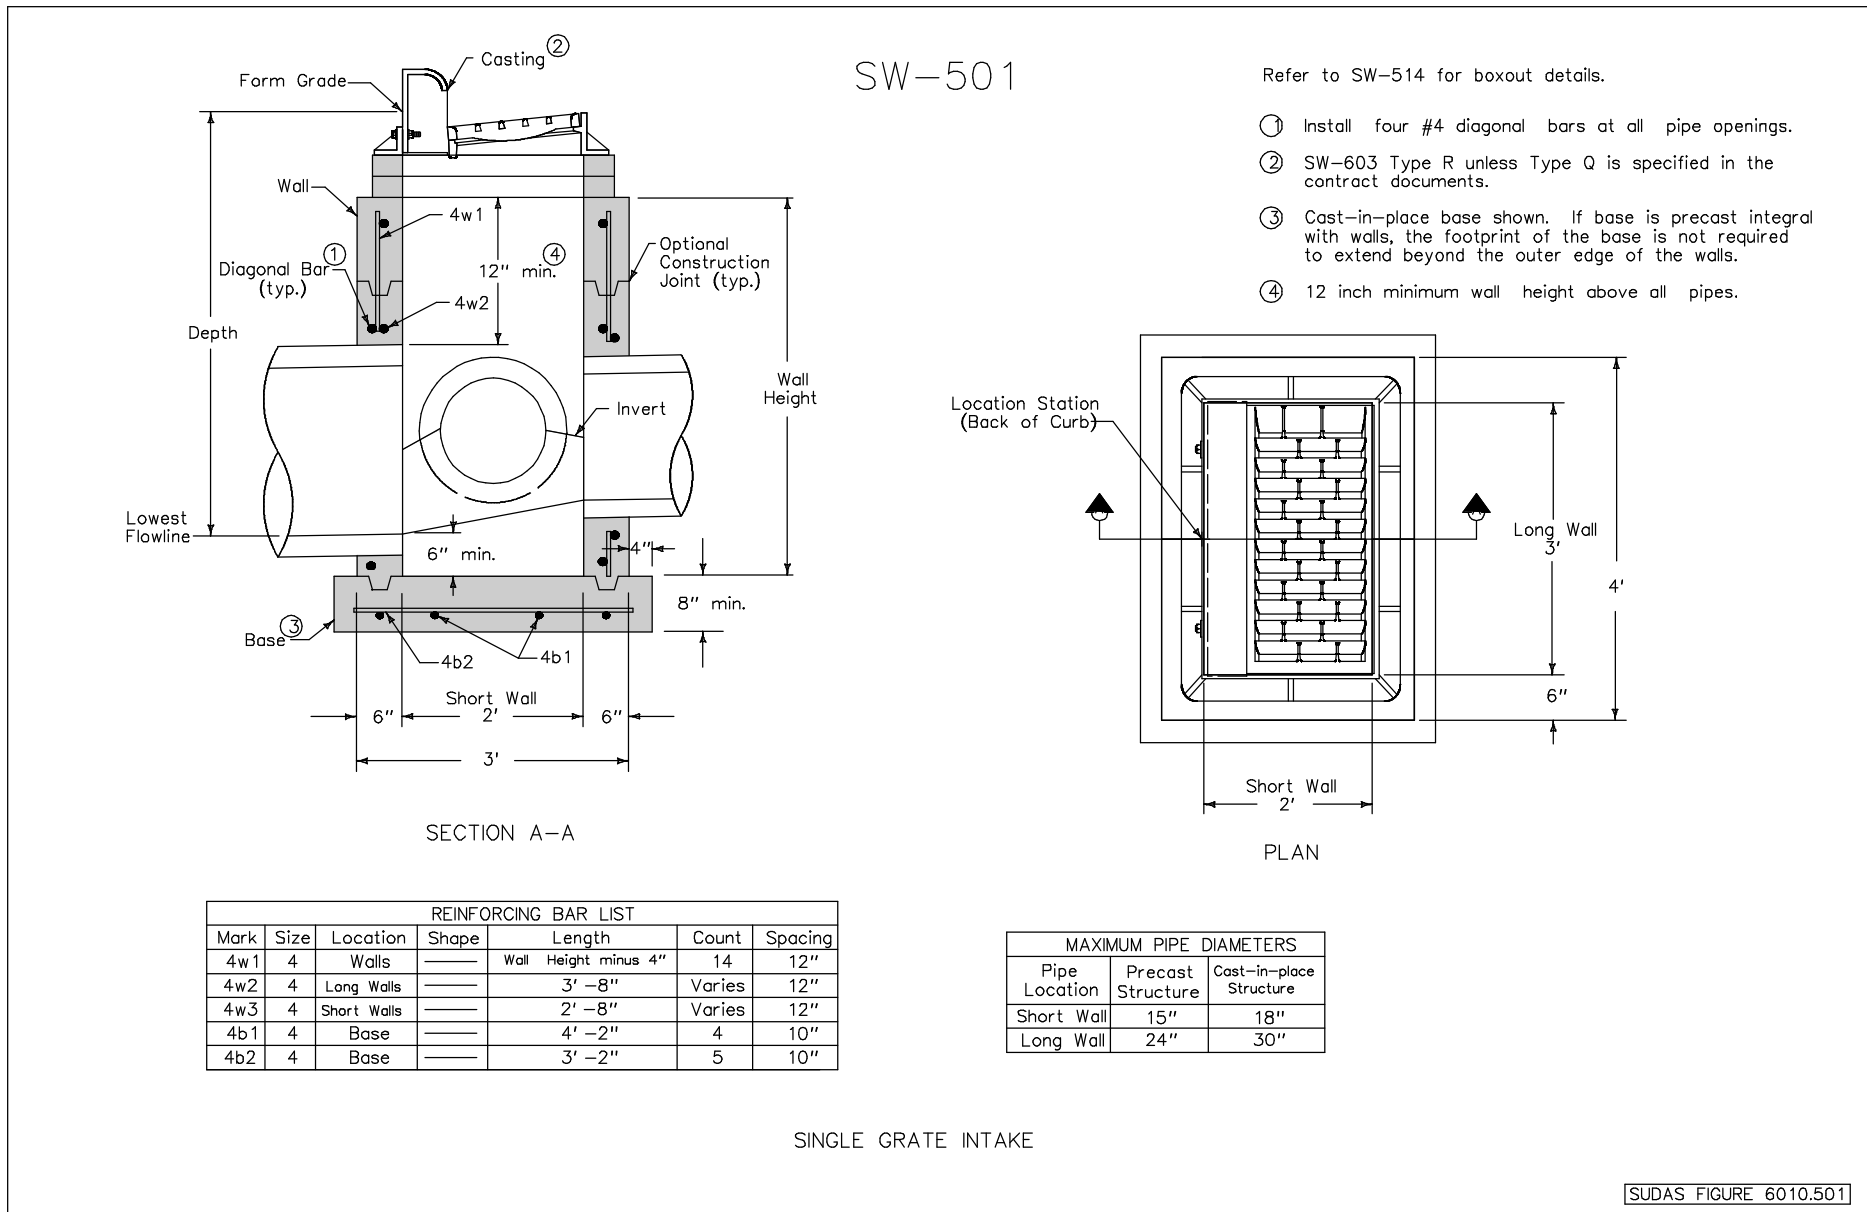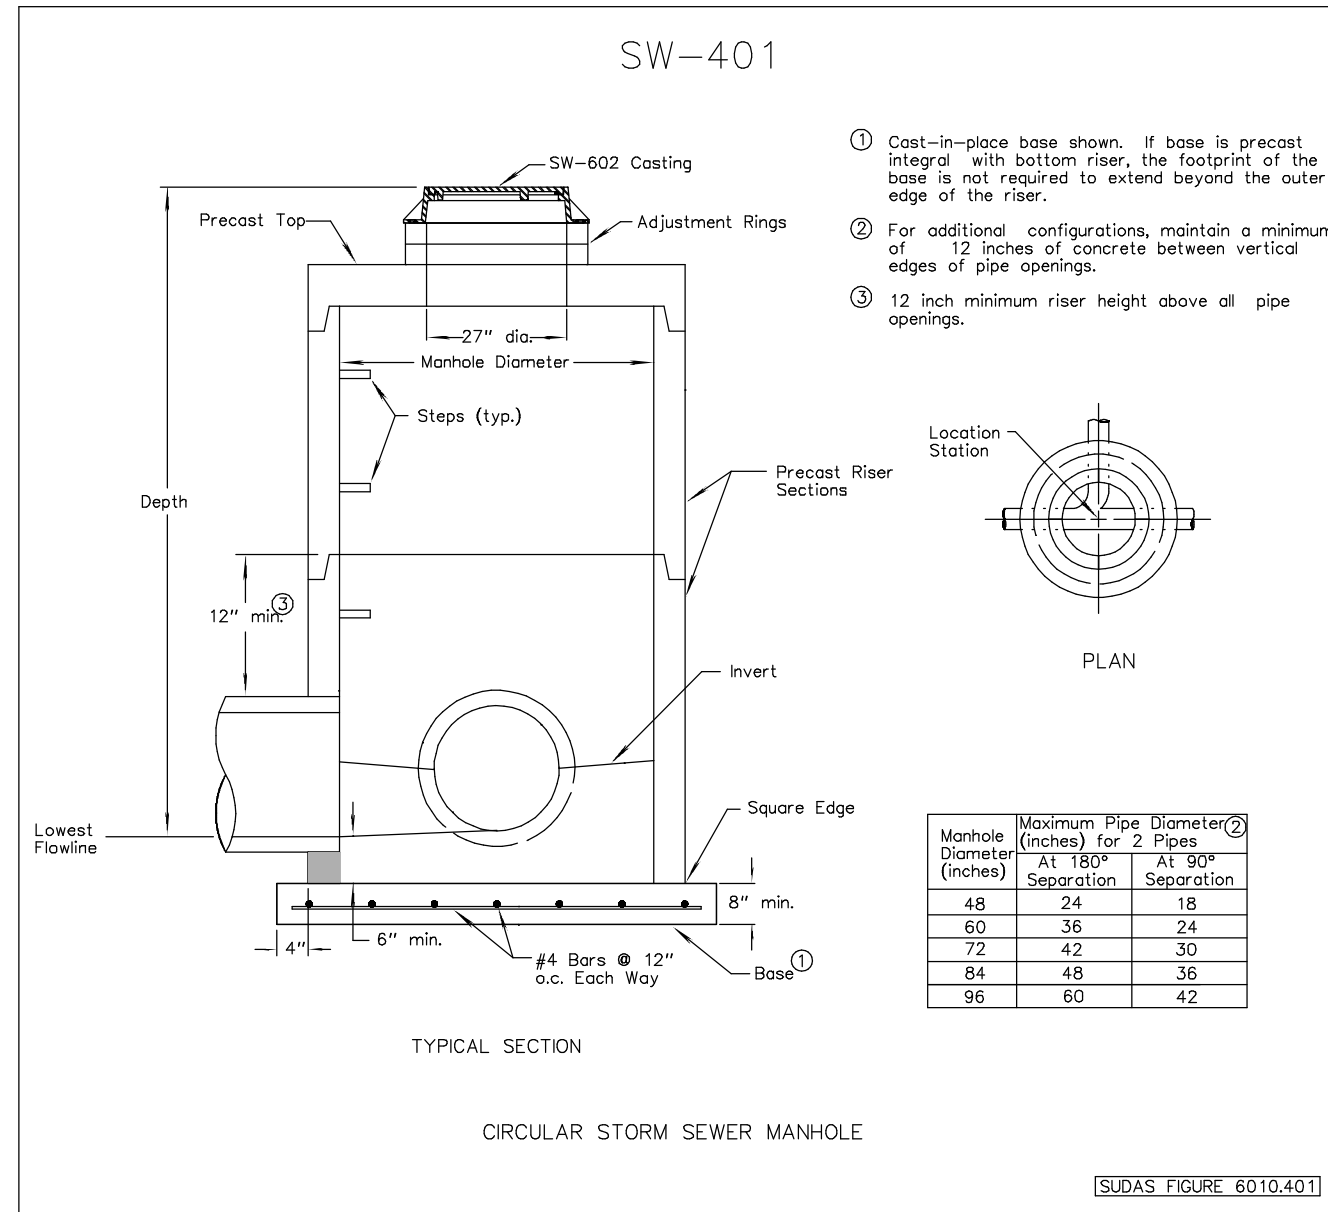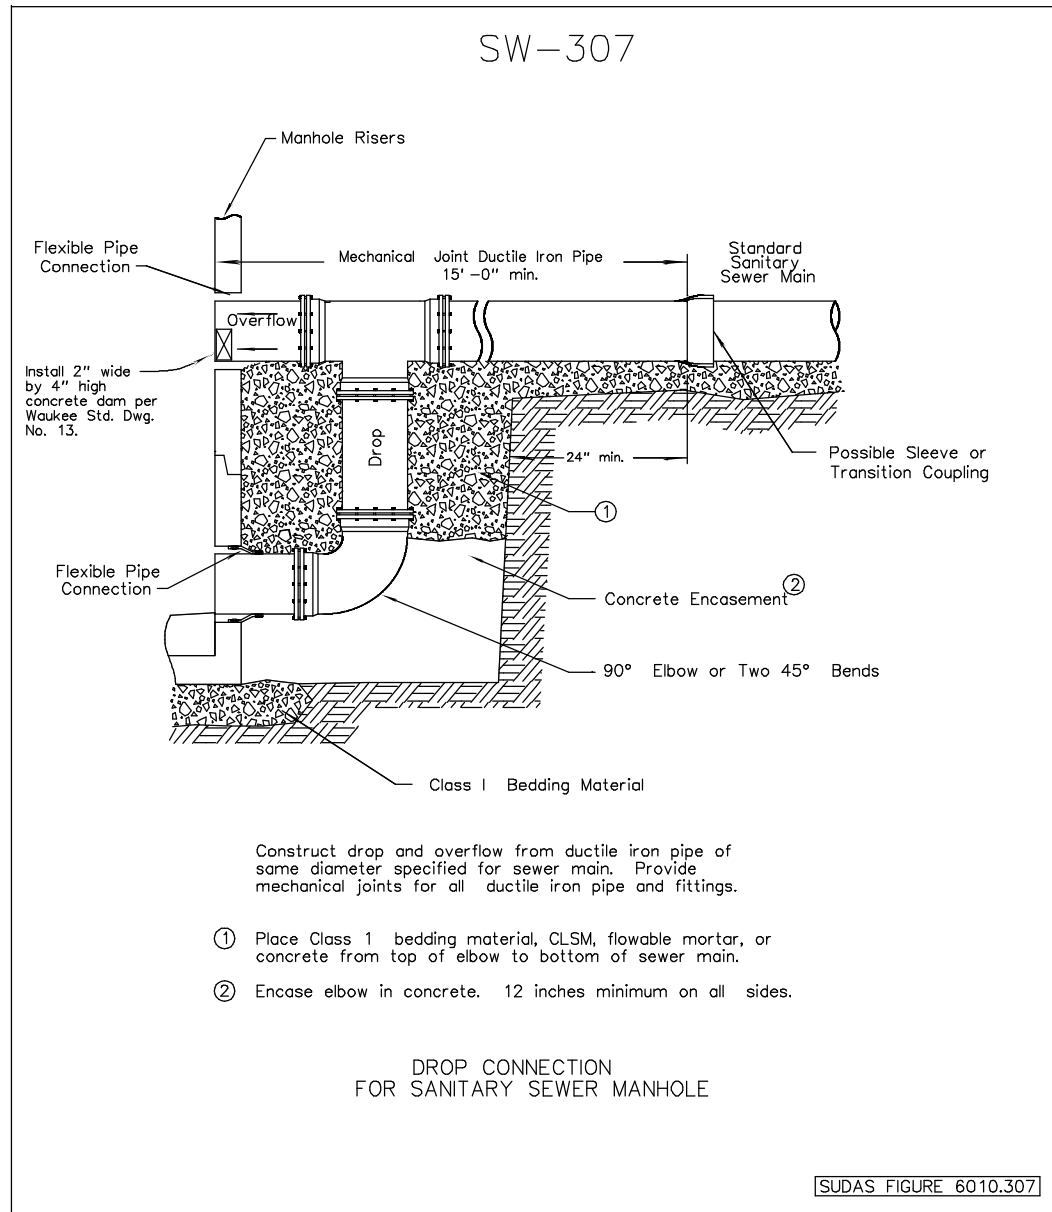

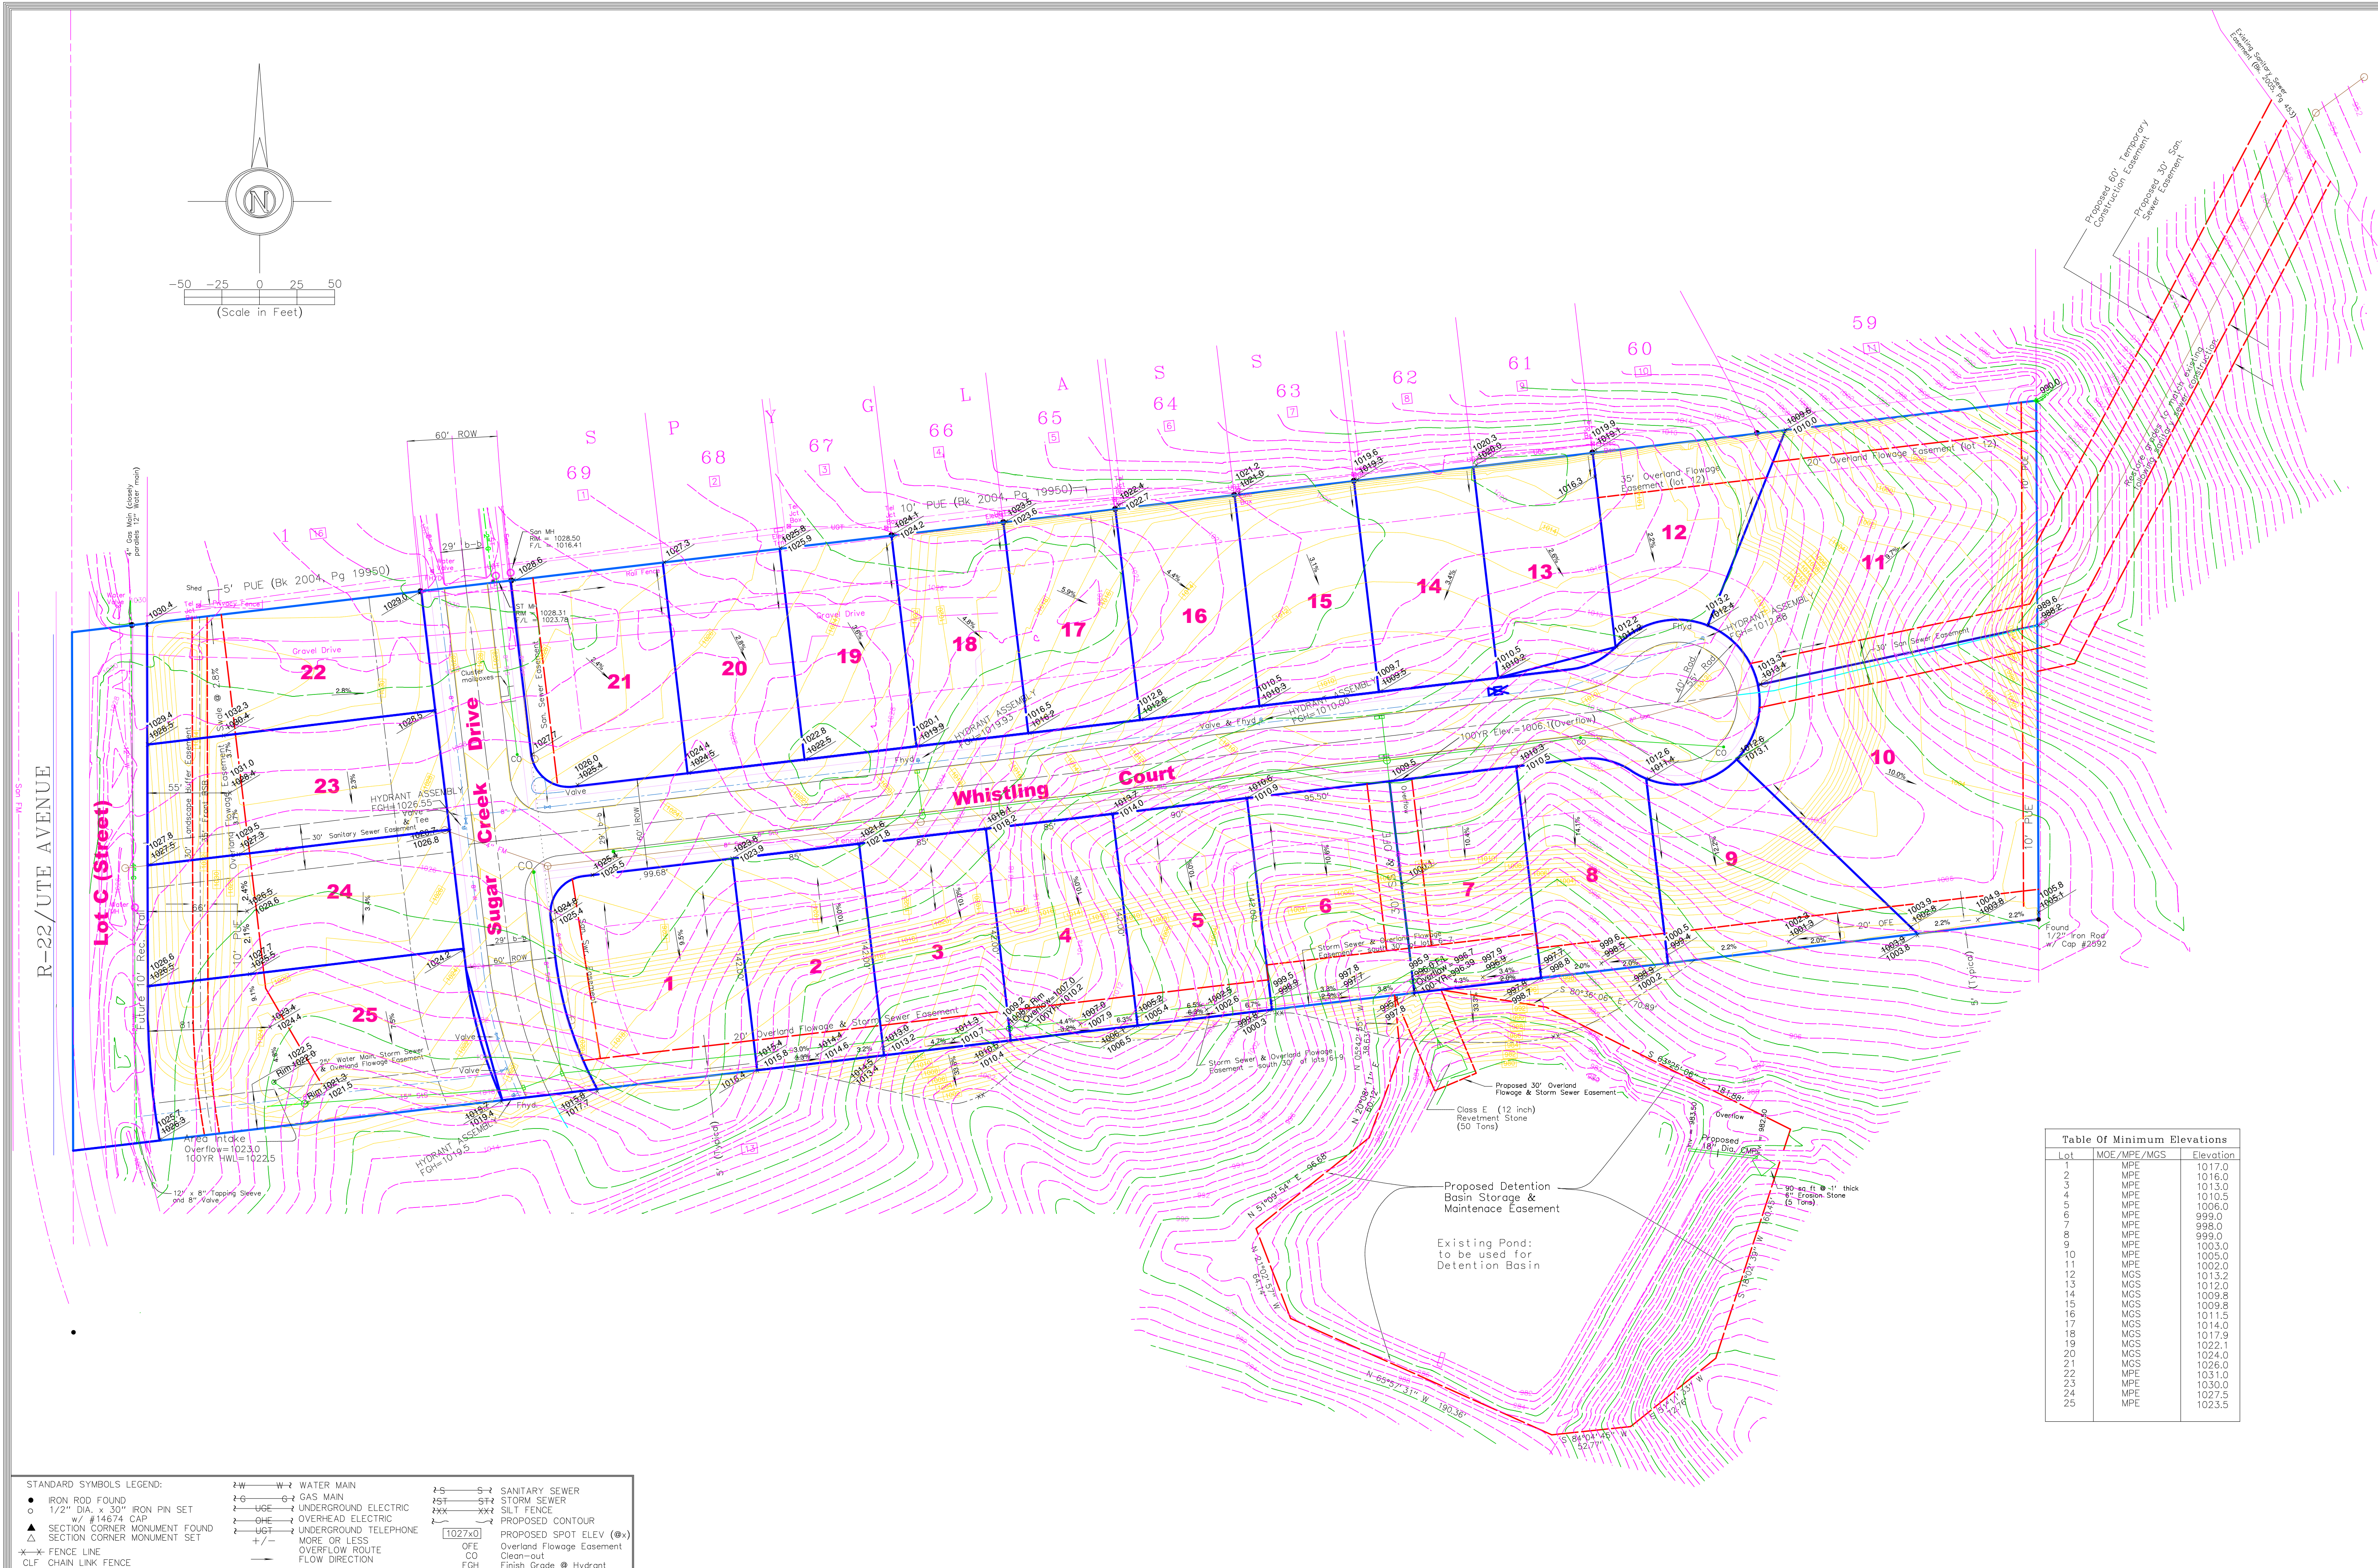

STANDARD SYMBOLS LEGEND:

● IRON ROD FOUND	W-1 WATER MAIN	S-1 SANITARY SEWER
1/2" DIA. x 30" IRON PN SET	W-2 GAS MAIN	S-2 STORM SEWER
▲ SECTION CORNER MONUMENT FOUND	W-3 UNDERGROUND ELECTRIC	W-4 SILT FENCE
▲ SECTION CORNER MONUMENT SET	W-4 OVERHEAD ELECTRIC	W-5 PROPOSED CONTOUR
✱ FENCE LINE	W-5 UNDERGROUND TELEPHONE	W-6 PROPOSED SPOT ELEV (E@x)
CLF CHAIN LINK FENCE	W-6 MORE OR LESS	W-7 OVERLAND FLOWAGE EASEMENT
	W-7 OVERFLOW ROUTE	W-8 Clean-out
	W-8 FLOW DIRECTION	W-9 Finish Grade @ Hydrant

Table Of Minimum Elevations

Lot	MOE/MPE/MGS	Elevation
1	MPE	1017.0
2	MPE	1016.0
3	MPE	1013.0
4	MPE	1010.5
5	MPE	1006.0
6	MPE	999.0
7	MPE	998.0
8	MPE	999.0
9	MPE	1003.0
10	MPE	1005.0
11	MPE	1002.0
12	MGS	1013.2
13	MGS	1012.0
14	MGS	1009.8
15	MGS	1009.8
16	MGS	1011.5
17	MGS	1014.0
18	MGS	1017.9
19	MGS	1022.1
20	MGS	1024.0
21	MGS	1026.0
22	MPE	1031.0
23	MPE	1030.0
24	MPE	1027.5
25	MPE	1023.5

As-Built Grading Plan
Spyglass Plat 2

BENCHMARK:
SPEKE IN THIRD POWERPOLE, SOUTH OF
SPEKE IN FIRST SIDE OF R-22
ELEV = 1025.53

REVISIONS:
5-28-13 Second Submittal
6-17-13 Third Submittal
7-8-13 & 7-9-13
10-23-13 Per City Review
11-6-13 Per City Review