
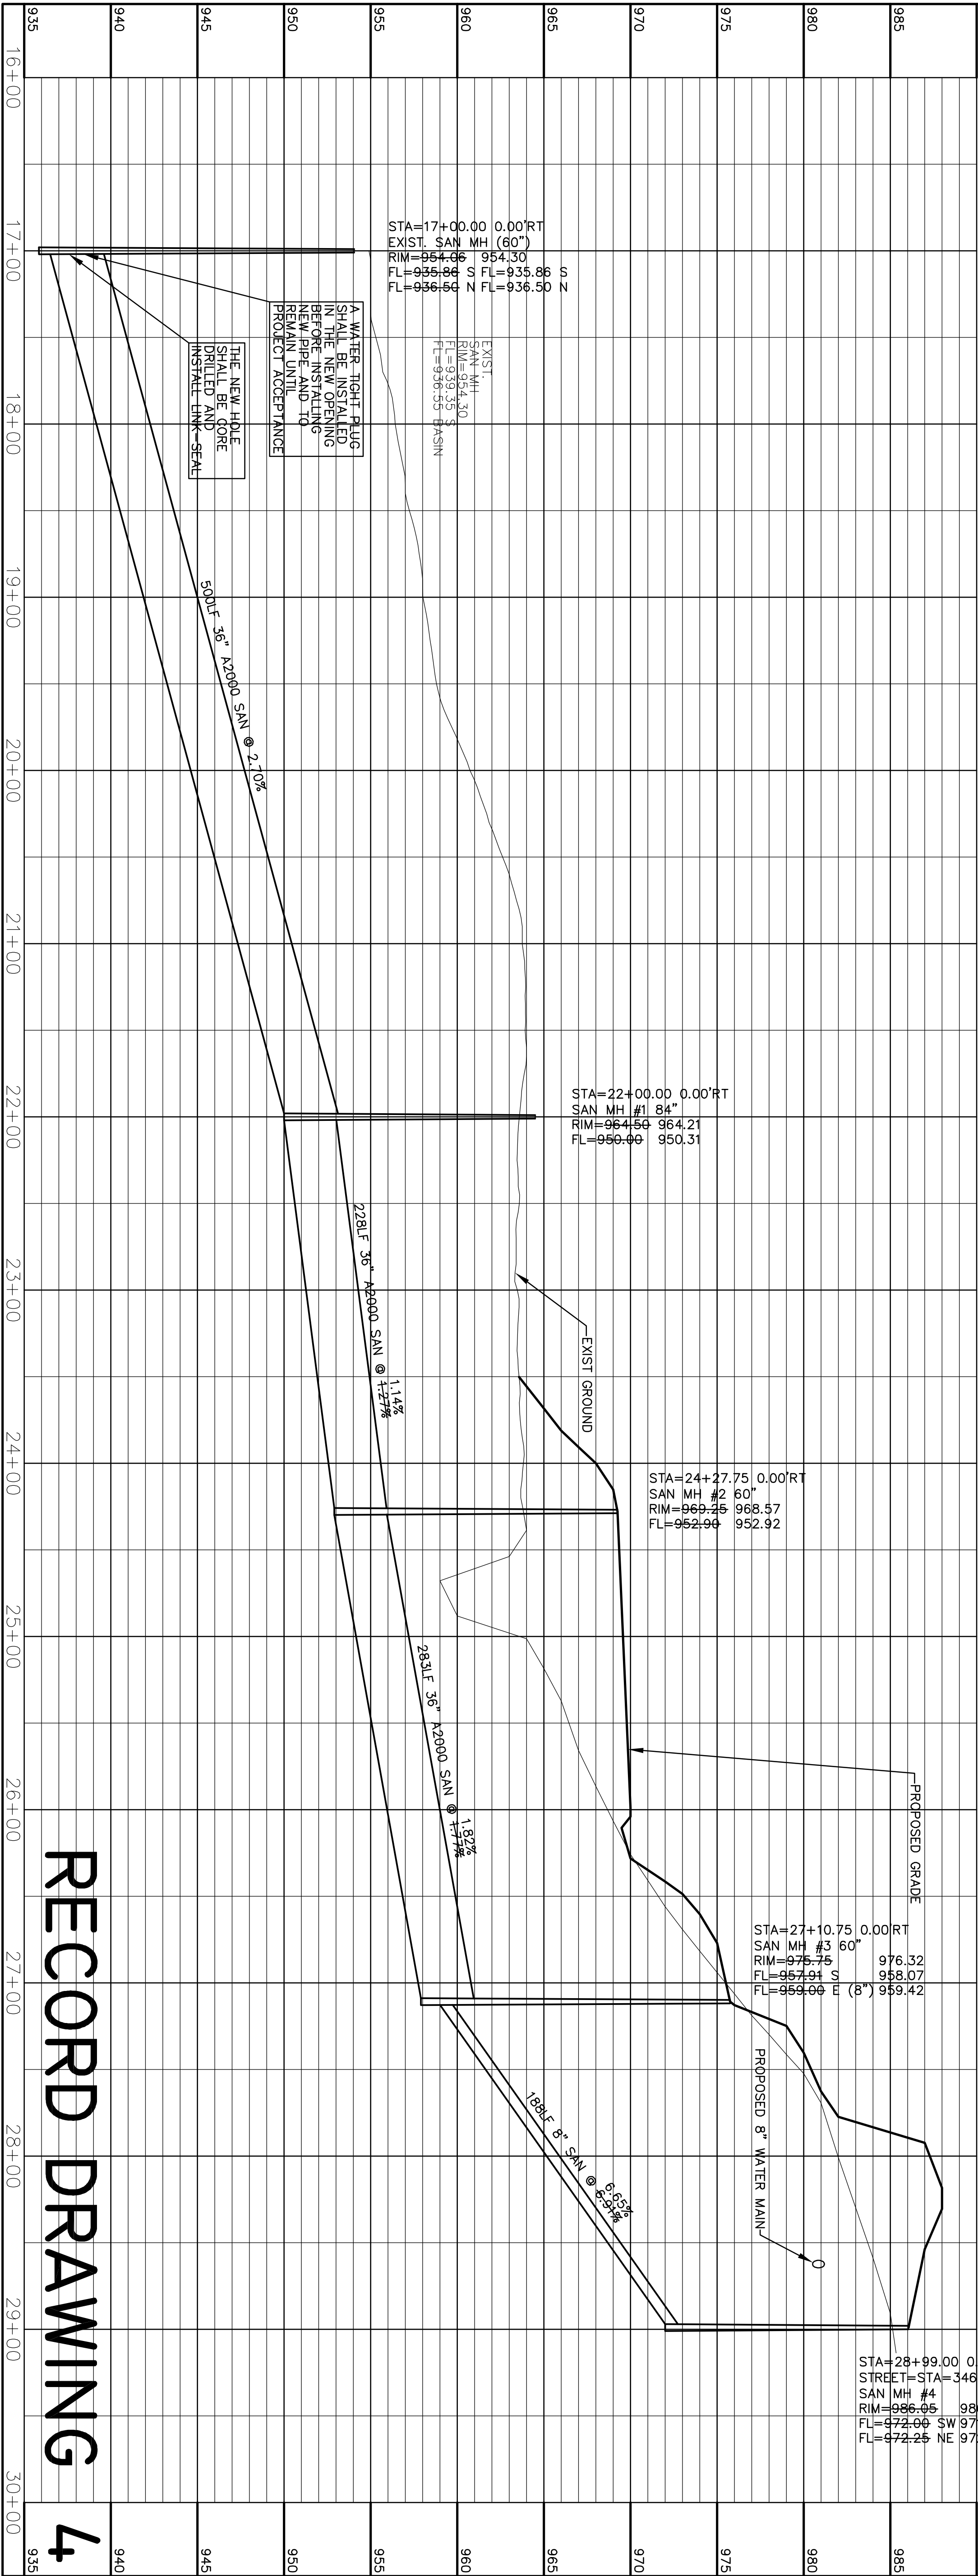
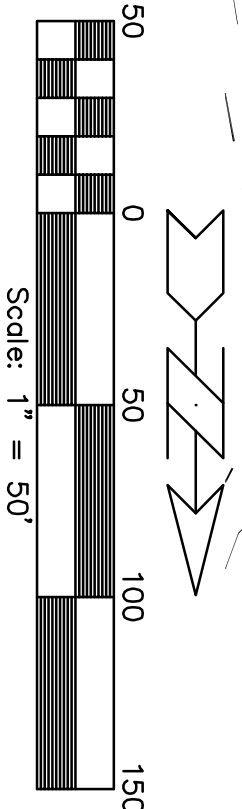


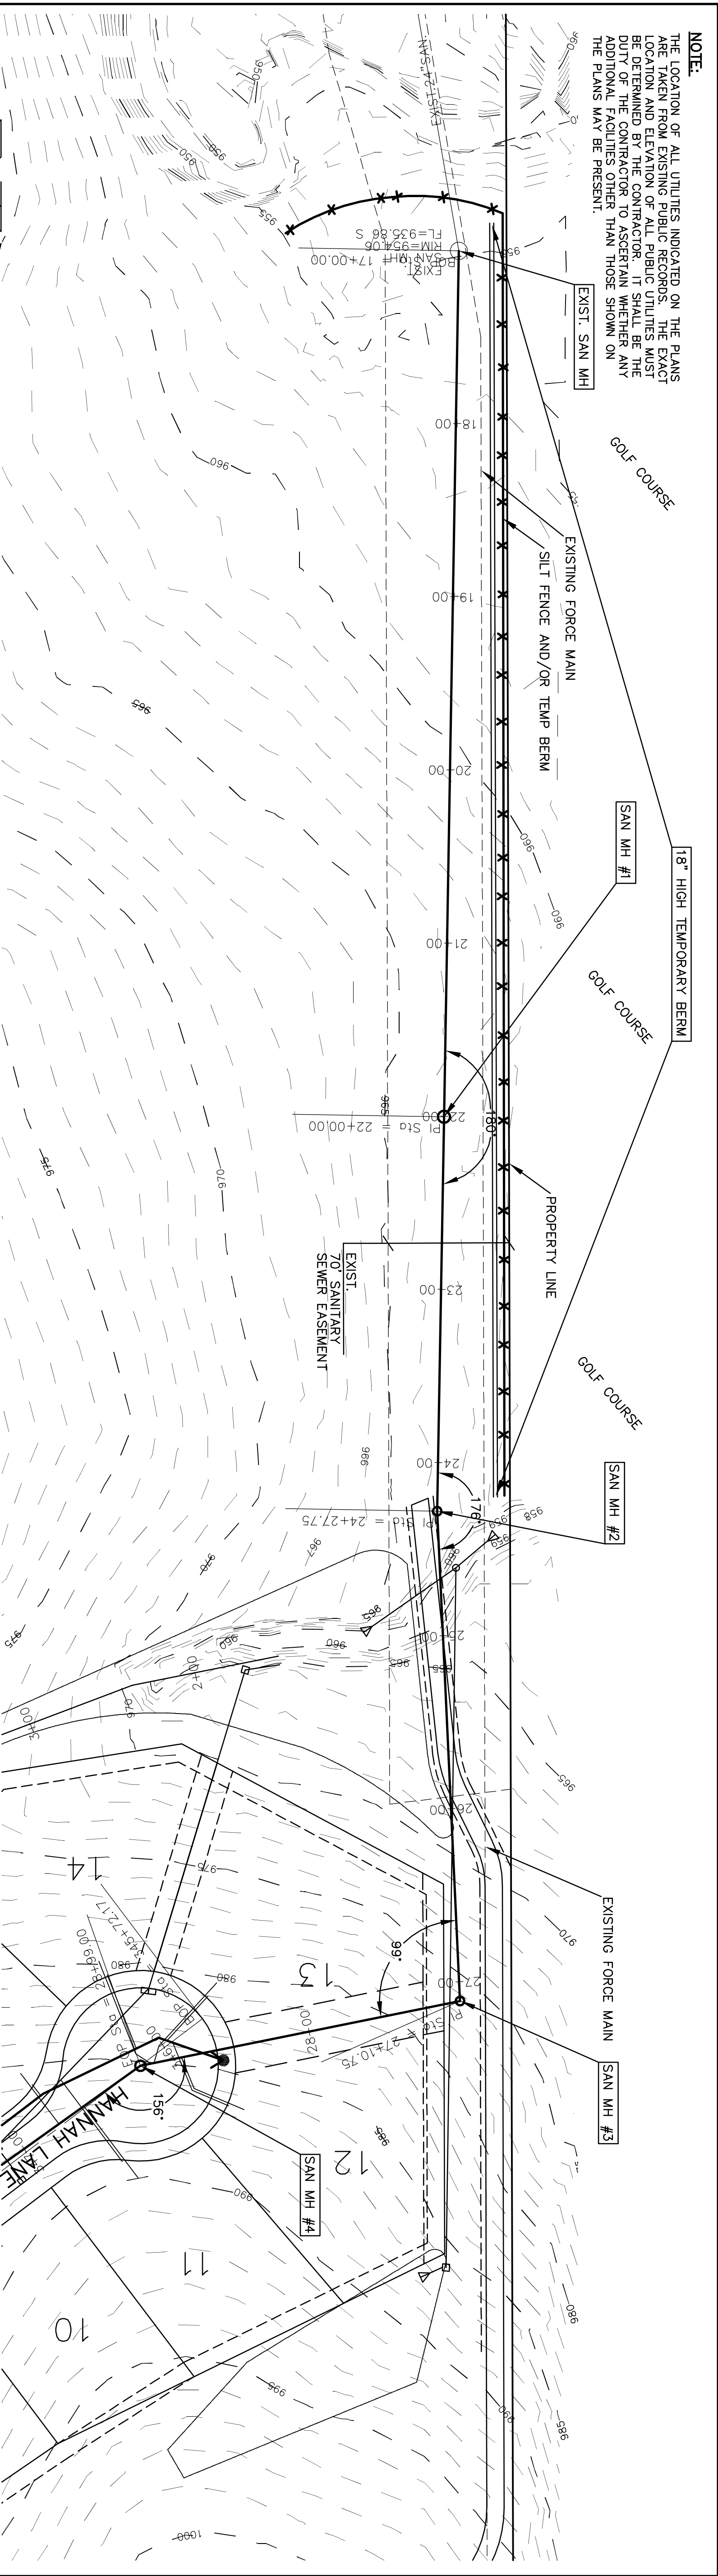

RECORD DRAWING 4

7150.00



ERG

Engineering Resource Group, Inc.
Engineers and Surveyors
2413 GRAND AVENUE
DES MOINES, IOWA 50312
(515) 288-4823

GLYNN VILLAGE PLAT 4 - OFFSITE TRUNK SEWER

NO.	REVISION	DATE	BY	FOR:	LOCATION:	SCALE:	DESIGNED BY:	DRAWN BY:
						1" = 50'	DJS	PJV
				HUBBELL REALTY COMPANY		7150PP4.DWG	CHECKED BY:	DATE: 10/12/11
						FIELD BOOK:	SHEET 4 OF 10	FILE NO.: 7150

NOTE:
THE LOCATION OF ALL UTILITIES INDICATED ON THE PLANS ARE TAKEN FROM EXISTING PUBLIC RECORDS. THE EXACT LOCATION AND DEPTH OF ALL UTILITIES SHALL BE DETERMINED BY THE CONTRACTOR. IT SHALL BE THE DUTY OF THE CONTRACTOR TO ASCERTAIN WHETHER ANY ADDITIONAL FACILITIES OTHER THAN THOSE SHOWN ON THE PLANS MAY BE PRESENT.

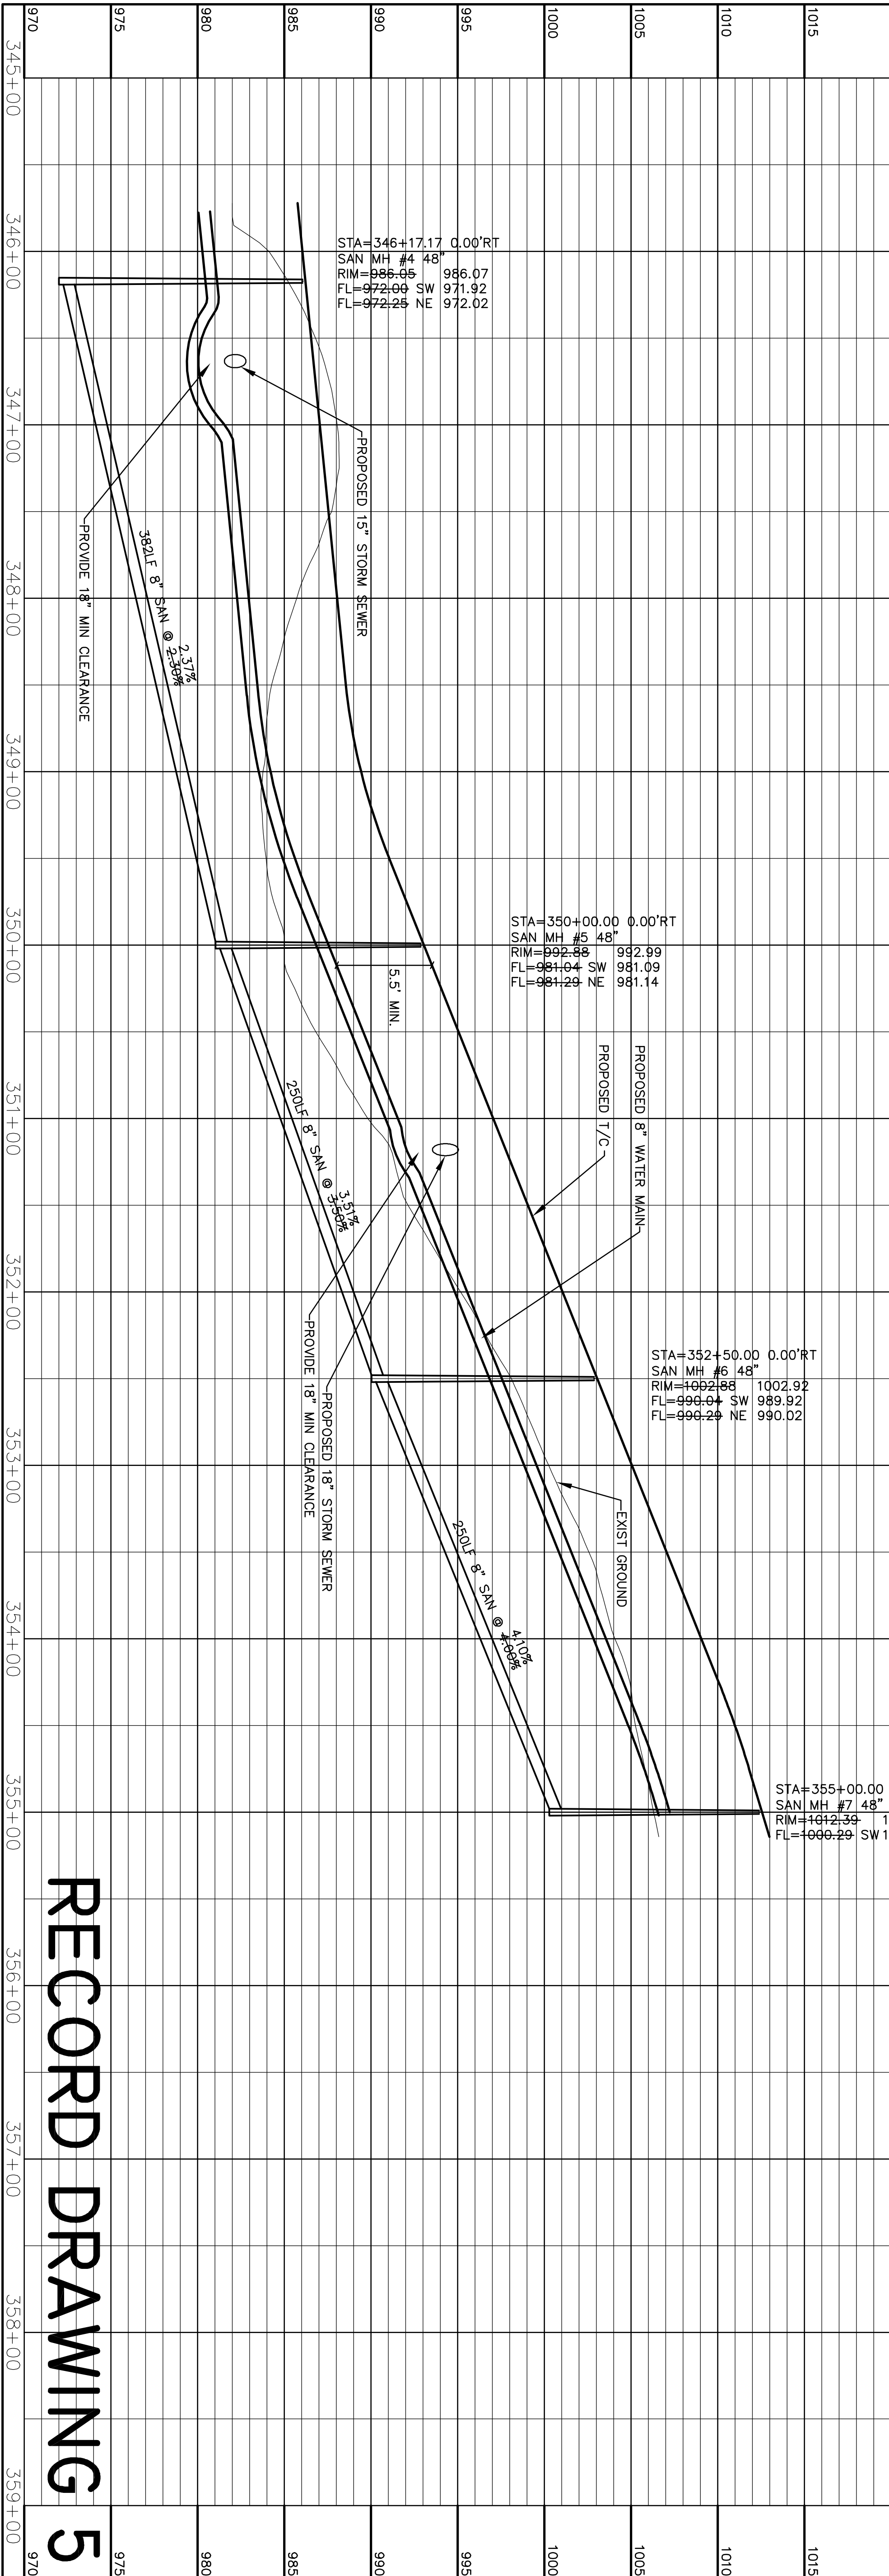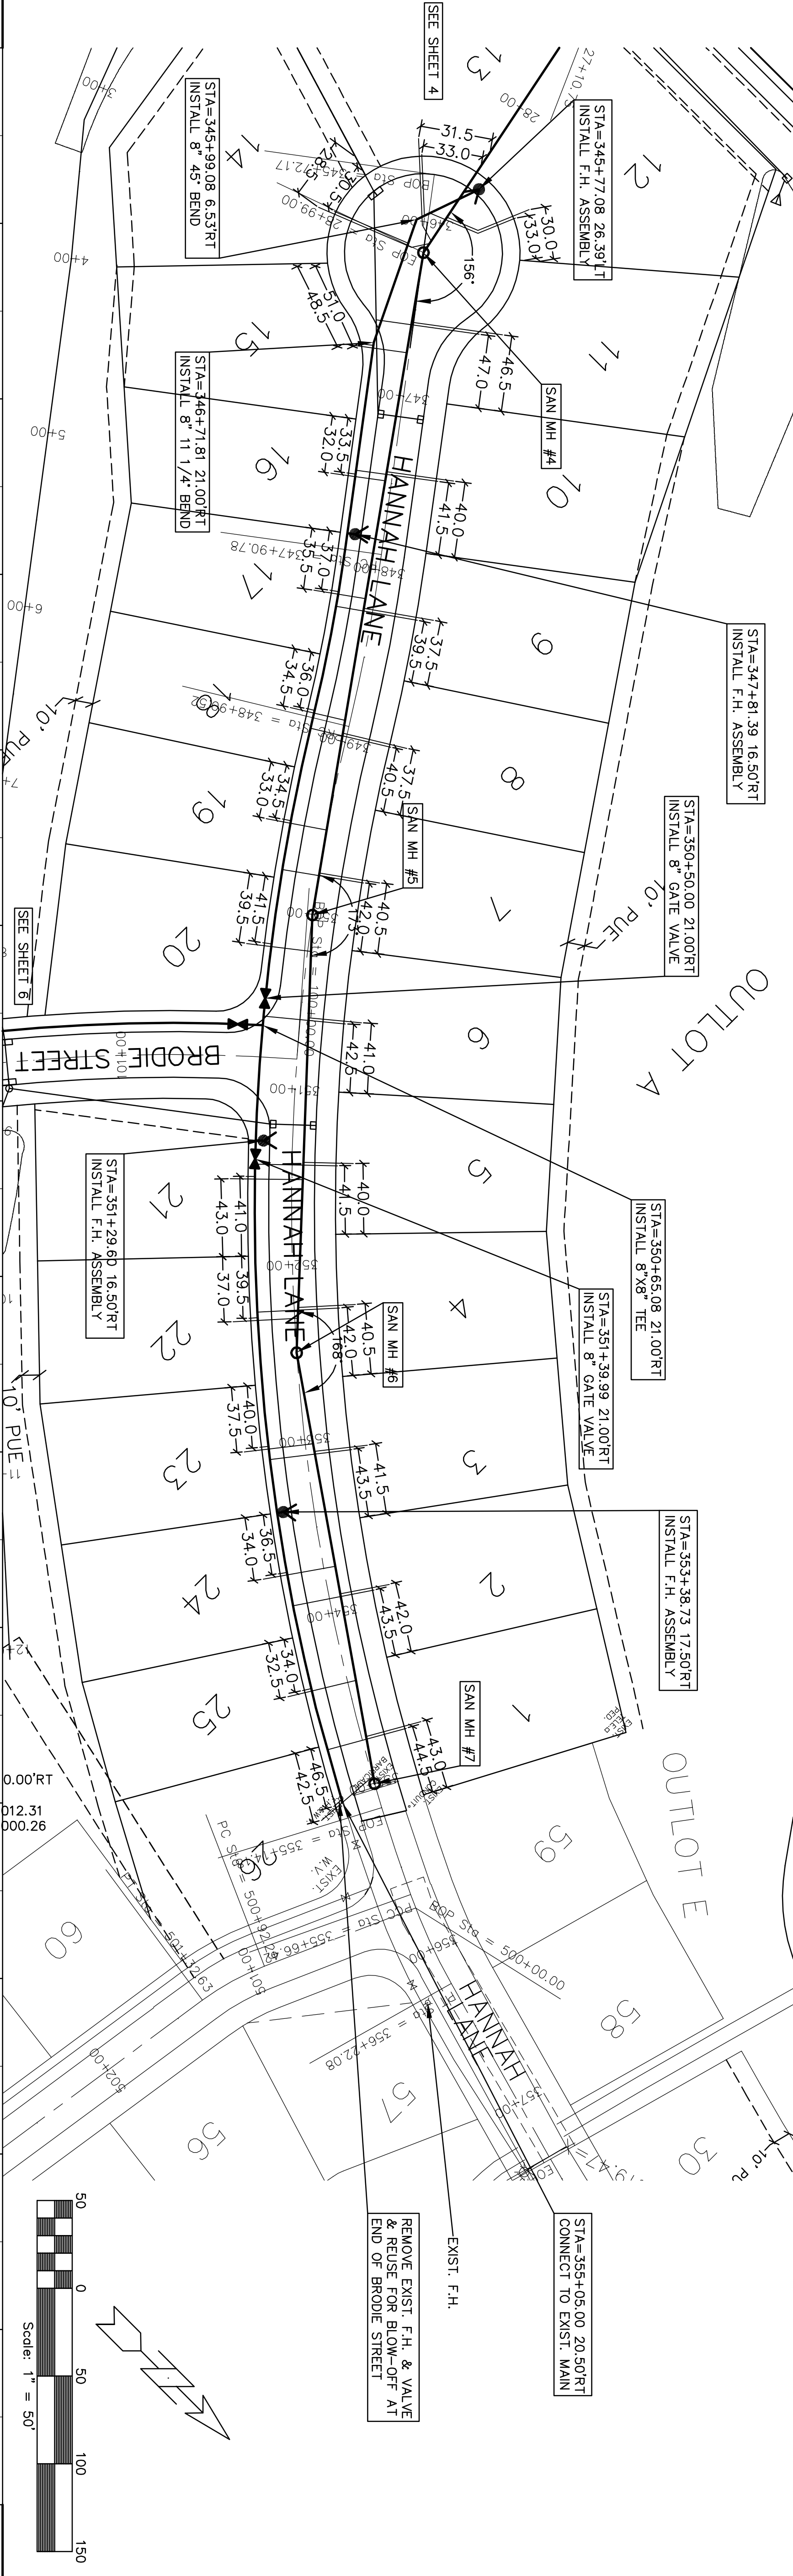

RECORD DRAWING 5


7150.00		ERG Engineering Resource Group, Inc. Engineers and Surveyors 2413 GRAND AVENUE DES MOINES, IOWA 50312 (515) 288-4823		HANNAH LANE - SANITARY AND WATER				NO. REVISION DATE BY FOR: HUBBELL REALTY COMPANY		LOCATION:		SCALE: 1" = 50'	DESIGNED BY: DJS	DRAWN BY: PJV
												DWG: 7150PP5.DWG	CHECKED BY:	DATE: 10/12/11
												FIELD BOOK:	SHEET 5 OF 10	FILE NO.: 7150

NO.	REVISION	DATE	BY

LOCATION:


DRAWN BY: PJV












DATE: 10/12/11
FILE NO.: 7150

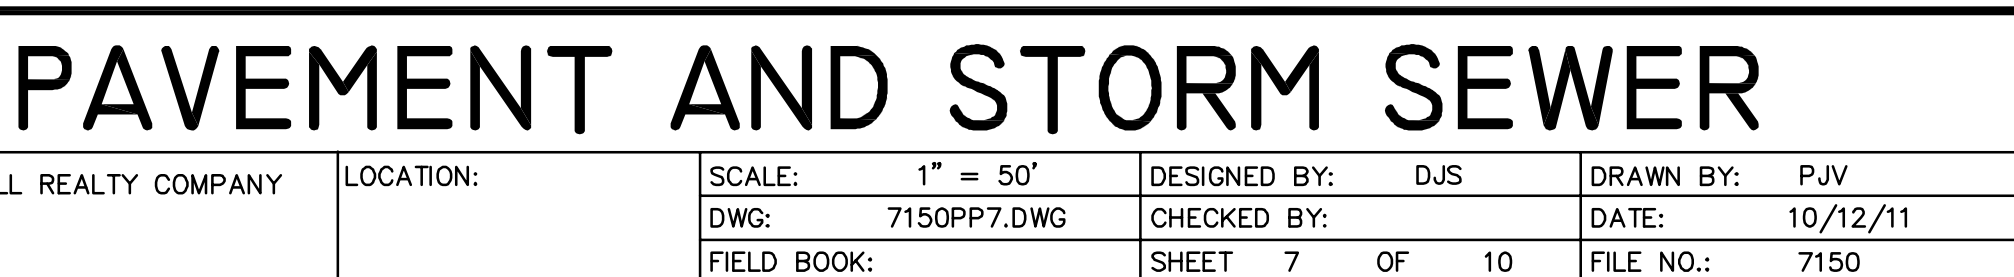

NO.	REVISION	DATE	BY	FOR: HUBBELL REALTY COMPANY

SCALE: 1" = 50'	DESIGNED BY: DJS	DRAWN BY: PJV
DWG: 7150PP9.DWG	CHECKED BY:	DATE: 10/12/11
FIELD BOOK:	SHEET 9 OF 10	FILE NO.: 7150

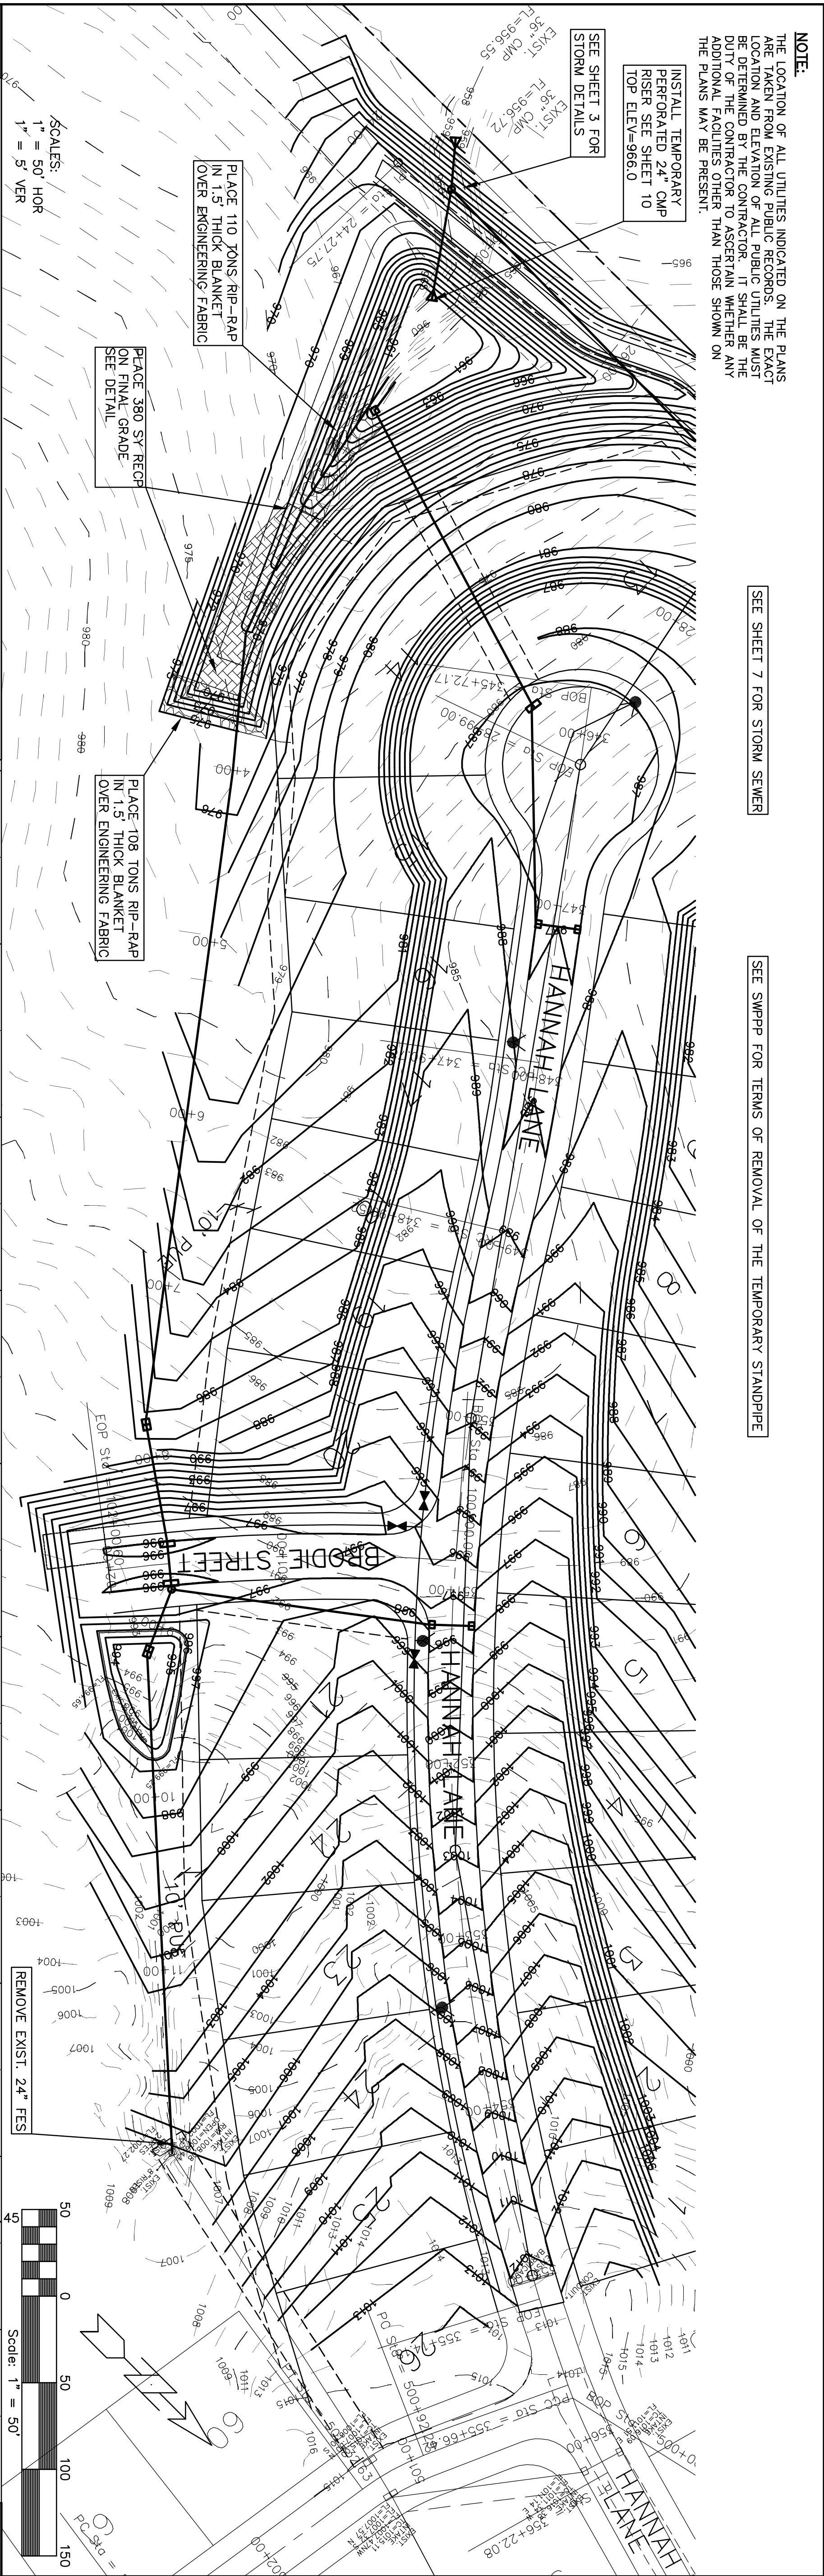

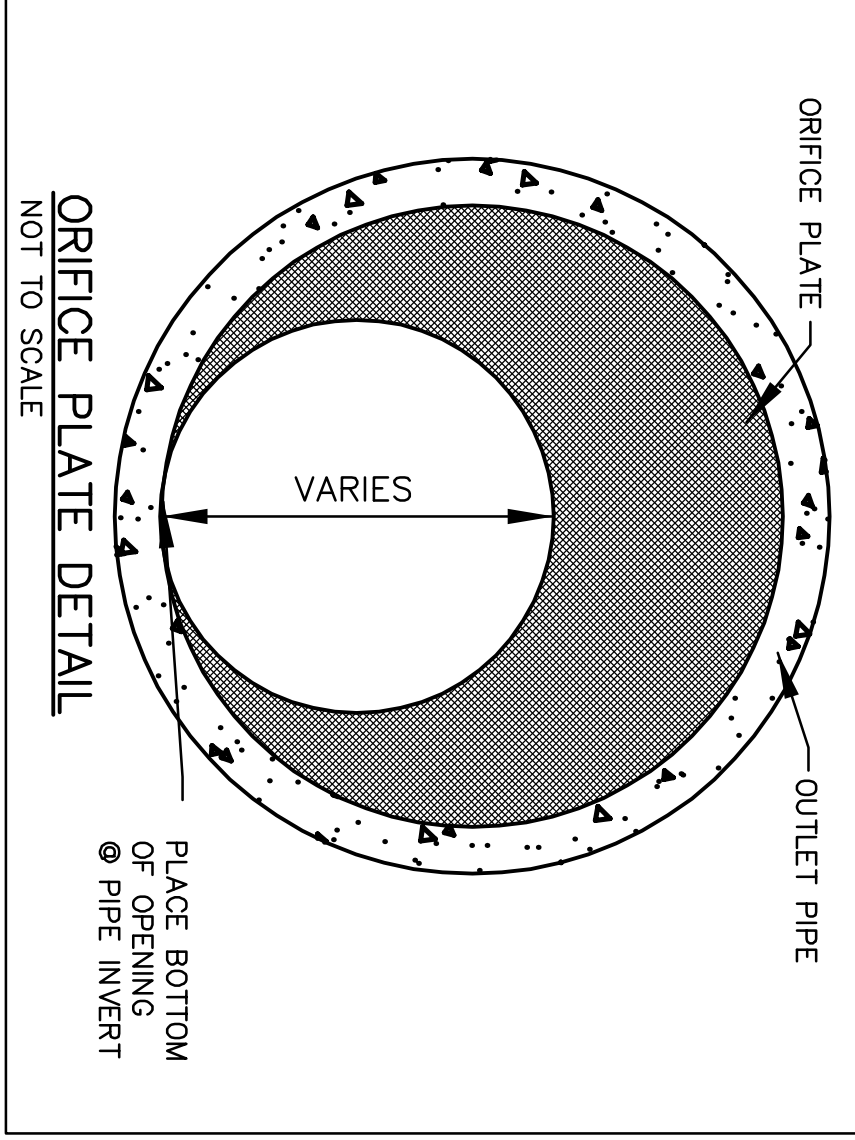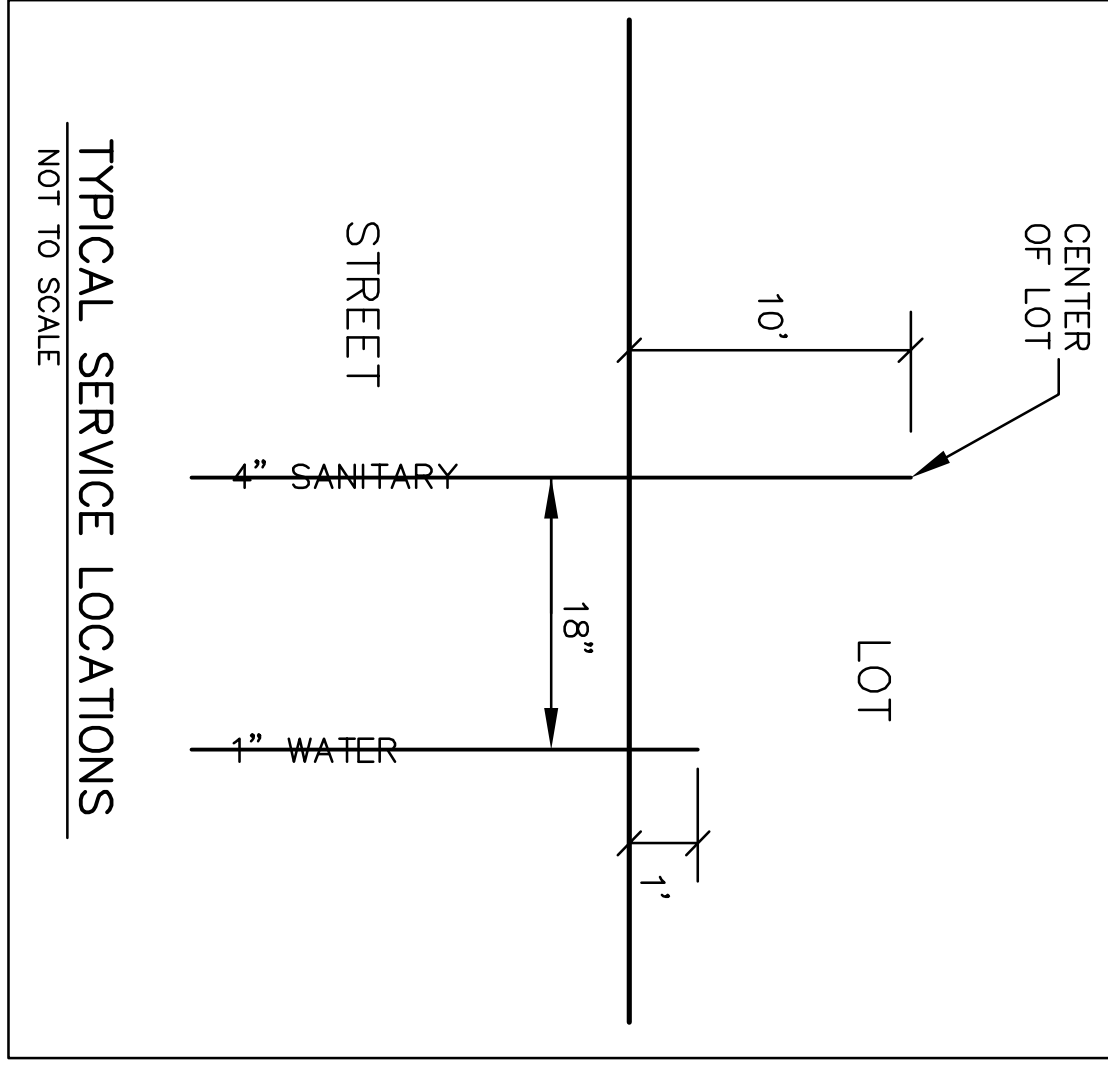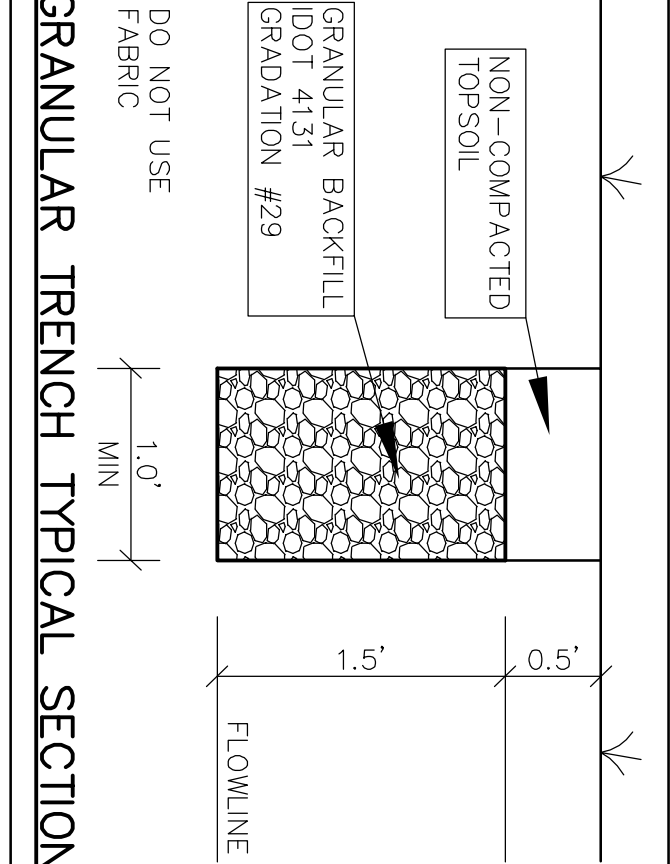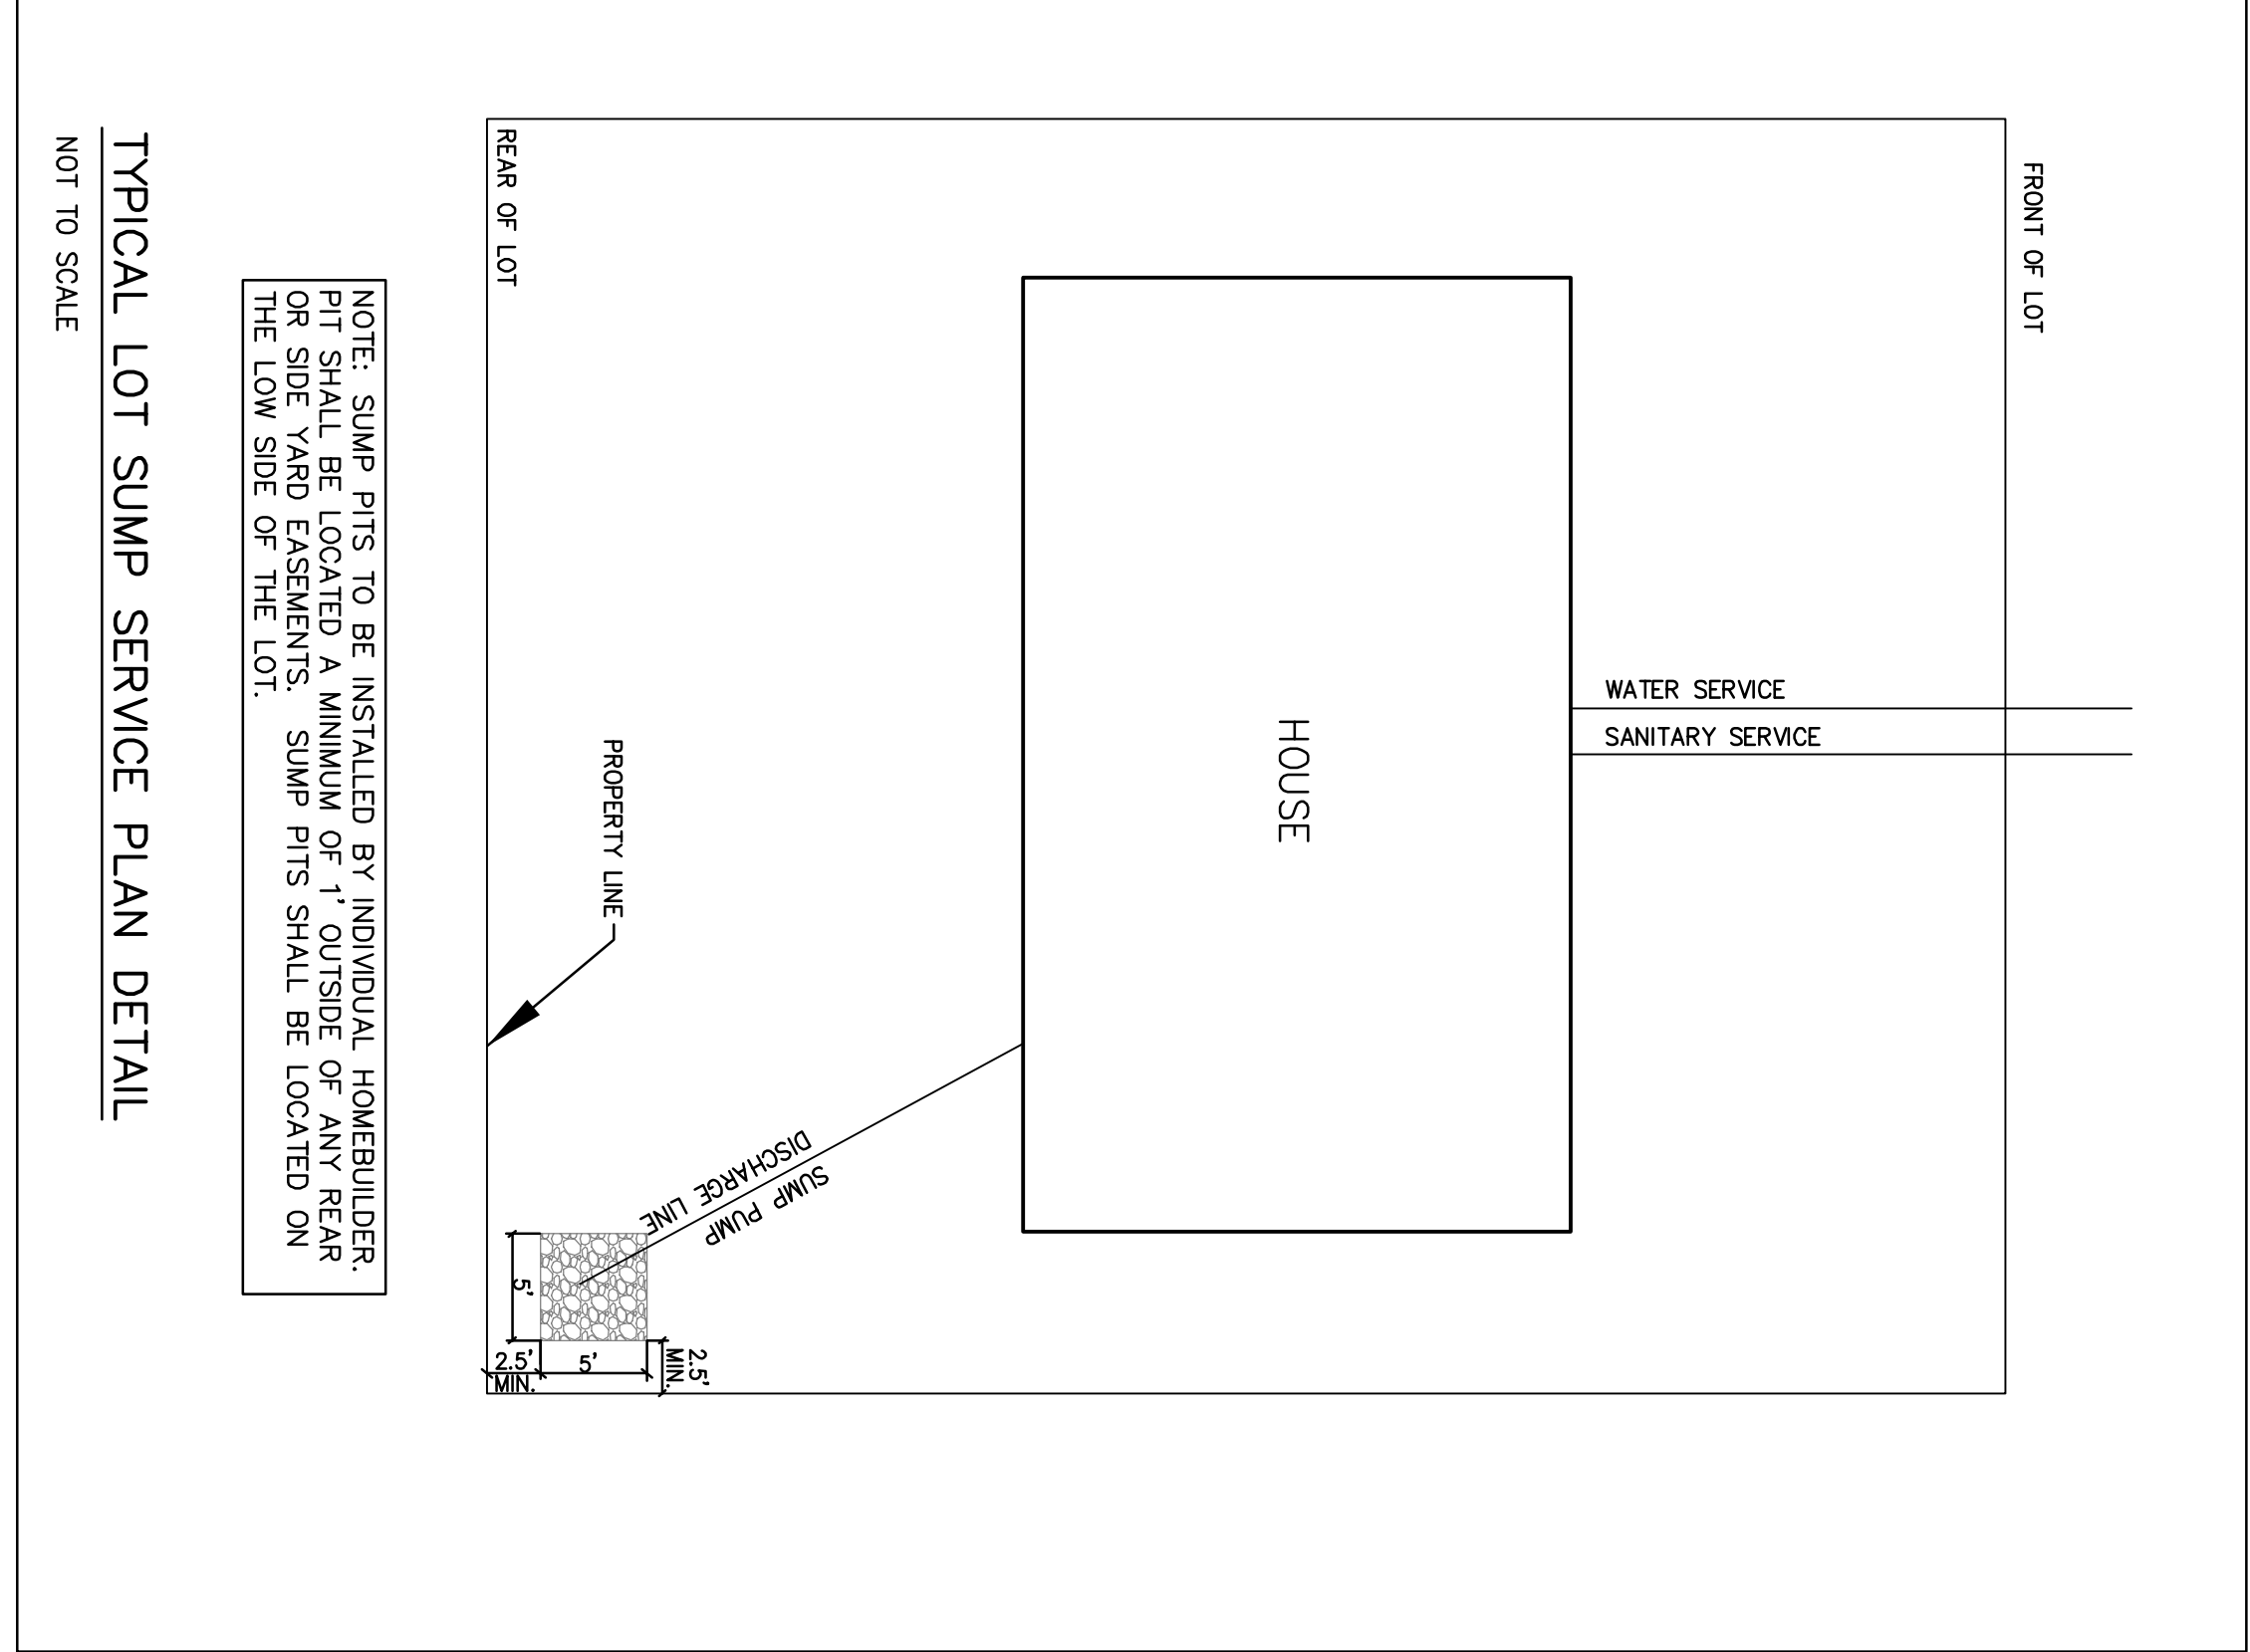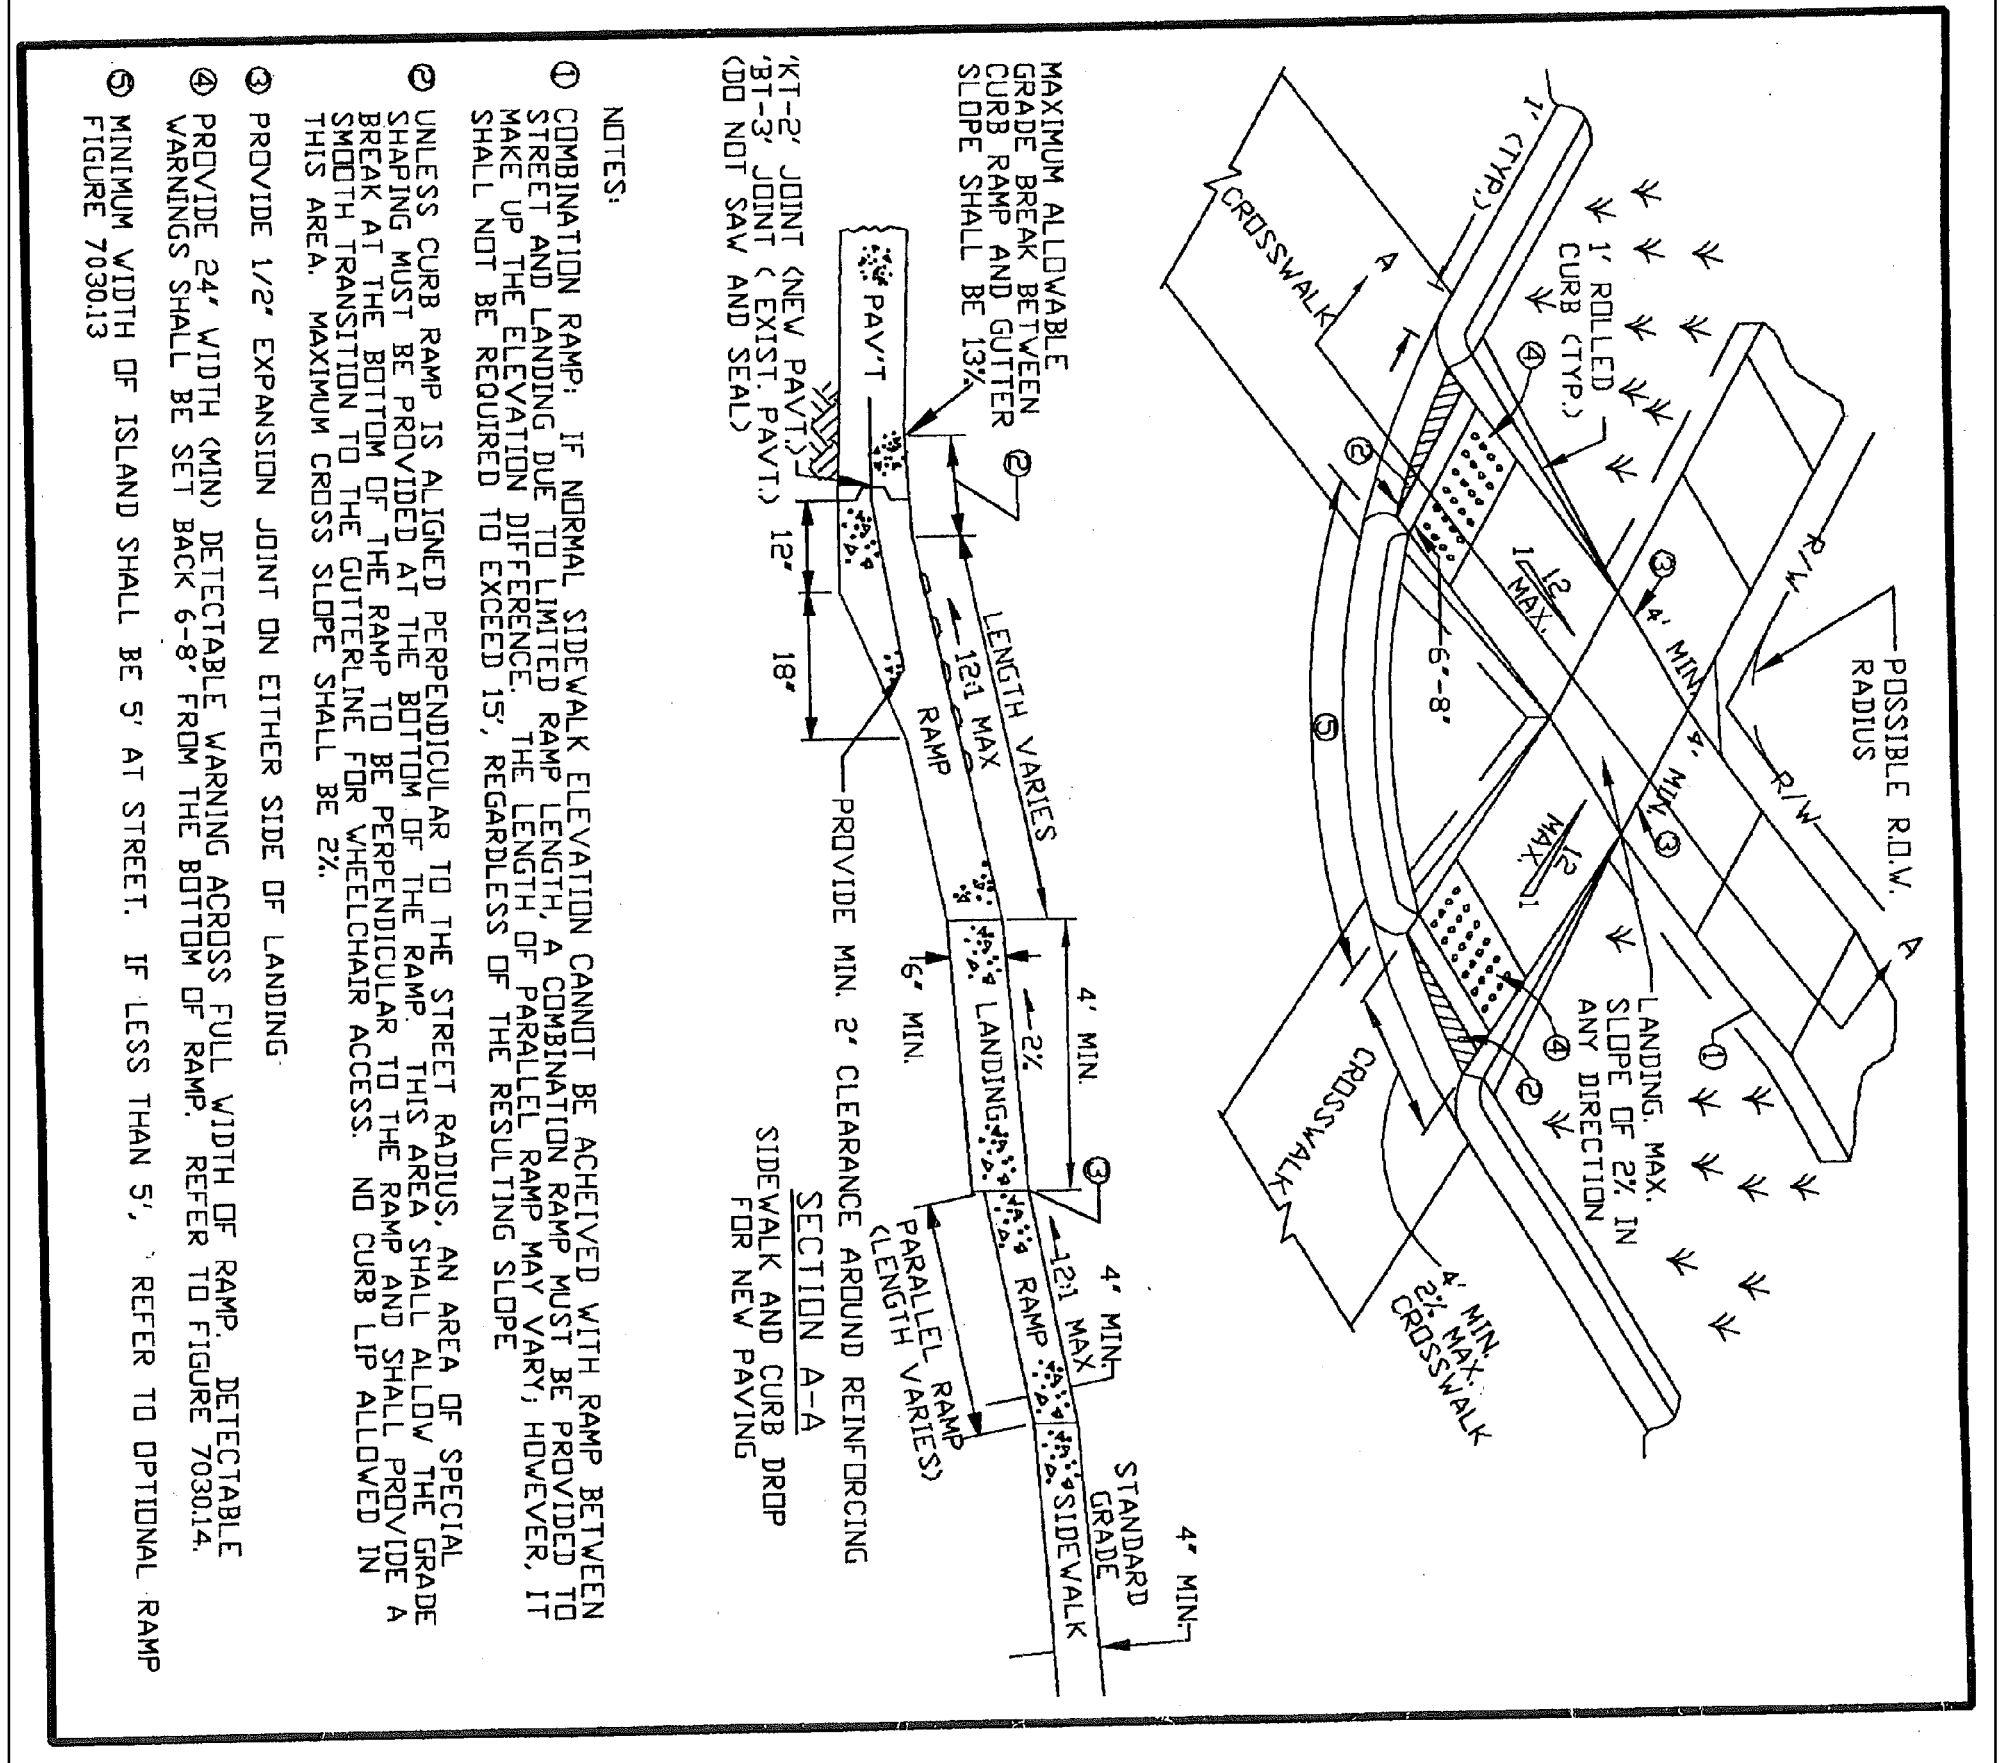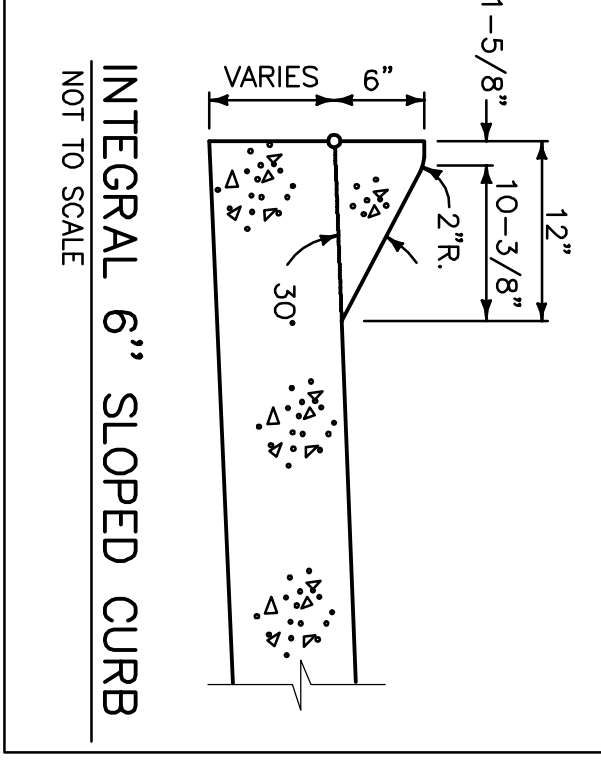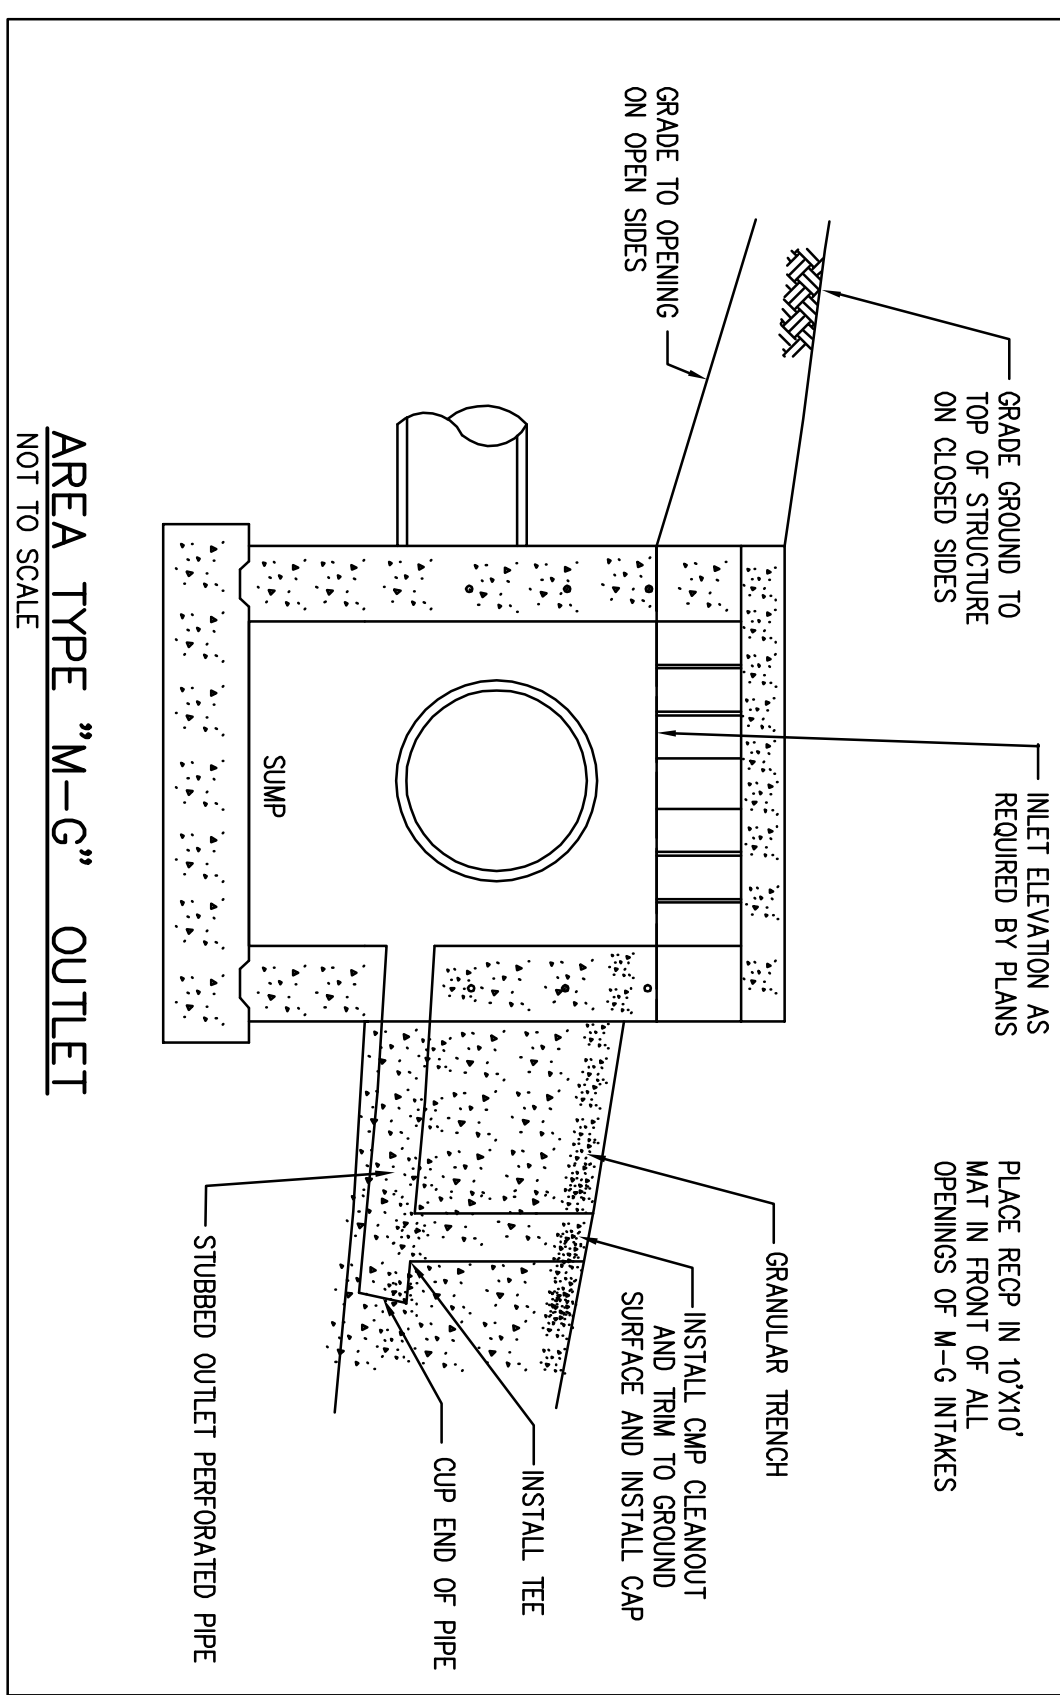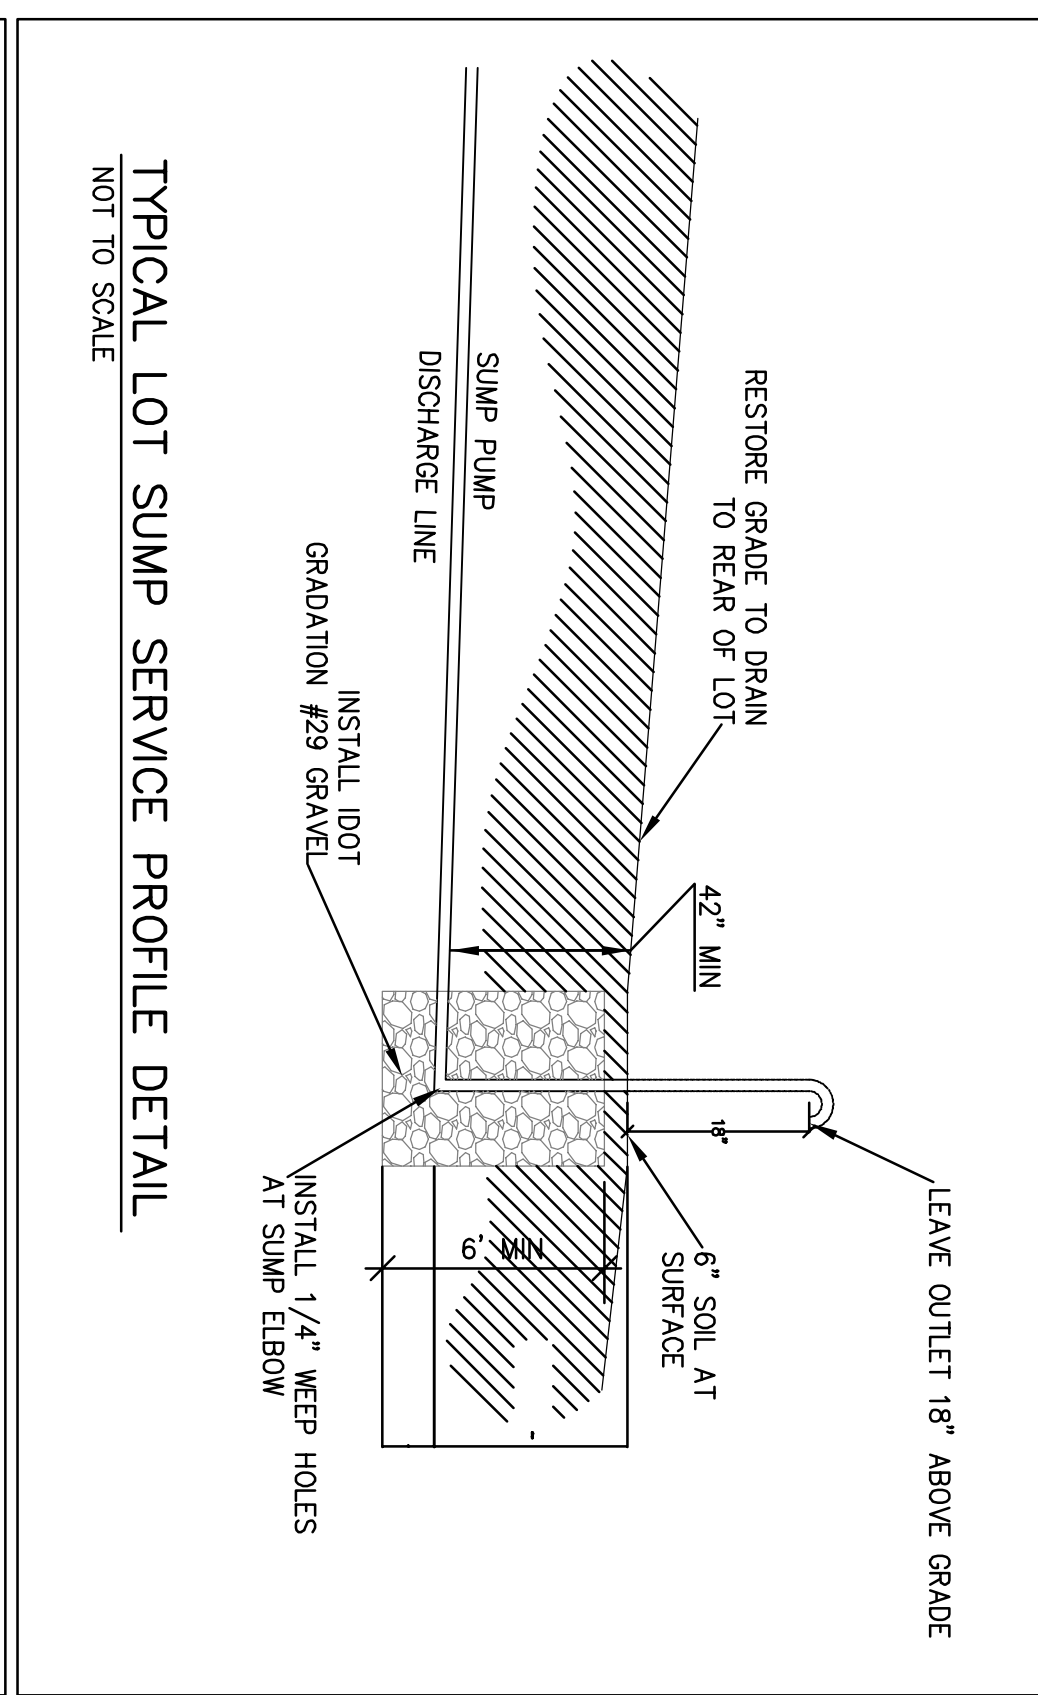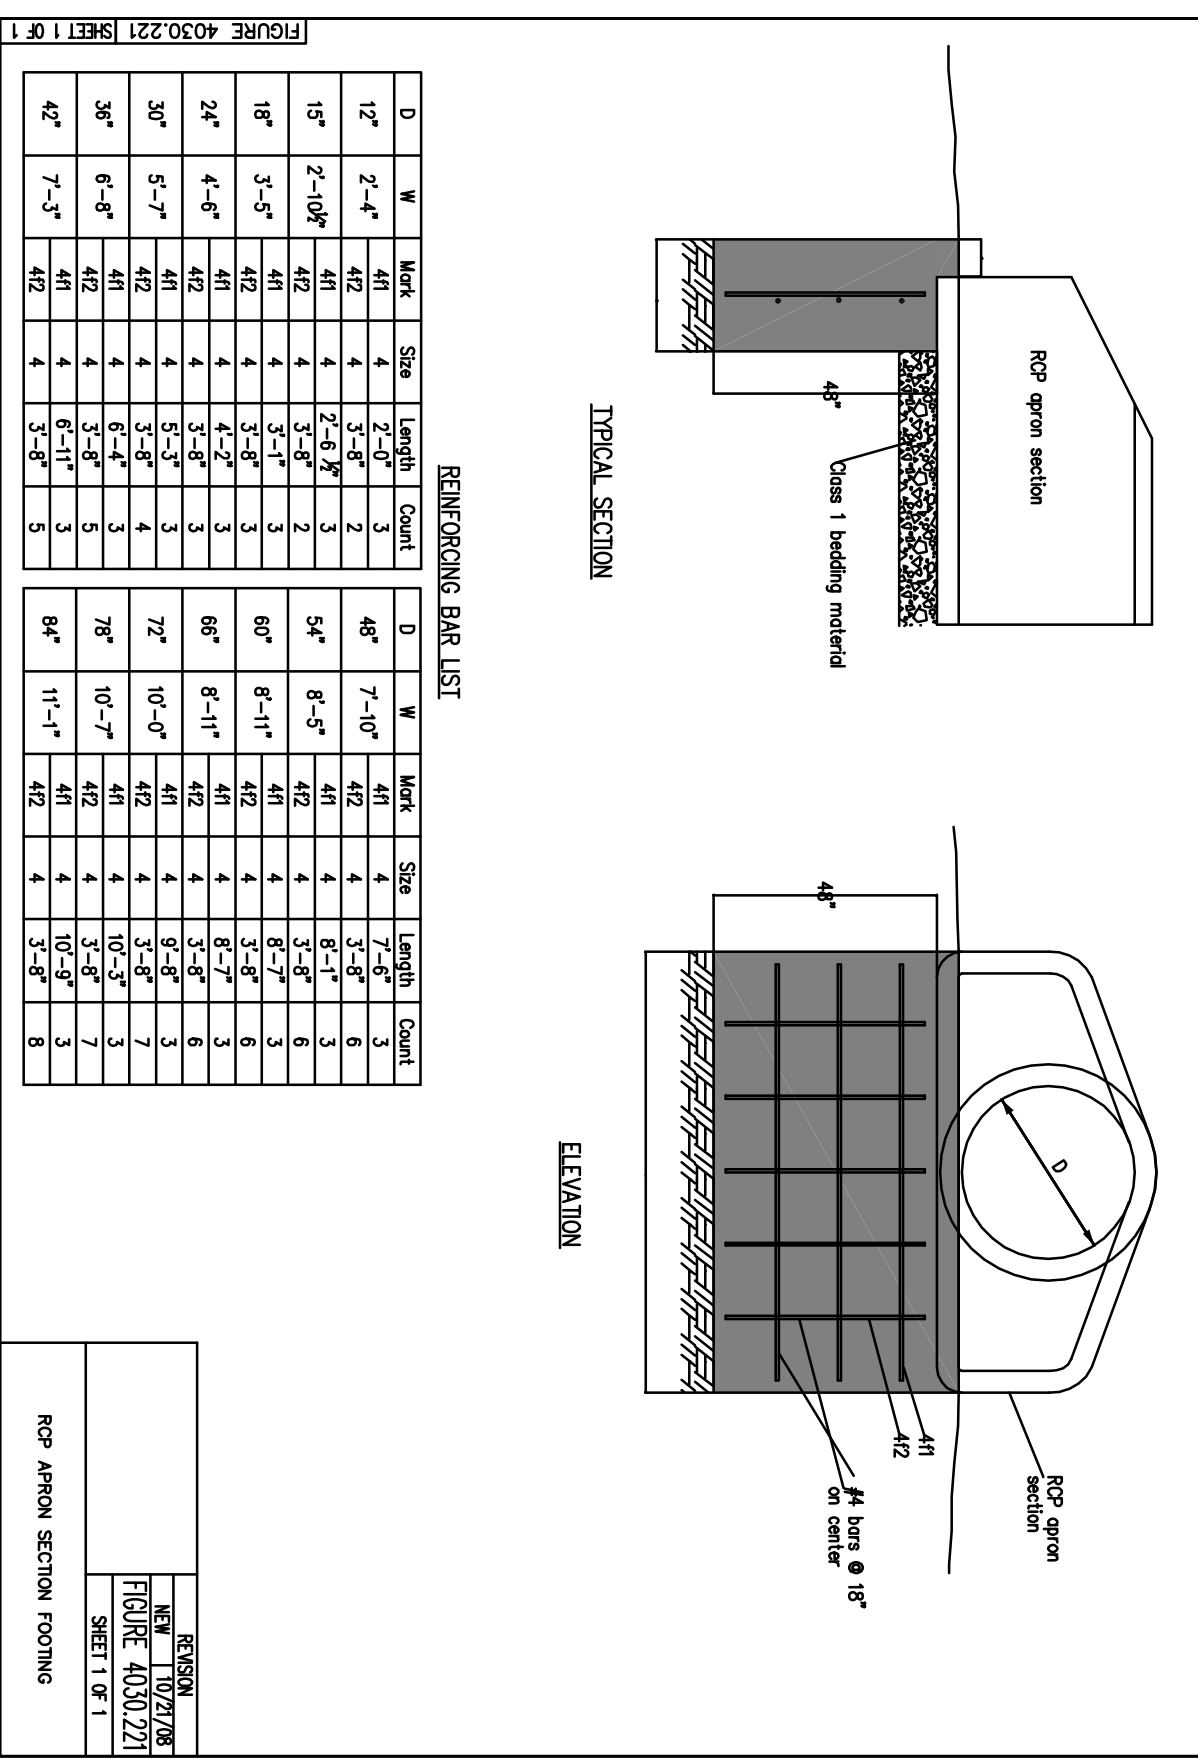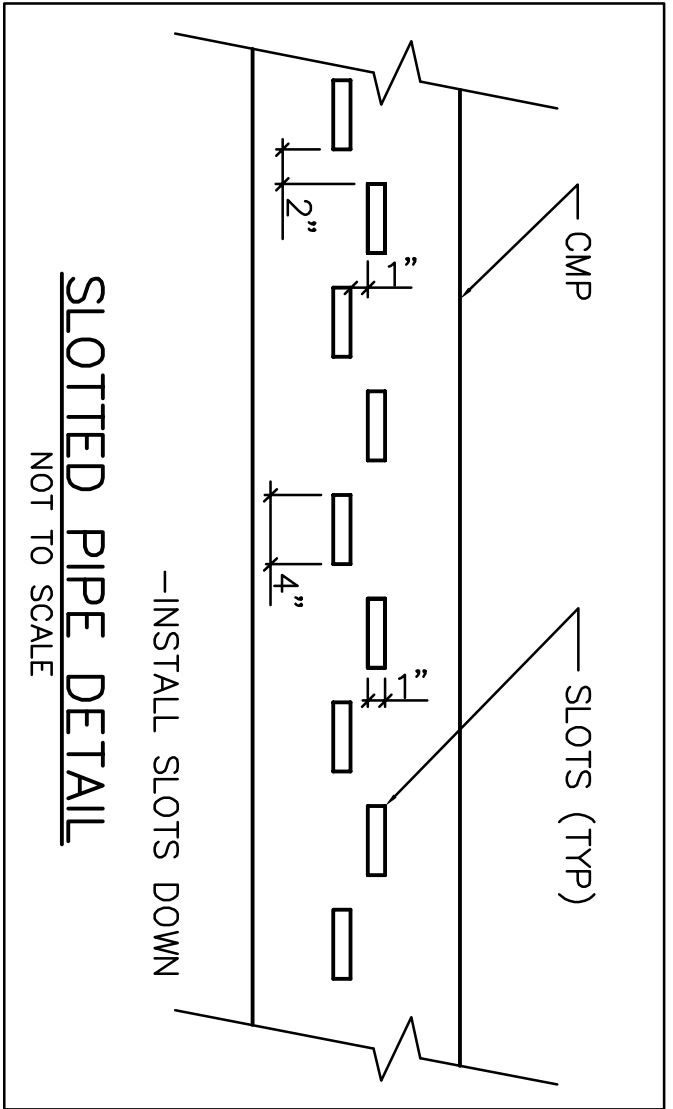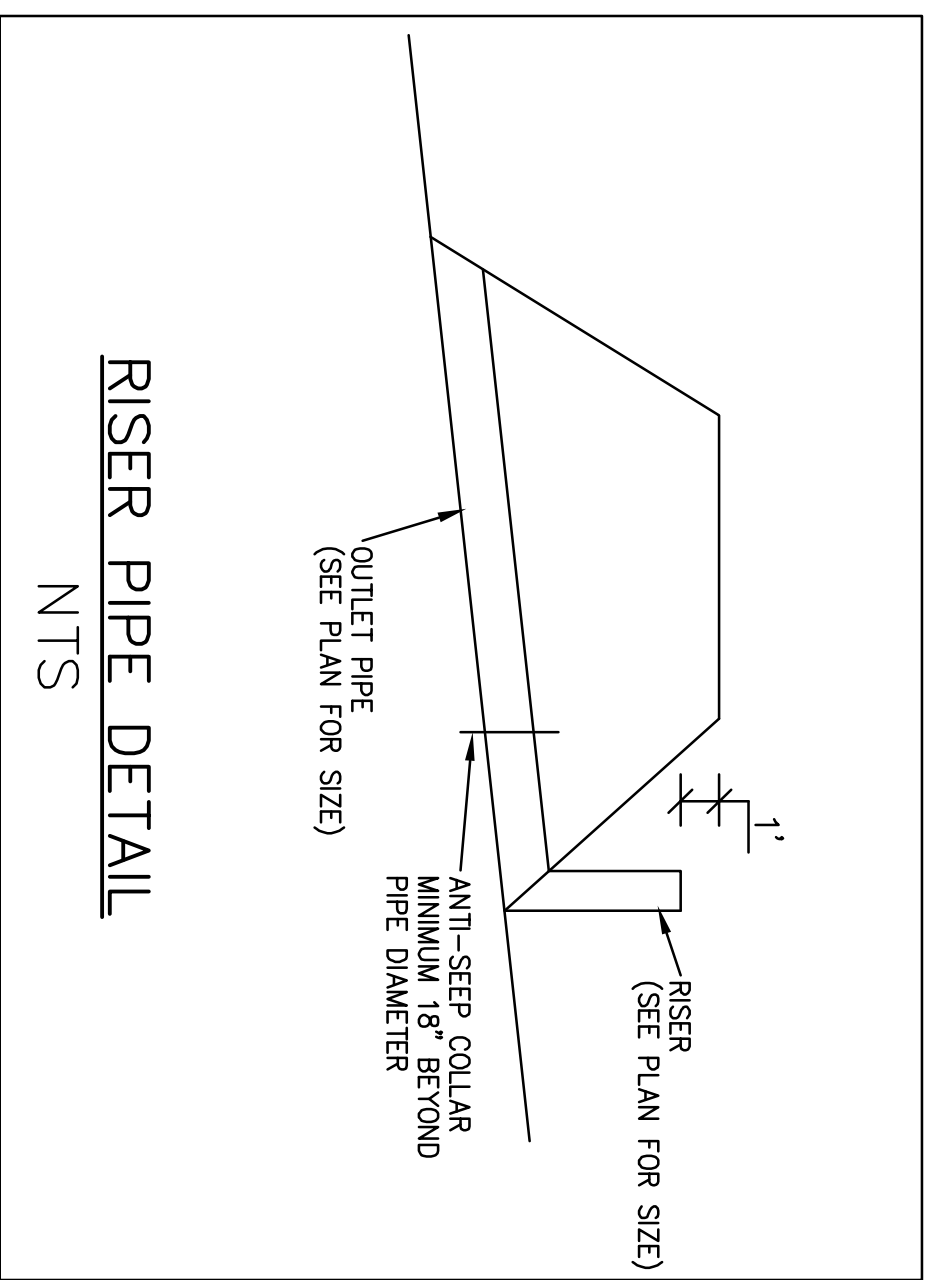

RECORD DRAWING 10