


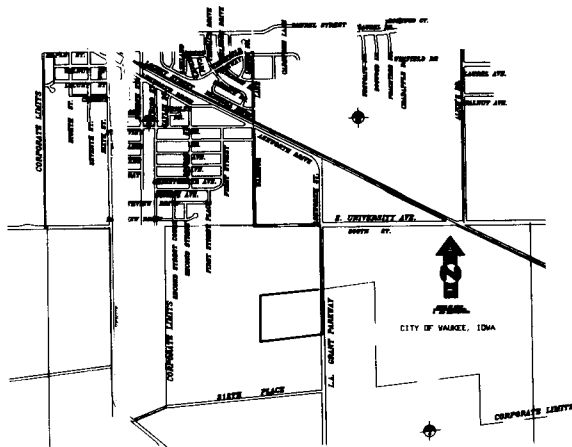

VICINITY MAP

OWNER / DEVELOPER

Boardwalk Development
475 S. 50T
WEST DES MOINES, IOWA 50265
PHONE: (515) 276-6755
PHONE: (515) 276-2793

BENCHMARK

FOUND RR S. KE NORTH FACE POWER POLE
100 FEET WEST OF ASHWORTH DRIVE, SOUTH
OF UNIVERSITY AVENUE.
Elevation 1018.31

SANITARY SEWER SERVICE

SANITARY SEWER CONNECTED TO GLYNN VILLAGE
SANITARY SEWER EXTENDED TO WEST PLAT BOUNDARY OF
THE HEMINGWAY PROPERTY

WATER SERVICE

EXTEND FROM WATER MAIN LOCATED ALONG L. A. GRANT
PARKWAY. STUB TO FUTURE GLYNN VILLAGE DEVELOPMENT
WEST OF HEMINGWAY PROPERTY.

ZONING

R-2

GENERAL NOTES

- CONFIRM LOCATION AND DEPTH OF ALL EXISTING UTILITIES PRIOR TO CONSTRUCTION TO ELIMINATE CONFLICTS. LOCATIONS OF UNDERGROUND UTILITIES ARE PROVIDED BY UTILITY COMPANIES. OWNER AND ENGINEER DO NOT GUARANTEE CORRECTNESS OF ALIGNMENTS SHOWN. CALL (1-800-292-8989) FOR UTILITY LOCATIONS 48 HOURS PRIOR TO DIGGING.
- ANY AND ALL DISCREPANCIES SHALL BE REPORTED TO THE ENGINEER IMMEDIATELY.
- ALL QUANTITIES ARE FOR CONTRACTOR CONVENIENCE. WHERE CONFLICTS OCCUR, DRAWINGS SHALL PREVAIL.
- ALL ELEVATIONS ARE TO CITY DATUM.
- ALL DIMENSIONS ARE PARALLEL OR PERPENDICULAR TO PROPERTY LINES AND FOUNDATION WALLS UNLESS NOTED. WRITTEN DIMENSIONS PREVAIL OVER SCALED DIMENSIONS.
- ALL PAVING AND SITE UTILITY IMPROVEMENTS SHALL COMPLY WITH THE WAUKEE STANDARD SPECIFICATIONS FOR PUBLIC IMPROVEMENTS.
- THE "CONTRACTOR" SHALL NOTIFY THE CITY AND PROJECT ENGINEER ONE WEEK BEFORE CONSTRUCTION BEGINS.
- NO ON SITE DISPOSAL OF TREES AND BRUSH SHALL BE ALLOWED.
- PROVIDE ALL WATER FITTINGS NECESSARY TO MAINTAIN SEPARATION AND ALIGNMENT SHOWN.
- SITE GRADING AND STORMWATER POLLUTION FACILITIES SHALL COMPLY WITH THE SEPARATE SITE DOCUMENT AND NPDES PERMIT NO. 8956-8786.

LEGAL DESCRIPTION

Government Lot 9 in Section 5, Township 78 North, Range 26 West of the 5th P.M., Dallas County, Iowa; more particularly described as follows:

Commencing at the Northeast Corner of said Section 5, Township 78 North, Range 26 West; thence S 00°(Degrees)05'(Minutes)53"(Seconds) W for 1850.55 feet to the Northeast Corner of said Government Lot 8 and being the Point-of-Beginning; thence S 00°05'42" W along the east side of said Section 5 for 1310.89 feet to the Southeast corner of said Government Lot 8; thence S 83°06'57" W for 1319.28 feet to the Southwest corner of said Government Lot 8; thence N 00°06'01" E for 1308.20 feet to the Northwest corner of said Government Lot 8; thence N 82°59'32" E for 1278.85 feet; thence N 83°22'59" E for 40.04 feet to the Northeast corner of Government Lot 8 and being the Point-of-Beginning. This parcel contains 39.35 acres and is subject to easements of record.

PLANS FOR HEMINGWAY

PLAT 1

WAUKEE, IOWA

2005

Contractor Contact
McAninch Randy Cole
Tim Tomitich

QUANTITY ESTIMATE

NO.	ITEM	QUAN	UNIT
1.	7" NON-REINFORCED PCC PAVEMENT	16876	SY
2.	8" NON-REINFORCED PCC PAVEMENT	5057	SY
3.	SUBGRADE PREPARATION	25220	SY
4.	8" SANITARY SEWER	5891	LF
5.	TYPE "A" SANITARY MANHOLE	24	EA
6.	SANITARY SERVICES	117	EA
7.	8" WATER MAIN	6677	LF
8.	8" VALVE	21	EA
9.	HYDRANT, (COMPLETE)	20	EA
10.	8" X 12" TAPPING VALVE & SLEEVE	1	EA
11.	TEMPORARY BLOWOFF	3	EA
12.	WATER SERVICES	117	EA
13.	8" SUMPLINE	2219	LF
14.	15" STORM SEWER	2851	LF
15.	18" STORM SEWER	1079	LF
16.	21" STORM SEWER	193	LF
17.	24" STORM SEWER	1158	LF
18.	STANDARD STORM MANHOLE	9	EA
19.	SHALLOW STORM MANHOLE	5	EA
20.	TYPE A CURB INTAKE	10	EA
21.	TYPE B CURB INTAKE	3	EA
22.	TYPE C CURB INTAKE	15	EA
23.	TYPE D CURB INTAKE	3	EA
24.	TYPE C AREA INTAKE	2	EA
25.	CLEAN-OUT	8	EA
26.	15" FES	3	EA
27.	18" FES W/FTG	1	EA
28.	24" FES	1	EA
29.	24" FES W/FTG	3	EA
30.	SUMPLINE SERVICES	117	EA
31.	SEED/MULCH	30	AC
32.	SILT FENCE	1000	LF
33.	PAVED INVERT	435	LF
34.	TEMPORARY TURN AROUND	2	EA
35.	10" X 5" PCC BIKEWAY	1280	LF

THE CONTRACTOR SHALL BE RESPONSIBLE FOR ALL QUANTITY ITEMS NECESSARY TO COMPLY WITH THESE PLANS. ADDITIONAL ITEMS NOT INCLUDED IN THE QUANTITY ESTIMATE MAY BE NECESSARY IN ORDER TO COMPLETE CONSTRUCTION IN COMPLIANCE WITH THE DETAILED PLANS. IN THE EVENT THERE ARE ANY DISCREPANCIES BETWEEN THE QUANTITY ESTIMATE AND THE DETAILED PLANS, THE DETAILED PLANS SHALL GOVERN.

- 8" PAVEMENT IN SE PLEASANT VIEW DRIVE AND L.A. GRANT PARKWAY

LEGEND

EXISTING / PROPOSED

●	○	PROPERTY CORNER
▲	▲	GOVERNMENT MONUMENT
---	---	PROPERTY BOUNDARY
P.	P.	PLATTED DISTANCE
M.	M.	MEASURED DISTANCE
D.	D.	DEEDED DISTANCE
#0000	#0000	ADDRESS
W 8" W	W 8" W	WATER MAIN AND SIZE
S 8" SAN	S 8" SAN	SANITARY SEWER AND SIZE
12" ST	12" ST	STORM SEWER AND SIZE
EAS 6" GAS	EAS 6" GAS	GAS MAIN AND SIZE
CHP	CHP	OVERHEAD ELECTRIC
UG	UG	UNDERGROUND ELECTRIC
UT	UT	UNDERGROUND TELEPHONE
□	□	STORM SEWER INTAKES
○	○	FLARED END SECTION
○	○	MANHOLE
○	○	CLEANOUT
○	○	FIRE HYDRANT
○	○	WATER VALVE
○	○	LIGHT POLE
○	○	POWER POLE
P.U.E.	P.U.E.	PUBLIC UTILITY EASEMENT
F.F.E.	F.F.E.	FINISHED FLOOR ELEVATION
→	→	DIRECTION OF DRAINAGE
+100'	+100'	TOP OF CURB SPOT ELEVATION
+100'	+100'	FINISHED GRADE SPOT ELEVATION
+100'	+100'	TOP OF SLAB SPOT ELEVATION
---	---	SILT FENCE
---	---	CONCRETE SURFACE
---	---	ASPHALT SURFACE
---	---	GRAVEL SURFACE
100	100	CONTOUR LINE

As-Built Survey



I HEREBY CERTIFY THAT THIS PLAN, SPECIFICATION OR REPORT WAS PREPARED BY ME OR UNDER MY DIRECT PERSONAL SUPERVISION AND THAT I AM A LICENSED PROFESSIONAL ENGINEER UNDER THE LAWS OF THE STATE OF IOWA.
DATE 4/27/05
LARRY J. RICHARDS, P.E. & L.S. IOWA REG. NO. 7059
MY REGISTRATION RENEWAL IS DECEMBER 31, 2008.


eds
ENGINEERING DESIGN SERVICES
14225 UNIVERSITY AVE. SUITE 220, WAUKEE, IOWA 50263
PH: (515) 221-1322 / FAX: (515) 221-1005

REVISIONS
DATE: 4.25.2005
COMMENTS OF



COVER SHEET

HEMINGWAY

DWG. NO. 1 OF 23
SCALE: 1" = 20'
JOB NO. 20-134
www.edsgroupinc.com

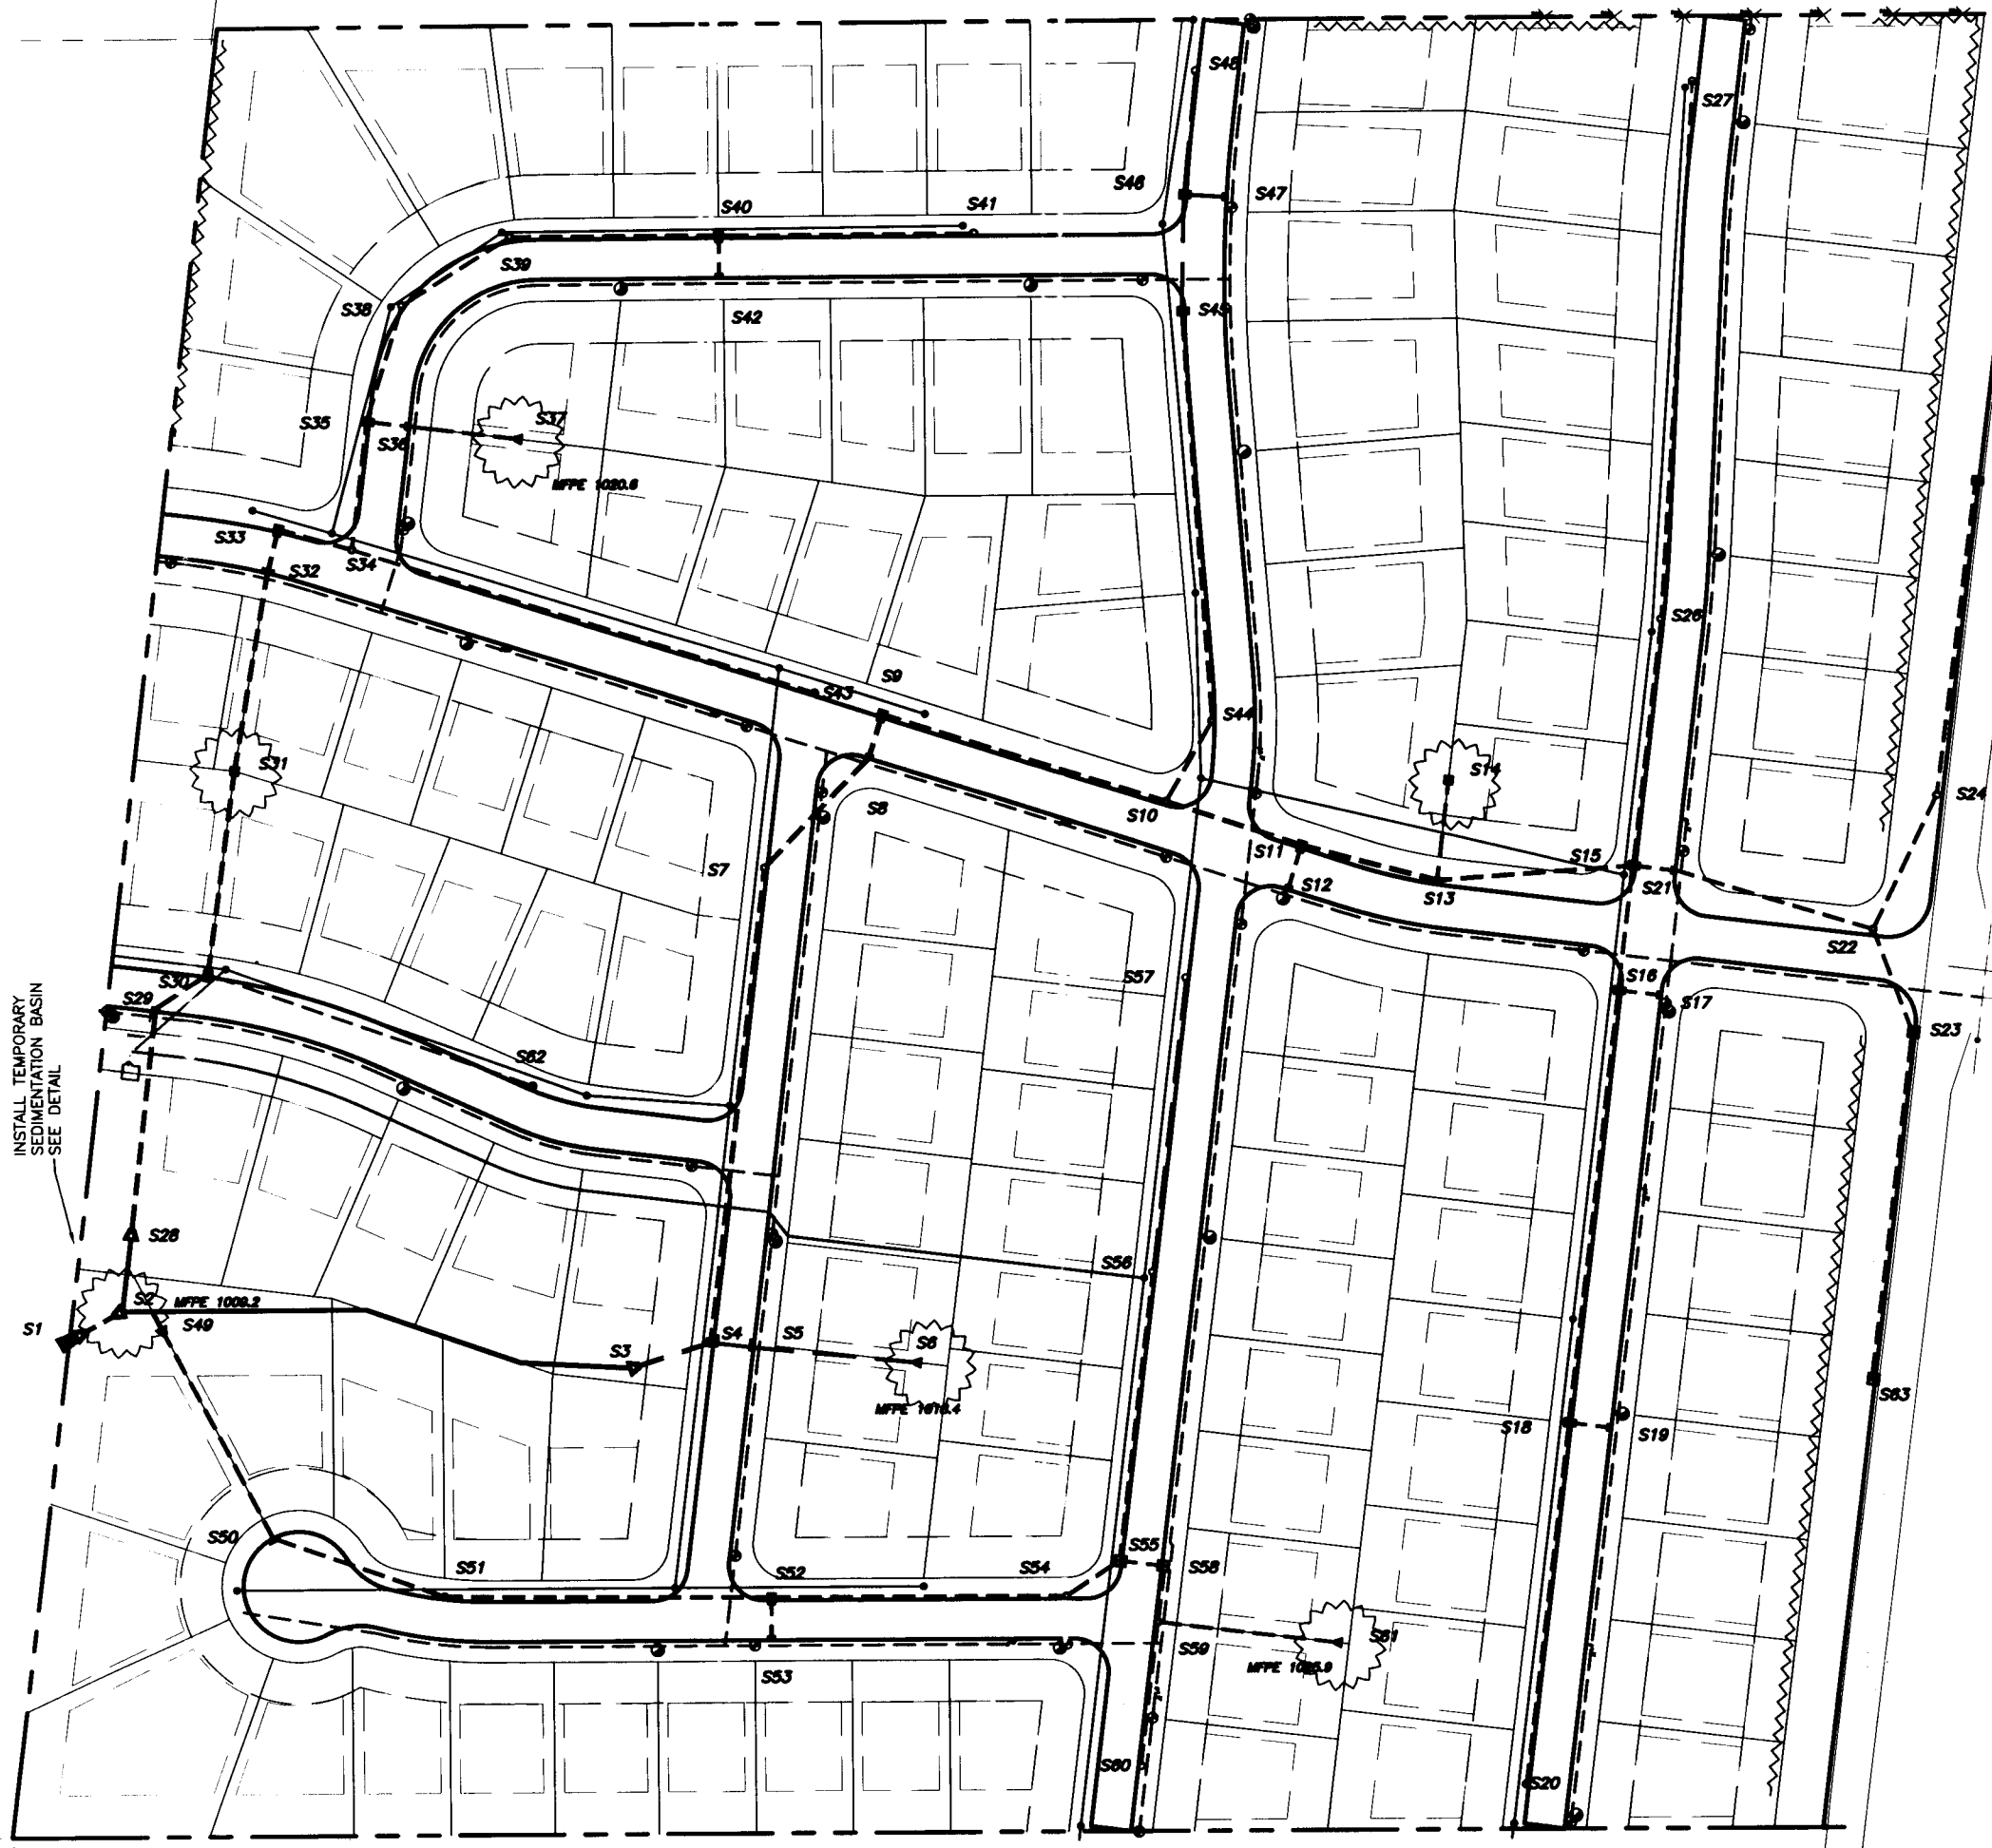

- ### LEGEND
- EXISTING / PROPOSED
- PROPERTY CORNER
 - GOVERNMENT MONUMENT
 - PROPERTY BOUNDARY
 - PLATTED DISTANCE
 - MEASURED DISTANCE
 - DEEDED DISTANCE
 - ADDRESS
 - WATER MAIN & SIZE
 - SANITARY SEWER & SIZE
 - STORM SEWER & SIZE
 - GAS MAIN & SIZE
 - ELECTRIC
 - TELEPHONE
 - STORM SEWER INTAKE
 - FLARED END SECTION
 - MANHOLE
 - FIRE HYDRANT
 - WATER VALVE
 - LIGHT POLE
 - POWER POLE
 - PUBLIC UTILITY EASEMENT
 - SURFACE WATER FLOWAGE EASEMENT
 - STORM SEWER EASEMENT
 - SANITARY SEWER EASEMENT
 - FINISHED FLOOR ELEVATION
 - CONTOUR LINE
 - DIRECTION OF DRAINAGE
 - SPOT ELEVATION TOP OF CURB
 - SPOT ELEVATION FINISHED GRADE
 - SPOT ELEVATION TOP OF SLAB
 - SIDEWALK
 - SILT FENCE
 - CONCRETE SURFACE
 - ASPHALT SURFACE
 - GRAVEL SURFACE

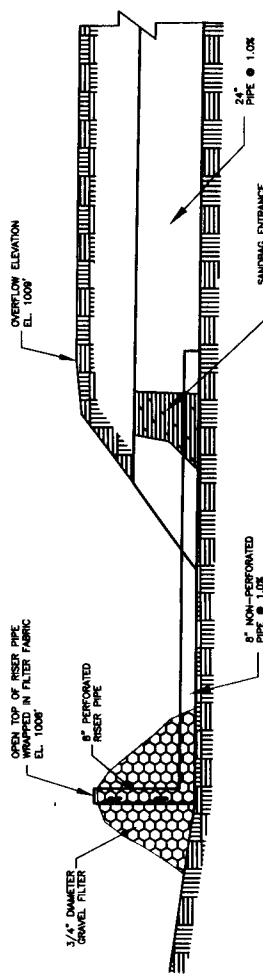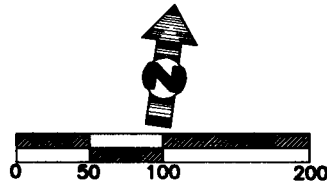

SEDIMENTATION BASIN OUTLET DETAIL
NO SCALE

eds
ENGINEERING DESIGN SERVICES
14225 UNIVERSITY AVE. SUITE 220 - WAUKEE, IOWA 50263
PH. (515) 221-1322 / FAX (515) 221-1005

DATE: _____
DRAWN: _____
CHECKED: _____
DATE: _____

DWG. NO. 2 OF 23
SCALE: 1" = 60'
JOB NO. 20-134

HEMINGWAY
www.edsgroup.com





I HEREBY CERTIFY THAT THIS PLAN, MAP, SURVEY OR REPORT WAS PREPARED BY ME OR UNDER MY DIRECT PERSONAL SUPERVISION AND THAT I AM A LICENSED PROFESSIONAL ENGINEER UNDER THE LAWS OF THE STATE OF IOWA.
SIGNATURE: _____
DATE: _____
NAME: LARRY A. EDWARDS, P.E. & L.S. IOWA REG. NO. 7006
MY LICENSE EXPIRES DECEMBER 31, 2008.

ALL STREET GRADES ARE TOP OF CURB
STATION ELEVATION

SOUTH CURB
0+15.50 1032.21 -1.34%
0+25.00 1031.88
0+50.00 1031.74

NORTH CURB
0+15.50 1031.85 -0.80%
0+40.50 1031.80
0+50.00 1031.74
0+75.00 1031.59
1+00.00 1031.44
1+25.00 1031.29
1+50.00 1031.14
1+75.00 1030.99
2+00.00 1030.84
2+25.00 1030.69
2+50.00 1030.54
2+75.00 1030.39
3+00.00 1030.24
3+25.00 1030.09
3+50.00 1029.94
3+75.00 1029.79
4+00.00 1029.64
4+25.00 1029.49
4+50.00 1029.34
4+75.00 1029.19
5+00.00 1029.04

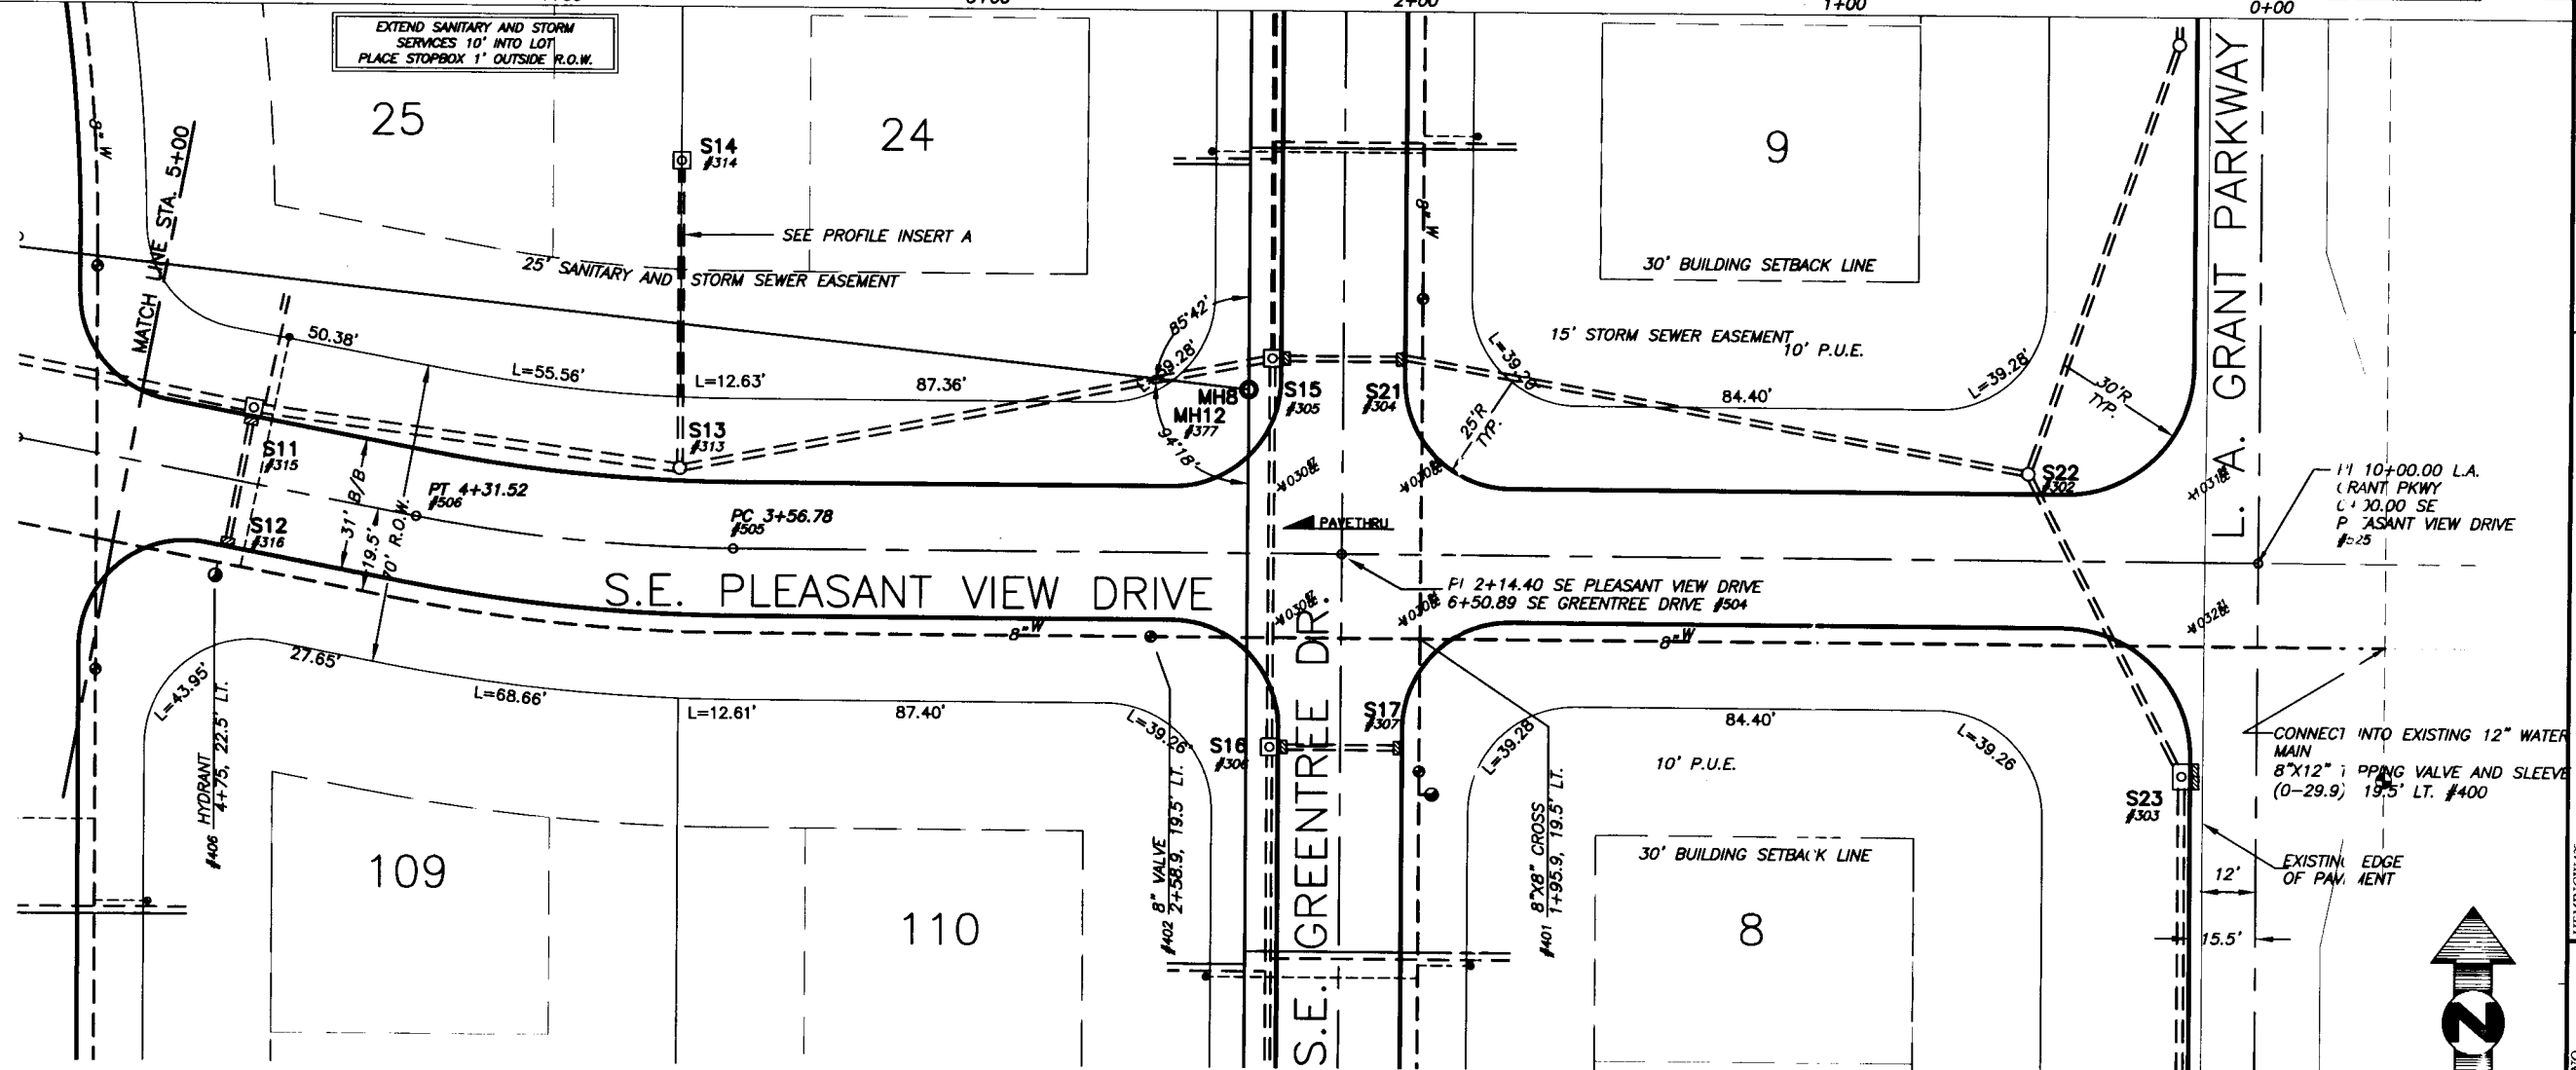
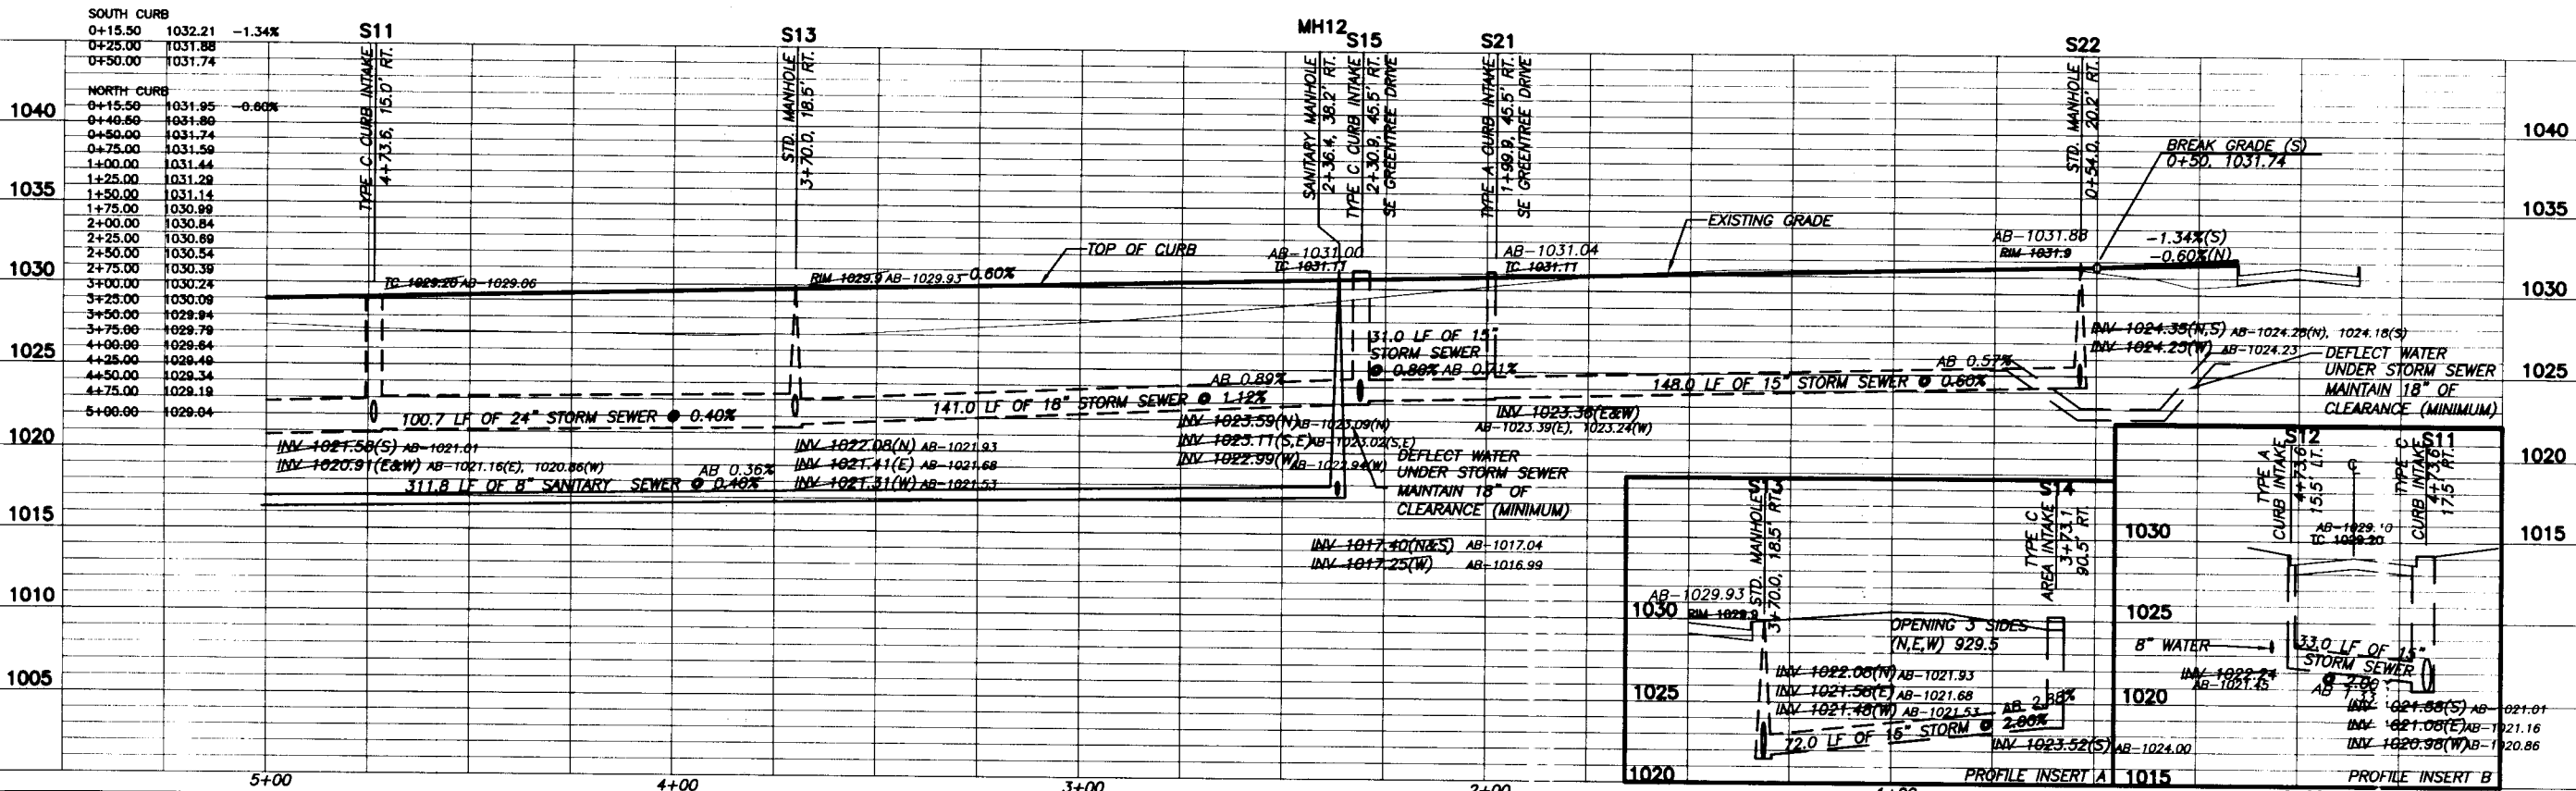


LARRY J. RICHARDS, P.E. & L.S. IOWA REG. NO. 7068
DATE
I hereby certify that I am a duly licensed professional engineer under the laws of the State of Iowa.
DRAWN
DATE

eds
ENGINEERING DESIGN SERVICES
14225 UNIVERSITY AVE. SUITE 220 - WAUKESHA, IOWA 50663
PH: (515) 231-1322 FAX: (515) 231-1005

REVISIONS
DATE
DRAWN
DATE

SE PLEASANT VIEW DRIVE
3 OF 23
SCALE: 1" = 20'
TODNO: 20-134
www.hemingtonengineering.com

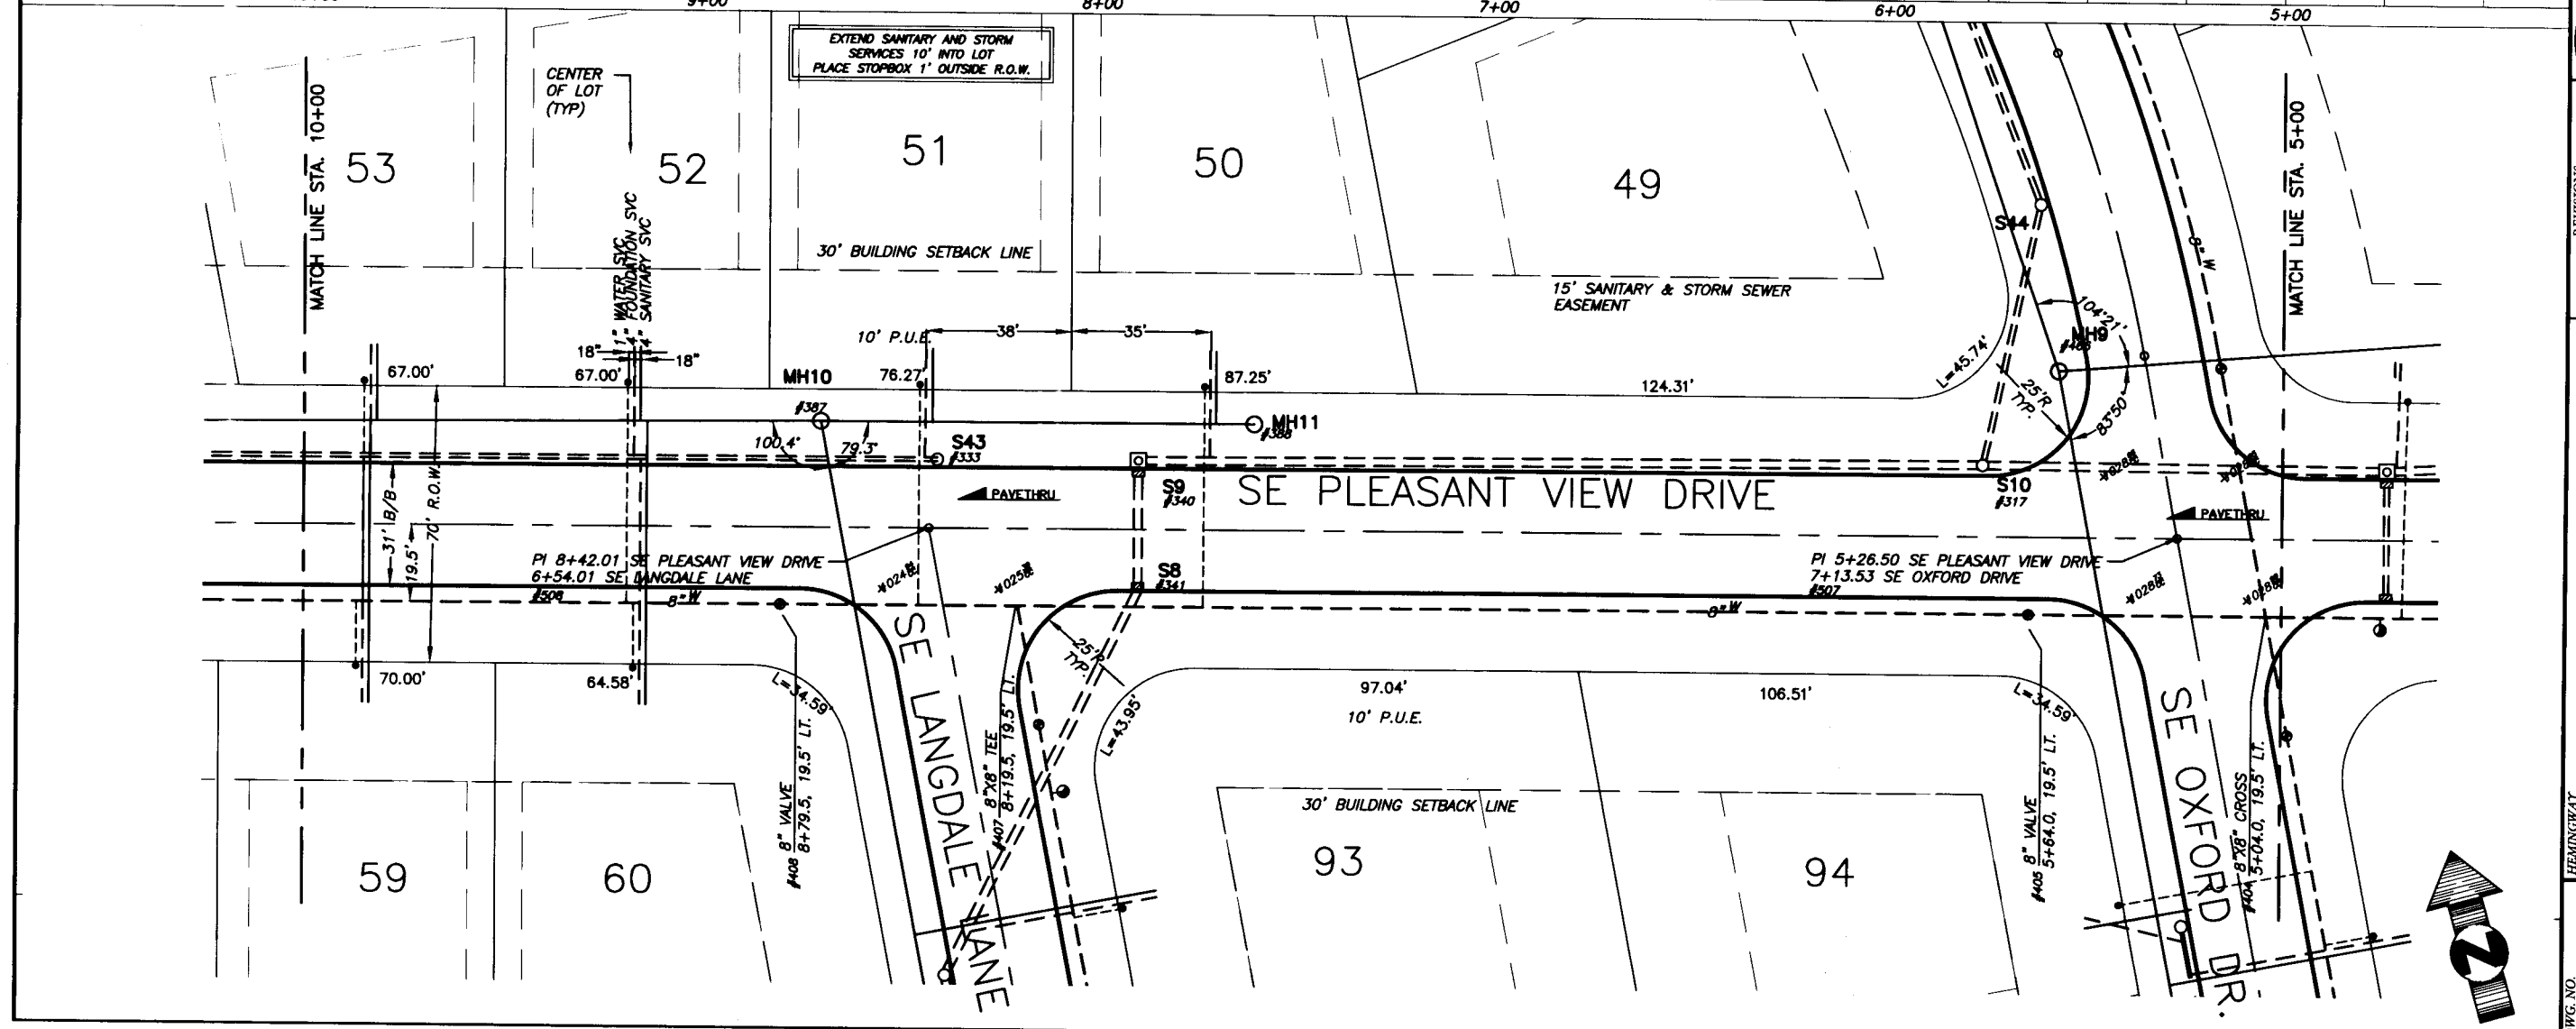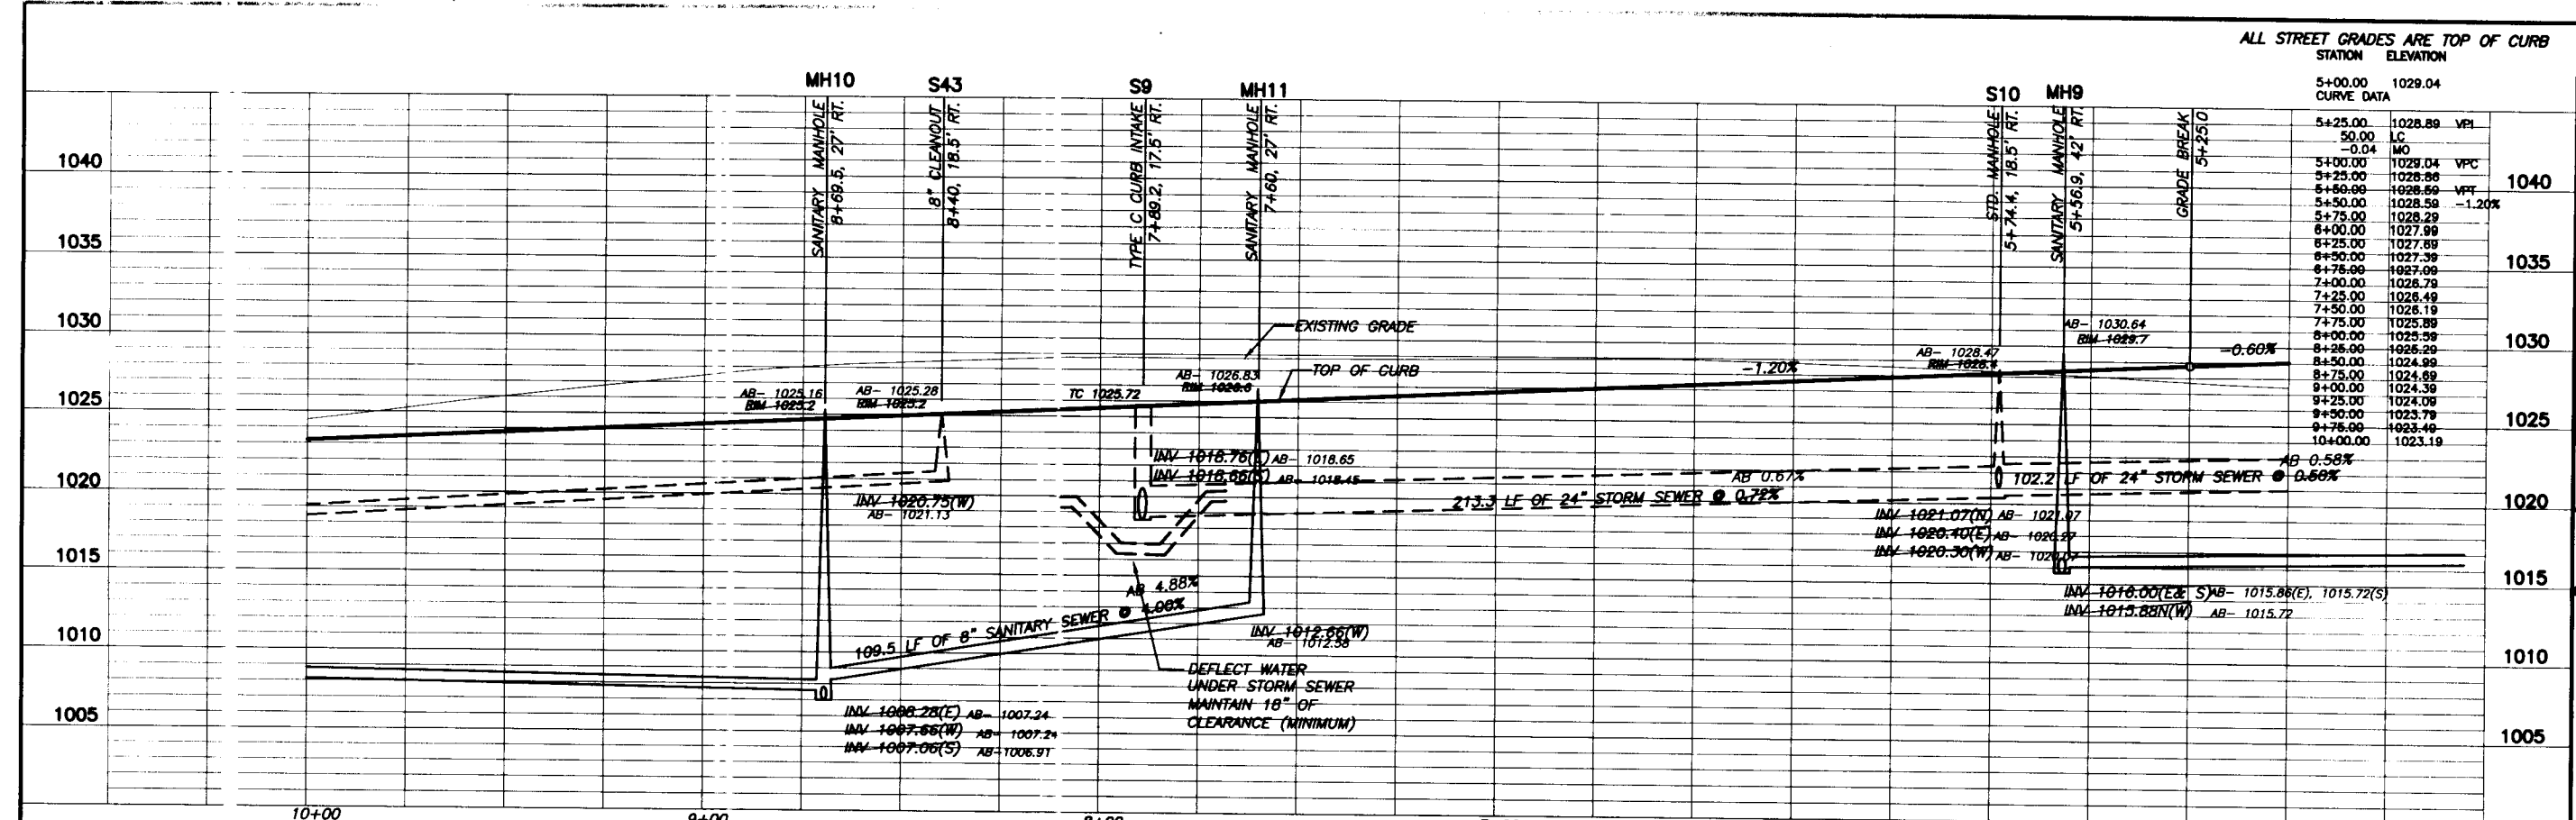

ALL STREET GRADES ARE TOP OF CURB
STATION ELEVATION

5+00.00 1029.04
CURVE DATA

5+25.00 1028.89 VPI
5+50.00 1028.04 VPC
5+75.00 1028.59 VPT
6+00.00 1027.99 -1.20%
6+25.00 1027.89
6+50.00 1027.39
6+75.00 1026.99
7+00.00 1026.79
7+25.00 1026.49
7+50.00 1026.19
7+75.00 1025.89
8+00.00 1025.59
8+25.00 1025.29
8+50.00 1024.99
8+75.00 1024.69
9+00.00 1024.39
9+25.00 1024.09
9+50.00 1023.79
9+75.00 1023.49
10+00.00 1023.19

1040
1035
1030
1025
1020
1015
1010
1005

1040
1035
1030
1025
1020
1015
1010
1005

SE PLEASANT VIEW DRIVE
1425 UNIVERSITY AVE. SUITE 200 - WAUKESHA, IOWA 50263
PH: (515) 221-1321 FAX: (515) 221-1095

EDS
ENGINEERING DESIGN SERVICES

1425 UNIVERSITY AVE. SUITE 200 - WAUKESHA, IOWA 50263
PH: (515) 221-1321 FAX: (515) 221-1095

DATE: 4/28/05

DATE: 4/28/05

REVISIONS

DATE: 4/28/05

4 OF 23

SCALE: 1" = 20'



JOB NO. 20-134

DWG. NO. HEMINGWAY

4 OF 23

SCALE: 1" = 20'

JOB NO. 20-134

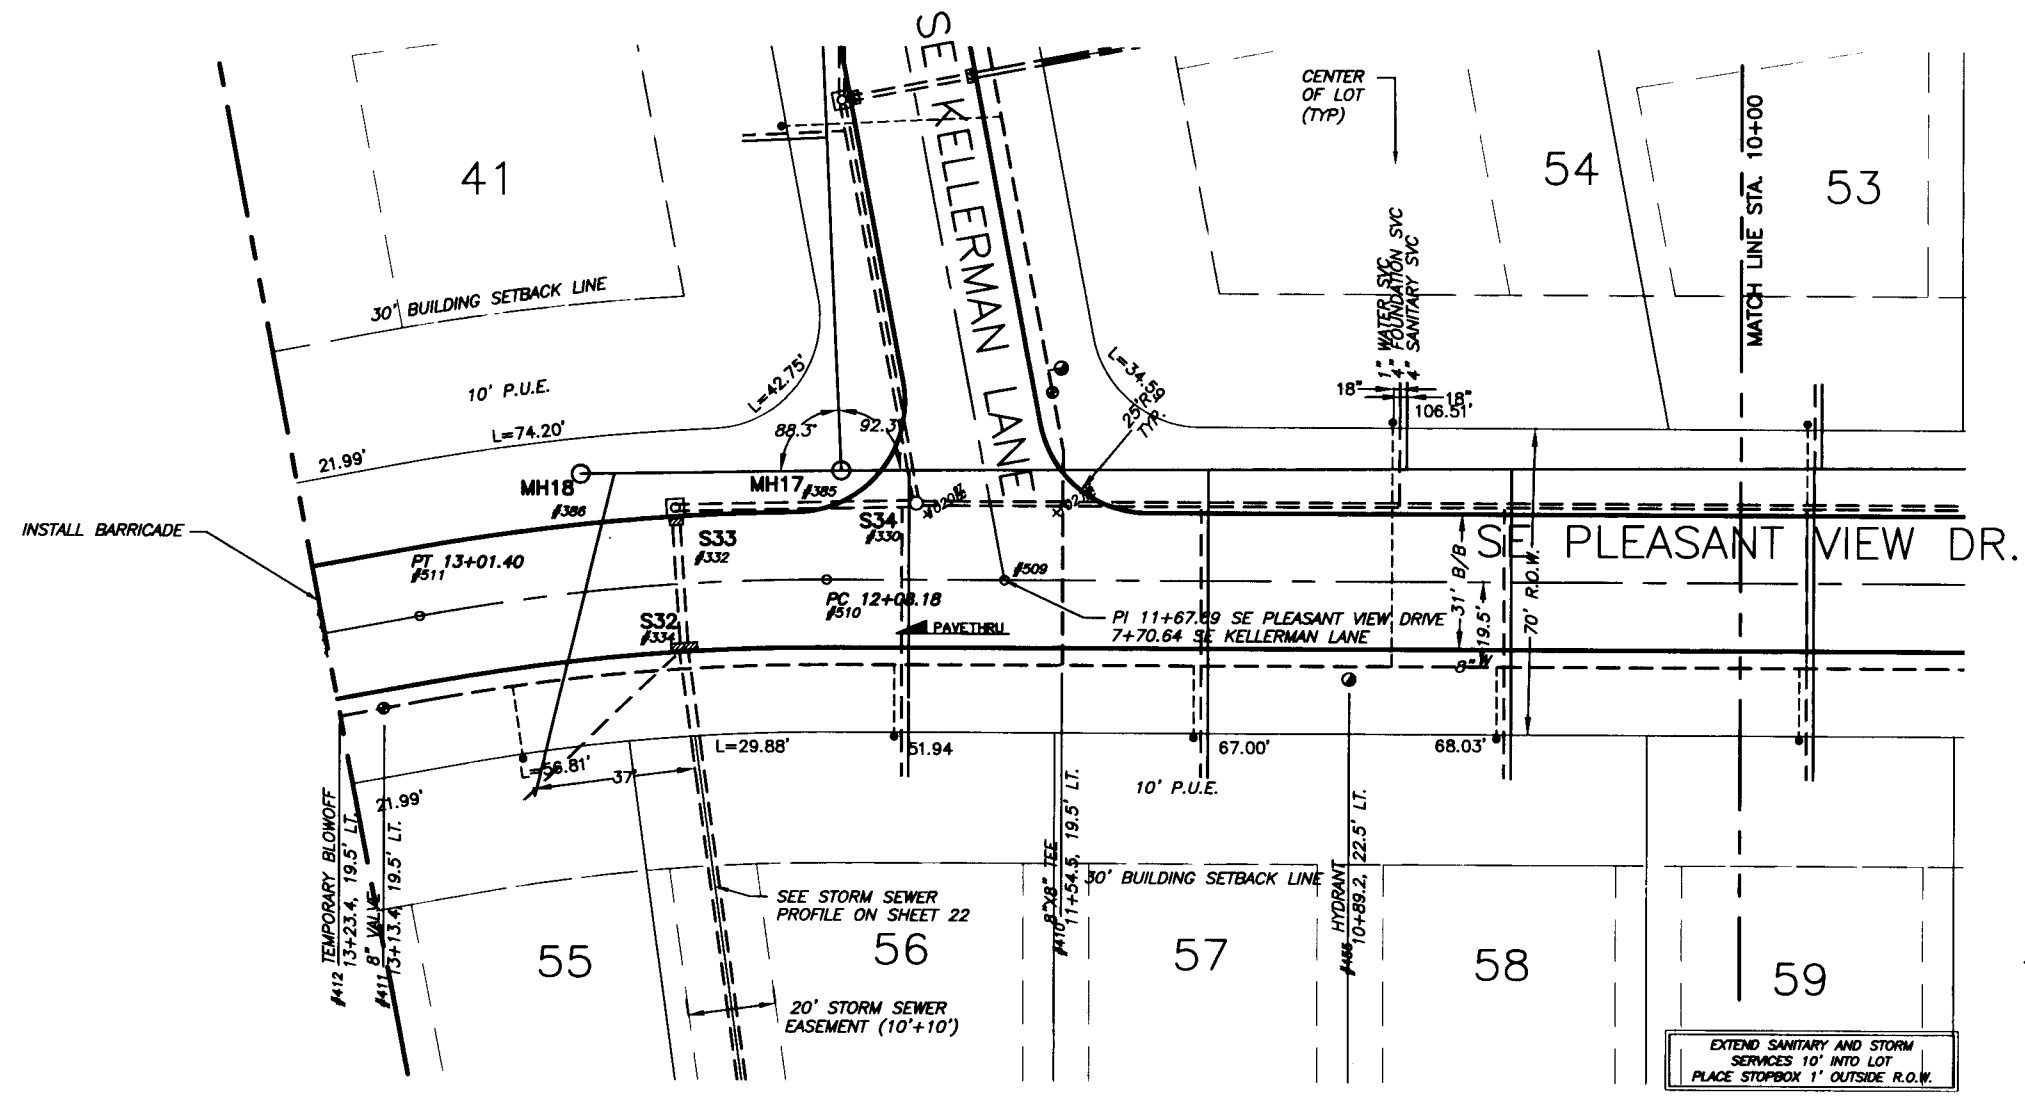
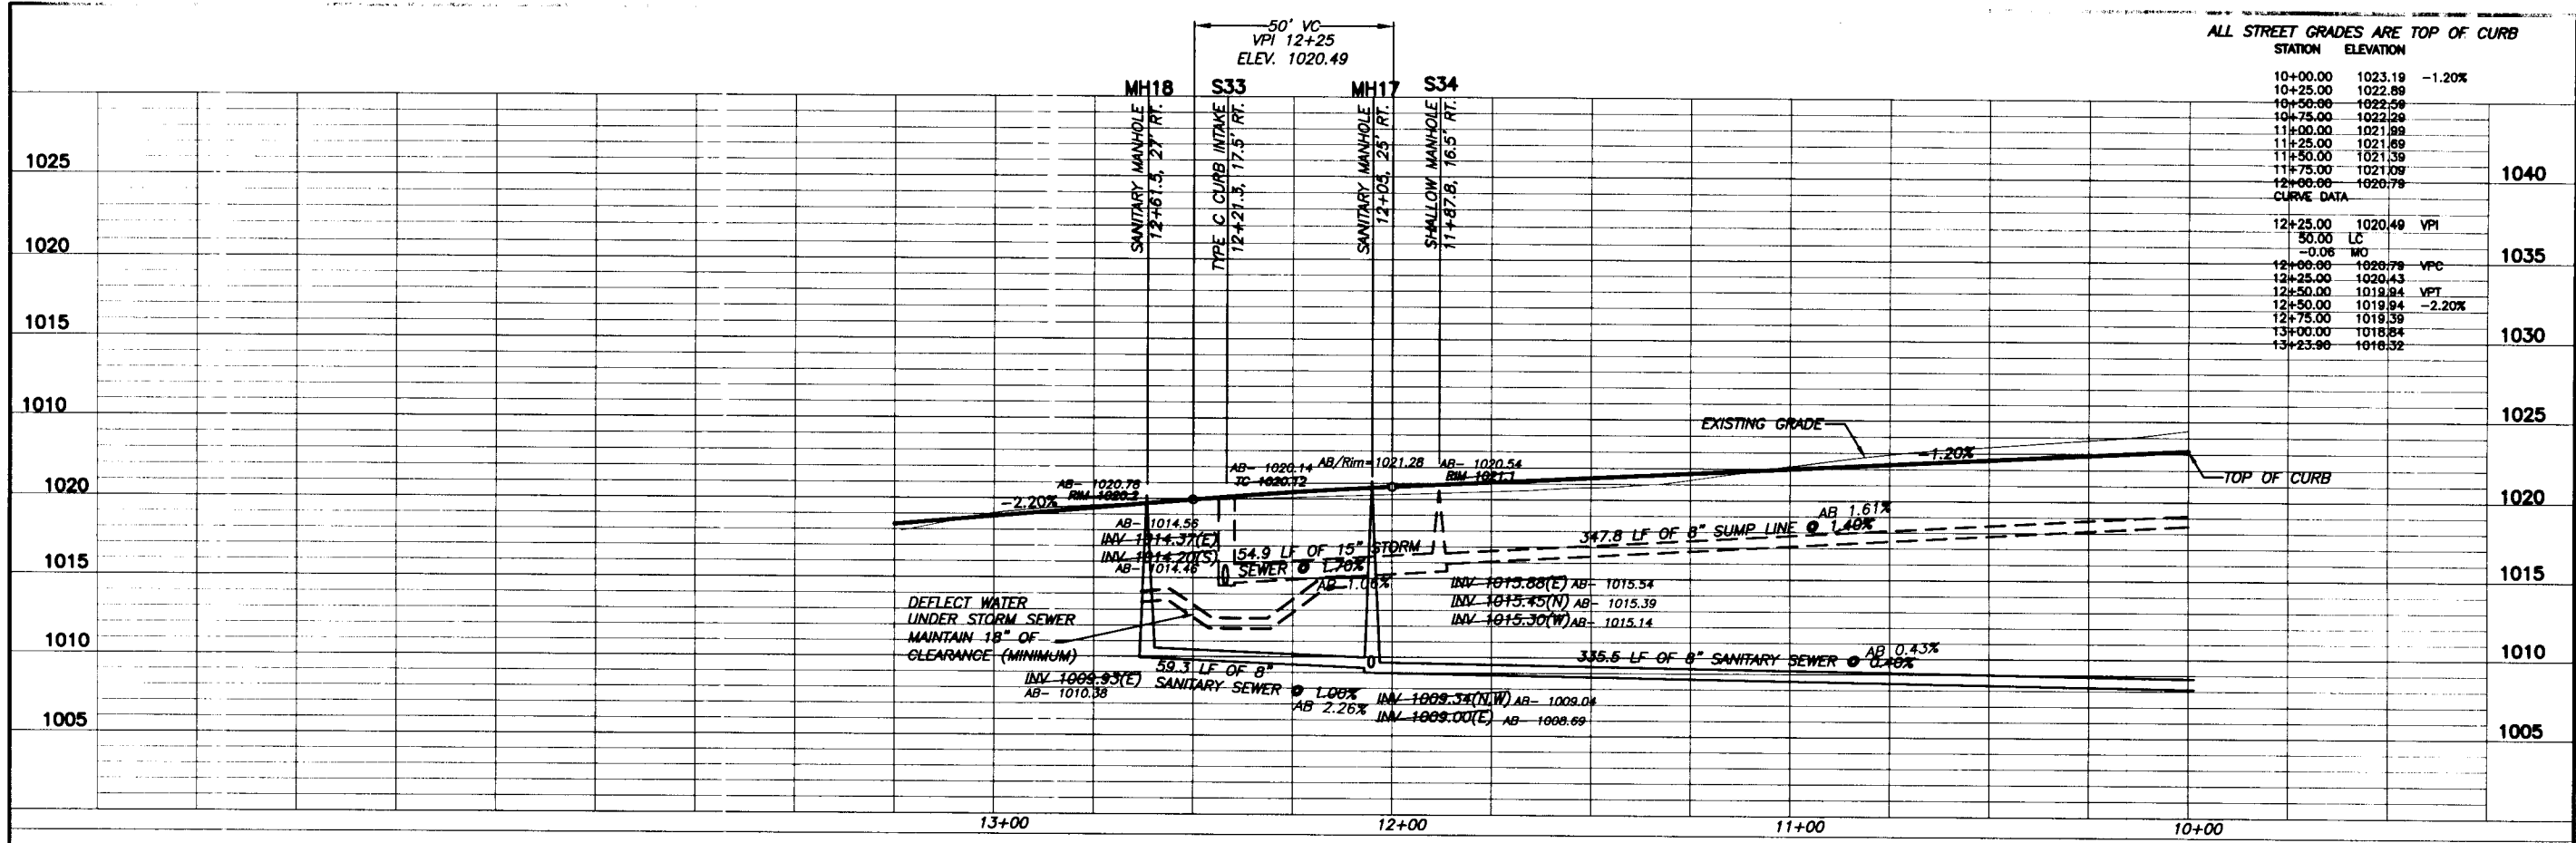


eds
ENGINEERING DESIGN SERVICES
 1425 UNIVERSITY AVE. SUITE 220 - WAUKEE, IOWA 50263
 PH: (515) 221-1322 FAX: (515) 221-1005

REVISIONS
 DATE: _____
 DRAWN: _____
 CHECKED: _____
 DATE: _____

SE PLEASANT VIEW DRIVE
 HEMINGWAY

5 OF 23
 SCALE: 1" = 20'
 JOB NO. 20-134
 www.engineeringdesignservices.net

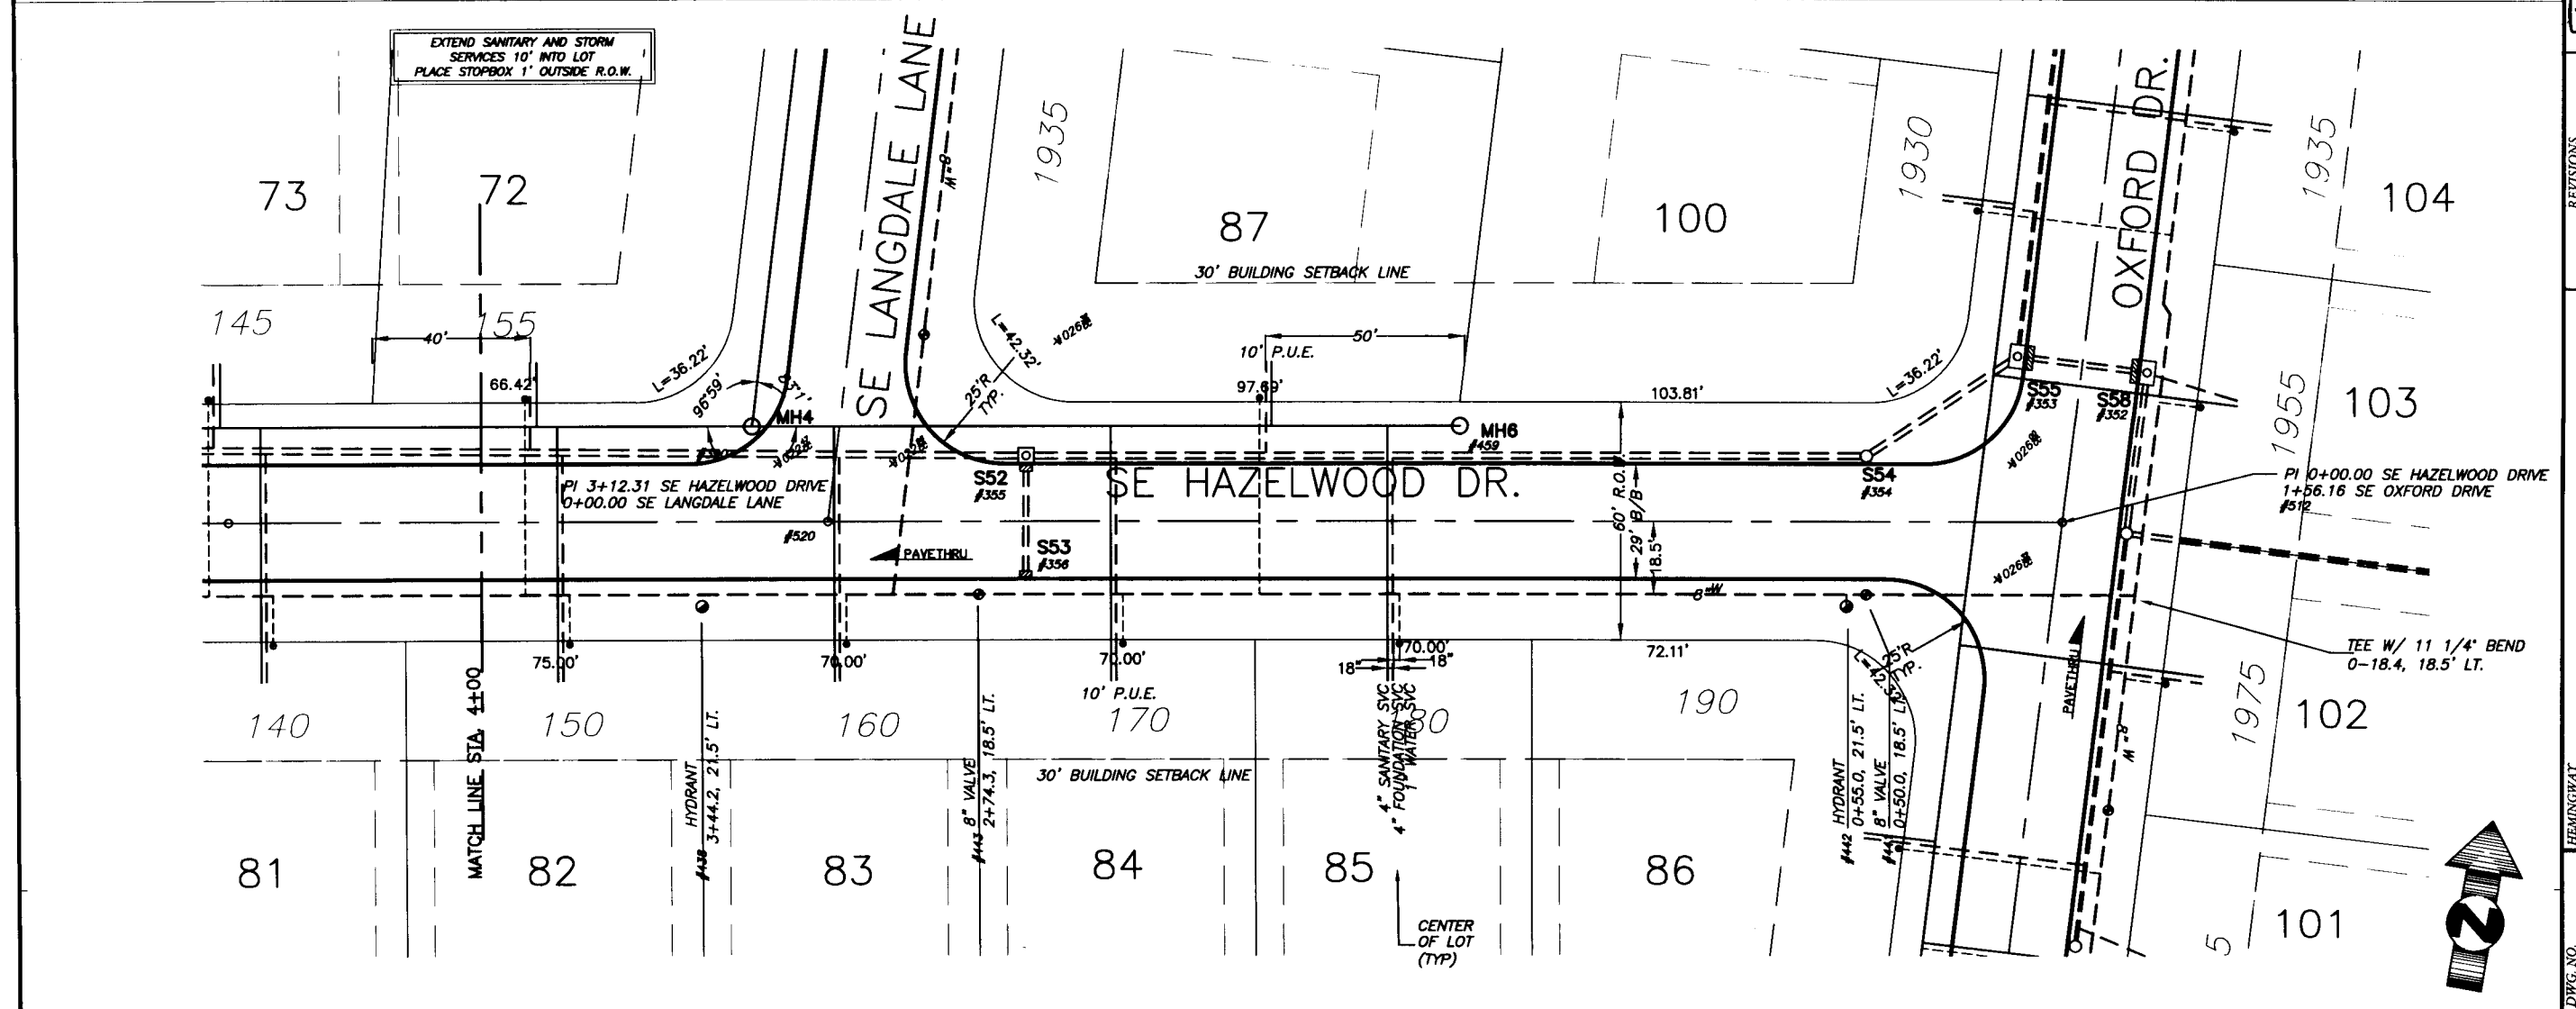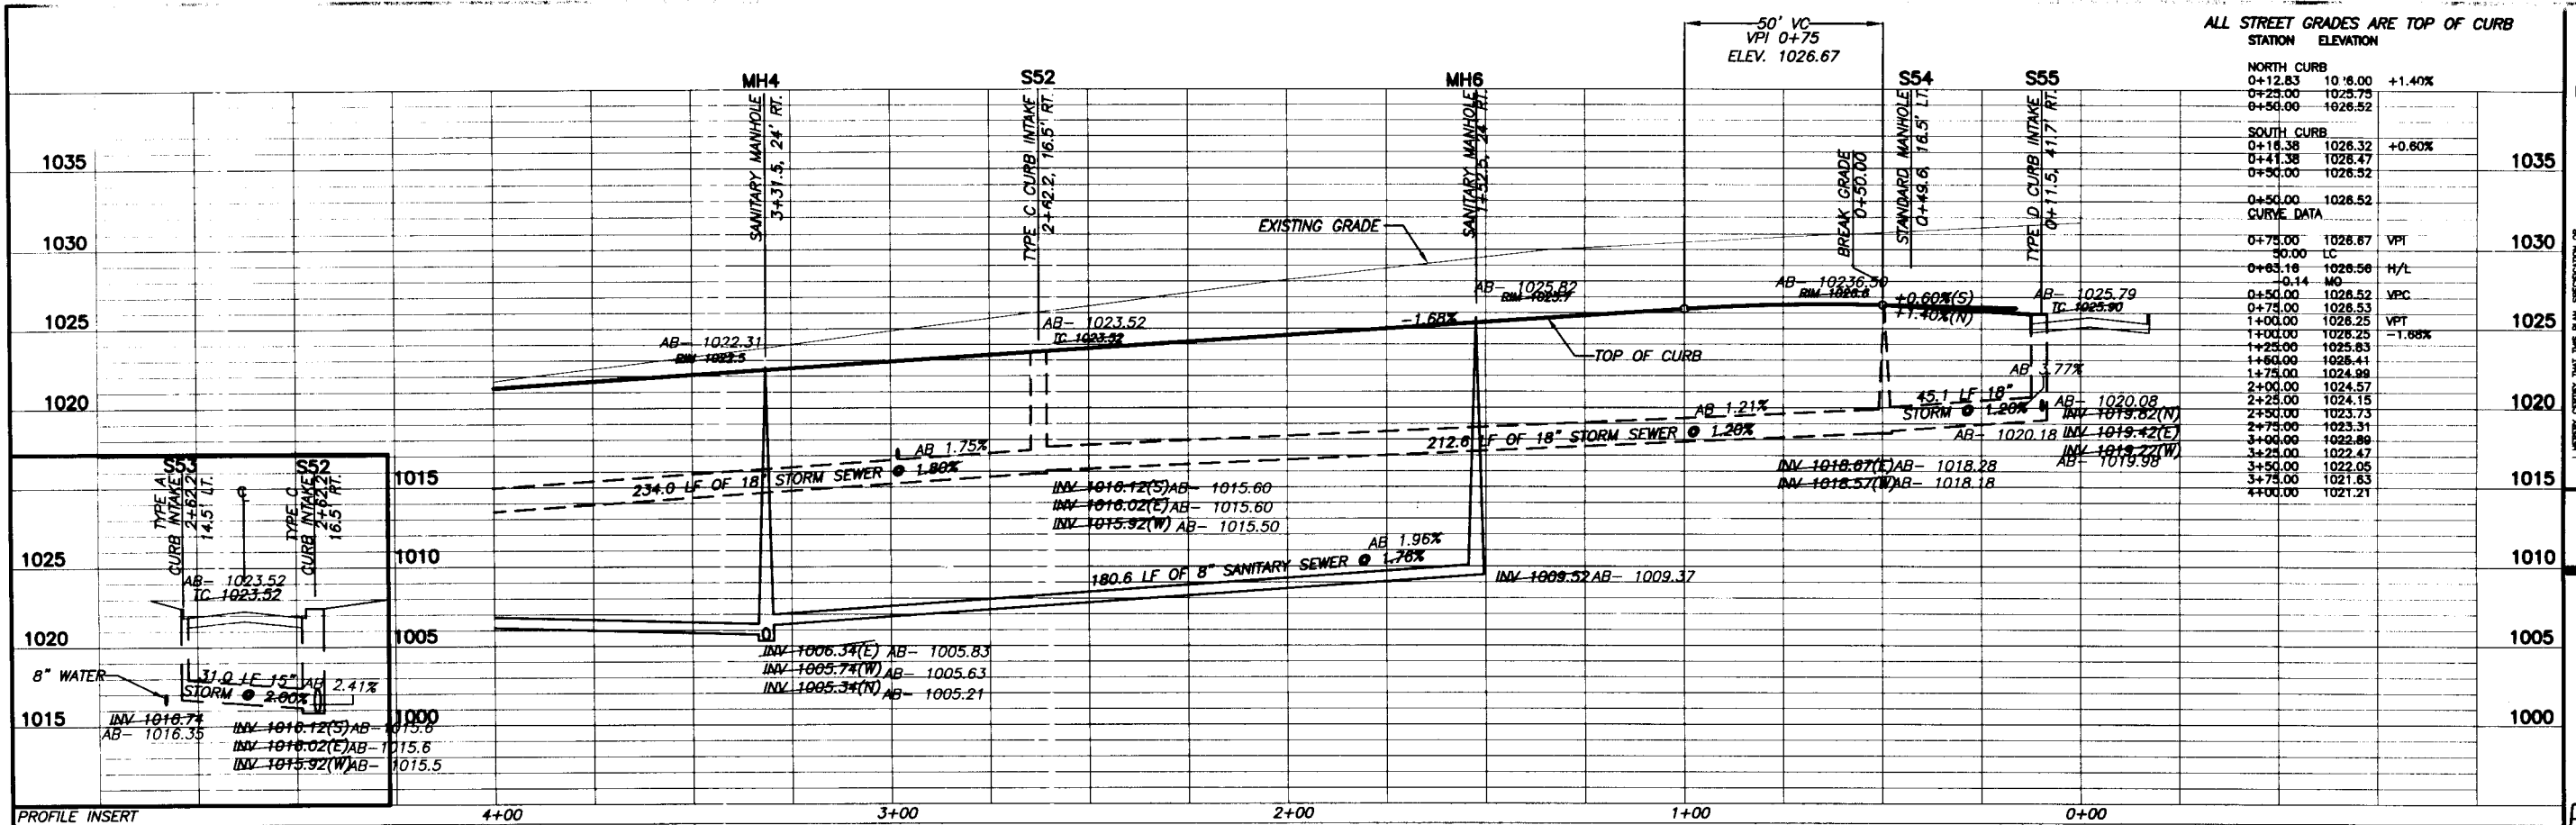


eds
 ENGINEERING DESIGN SERVICES
 14225 UNIVERSITY AVE. SUITE 220 - WAUKEE, IOWA 50243
 PH: (515) 221-1322 FAX: (515) 221-1005

DATE: 4/28/05
 DRAWN: LJR
 CHECKED: LJR
 APPROVED: LJR

REVISIONS:
 DATE:

DWG. NO. 6 OF 23
 SCALE: 1" = 20'
 JOB NO. 20-134
 www.hemmingsdesignservices.net

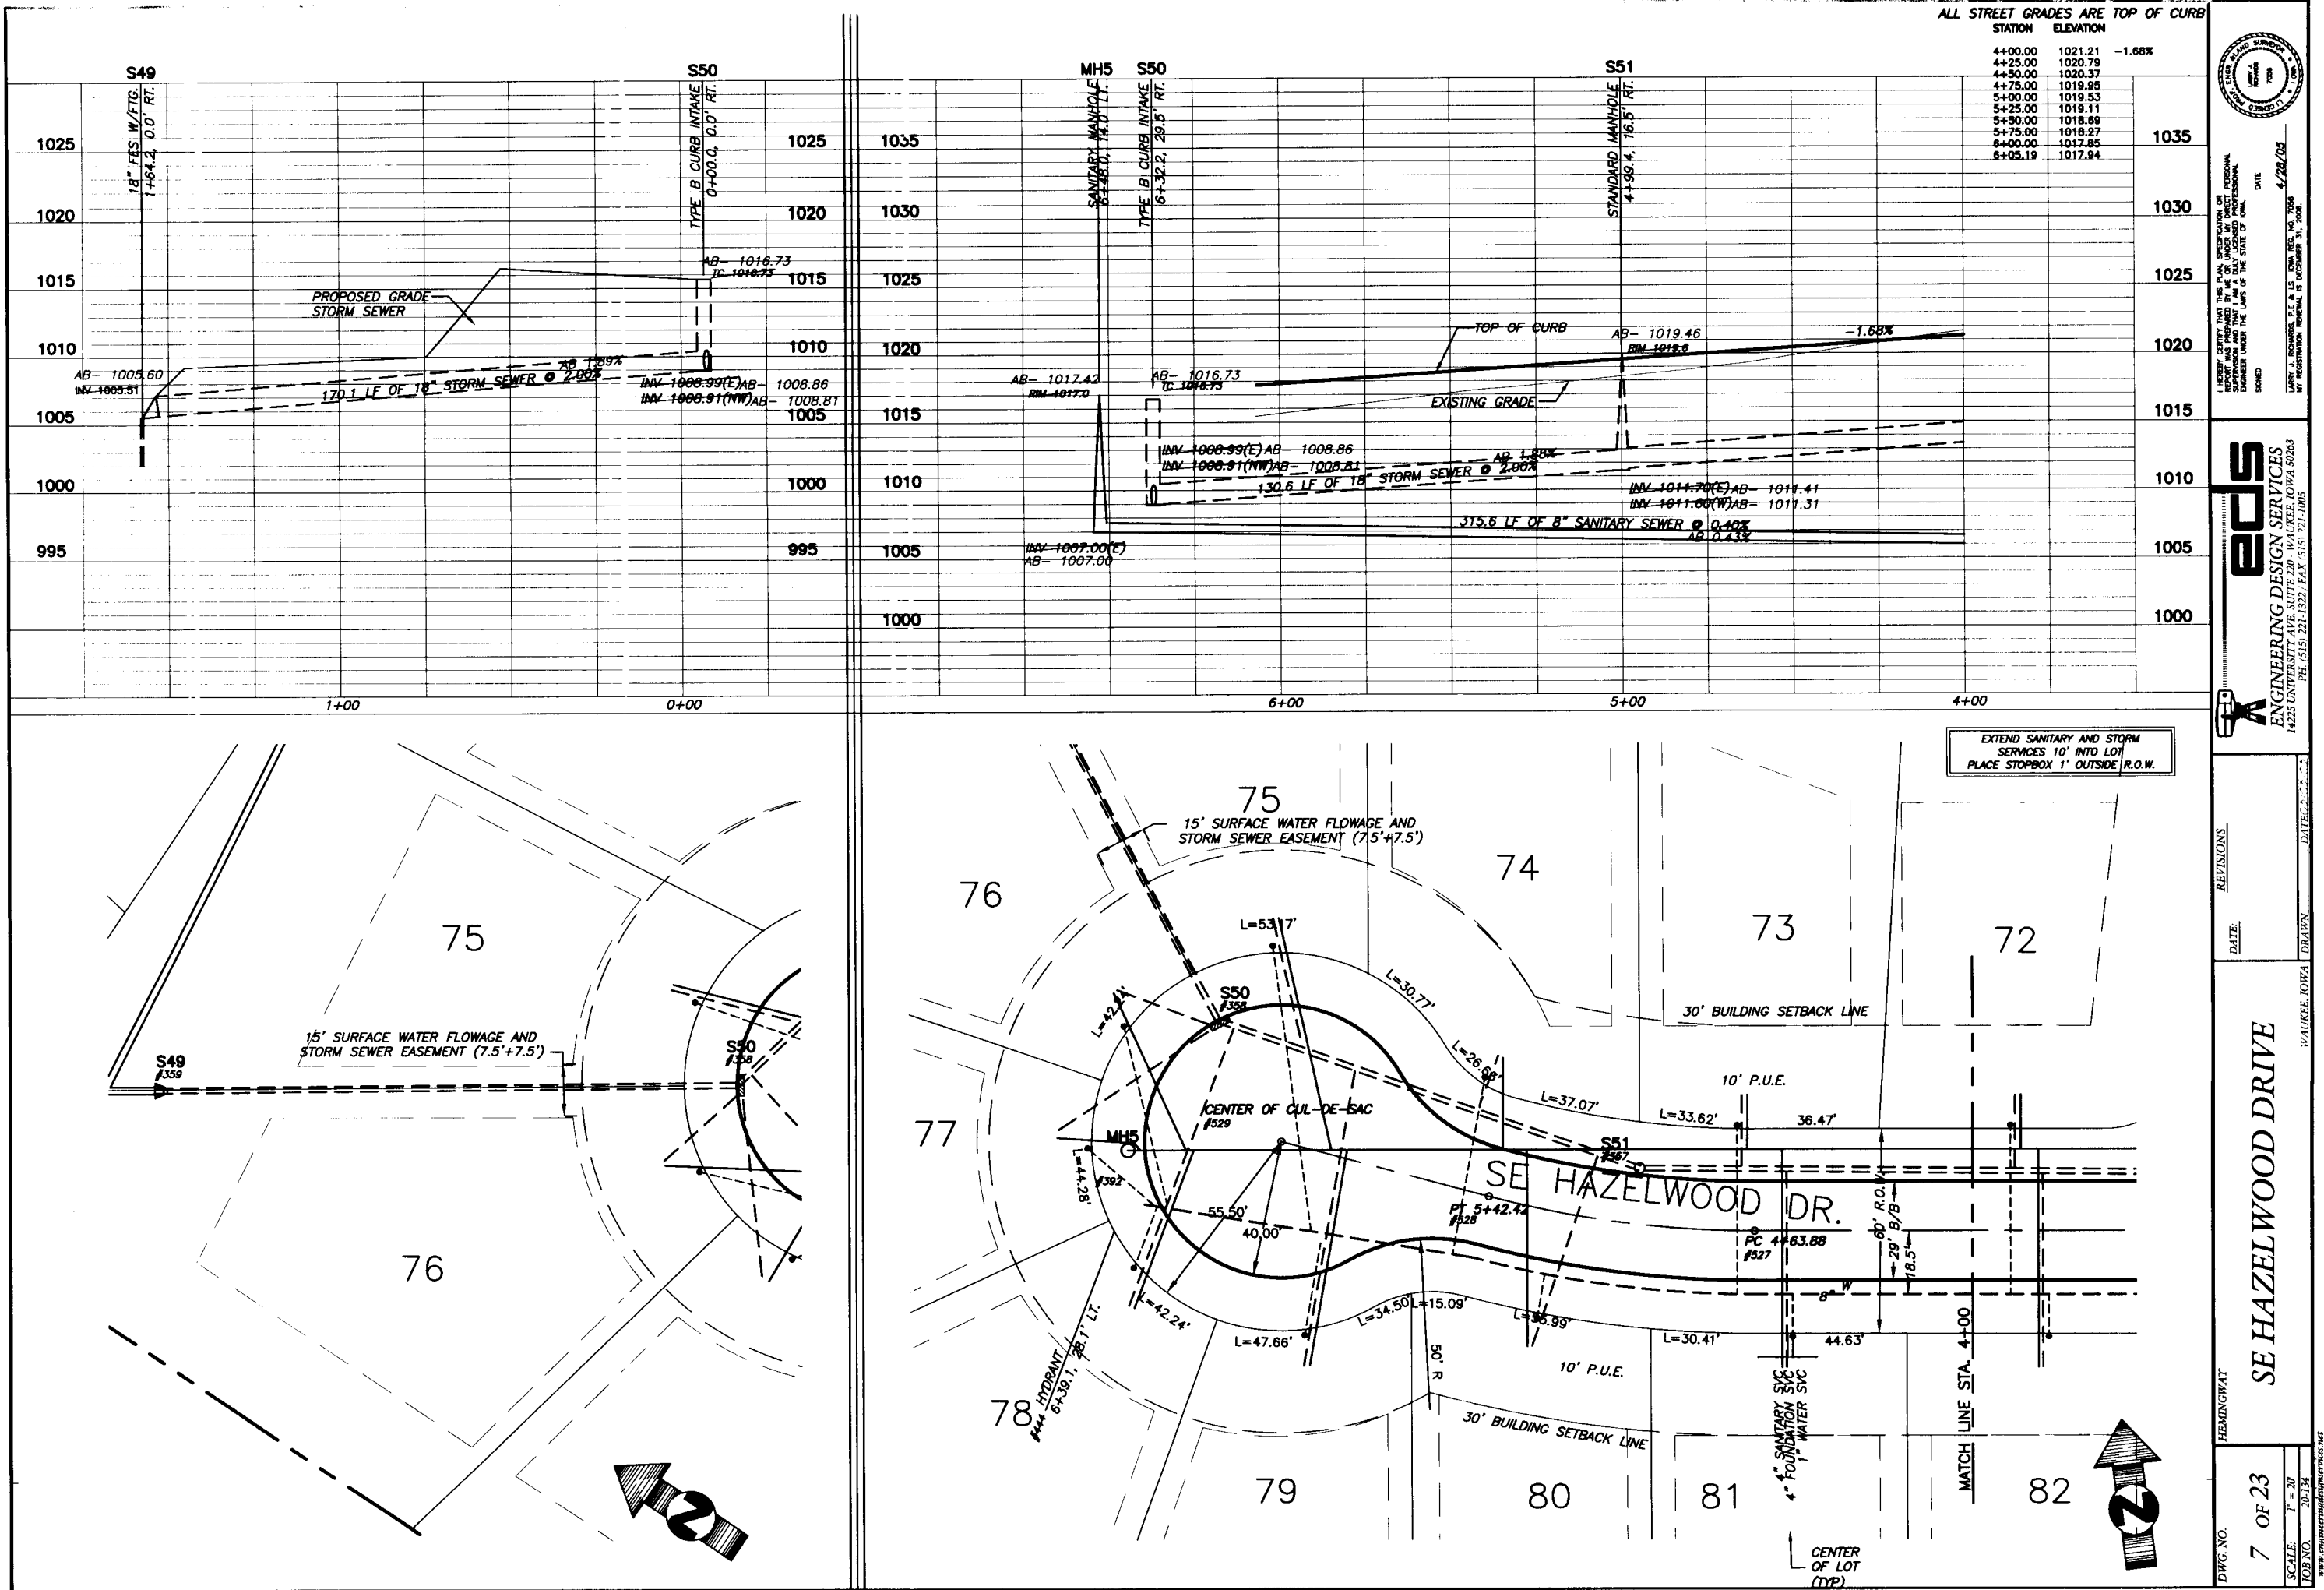

I HEREBY CERTIFY THAT THIS PLAN, SPECIFICATION OR REPORT WAS PREPARED BY ME OR UNDER MY DIRECT SUPERVISION AND THAT I AM A LICENSED PROFESSIONAL ENGINEER UNDER THE LAWS OF THE STATE OF IOWA.

SIGNED: _____

DATE: 4/28/09

EDS ENGINEERING DESIGN SERVICES
1425 UNIVERSITY AVE. SUITE 200
DES MOINES, IOWA 50319
PH: 515-221-1322 FAX: 515-221-1003

EDS ENGINEERING DESIGN SERVICES
1425 UNIVERSITY AVE. SUITE 200
DES MOINES, IOWA 50319
PH: 515-221-1322 FAX: 515-221-1003

REVISIONS

DATE	DESCRIPTION

SE HAZELWOOD DRIVE

DWG. NO. 7 OF 23
SCALE: 1" = 20'-14"
JOB NO. 20134
www.edsdesignservices.net

NORTH CUR		
0+14.50	020.11	-3.07%
0+25.00	019.79	
0+50.00	019.02	
SOUTH CUR		
0+14.50	019.61	-1.60%
0+25.00	019.44	
0+50.00	018.03	
0+75.00	018.62	
1+00.00	018.22	
1+25.00	017.82	
1+50.00	017.42	
1+75.00	017.02	
2+00.00	016.62	
2+25.00	016.22	
2+50.00	015.82	
2+75.00	015.42	
3+00.00	015.02	
3+25.00	014.62	
3+50.00	014.22	
3+75.00	013.82	
4+00.00	013.42	
4+25.00	013.02	
4+50.00	012.62	
4+75.00	012.22	
4+82.22	012.11	



I HEREBY CERTIFY THAT THIS PLAN, SPECIFICATION OR
 DESIGN WAS PREPARED BY ME OR UNDER MY DIRECT
 SUPERVISION AND THAT I AM A DULY LICENSED PROFESSIONAL
 ENGINEER UNDER THE LAWS OF THE STATE OF IOWA.

DATE _____

SIGNED _____




eds
ENGINEERING DESIGN SERVICES
4425 UNIVERSITY AVE. SUITE 200 • WALKER, IOWA 50263
TEL: 515-371-3231 FAX: 515-371-3234
WWW.EDS-DESIGN.COM

DATE:



REVISIONS

SE BAYTREE DRIVE

DWG. NO. 8 OF 23
SCALE: 1" = 20'

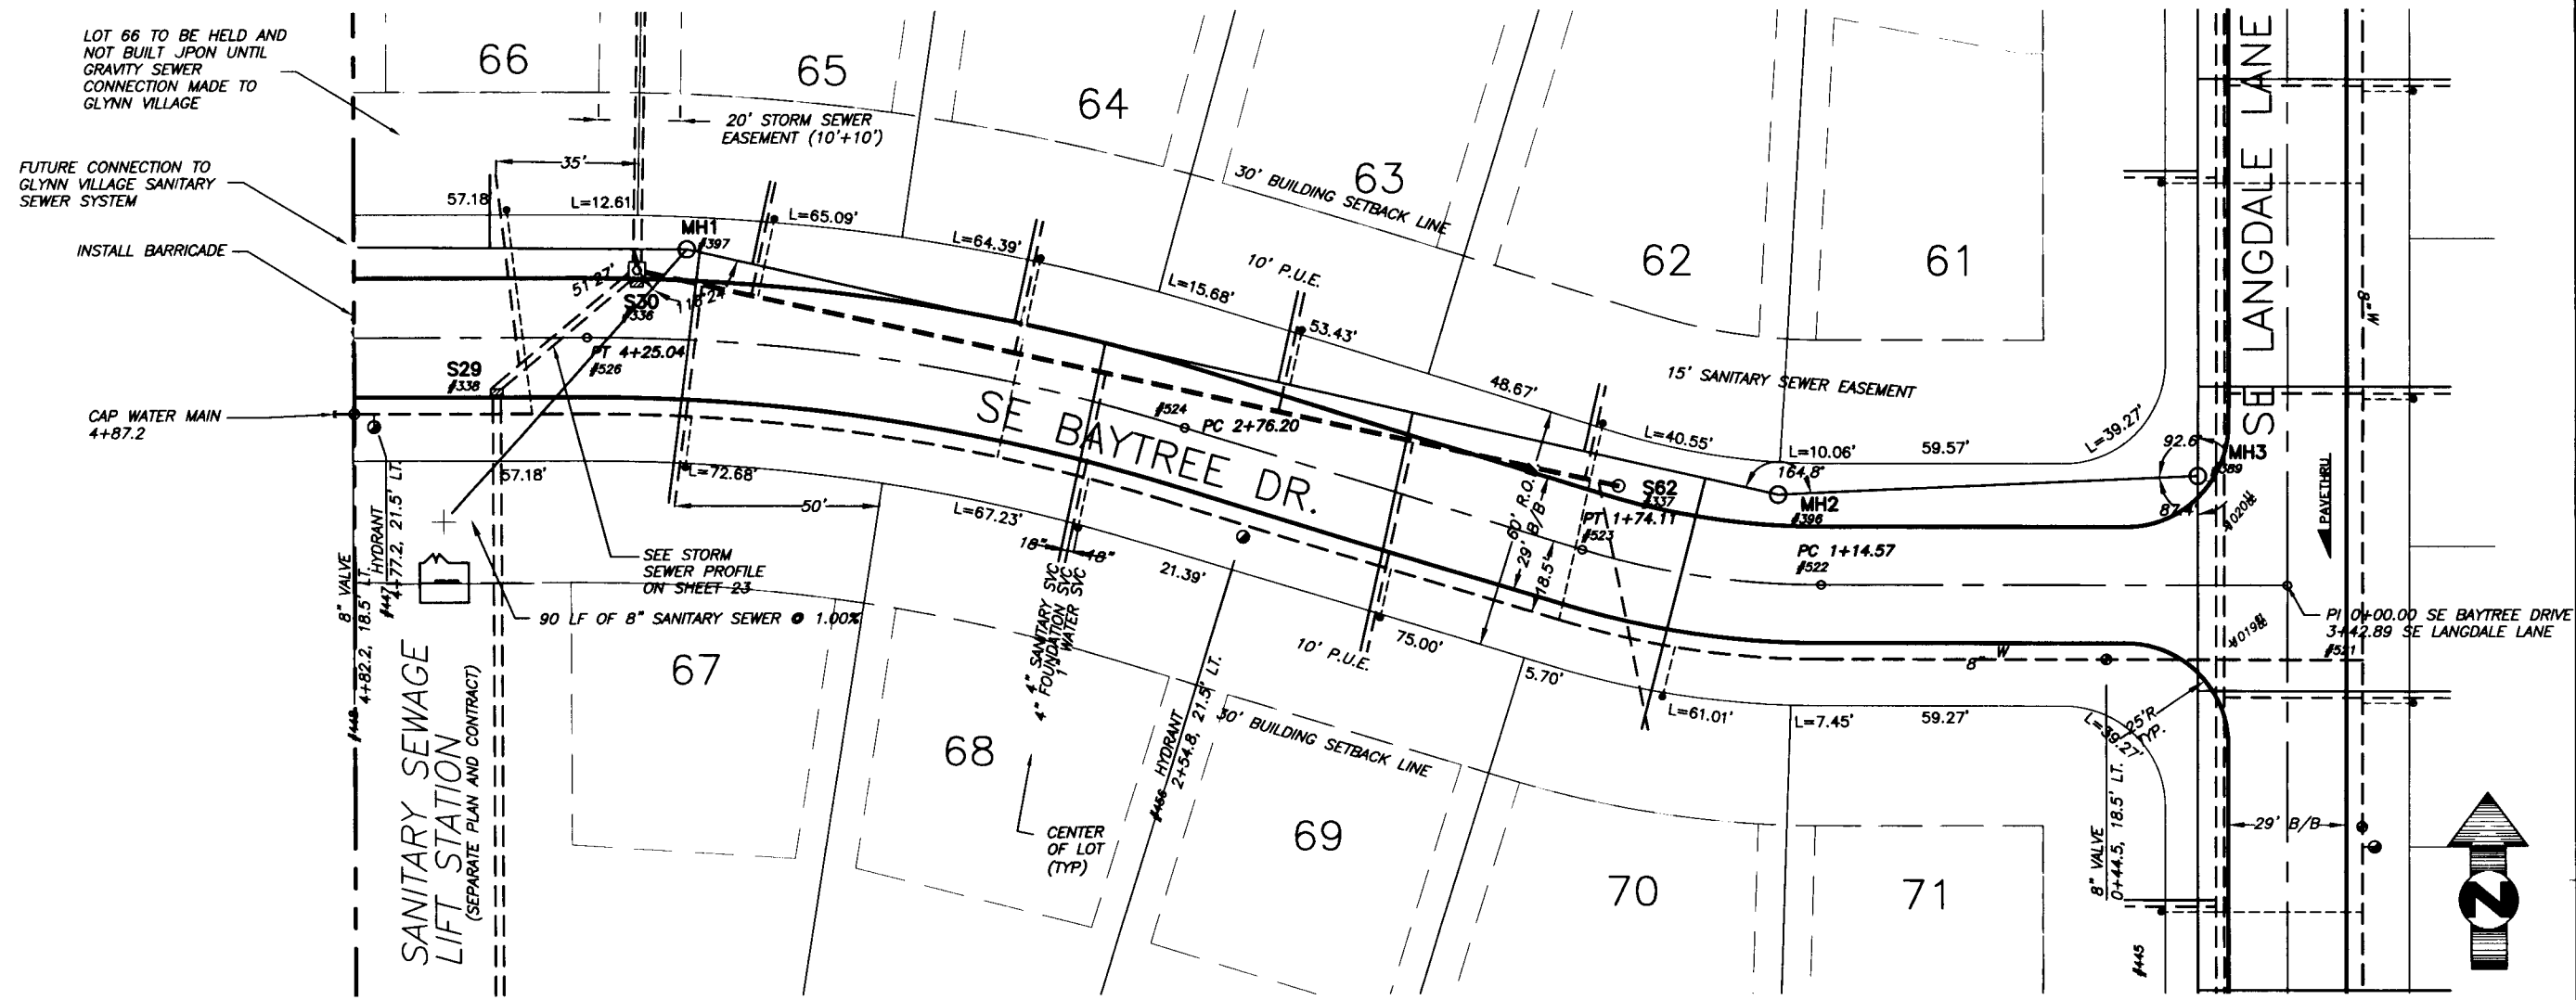

ALL STREET GRADES ARE TOP OF CURB
STATION ELEVATION

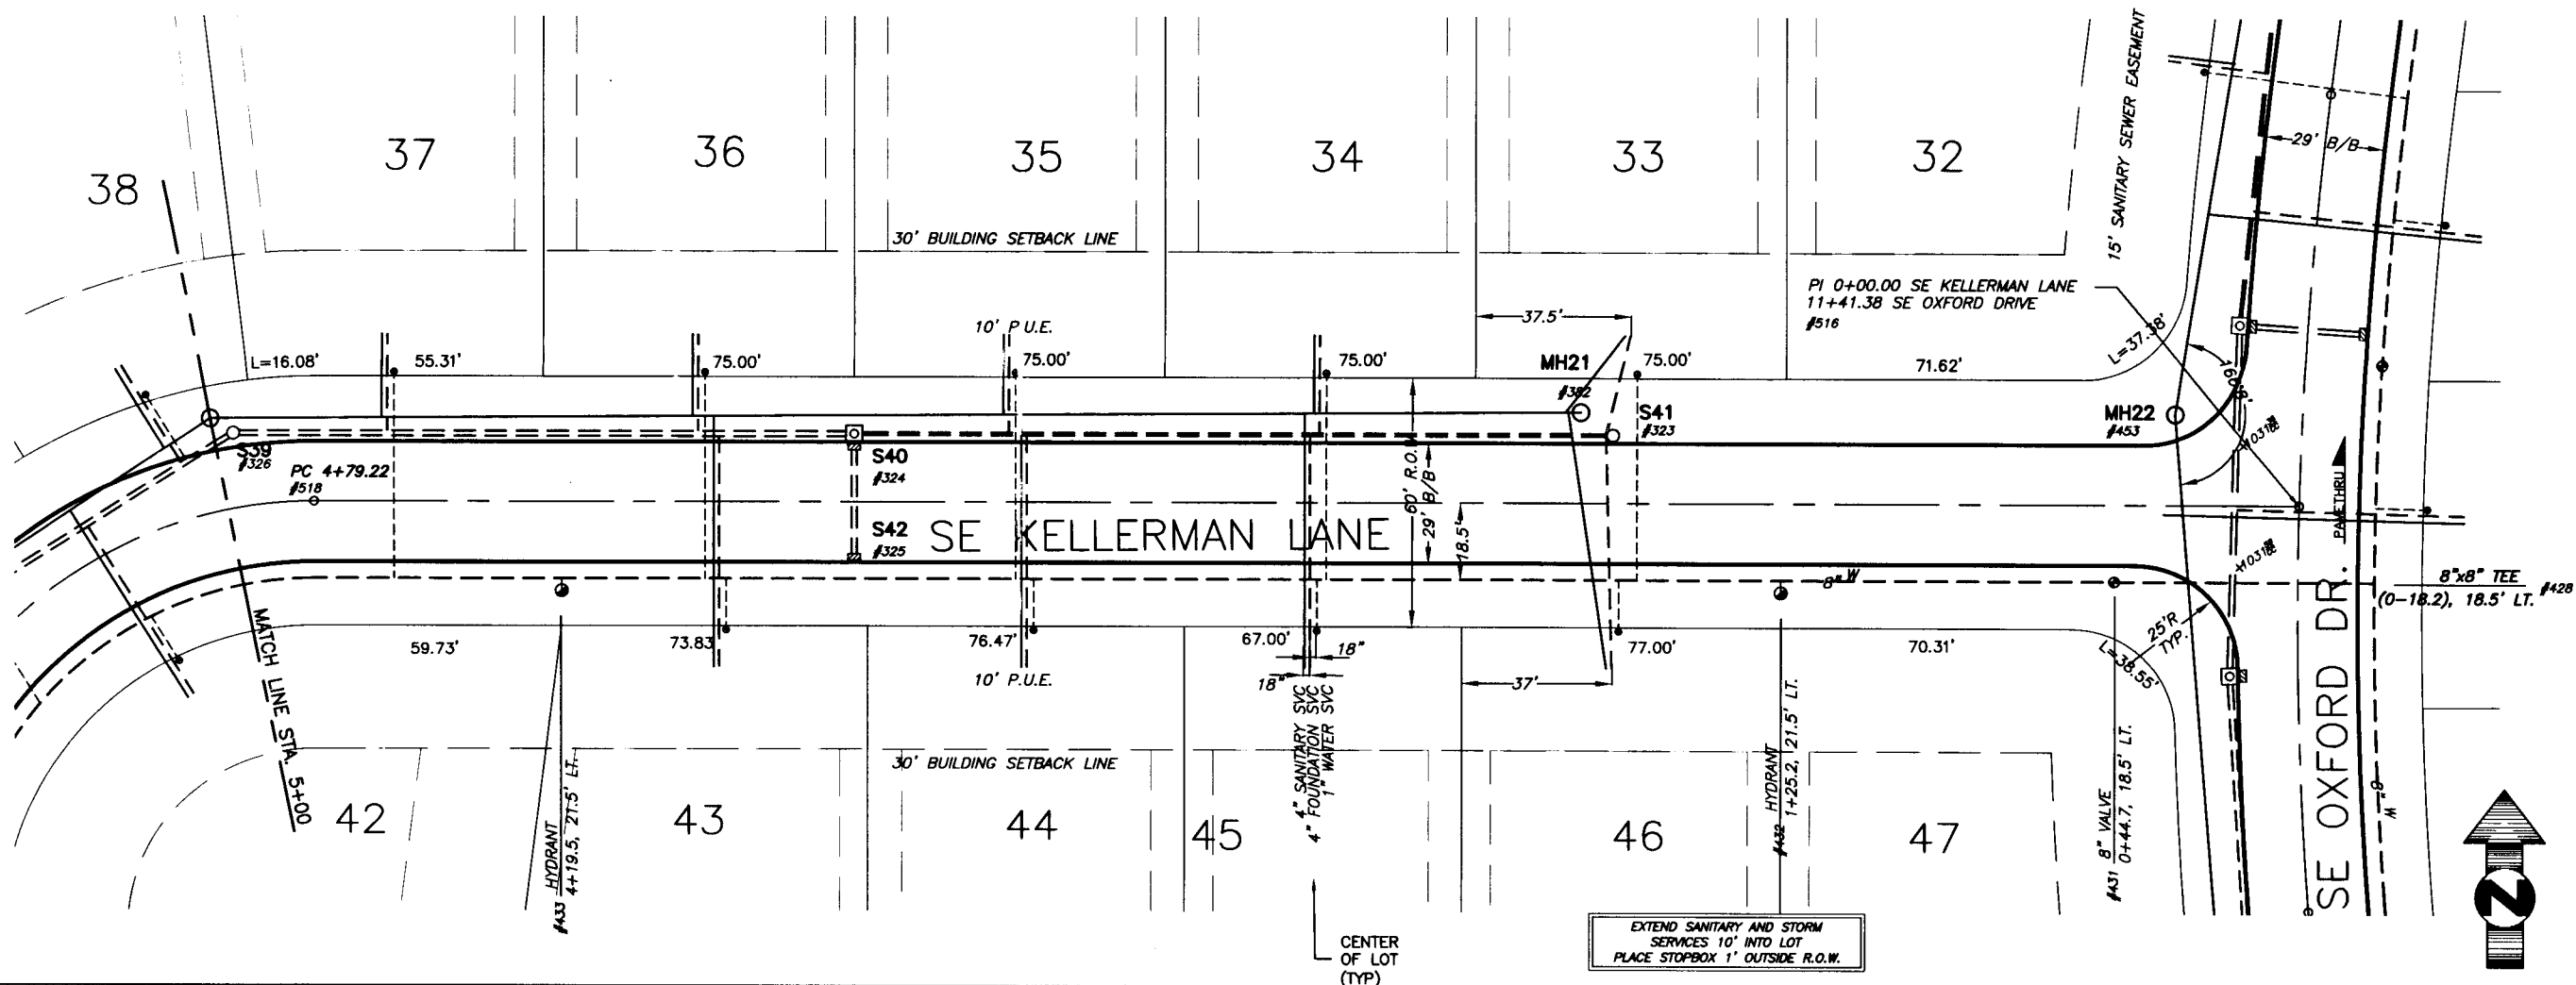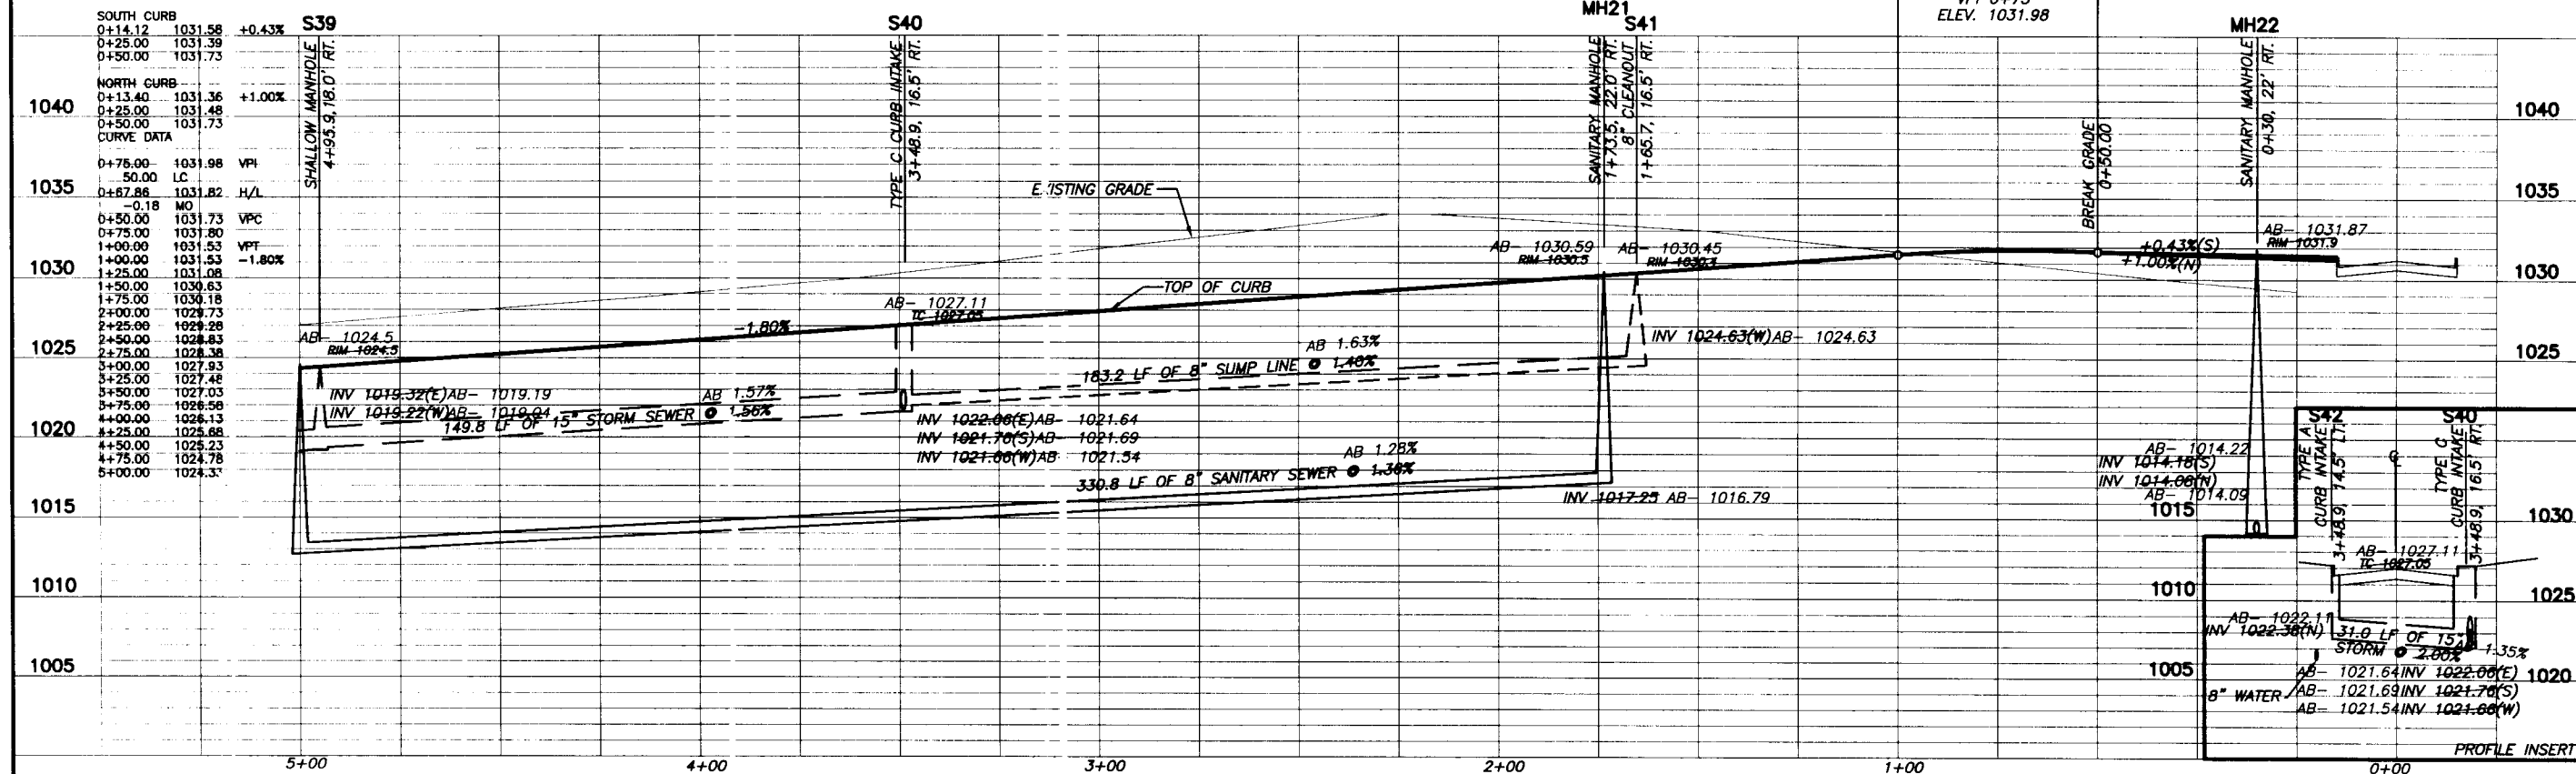

DATE: 4/28/05

ENGINEERING DESIGN SERVICES

1425 UNIVERSITY AVE. SUITE 220 - WALKER, IOWA 50463

PH: (515) 221-1322 FAX: (515) 221-1045

SE KELLERMAN LANE

HEMINGWAY

9 OF 23





SCALE: 1" = 30'

TOD: NO. 20134

WWW.HEMINGWAYENGINEERING.NET

STATION	ELEVATION
1	100.00
2	100.00
3	100.00
	5+00.00	1024.33	
	5+25.00	1023.88	
	5+50.00	1023.43	
	5+75.00	1022.98	
	6+00.00	1022.53	BREAK GRADE
1040	EAST CURB LINE		
	6+25.00	1022.34	
	6+50.00	1022.15	
	6+75.00	1021.95	
	7+00.00	1021.78	
1035	7+25.00	1021.57	
	7+37.81	1021.37	EAST CC
	WEST CURB LINE		
	6+25.00	1022.27	
	6+50.00	1022.02	
1030	6+75.00	1021.78	
	7+00.00	1021.51	
	7+25.00	1021.24	
	7+52.12	1020.98	WEST CC

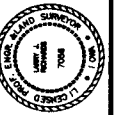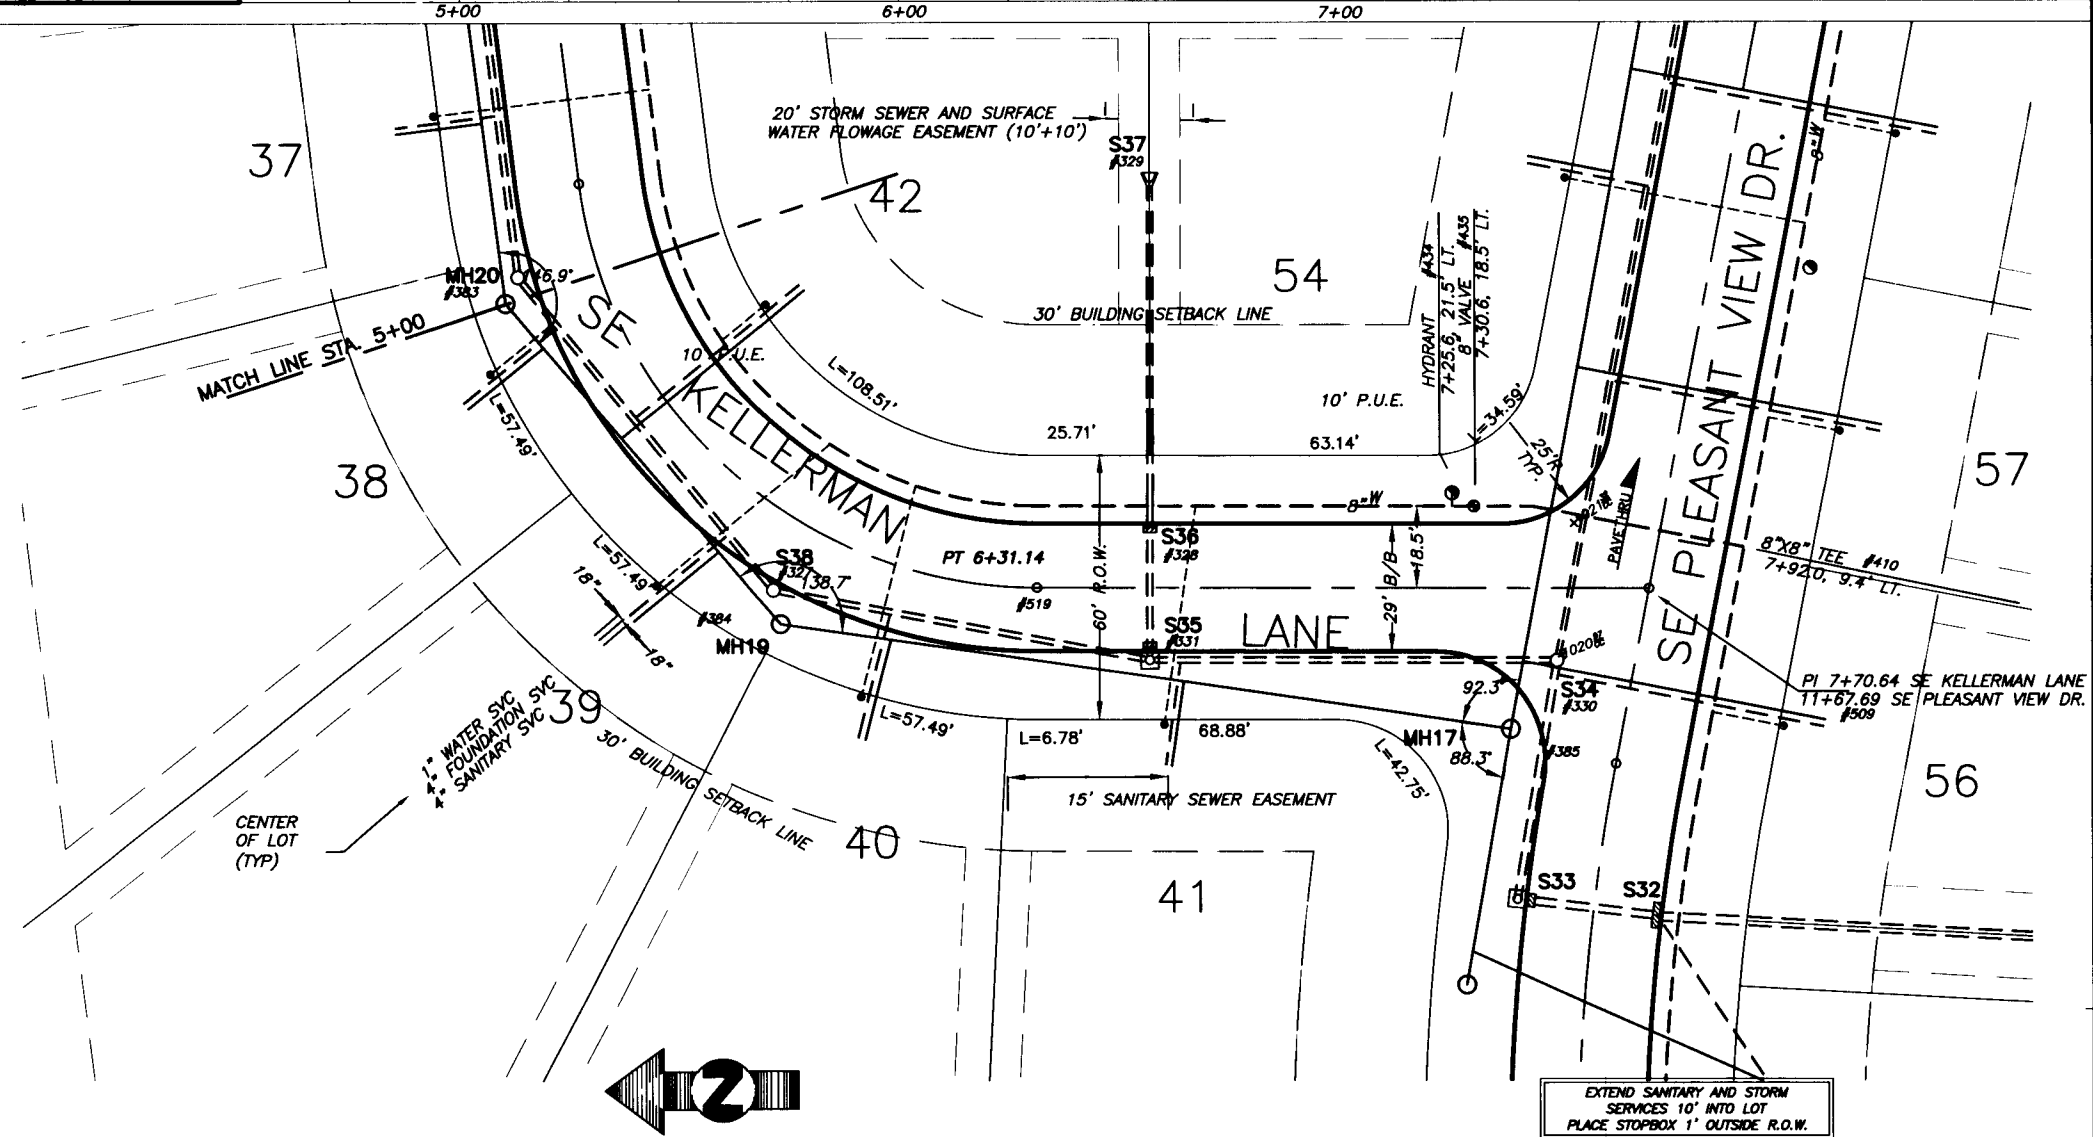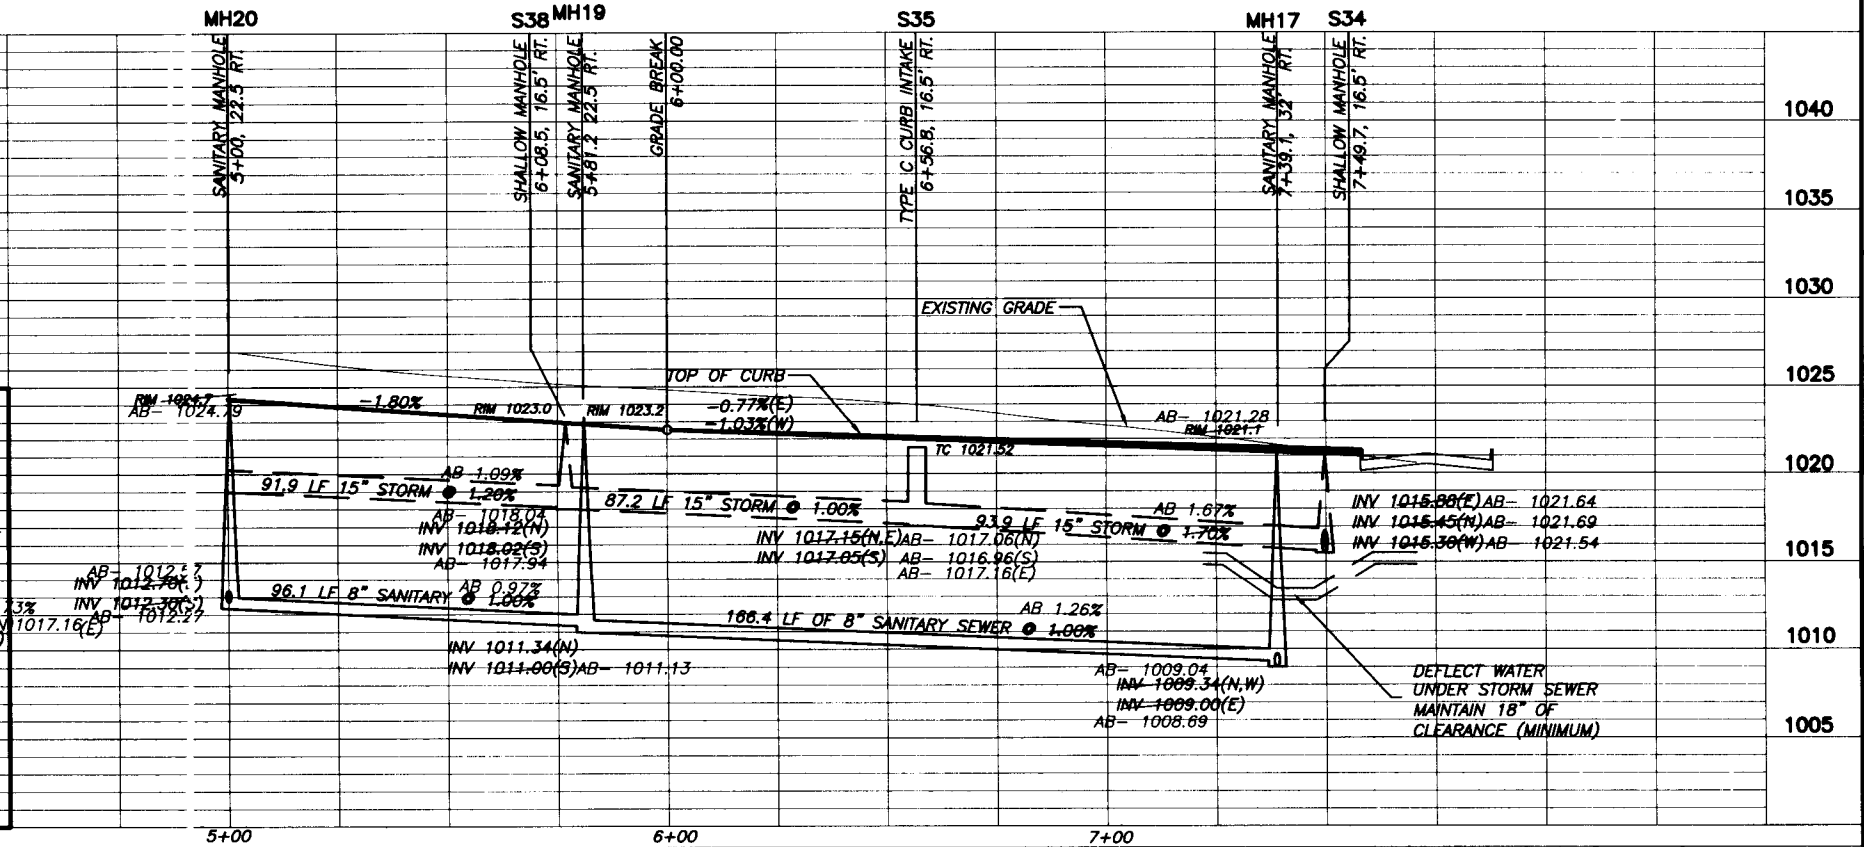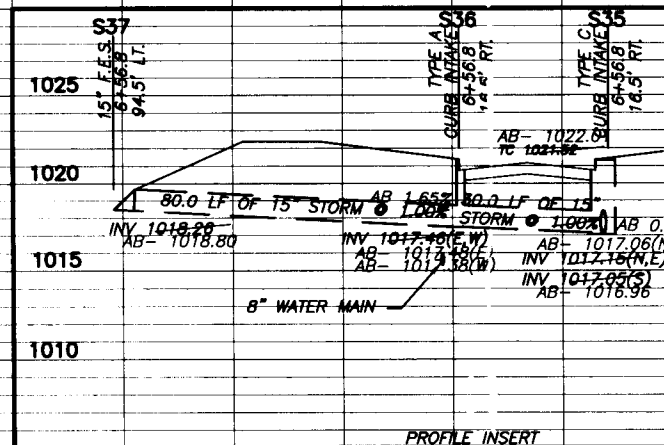

REPORT WAS PREPARED BY ME OR UNDER MY DIRECT PERSONAL SUPERVISION AND THAT I AM A DULY LICENSED PROFESSIONAL ENGINEER UNDER THE LAWS OF THE STATE OF OHIO.

SIGNED _____ DATE 4/28/05

LARRY J. SCHWABE, P.E. & S. OHIO REG. NO. 7058
MY REGISTRATION RENEWAL IS DECEMBER 31, 2006.



QUESTIONS

DATE: _____

SE KELLERMAN DRIVE

XXXXXXXXXX

10 OF 23




Journal of Management Inquiry 18(4)

ALL STREET GRADES ARE TOP OF CURB

STATION ELEVATION

10+00.00 33.91 +0.64%
10+25.00 34.14
10+50.00 34.37
10+75.00 1034.80
CURVE DATA

1045
11+25.00 35.08 VPI
100.00
10+90.30 34.08 H/L
-0.54
10+75.00 1034.80 VPC
11+00.00 1034.69
11+25.00 1034.52
11+50.00 1034.07
11+75.00 1033.36 VPI
11+75.00 1033.36 -3.40%
12+00.00 1032.51
12+25.00 1031.66
12+50.00 1030.81
12+75.00 1029.96
13+00.00 1029.11
13+08.66 1028.81

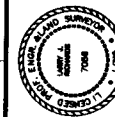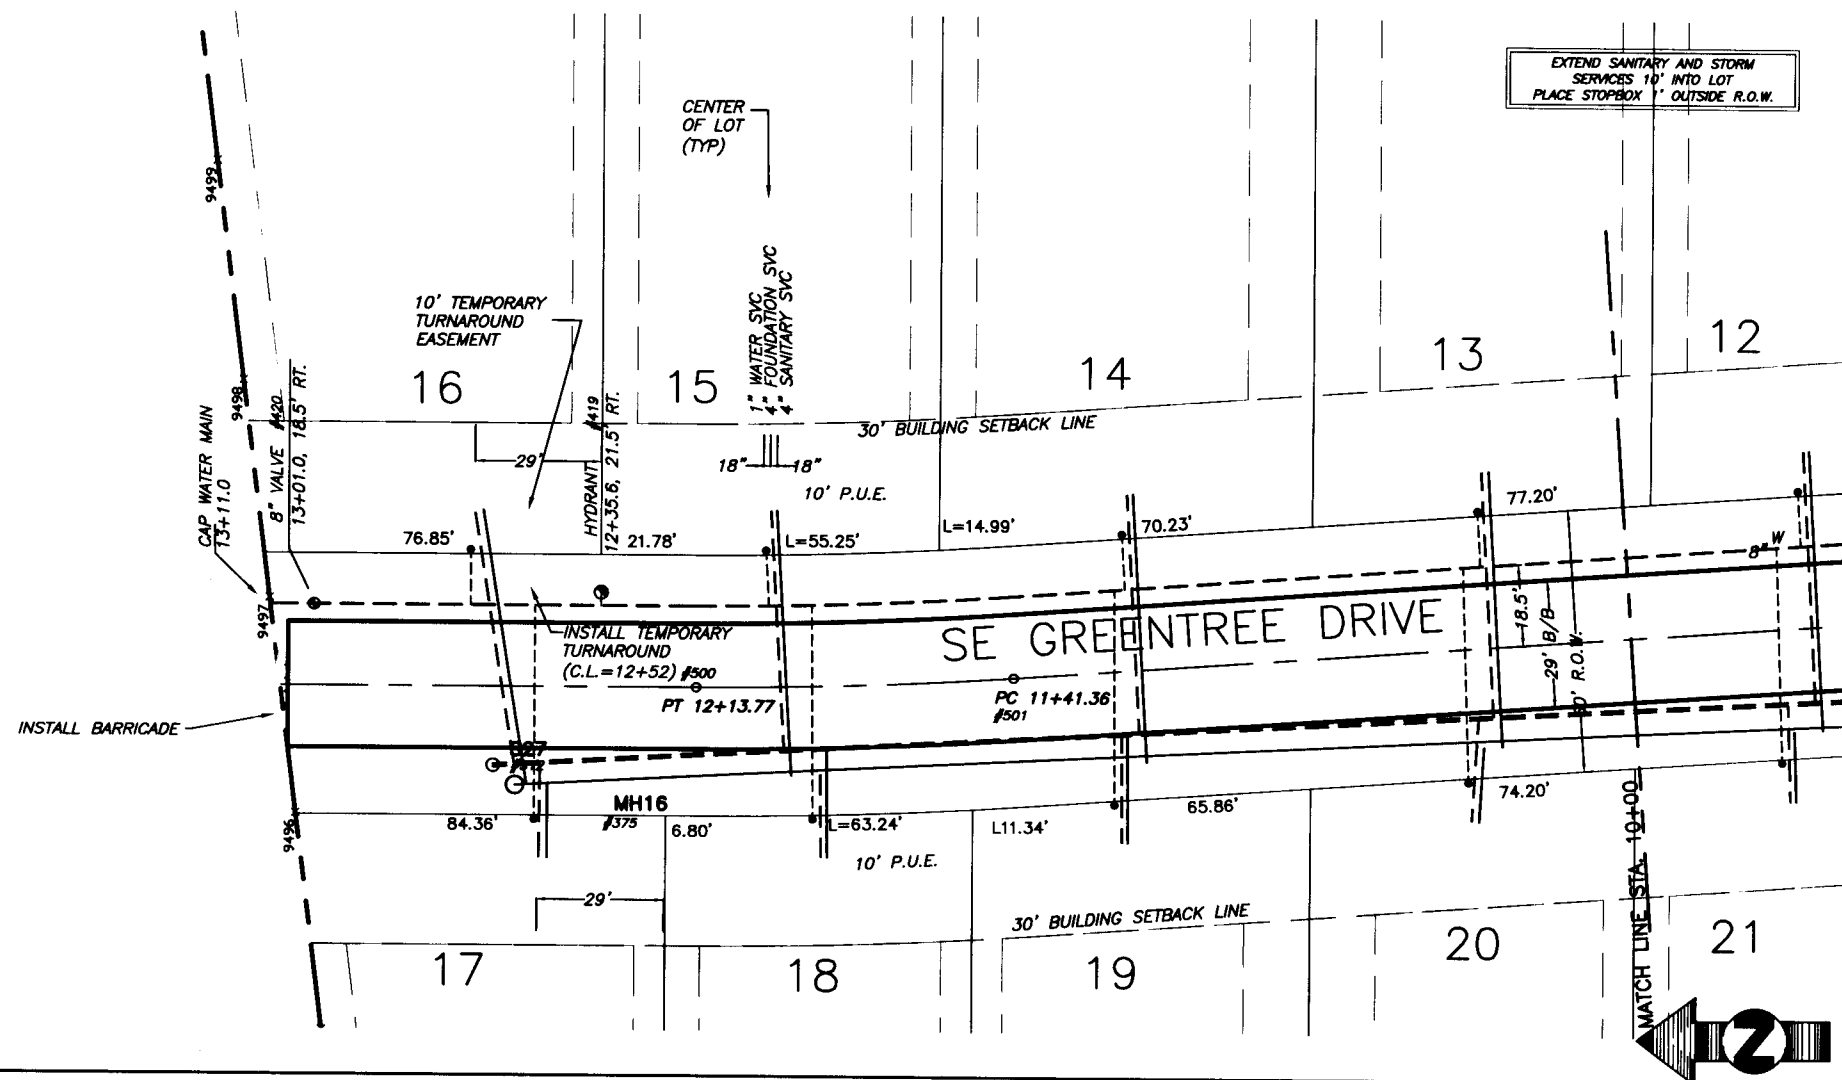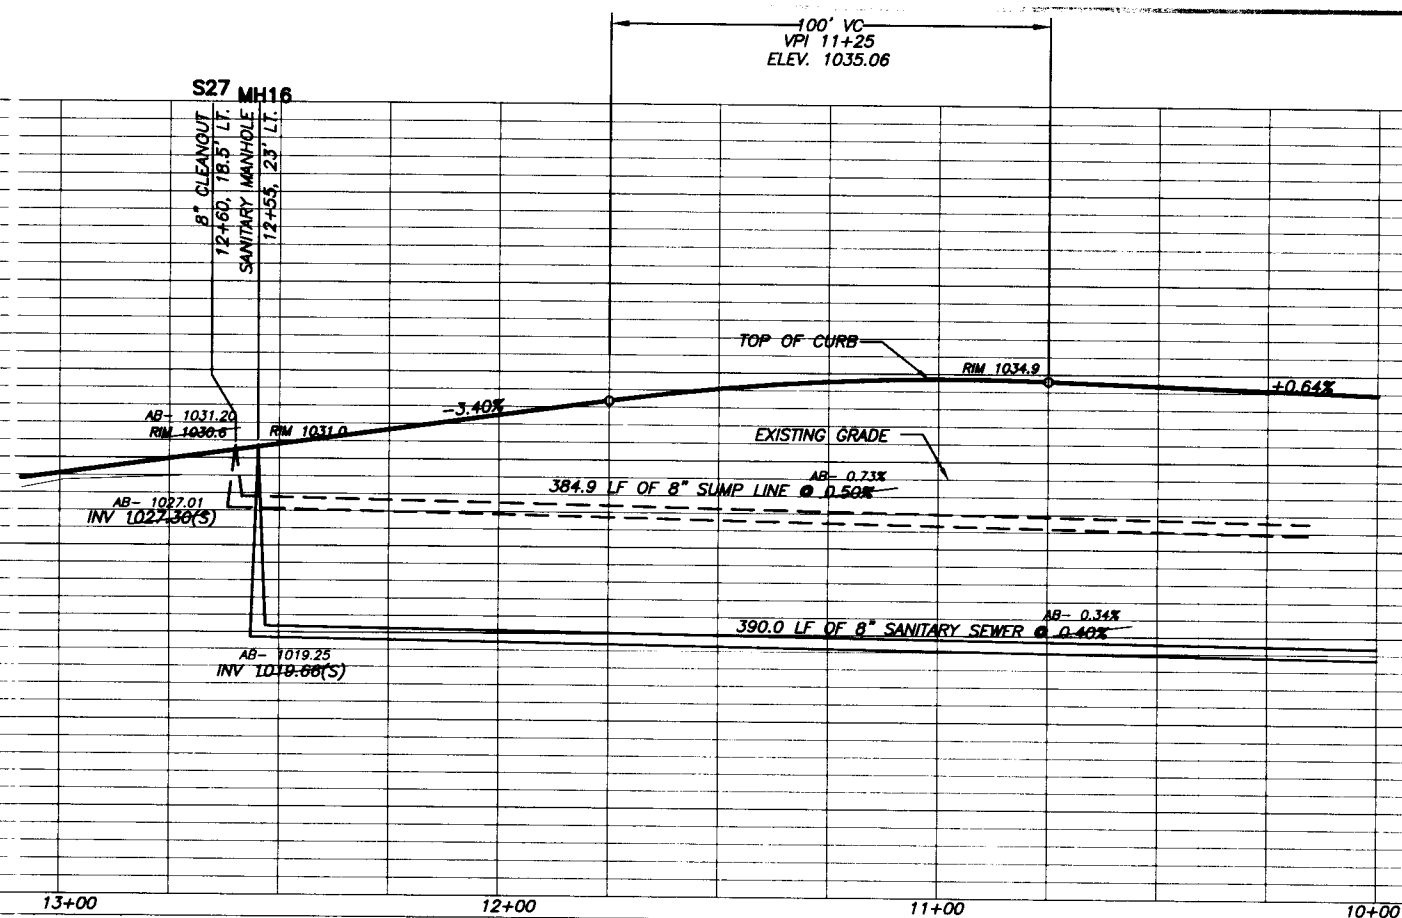

LARRY J. RICHARDS, P.E. & L.S. IOWA REG. NO. 2200
MY REGISTRATION RENEWAL IS DECEMBER 31, 2008.
DATE 4/29/05
SIGNED

eds
ENGINEERING DESIGN SERVICES
14225 UNIVERSITY AVE. SUITE 220 WAUKEE, IOWA 50263
PH. (515) 221-1322 / FAX (515) 221-1005

REVISIONS

DATE

SE GREENTREE DRIVE

HEMINGWAY

DWG. NO.

13 of 23



SCALE: 1" = 20'

JOB NO. 20-134

www.mhengineering.com

ALL STREET GRADES ARE TOP OF CURB

	5+00.00	1027.74	+0.64%
	5+25.00	1027.90	
	5+50.00	1028.06	
	5+75.00	1028.22	
	6+00.00	1028.38	
	6+25.00	1028.54	
	6+50.00	1028.70	
	6+75.00	1028.86	
	6+95.01	1028.91	
	WEST CURB		
	6+75.00	1028.86	-0.52 %
	7+00.50	1028.73	
1040			
	WEST CURB		
	7+32.05	1028.69	+4.98
	7+50.00	1029.58	
	7+75.00	1030.8	%
1035			
	EAST CURB		
	7+26.56	1028.99	+3.80%
	7+50.00	1029.88	
	7+75.00	1030.83	
1030	8+00.00	1031.78	
	CURVE DATA		
	8+50.00	1033.68	VPI
	100.00	LC	
1025	8+53.33	1033.36	H/L
	-0.57	MD	
	8+00.00	1031.78	VPC
	8+25.00	1032.59	
	8+50.00	1033.11	
	8+75.00	1033.35	
	9+00.00	1033.30	VPT
1020	9+00.00	1033.30	-0.76%
	9+25.00	1033.11	
	9+50.00	1032.92	
	9+75.00	1032.73	
	10+00.00	1032.54	
1015			266
1010			
			10+00

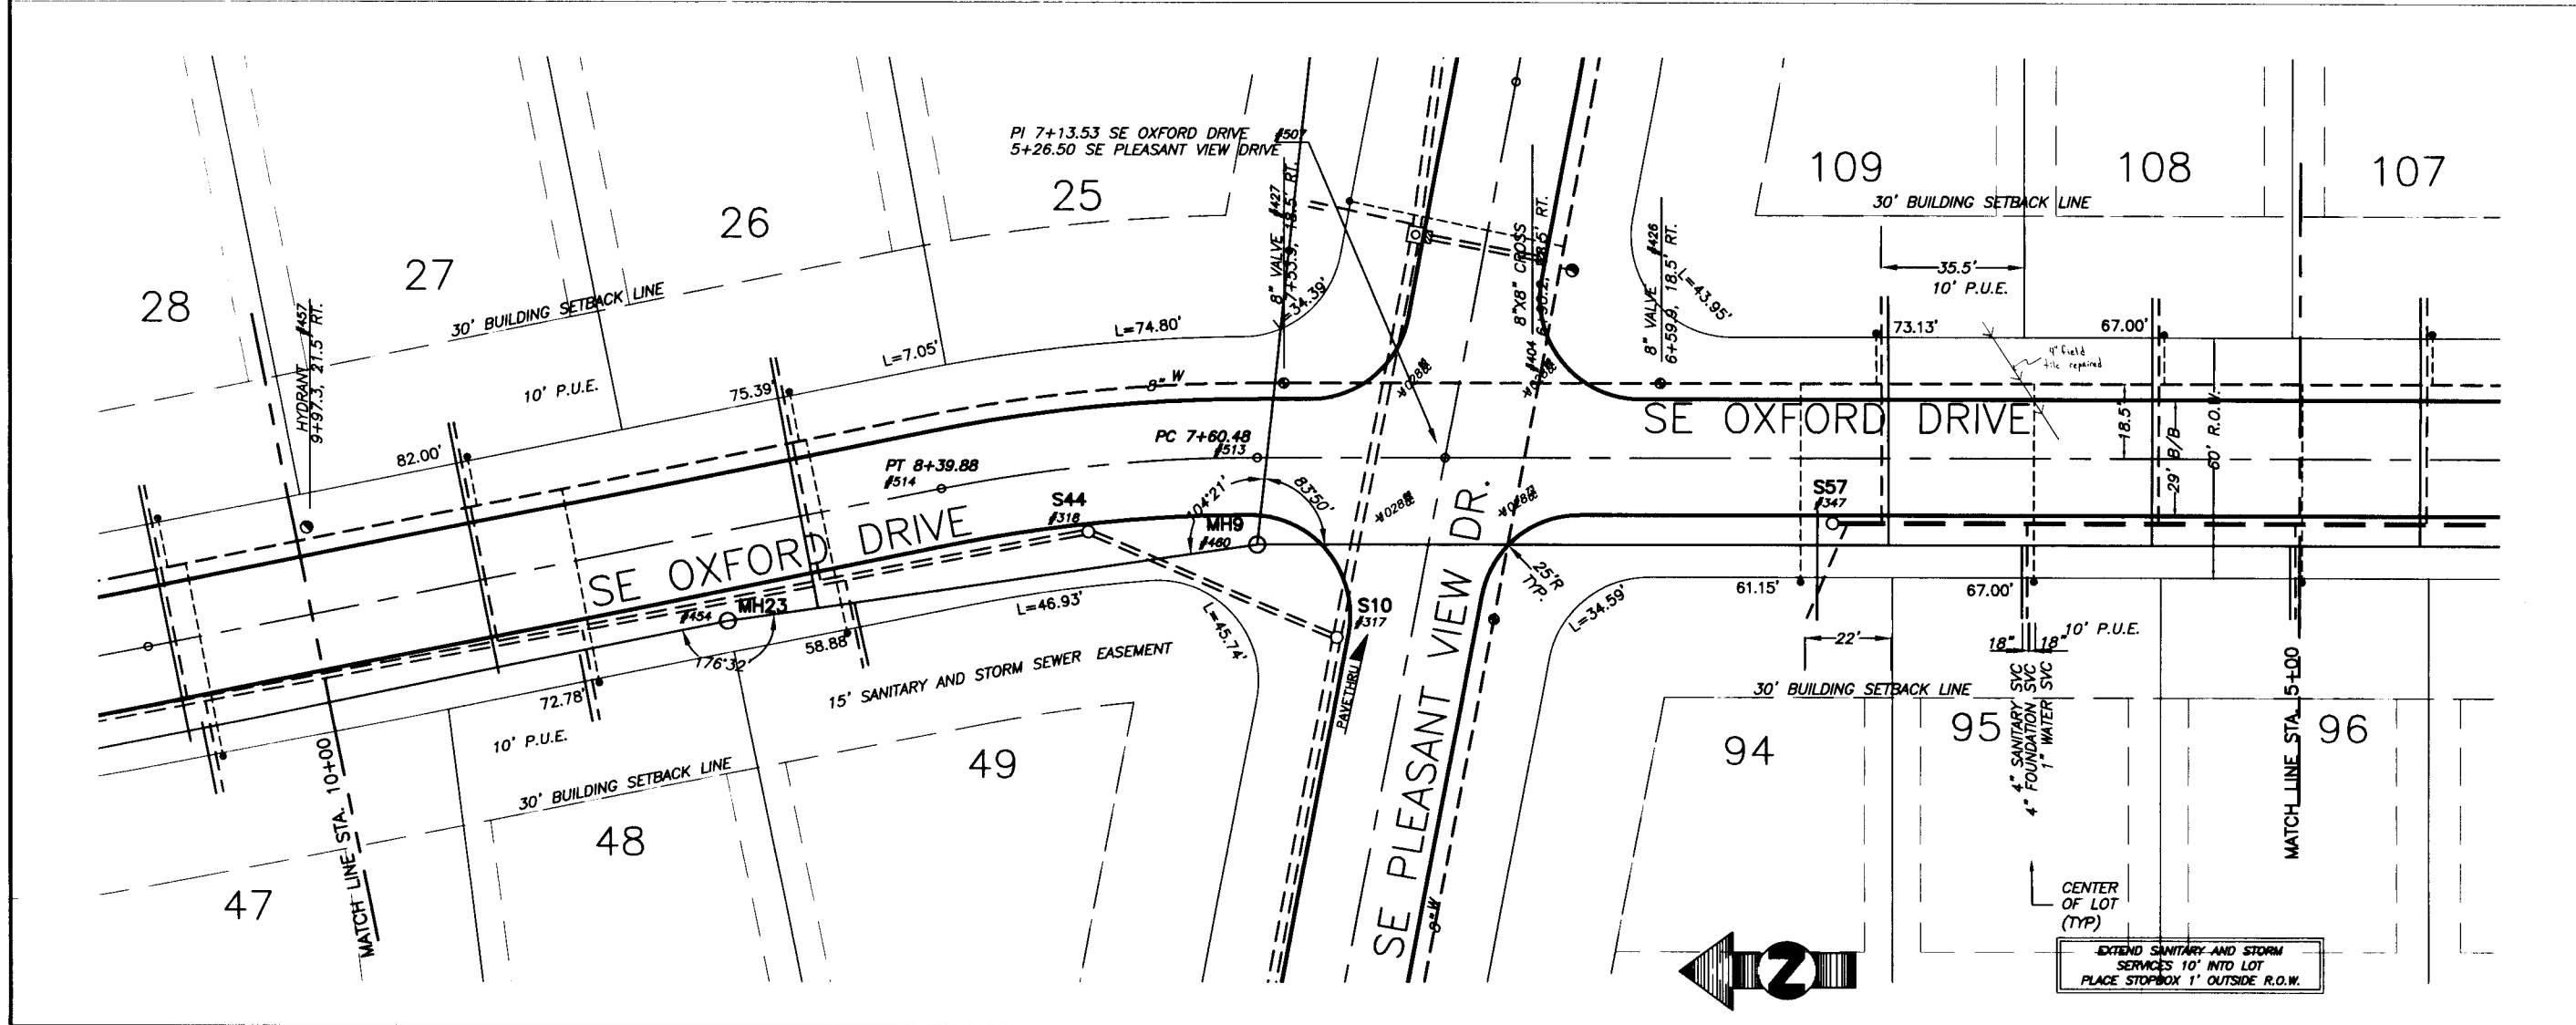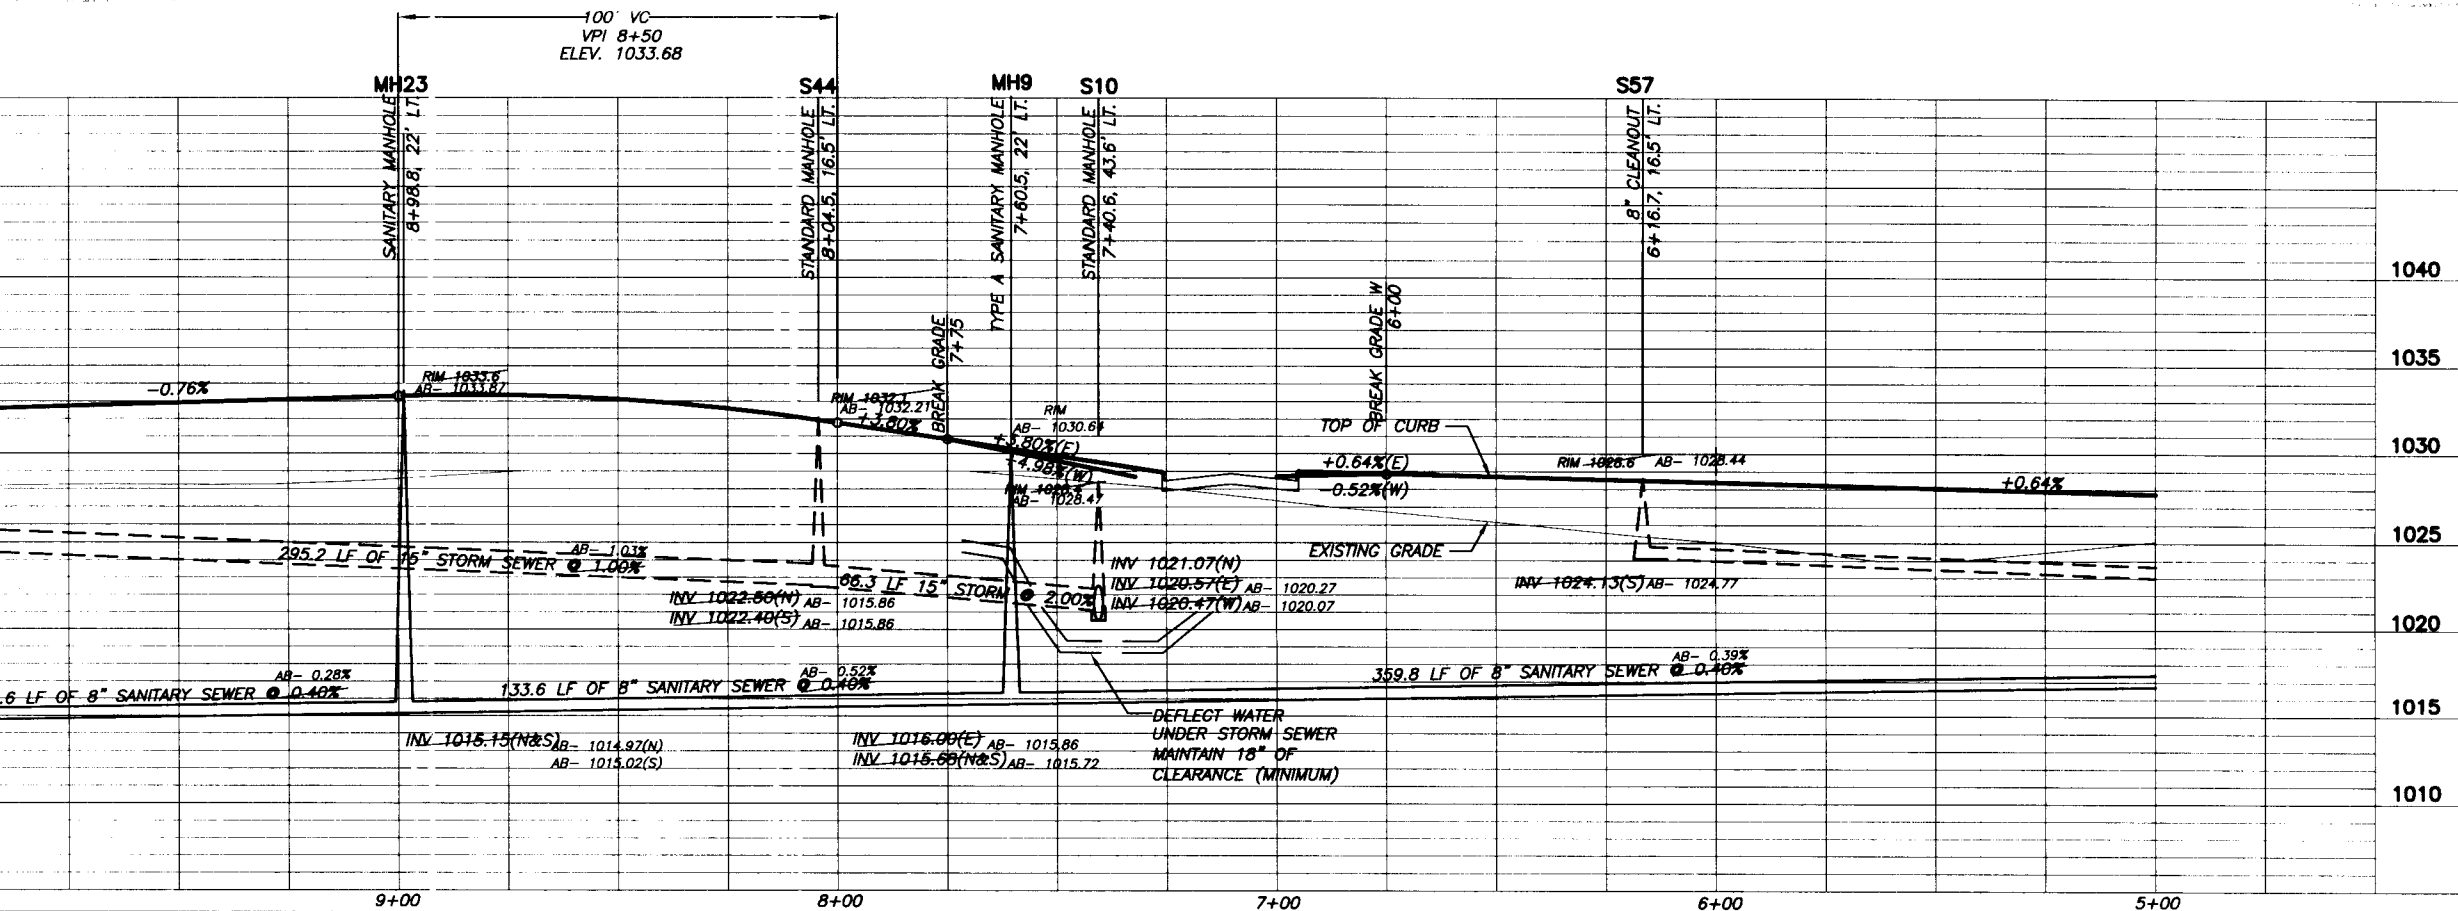

LARRY J. RICHARDS, P.E. & S. IOWA REG. NO. 7008
BY REGISTRATION RENEWAL IS EXPIRING 31, 2008



eds
ENGINEERING DESIGN SERVICES
1425 UNIVERSITY AVE. SUITE 220 - WAUKEE, IOWA 50263
PH: (515) 221-1322 FAX: (515) 221-1005

REVISIONS
DATE: _____
DRAWN: _____
CHECKED: _____
DATE: _____

SE OXFORD DRIVE

15 OF 23
SCALE: 1" = 20'
JOB NO. 20134
www.edsgroupinc.com

SEE SHEET GRADES FOR TOP OF CURB

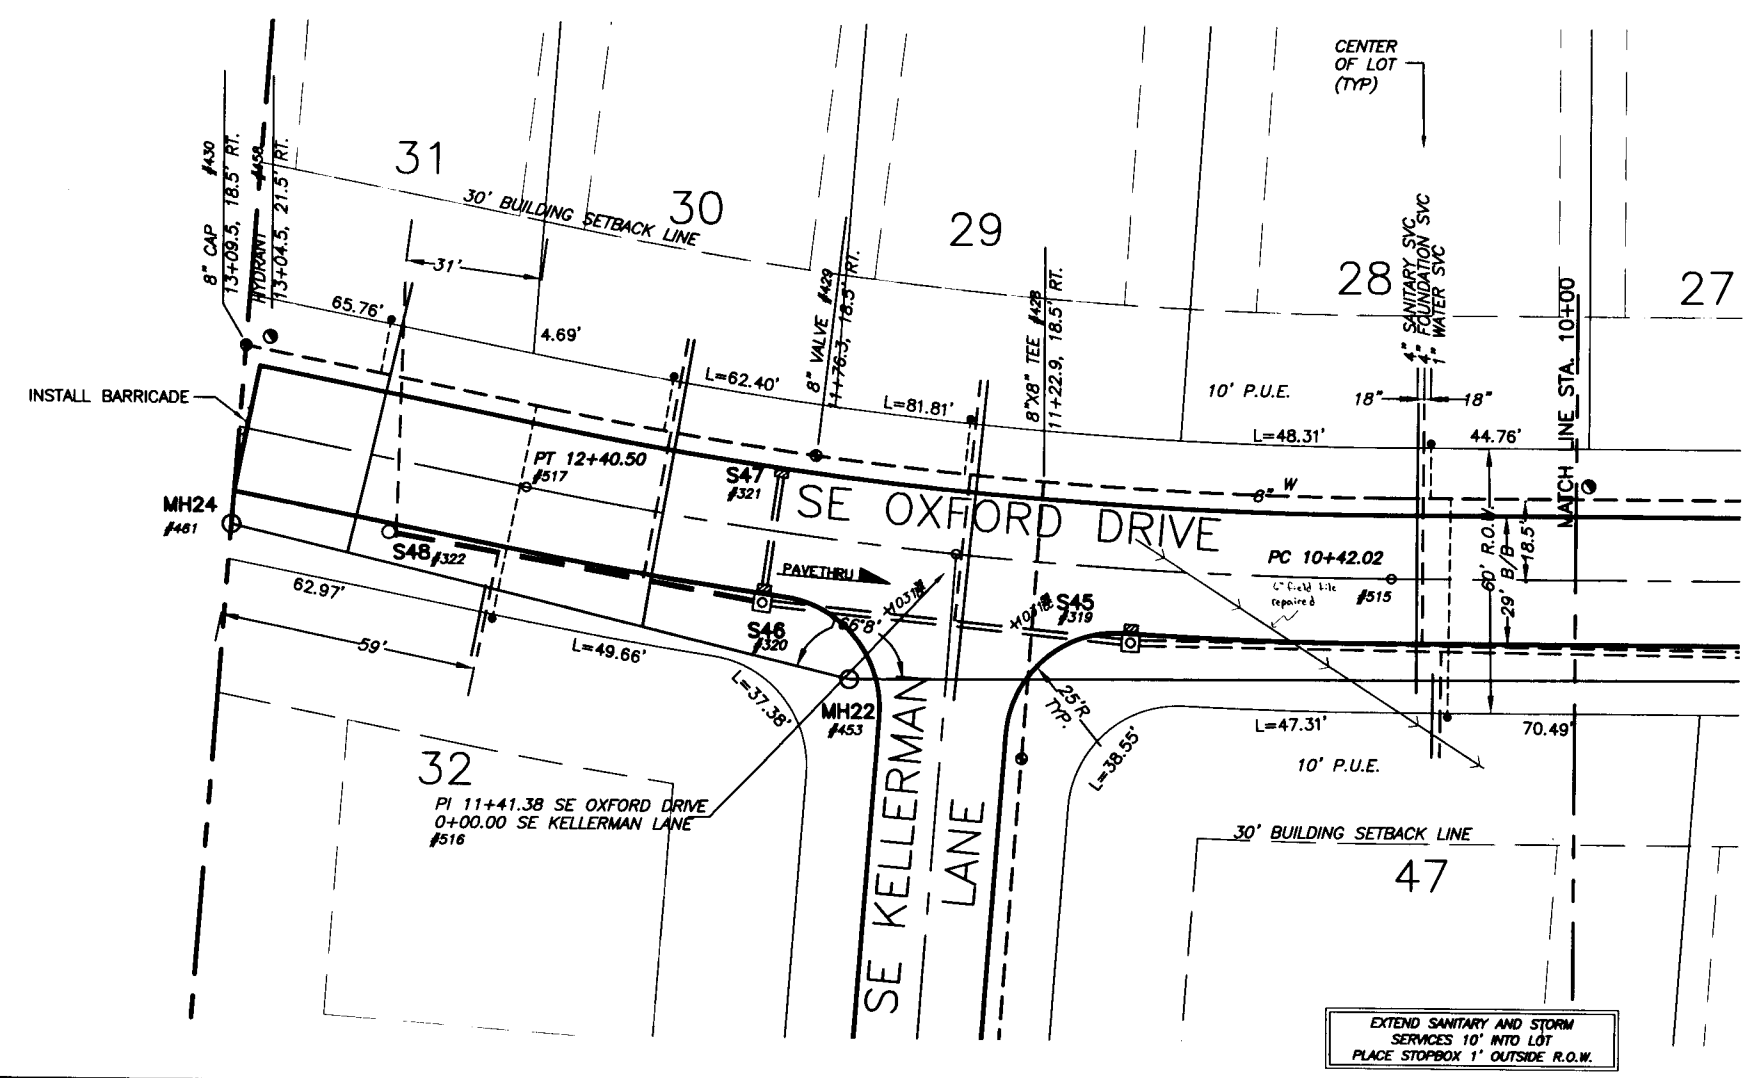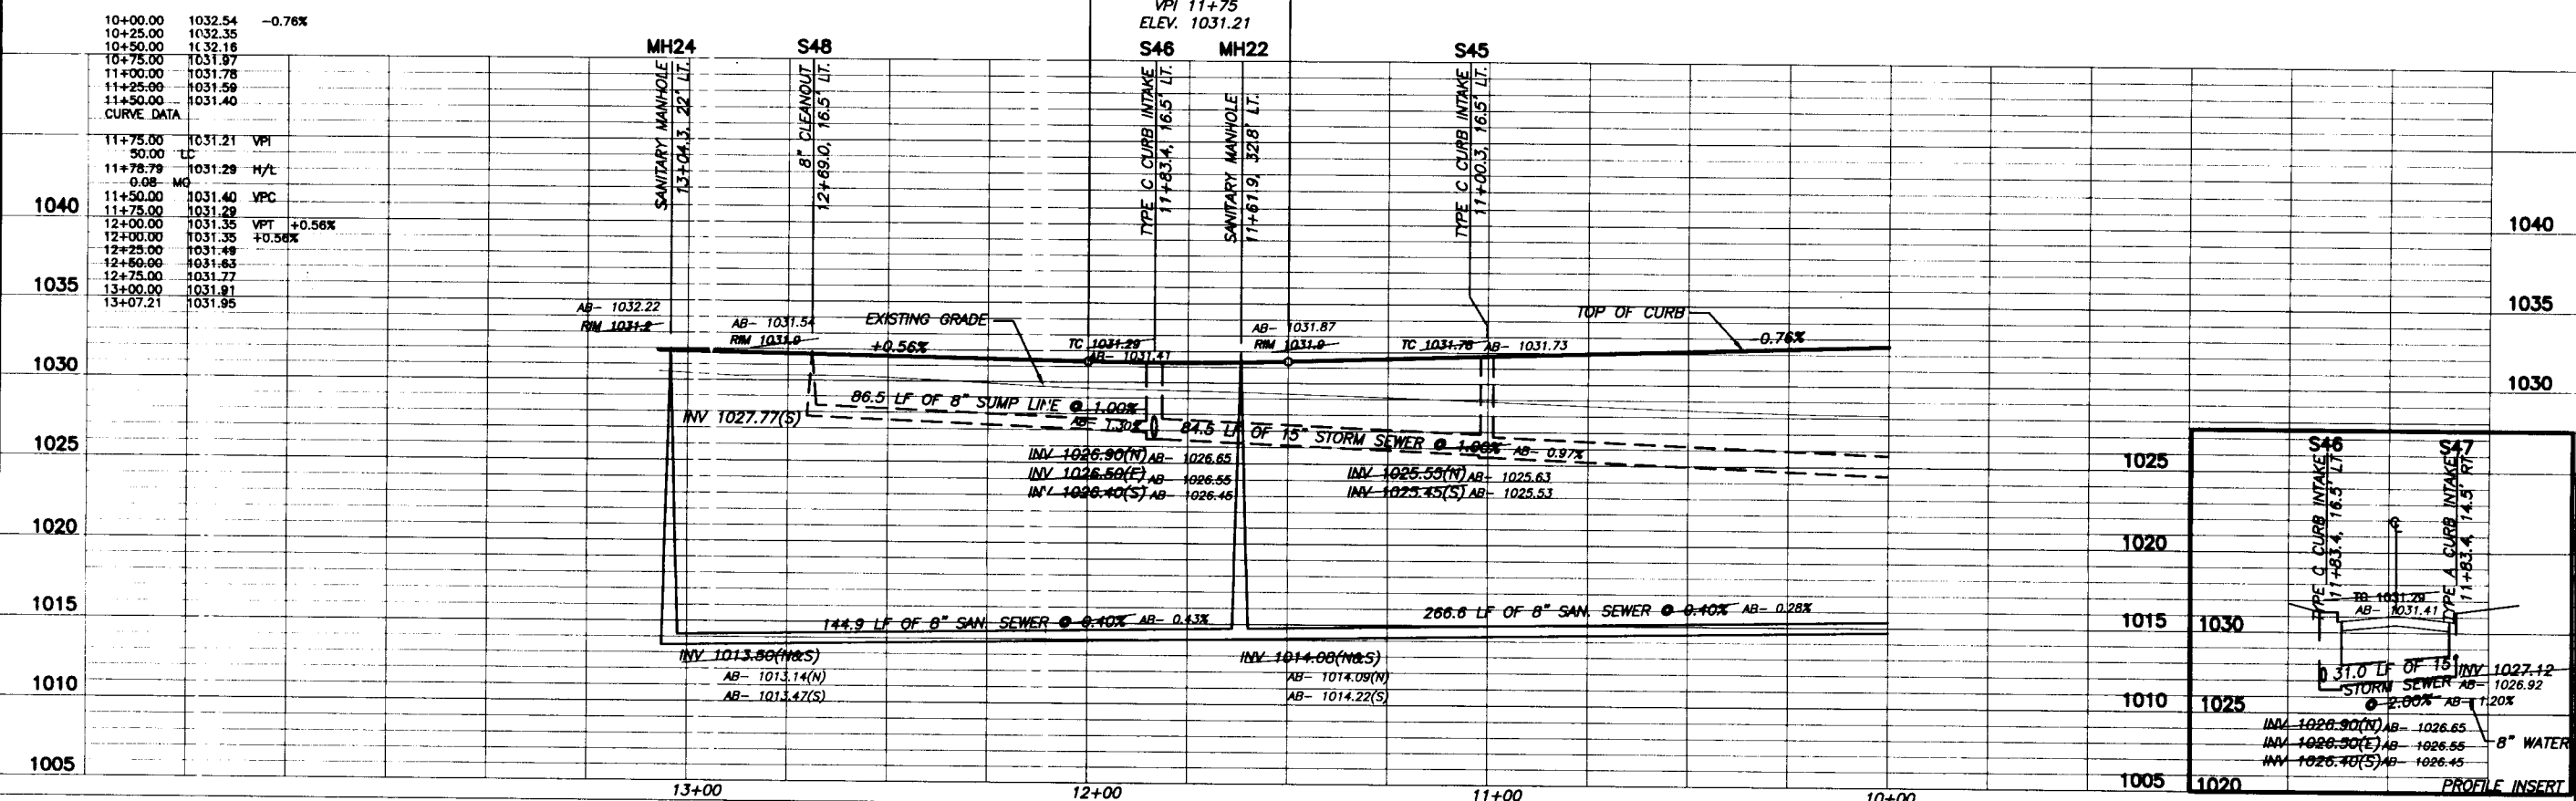

DATE: 1/29/05

SIGNED: LARRY J. SCHAEFER, P.E., L.S. IOWA REG. NO. 1026
BY REGISTRATION RENEWAL IS DECEMBER 31, 2008.

eds
ENGINEERING DESIGN SERVICES
14225 UNIVERSITY AVE. SUITE 220 - WAUKEE, IOWA 50243
PH. (515) 221-1322 / FAX (515) 221-1005
www.engineeringdesignservices.net

REVISIONS

DATE: _____

DATE: _____



DATE: _____


SE OXFORD DRIVE

16 OF 23

SCALE: 1" = 20'

DWG. NO. 20-134

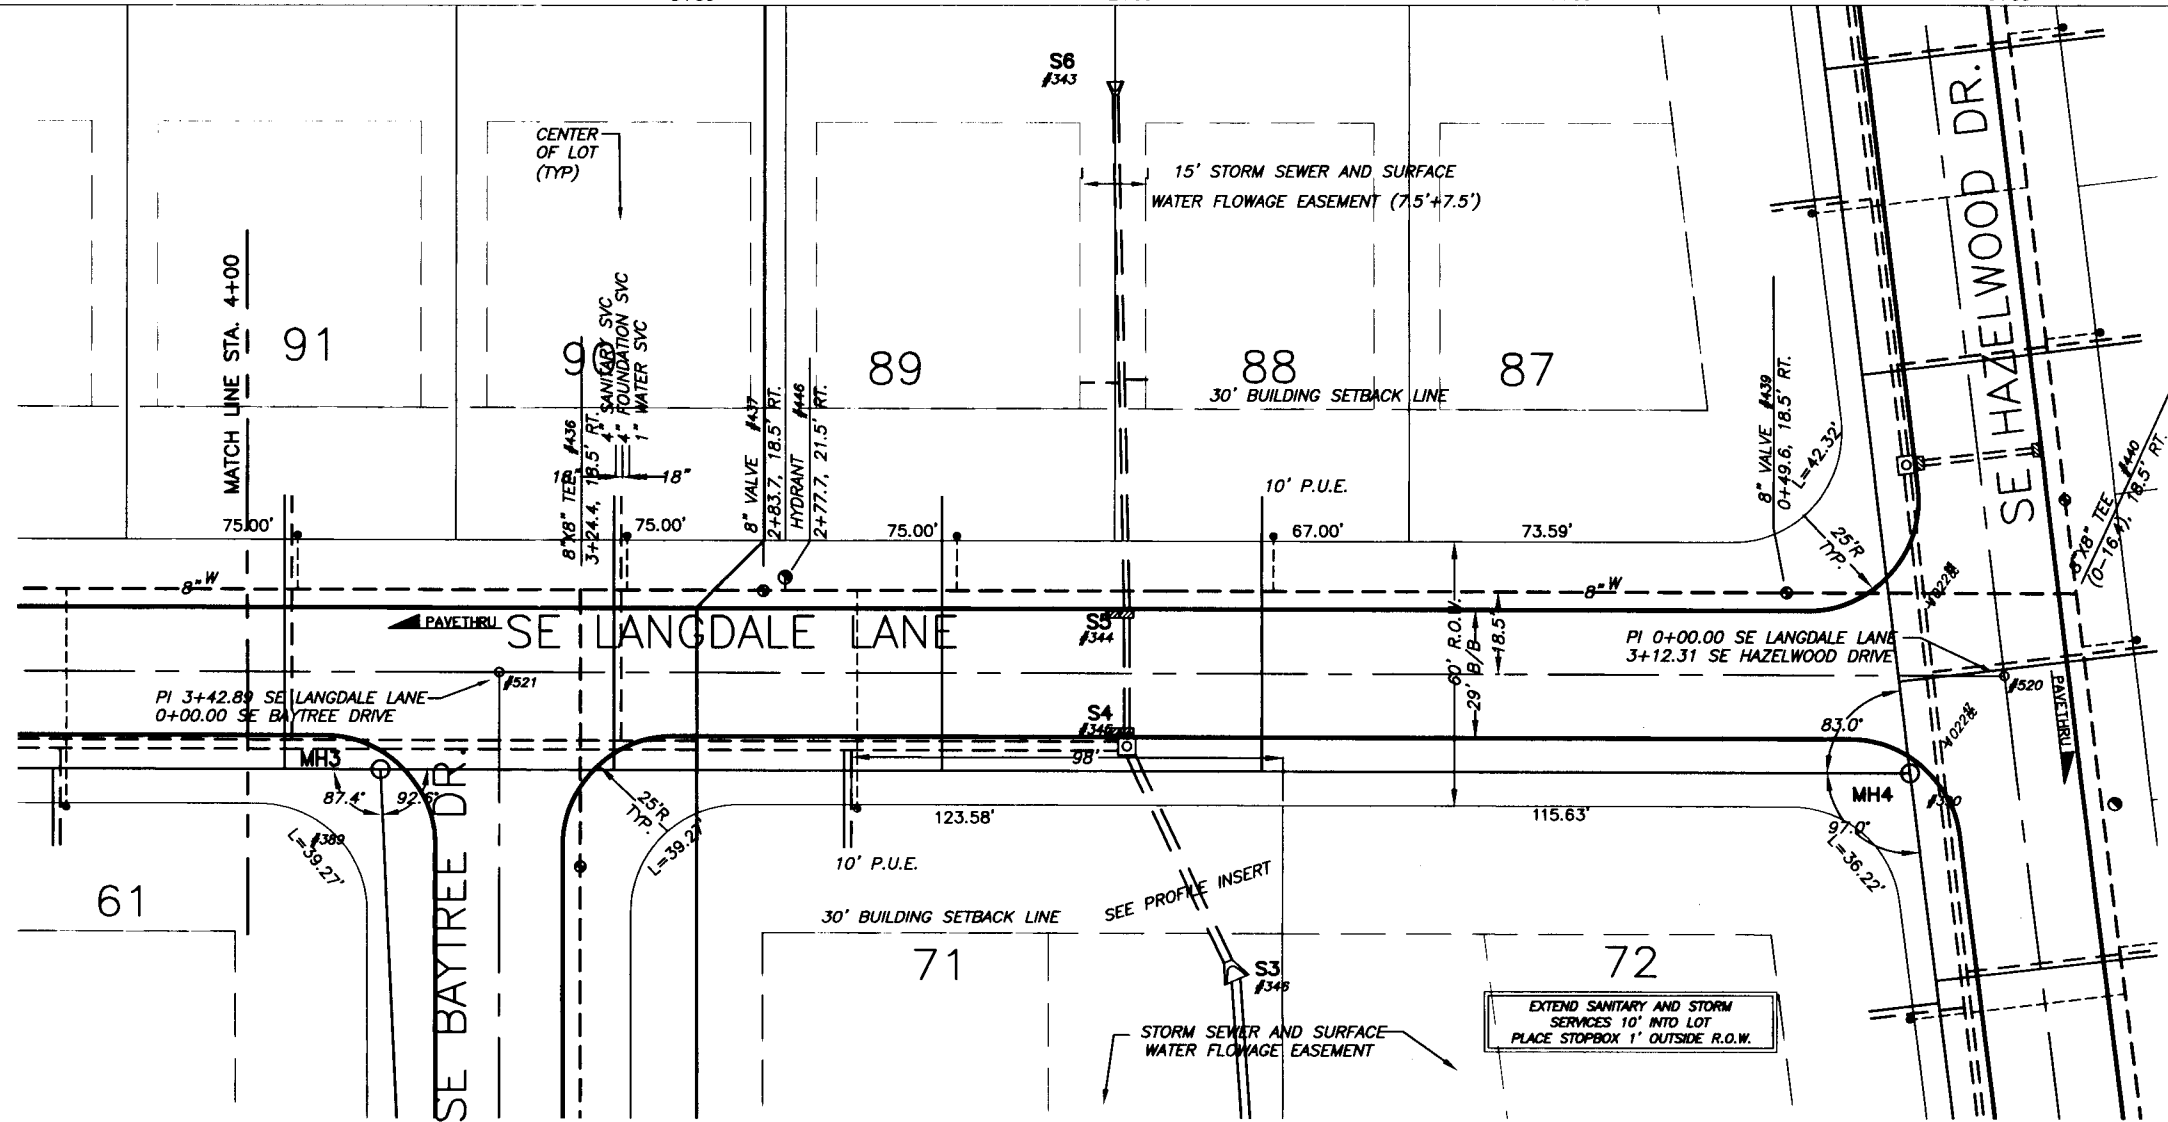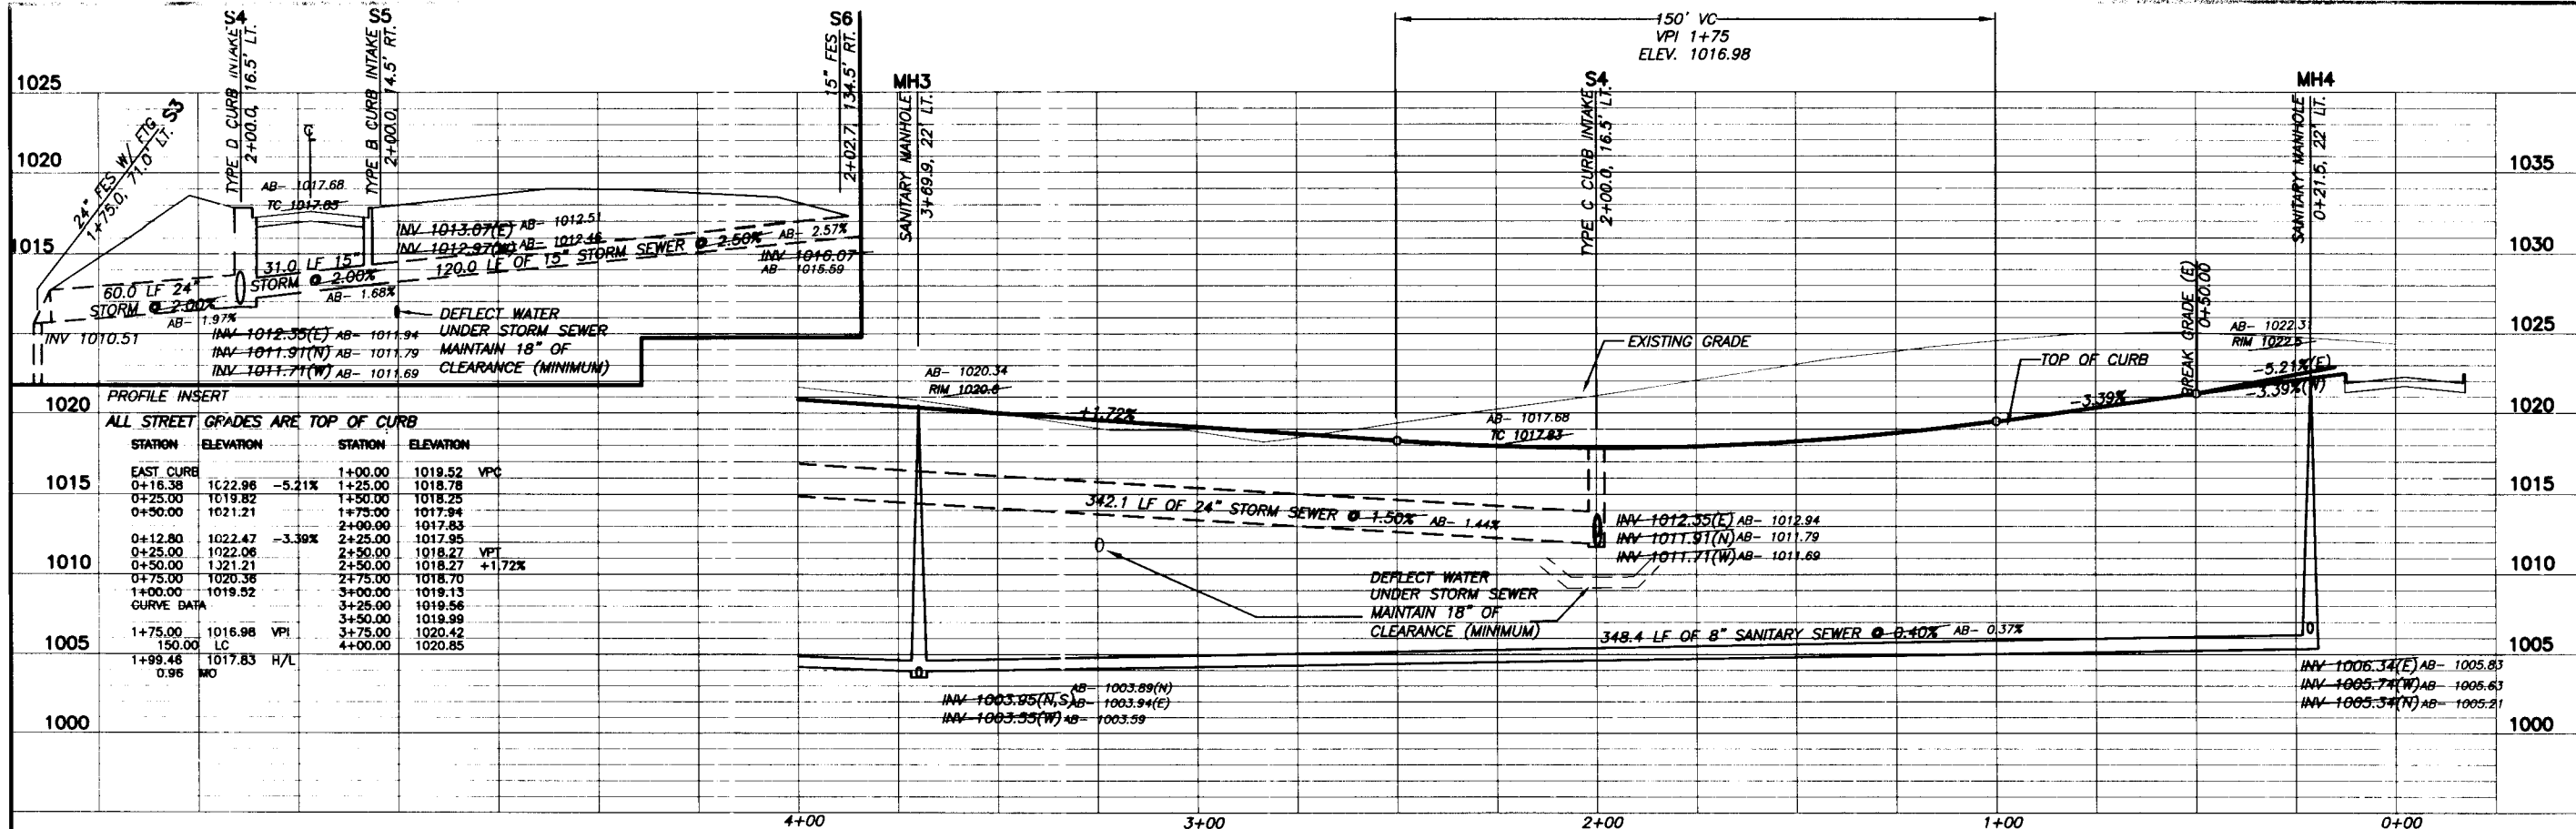

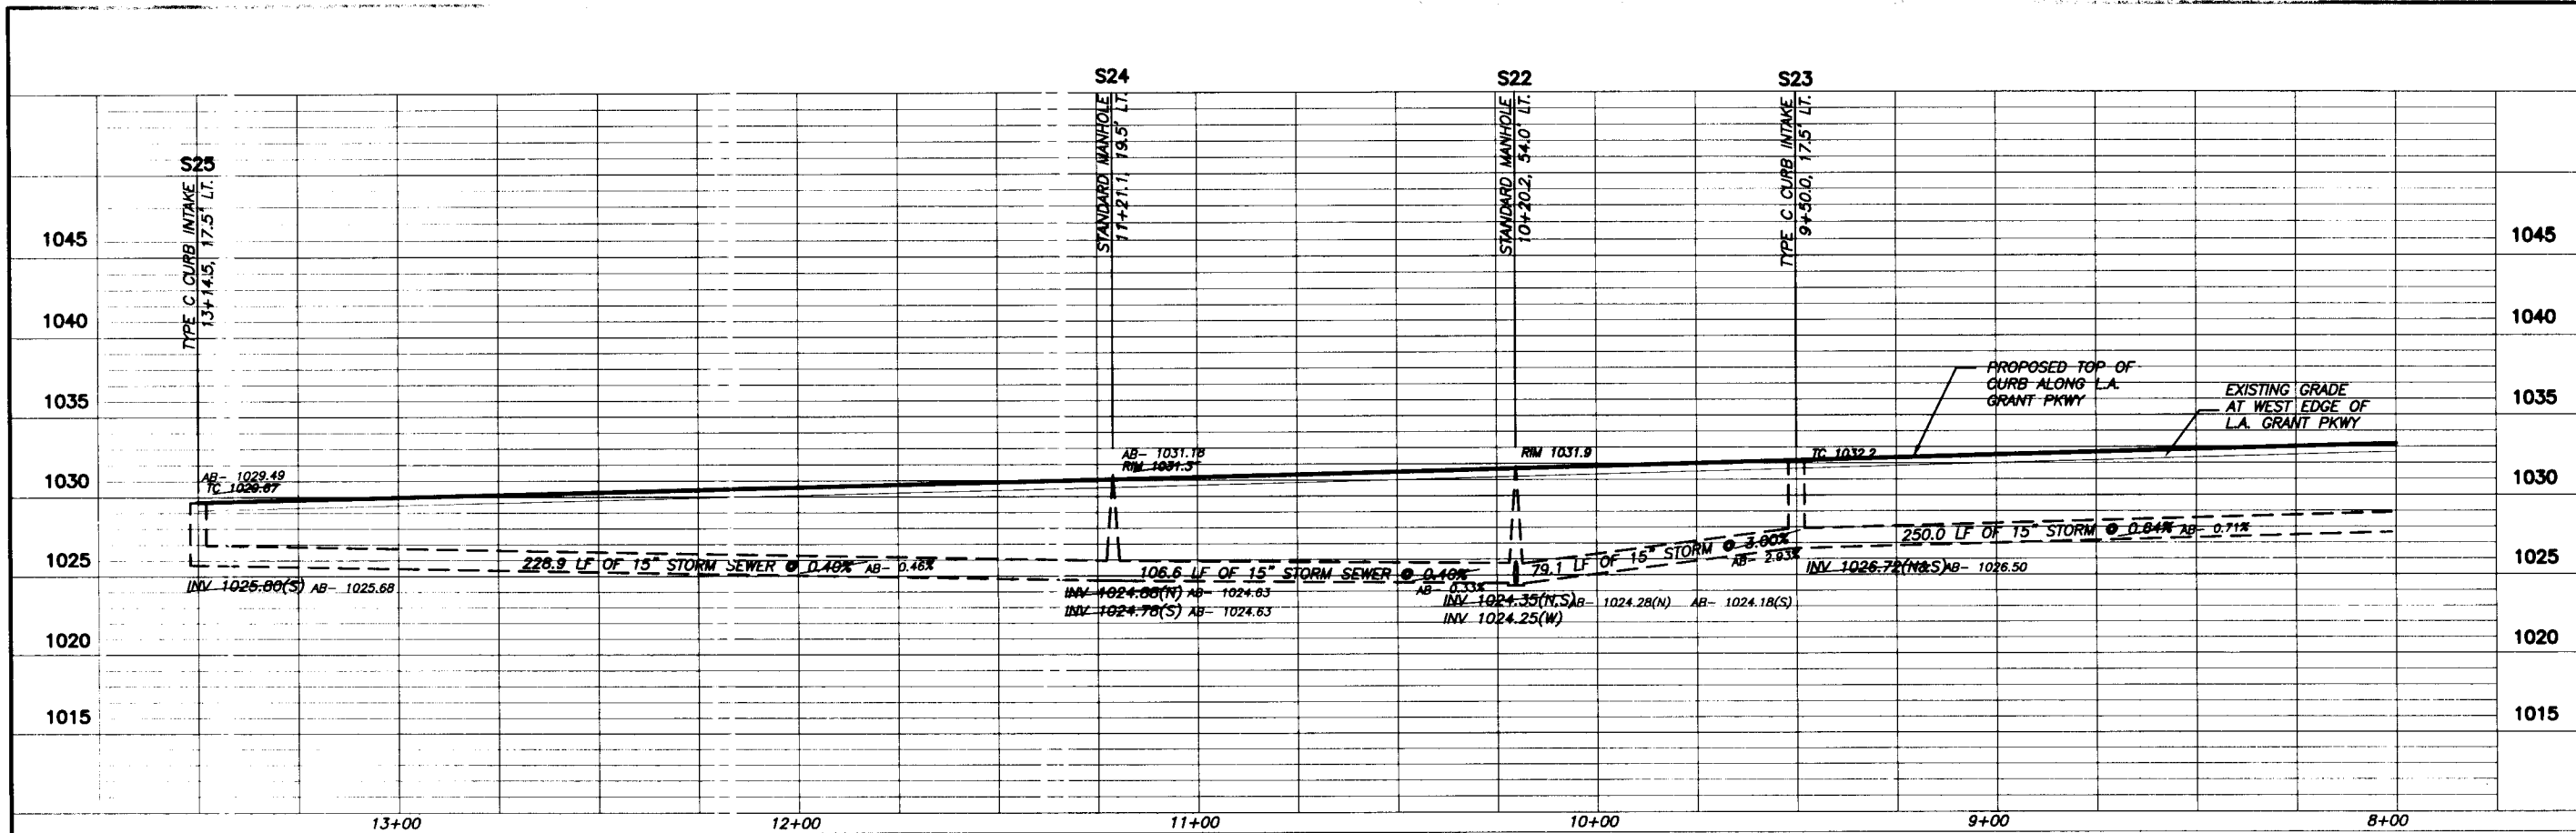

1. HEREBY CERTIFY THAT THIS PLAN, SPECIFICATION OR REPORT WAS PREPARED BY ME OR UNDER MY DIRECT PERSONAL SUPERVISION AND THAT I AM A LICENSED PROFESSIONAL ENGINEER UNDER THE LAWS OF THE STATE OF IOWA.

SIGNED: _____ DATE: _____

LARRY J. RICHARDS, P.E. & L.S. IOWA REG. NO. 7006
BY REGISTRATION EXPIRATION IS DECEMBER 31, 2006

eds
ENGINEERING DESIGN SERVICES
14225 UNIVERSITY AVE. SUITE 220 - WAUKESHA, IOWA 50603
PH: (515) 231-1321 / FAX: (515) 231-1085

REVISIONS:

DATE: _____

DATE: 2-22-02

DRAWN: _____

HEMINGWAY

20 OF 23

SCALE: 1" = 20'


DWG. NO. 20-134



JOB NO. _____

www.engineeringdesignservices.net

WAUKESHA, IOWA

L.A. GRANT PARKWAY

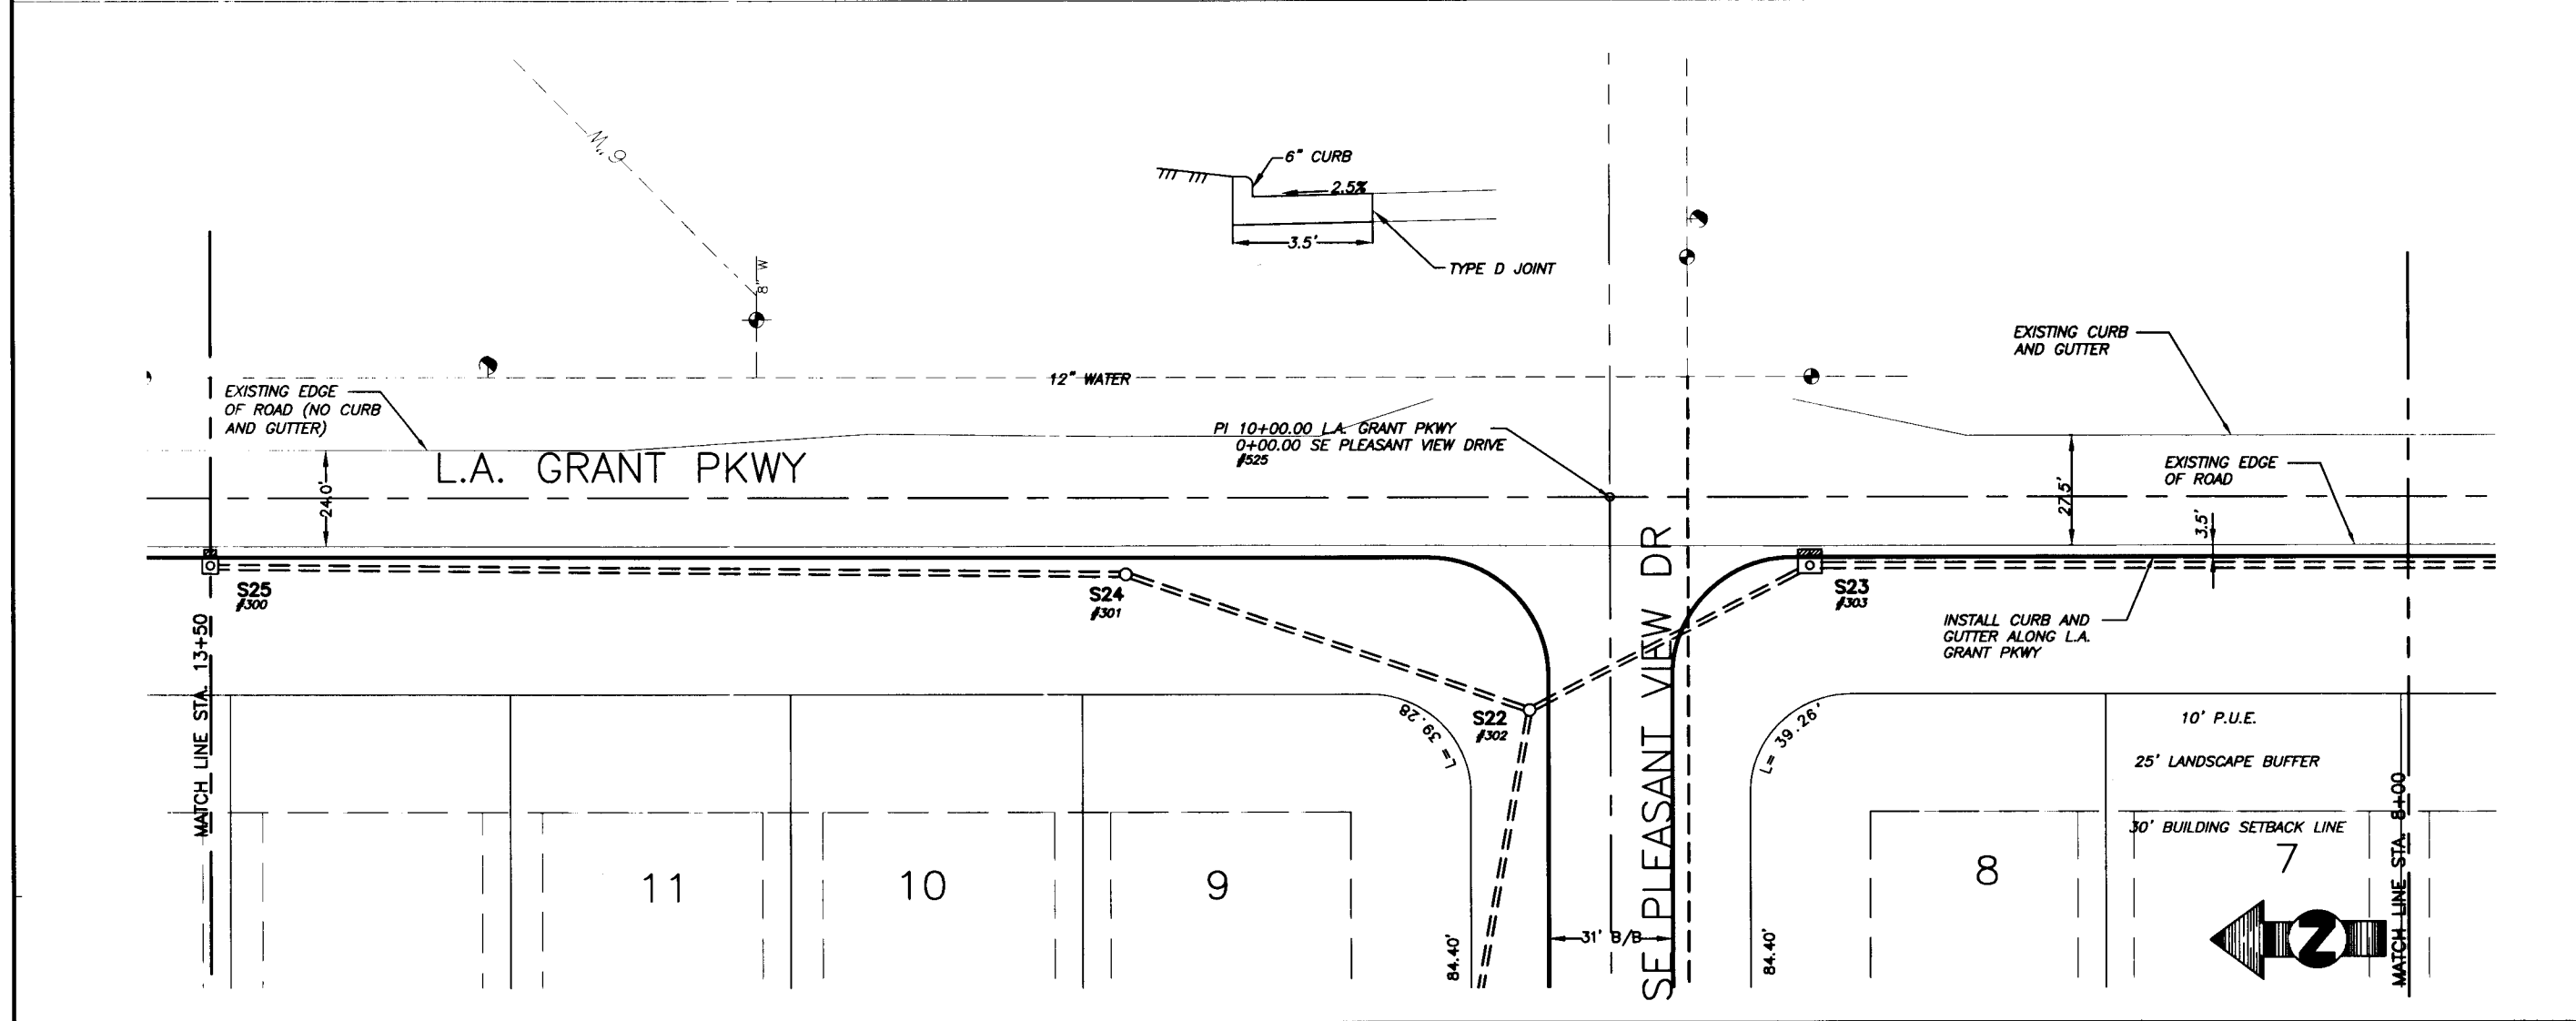

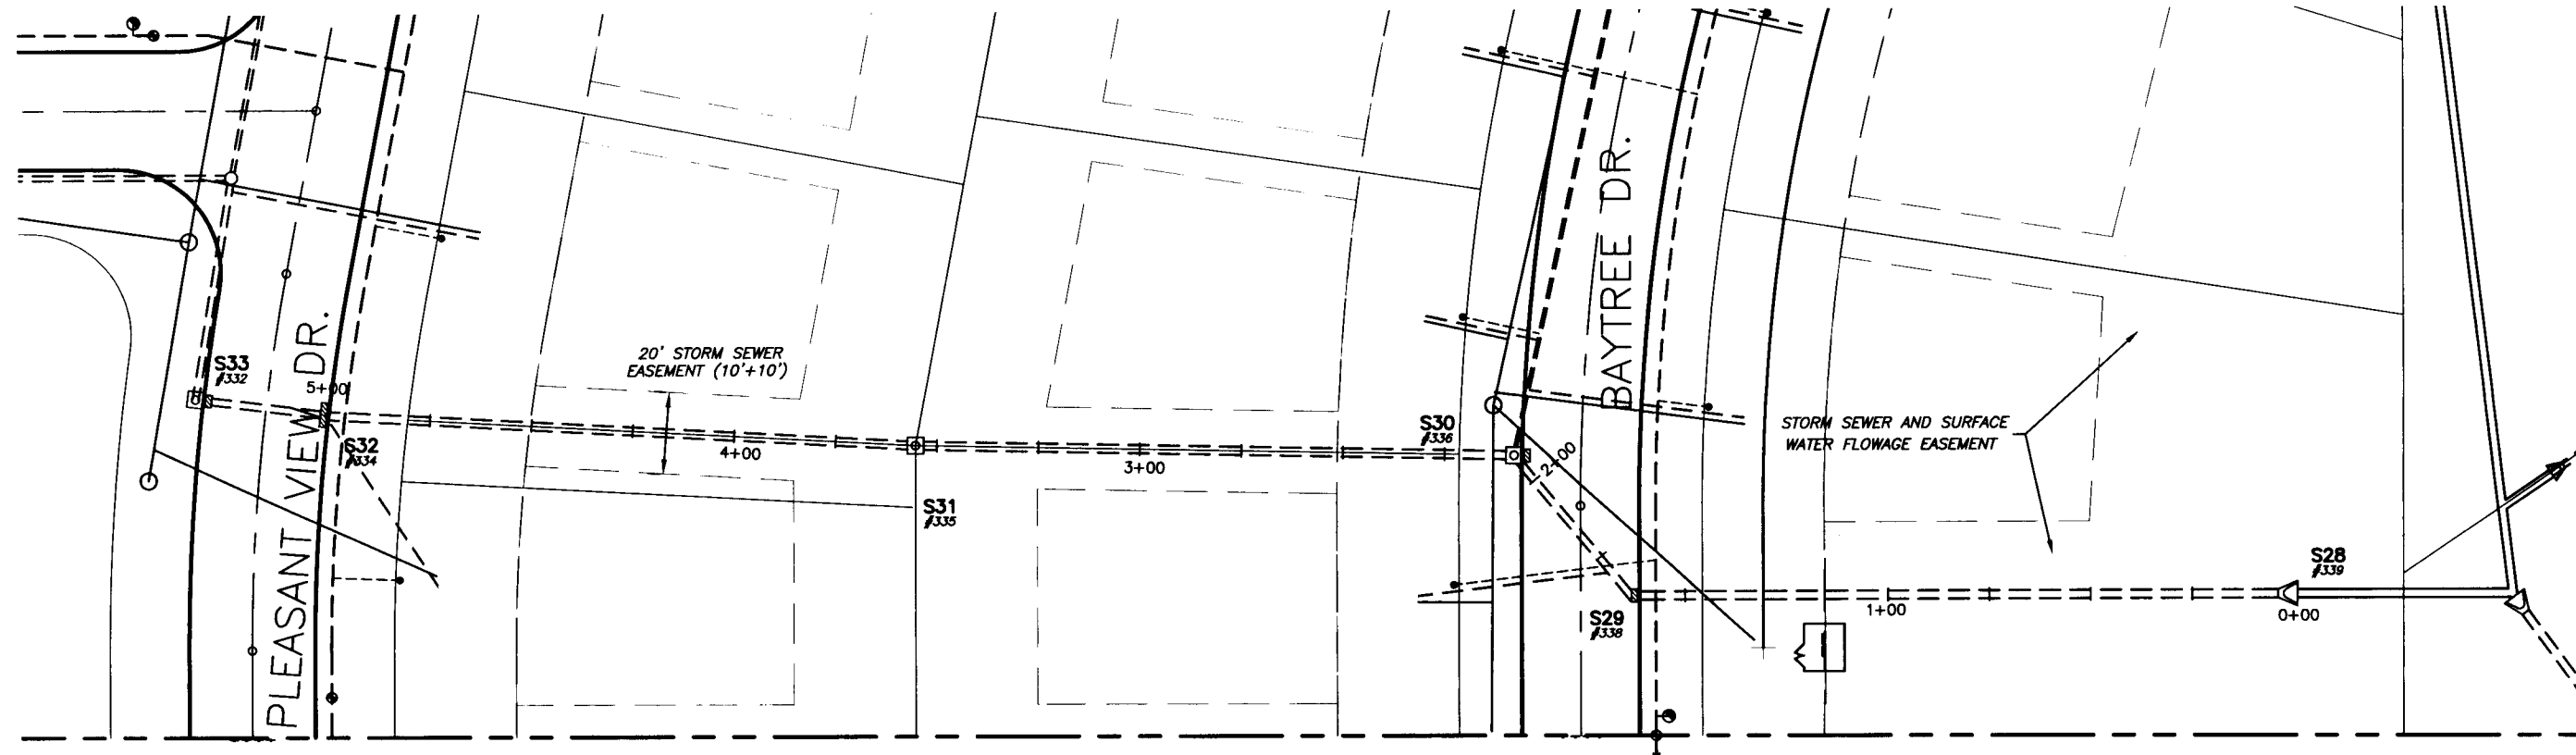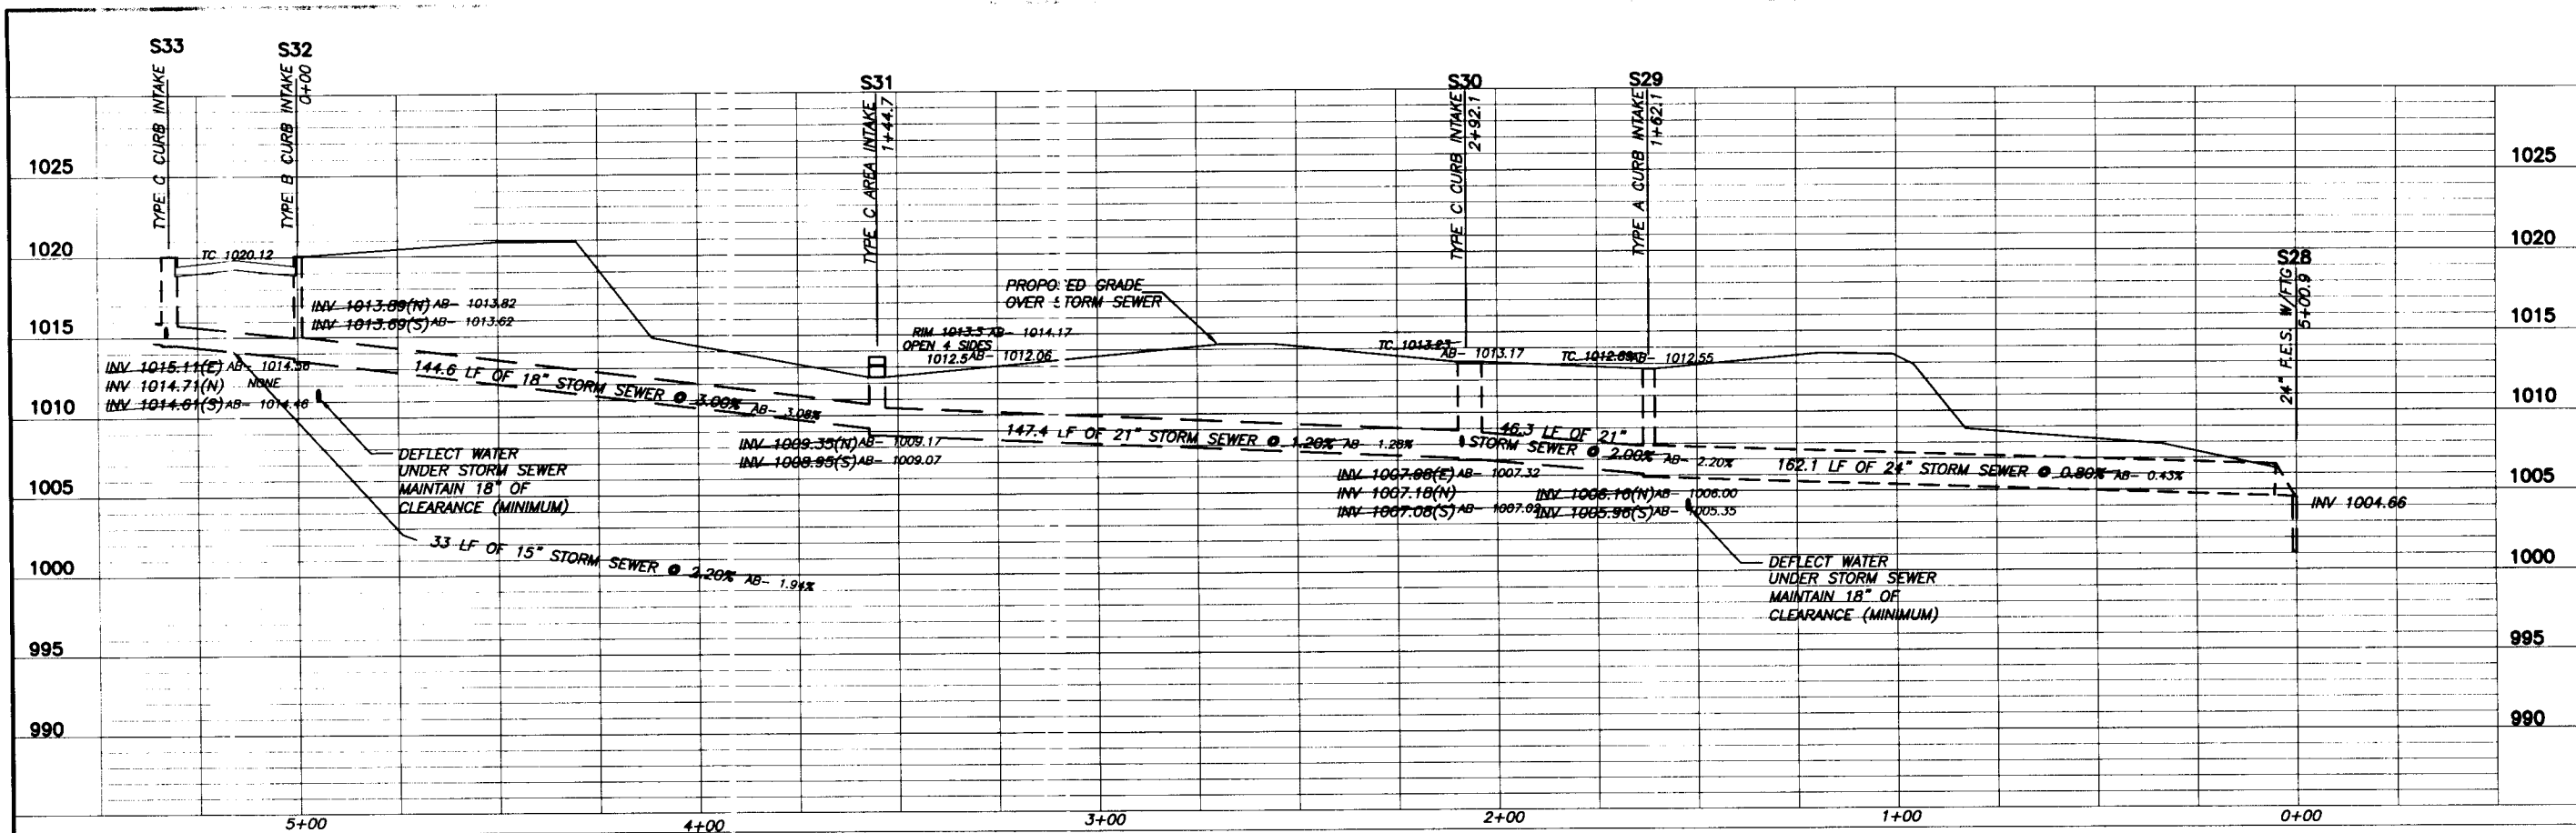

STORM SEWER OUTLET

DATE: _____

REVISIONS: _____

DATE: _____

DATE: _____

DATE: _____

DATE: 4/29/05

DATE: _____

DATE: _____

DATE: _____

DWG. NO. 22 OF 23

SCALE: 1" = 20'

TOR. NO. 20-134

www.engineeringdesignservices.net

HEMINGWAY

WAUKEL, IOWA

DRAWN: _____

DATE: 4/29/05

eds

ENGINEERING DESIGN SERVICES

14225 UNIVERSITY AVE SUITE 220 - WAUKEL, IOWA 50263

PH (515) 221-1322 FAX (515) 221-1085

1. HEREBY CERTIFY THAT THIS PLAN, SPECIFICATION OR REPORT WAS PREPARED BY ME OR UNDER MY DIRECT PERSONAL SUPERVISION AND THAT I AM A LICENSED PROFESSIONAL ENGINEER UNDER THE LAWS OF THE STATE OF IOWA.

SIGNED: _____

