

REVISION

COLOR ELEVATIONS
RM
20005
03.25.2022

AC001


	3,114 S.F.	100%	TOTAL AREA	
	1,086 S.F.	35%	GLASS	CLEAR GLASS IN DARK BRONZE ALUMINUM FRAMES
	1,073 S.F.	35%	MASONRY	APPLIED MASONRY VENEER
	649 S.F.	20%	EIFS	EXTERIOR INSULATION FINISH SYSTEM
	336 S.F.	10%	ACP	ALUMINUM COMPOSITE PANEL



**NORTH ELEVATION**  
NO SCALE

NOTE:  
THESE ELEVATIONS HAVE BEEN DESIGNED TO MEET THE REQUIREMENTS OF THE CITY OF WAUKEE'S ARCHITECTURAL DESIGN STANDARDS AND THE APPROVAL OF THE PLANNING COMMISSION / CITY OF WAUKEE. CHANGES SHALL NOT BE MADE TO THE APPROVED ELEVATIONS UNLESS APPROVED BY THE LOCAL JURISDICTION.

	1,175 S.F.	100%	TOTAL AREA	
	114 S.F.	10%	GLASS	CLEAR GLASS IN DARK BRONZE ALUMINUM FRAMES
	810 S.F.	69%	MASONRY	APPLIED MASONRY VENEER
	189 S.F.	16%	EIFS	EXTERIOR INSULATION FINISH SYSTEM
	62 S.F.	5%	ACP	ALUMINUM COMPOSITE PANEL

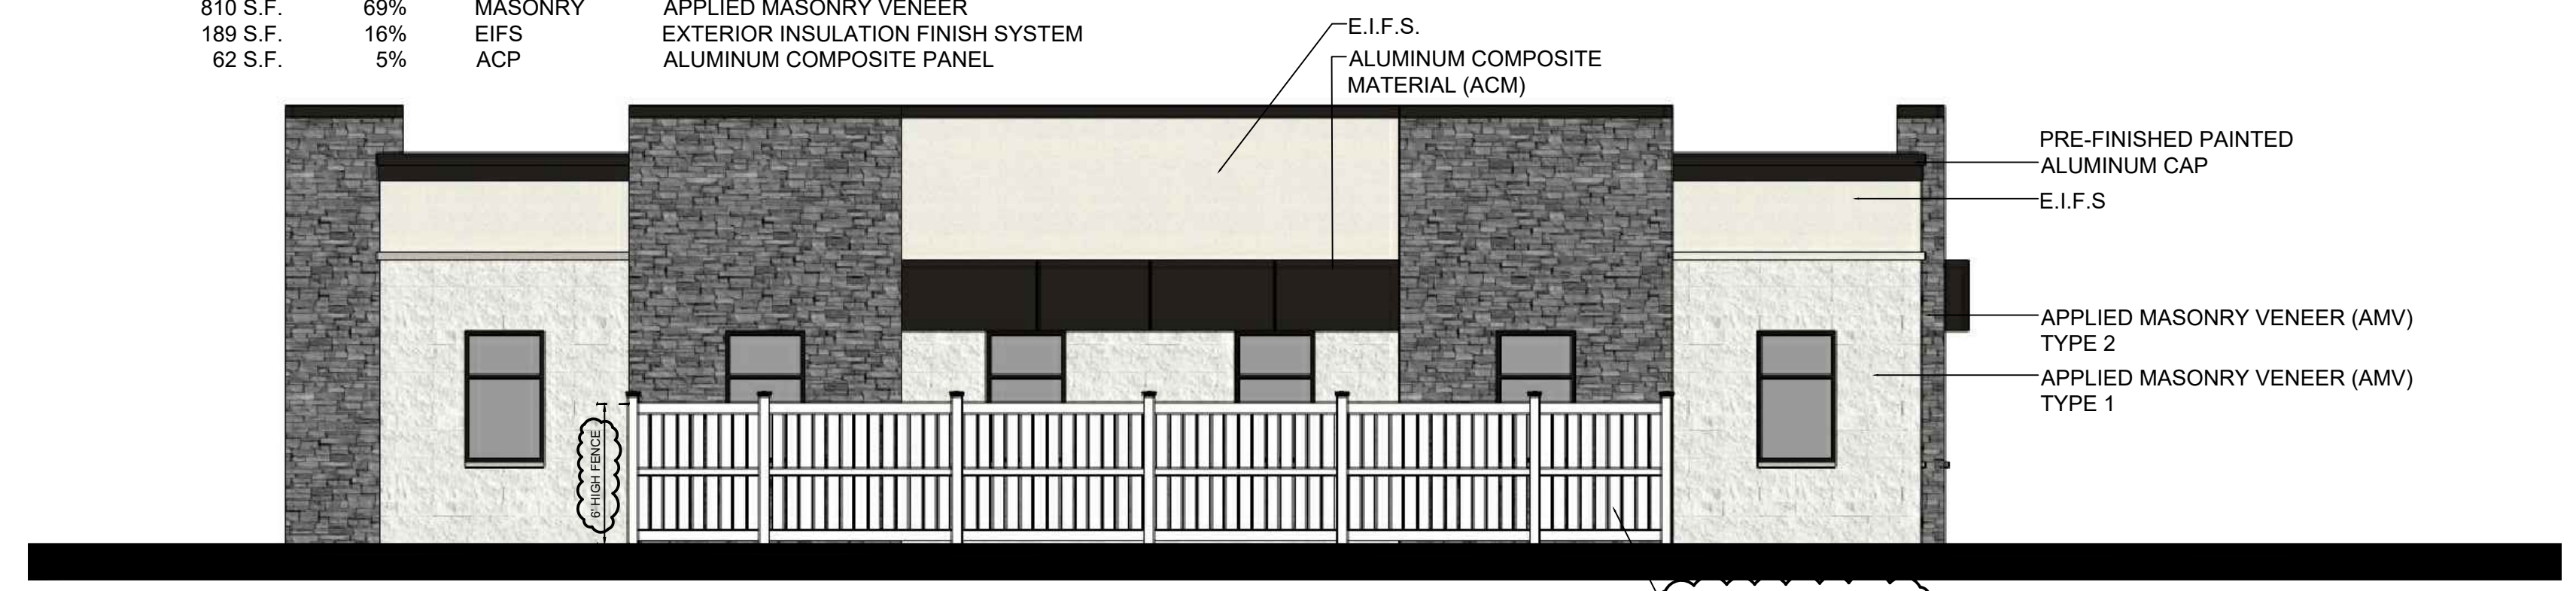

**WEST ELEVATION**  
NO SCALE

NOTE:  
THESE ELEVATIONS HAVE BEEN DESIGNED TO MEET THE REQUIREMENTS OF THE CITY OF WAUKEE'S ARCHITECTURAL DESIGN STANDARDS AND THE APPROVAL OF THE PLANNING COMMISSION / CITY OF WAUKEE. CHANGES SHALL NOT BE MADE TO THE APPROVED ELEVATIONS UNLESS APPROVED BY THE LOCAL JURISDICTION.

WHITE VINYL FENCE, 6' HIGH.

