


1  
A1.1 CONCEPTUAL FLOOR PLAN  
SCALE: 3/16" = 1'-0" @ 36X24

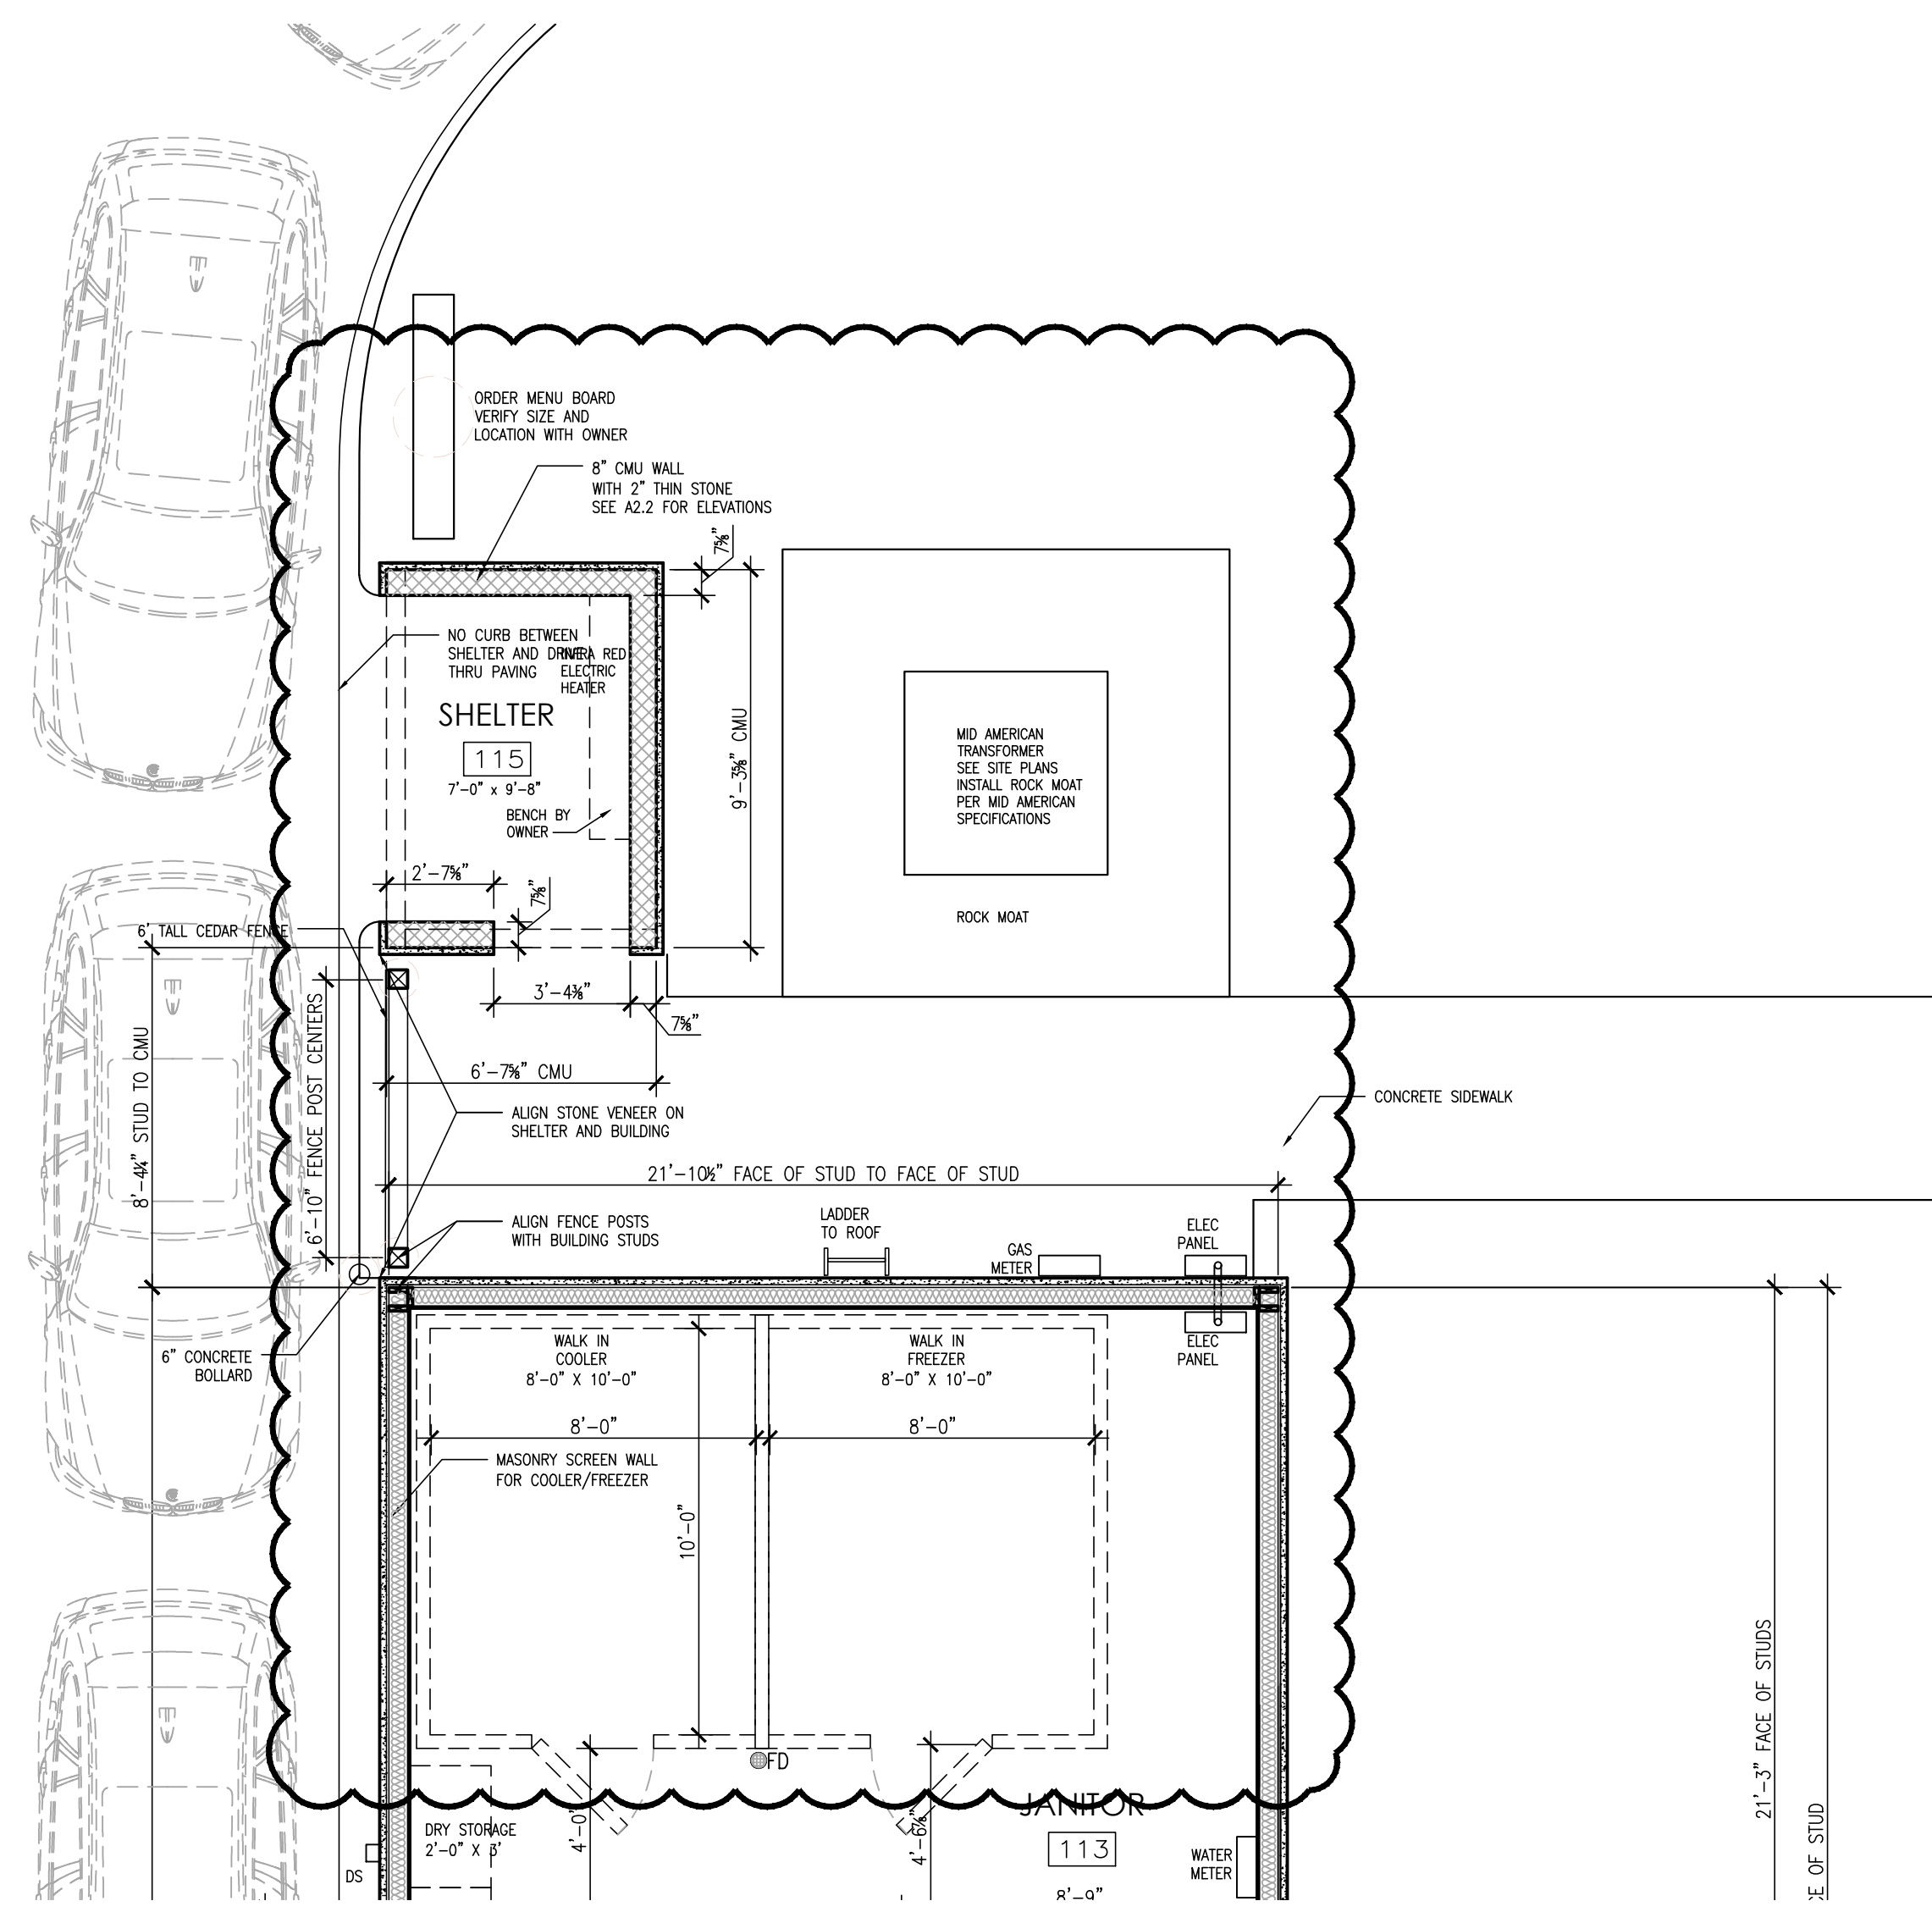

2  
A1.1 OUTDOOR SHELTER AREA AND SCREEN FENCE  
SCALE: 3/16" = 1'-0" @ 36X24

REISSUED WITH RESPONSES TO STAFF COMMENT 12-23-2025

The Design Partnership, LLP  
Architects + Planners



This drawing is provided for informational purposes only. Any reproduction or use of this drawing without the written consent of The Design Partnership, LLP is strictly prohibited. © Copyright 2025 by The Design Partnership, LLP

ISSUED / REVISION	DATE
PRELIMINARY	7-21-2025
ISSUED FOR PERMITS	2-28-2024
ISSUED FOR PRELIMINARY APPROVAL	3-15-2024
ISSUED FOR CITY COUNCIL MTG	3-27-2024
METAL STUD WALL NOTE	5-31-2024
HOOD WALL ASSEMBLY NOTE	6-4-2024


Charlotte's Kitchen  
Drive Thru Restaurant  
1165 SE University Avenue  
Waukee, Iowa 50263



JOB NO. 250046-5

TITLE DIMENSIONED FLOOR PLANS


SHEET A1.1

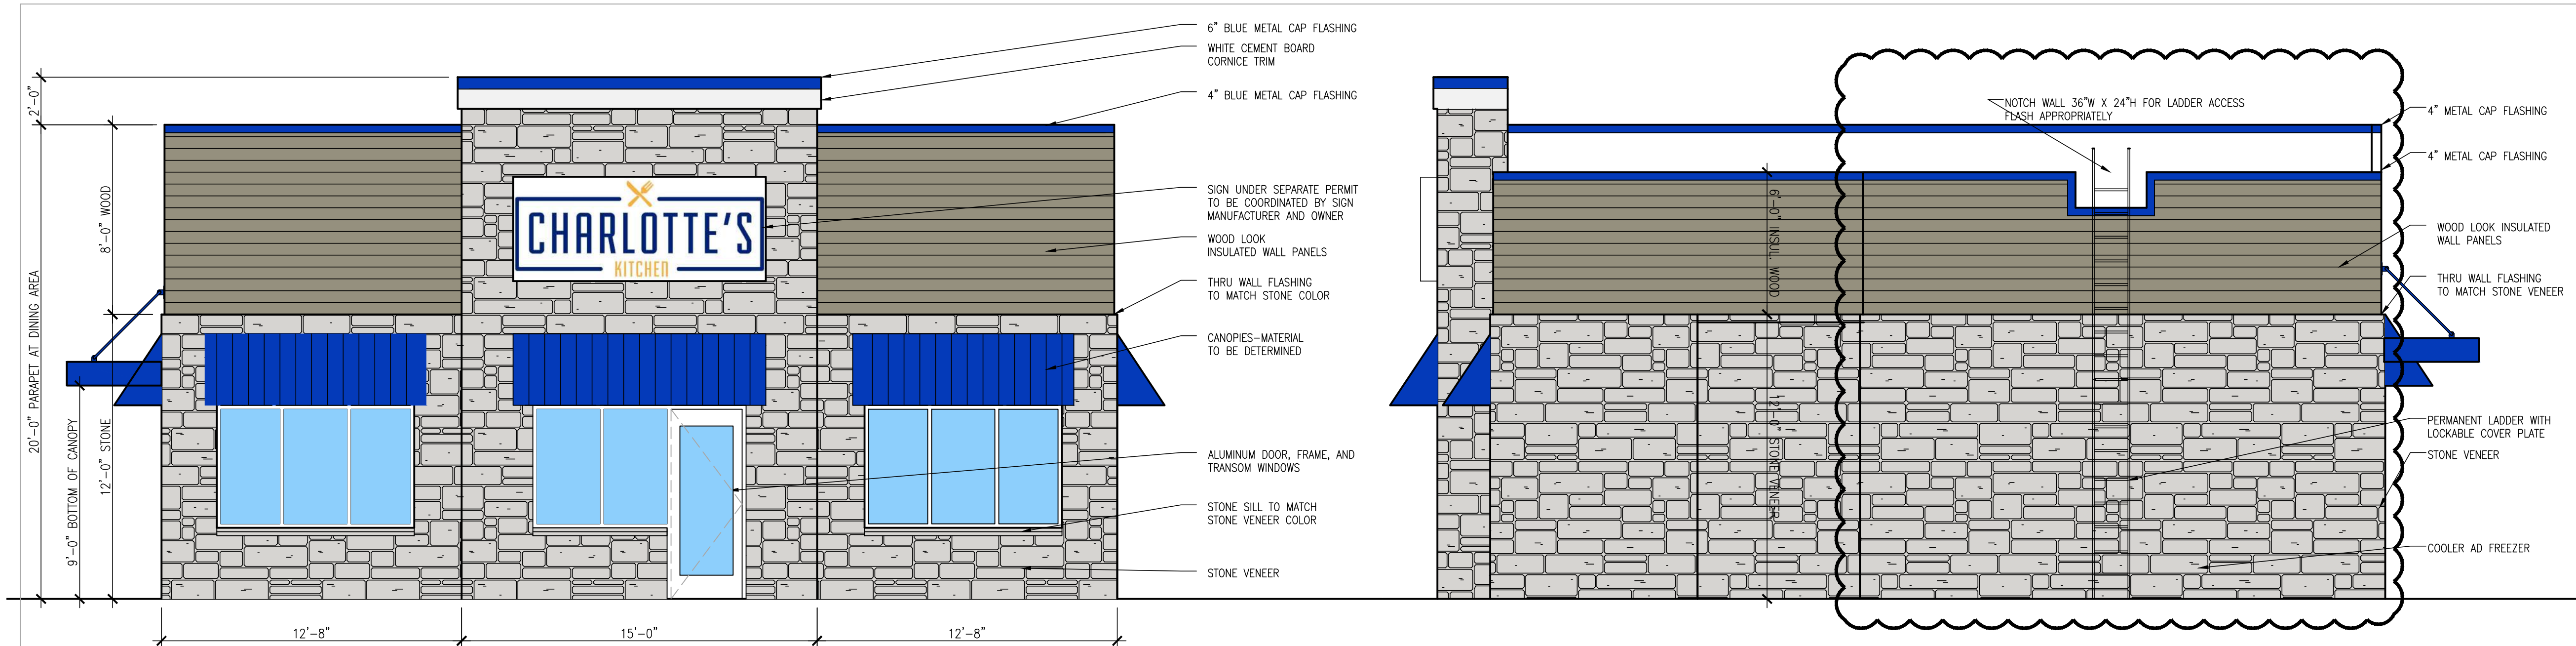


STONE VENEER FOR BUILDING AND TRASH ENCLOSURE

1 SOUTH ELEVATION  
A2.1 SCALE: 1/4" = 1'-0" @ 36X24

2 NORTH ELEVATION  
A2.1 SCALE: 1/4" = 1'-0" @ 36X24

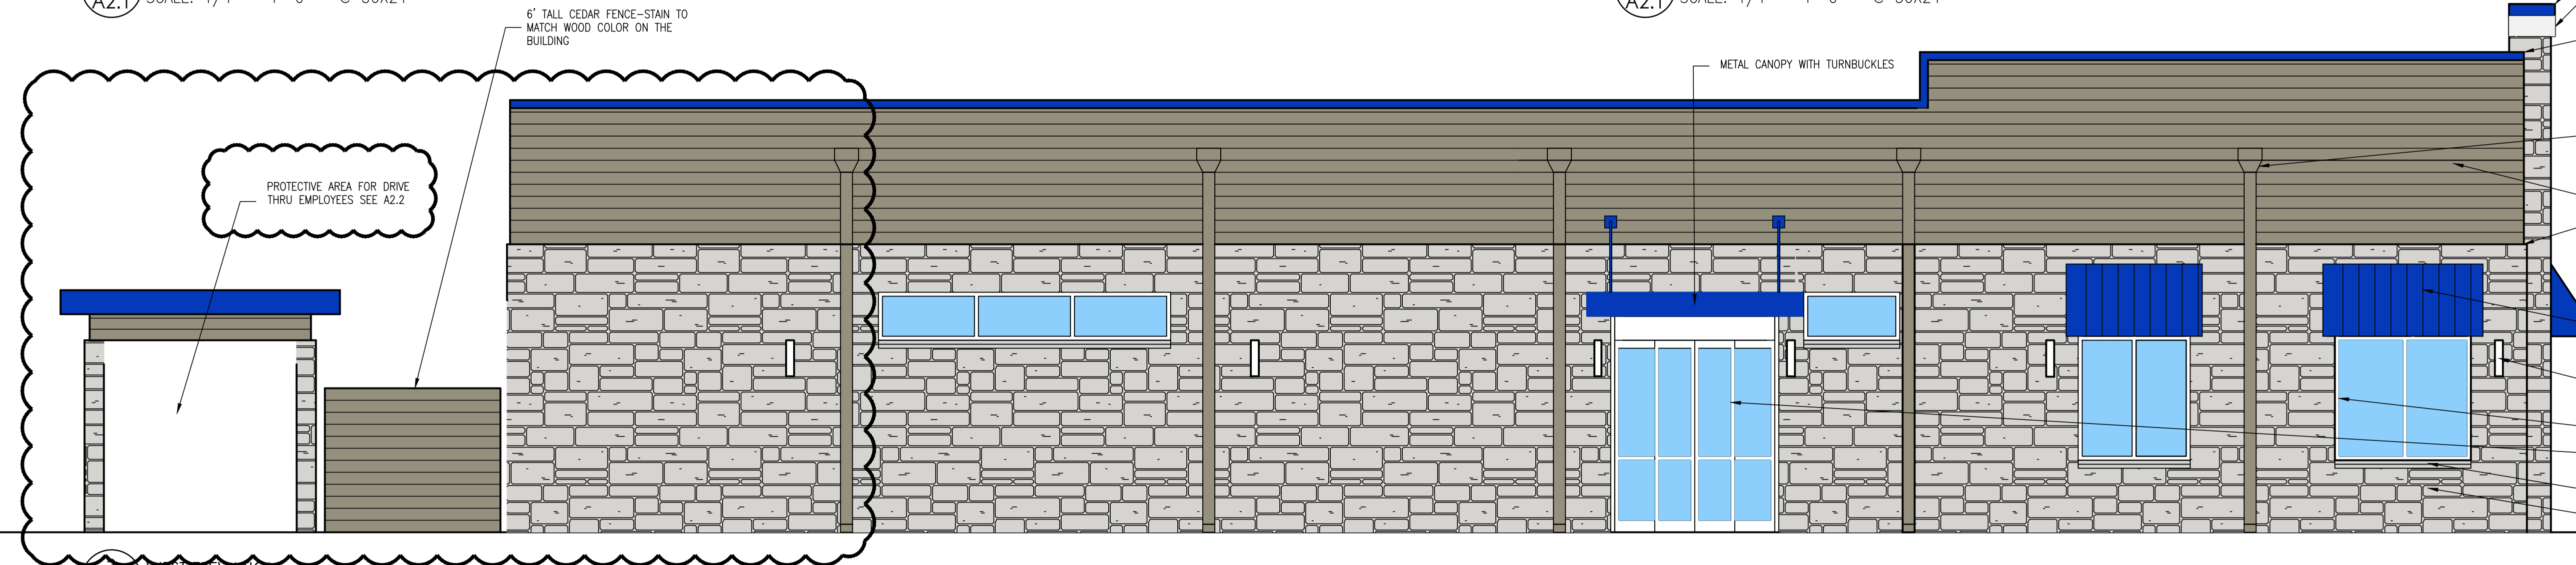

3 WEST ELEVATION  
A2.1 SCALE: 1/4" = 1'-0" @ 36X24

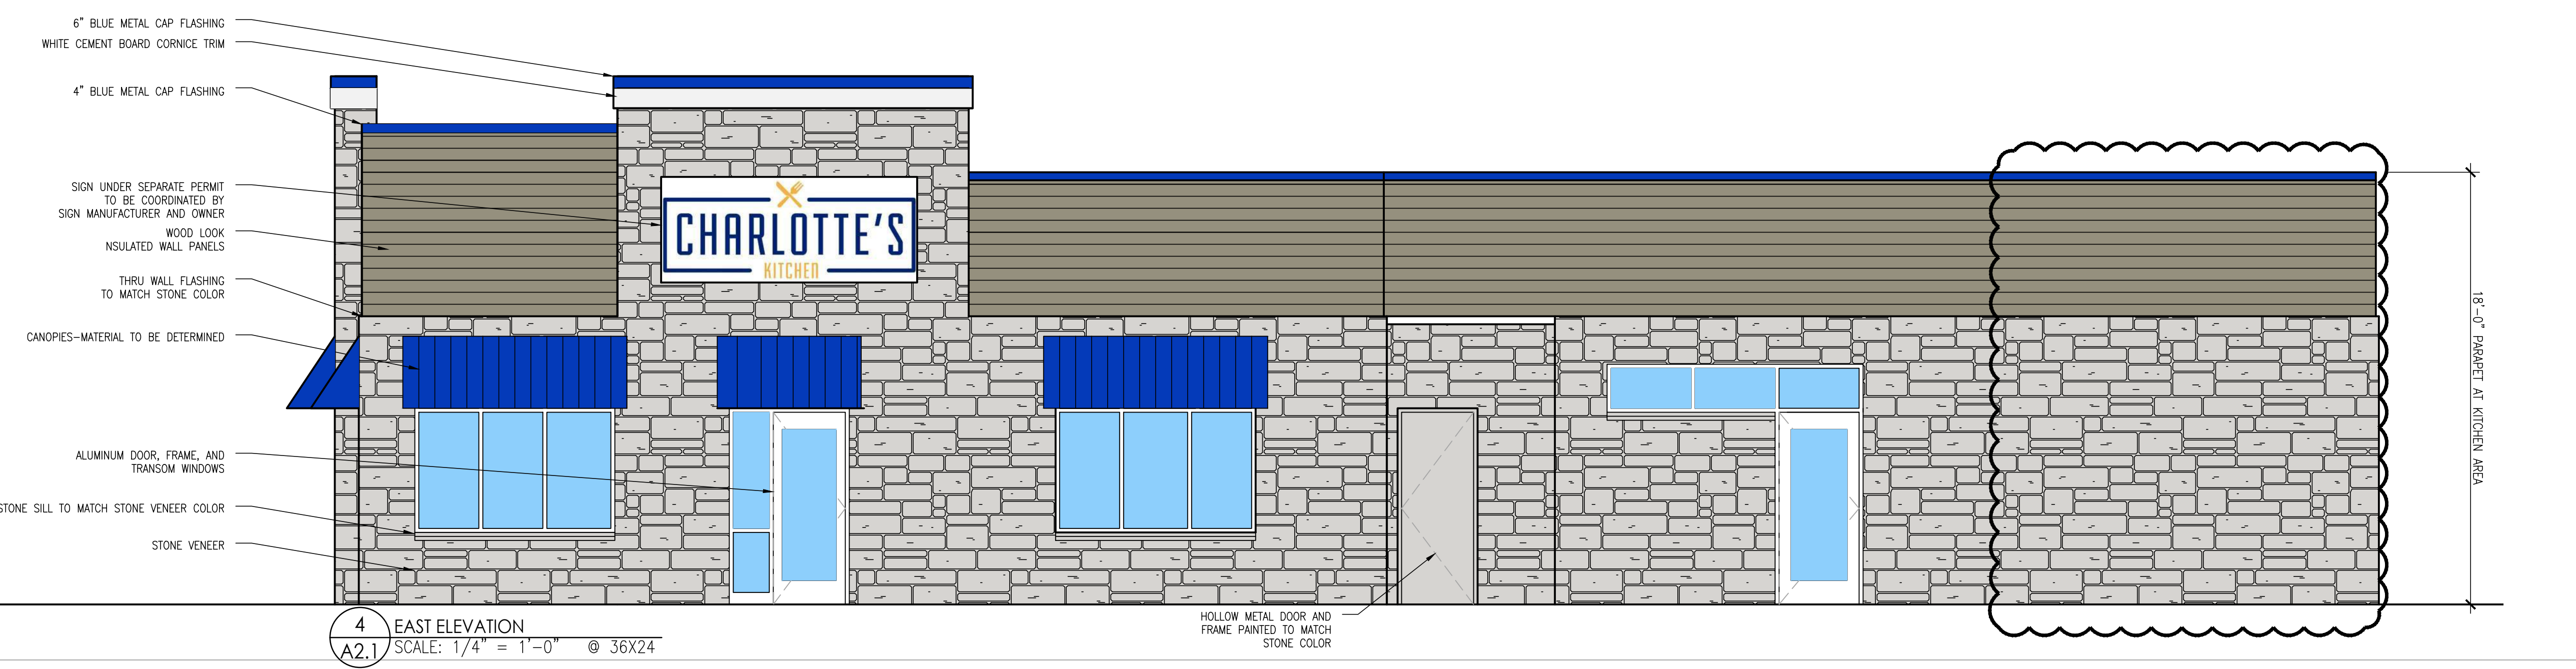

4 EAST ELEVATION  
A2.1 SCALE: 1/4" = 1'-0" @ 36X24

REISSUED WITH RESPONSES TO STAFF COMMENT 12-23-2025

The Design Partnership, LLP  
Architects + Planners

ACCURATE COMMERCIAL

This drawing is provided for informational purposes only. Any reproduction, distribution, or use of this drawing without the written consent of the designer is strictly prohibited. Copyright © 2025 by The Design Partnership, LLP.

ISSUED / REVISION	DATE
PRE-APP REVIEW	7-21-2025
ISSUED FOR CITY COUNCIL MTG	3-27-2024
METAL STUD WALL NOTE	5-31-2024
HOOD WALL ASSEMBLY NOTE	6-4-2024







Charlotte's Kitchen  
Drive Thru Restaurant  
1165 SE University Avenue  
Waukee, Iowa 50263



JOB NO. 250046-5

TITLE EXTERIOR ELEVATIONS

SHEET A2.1

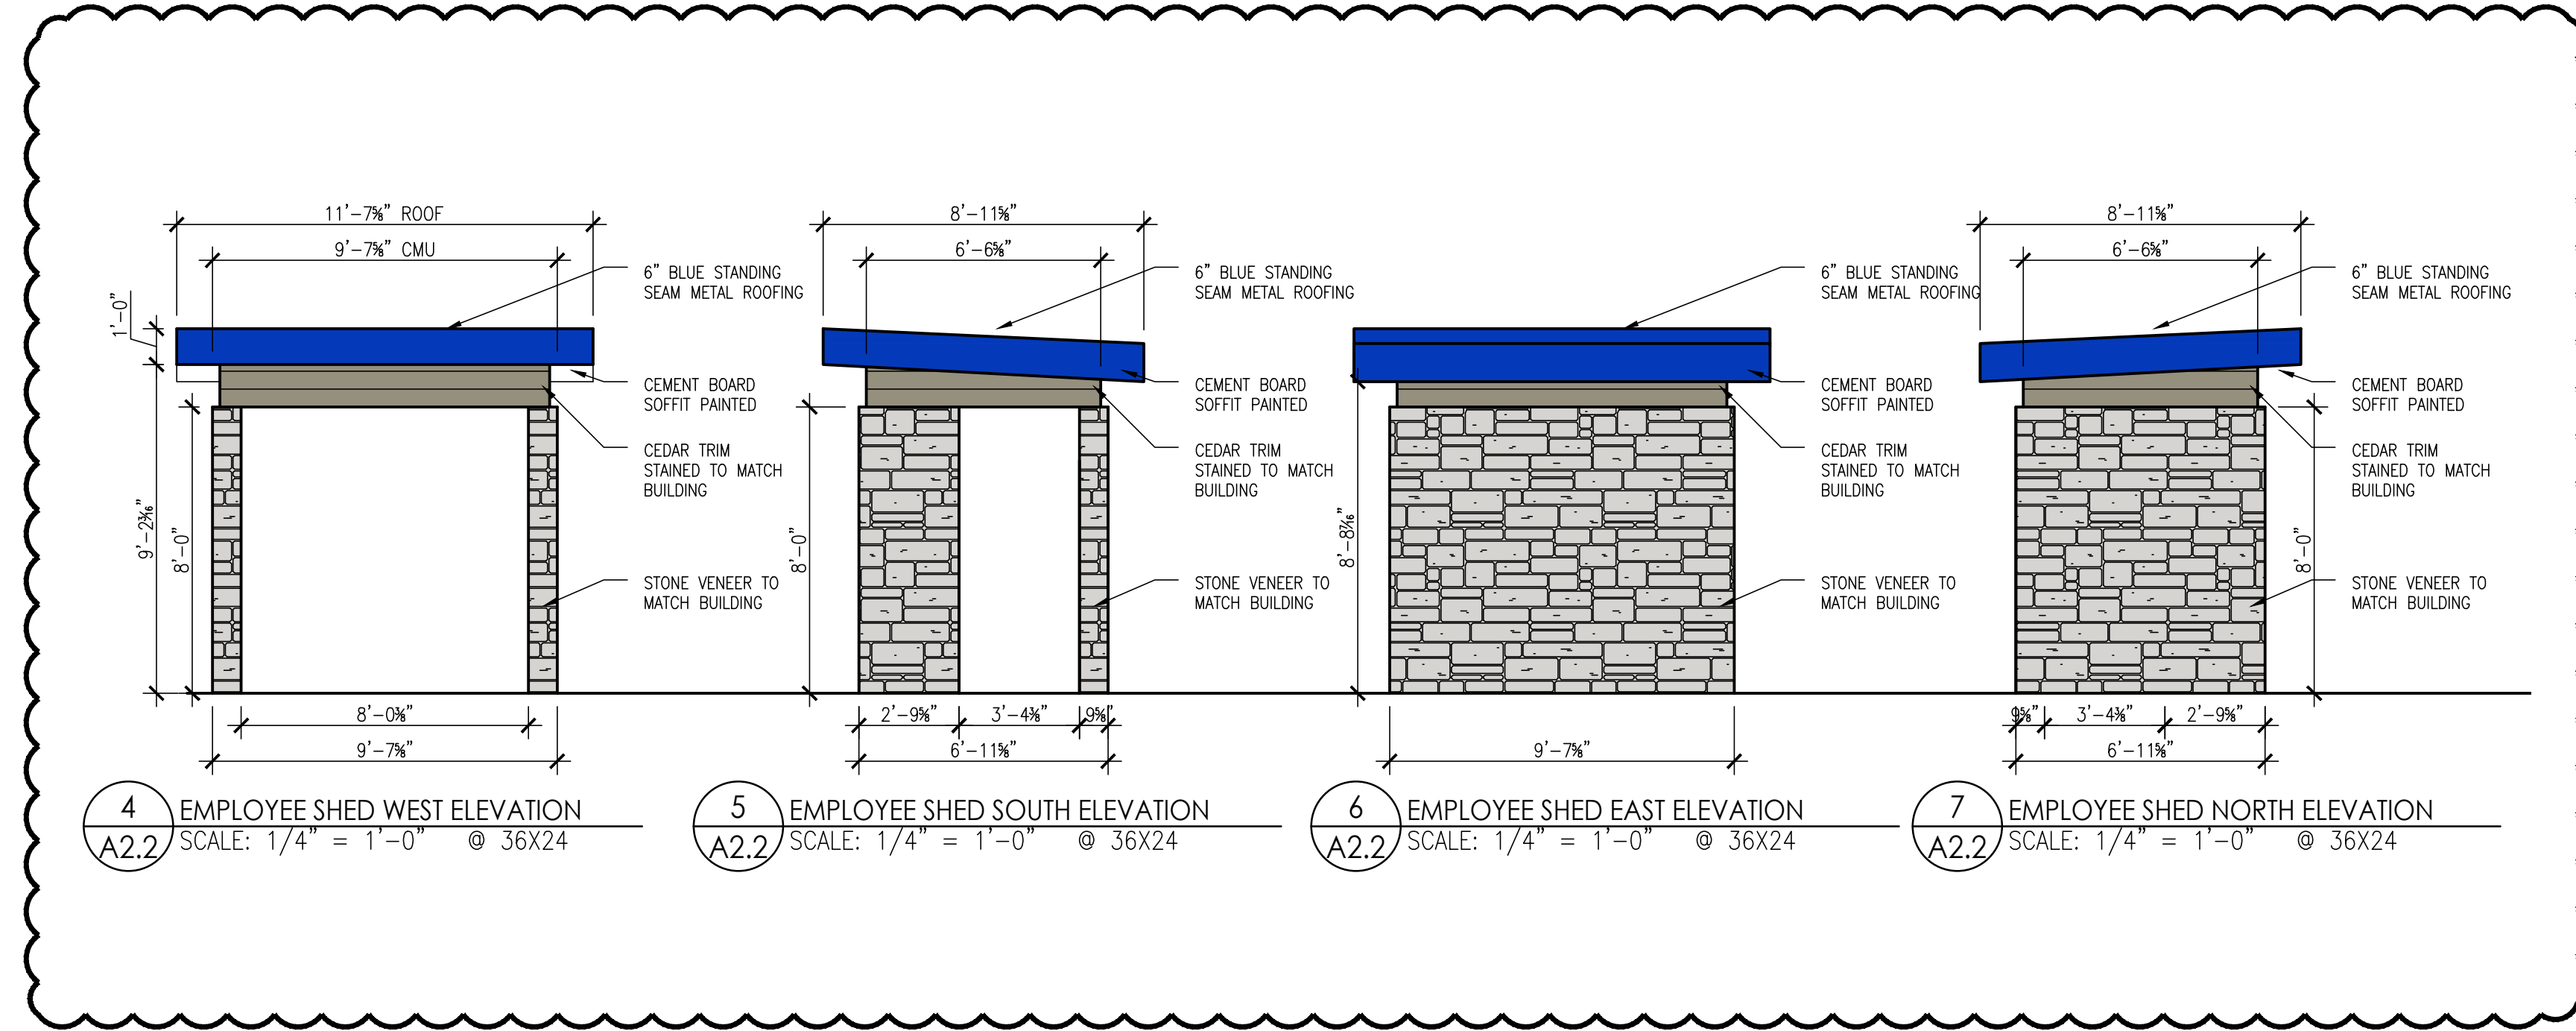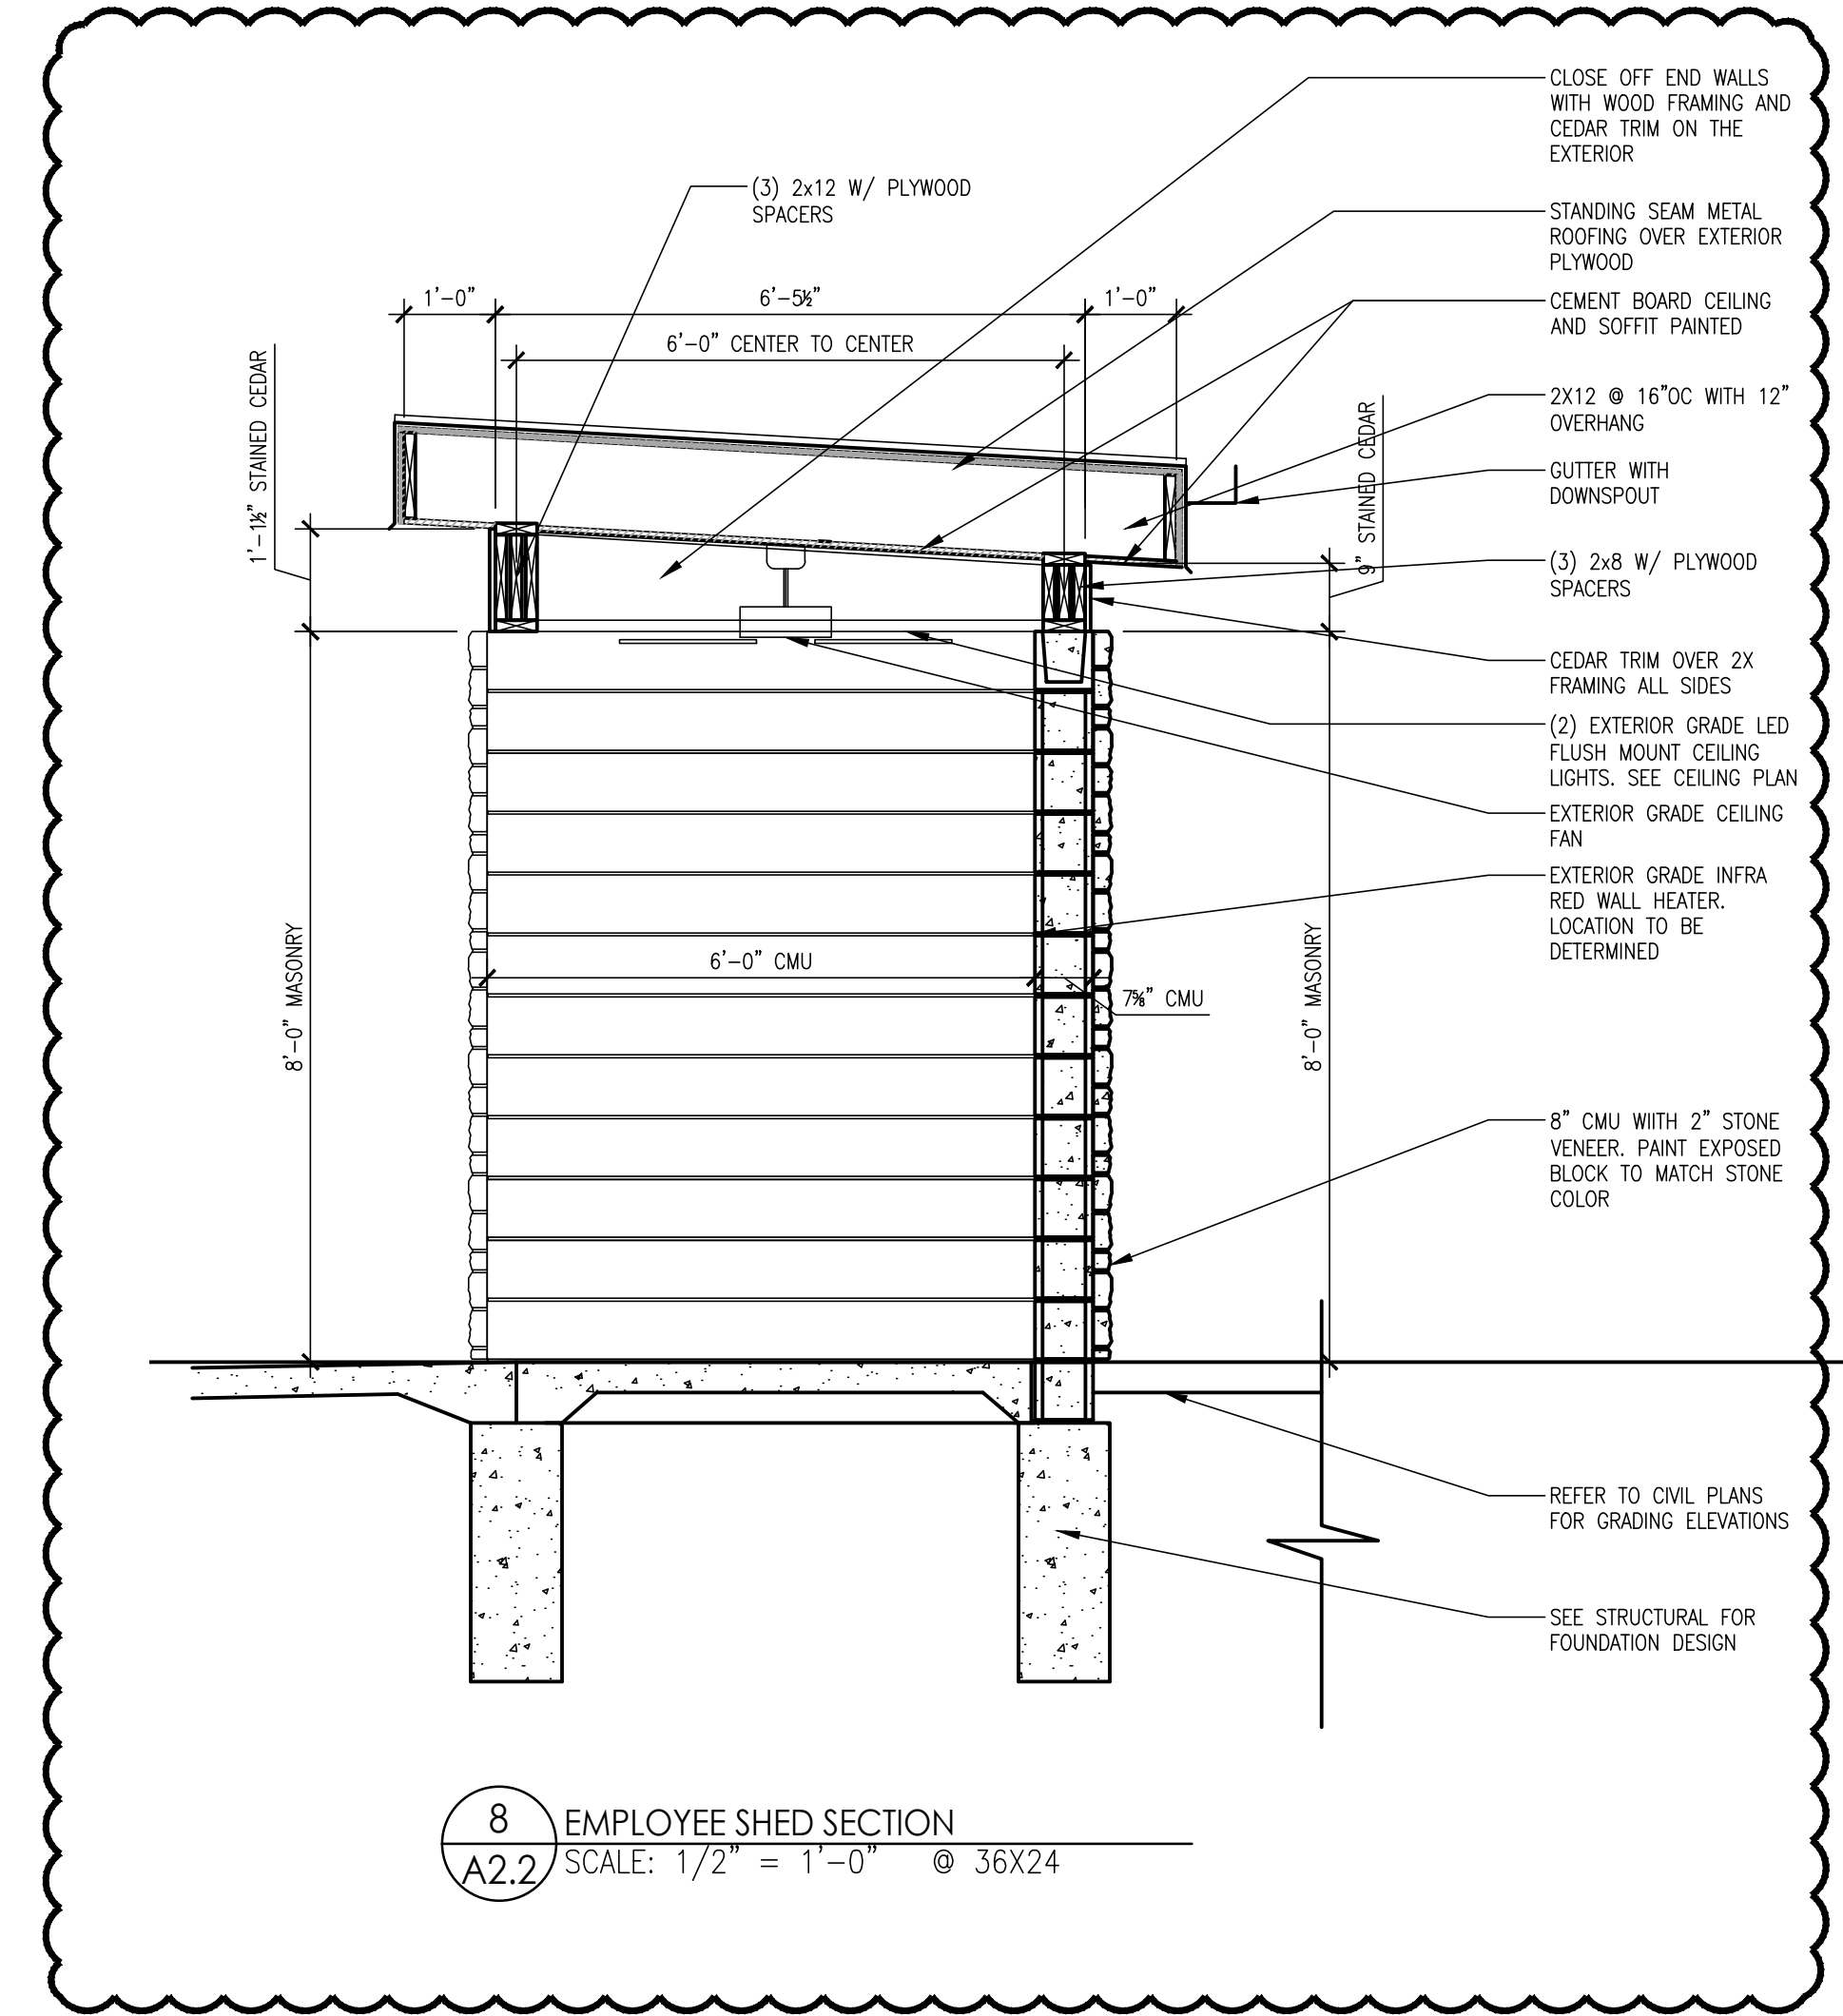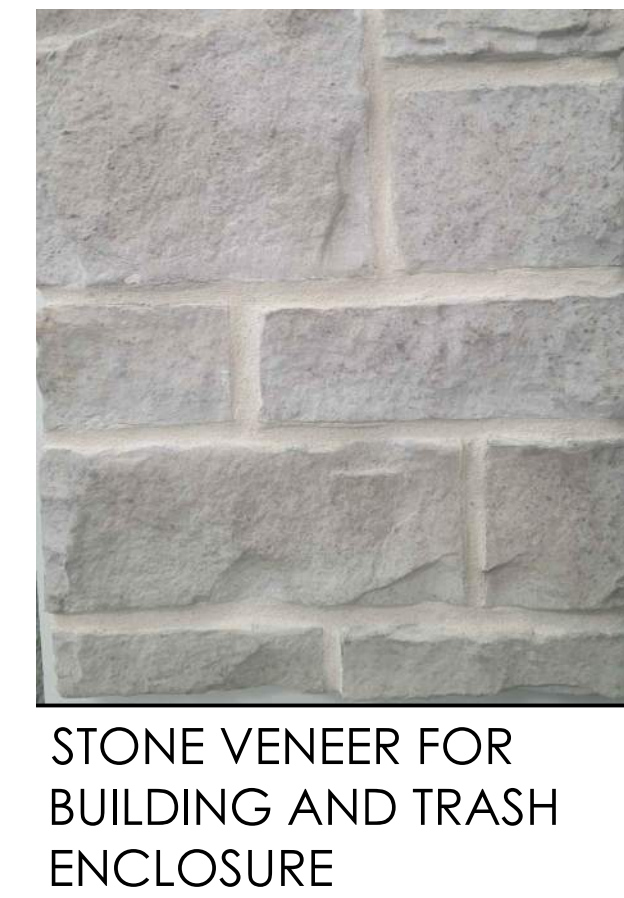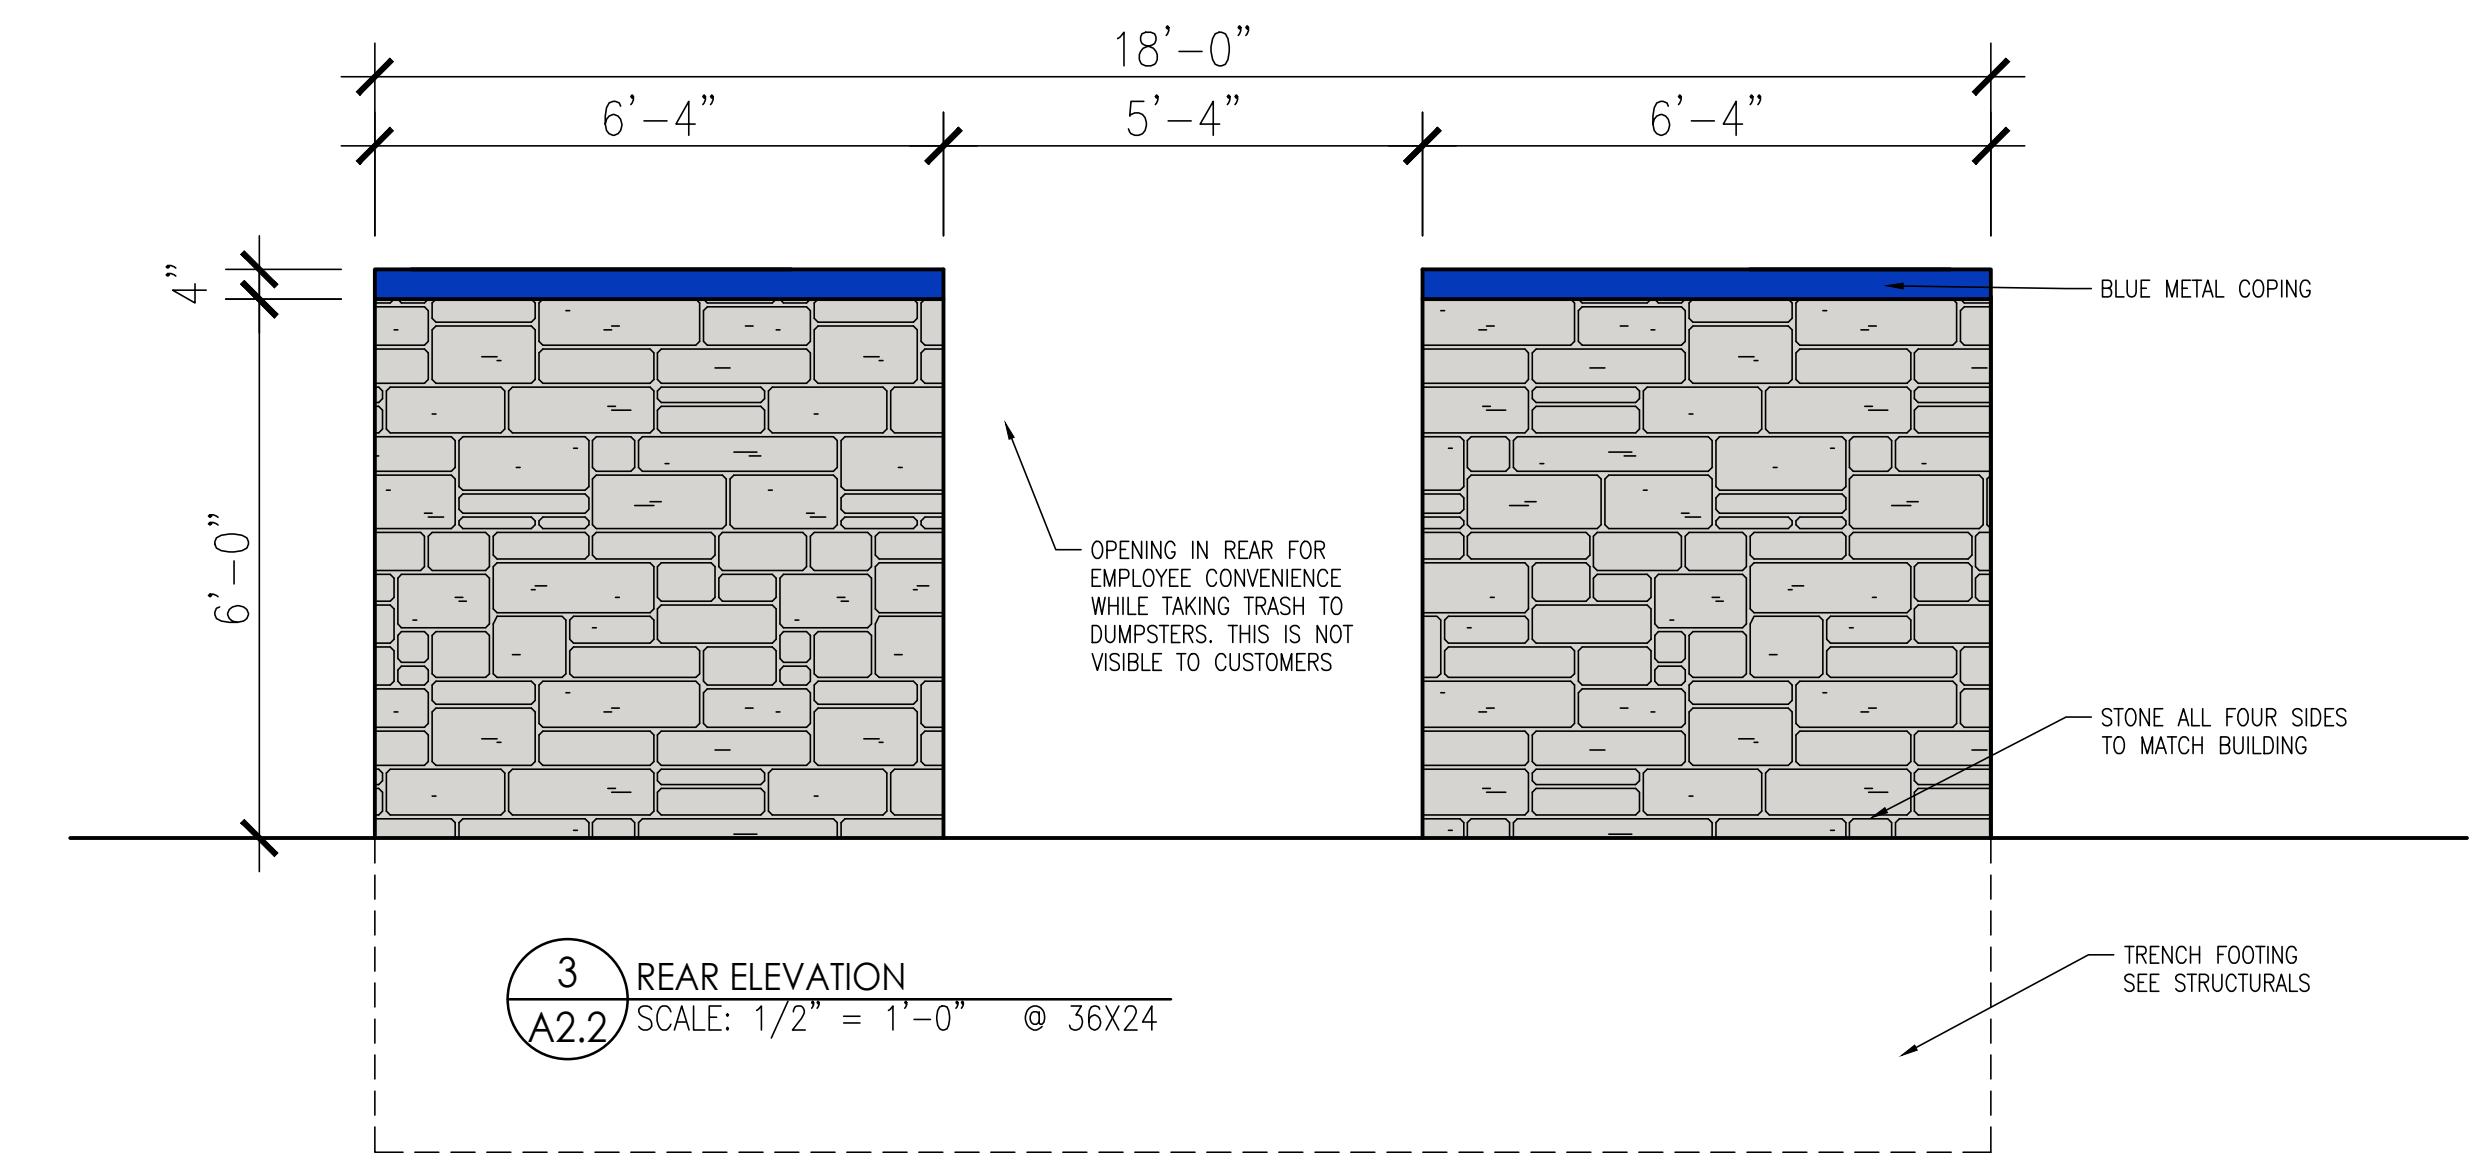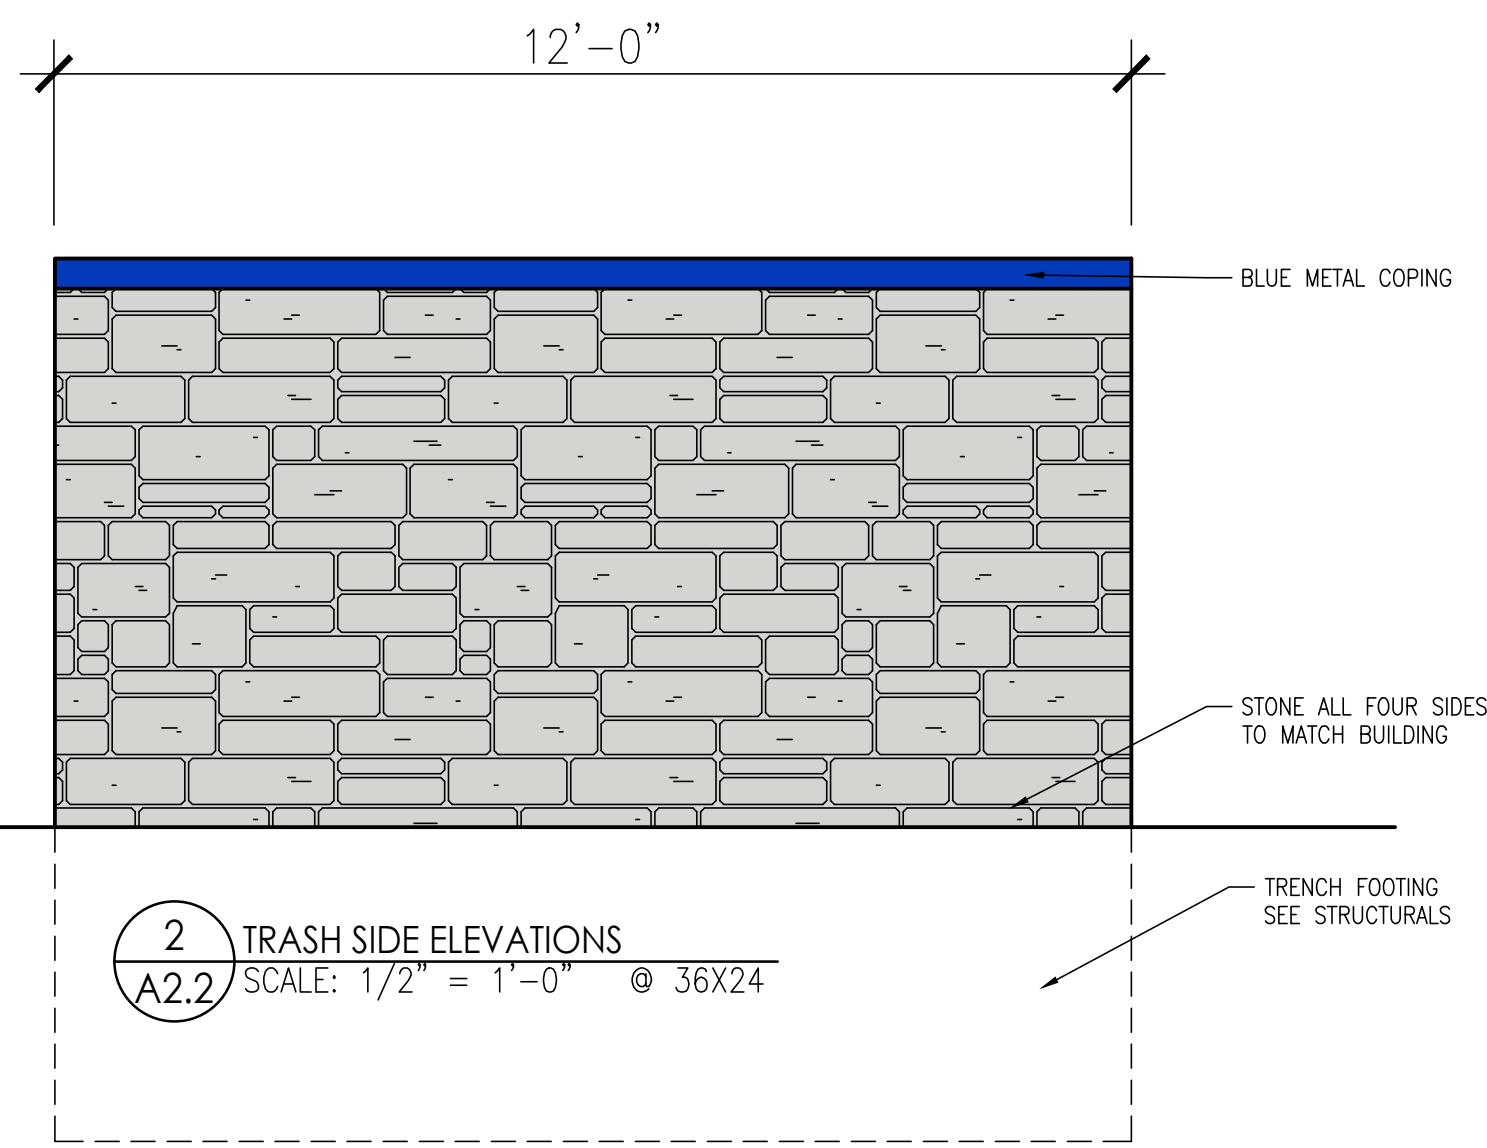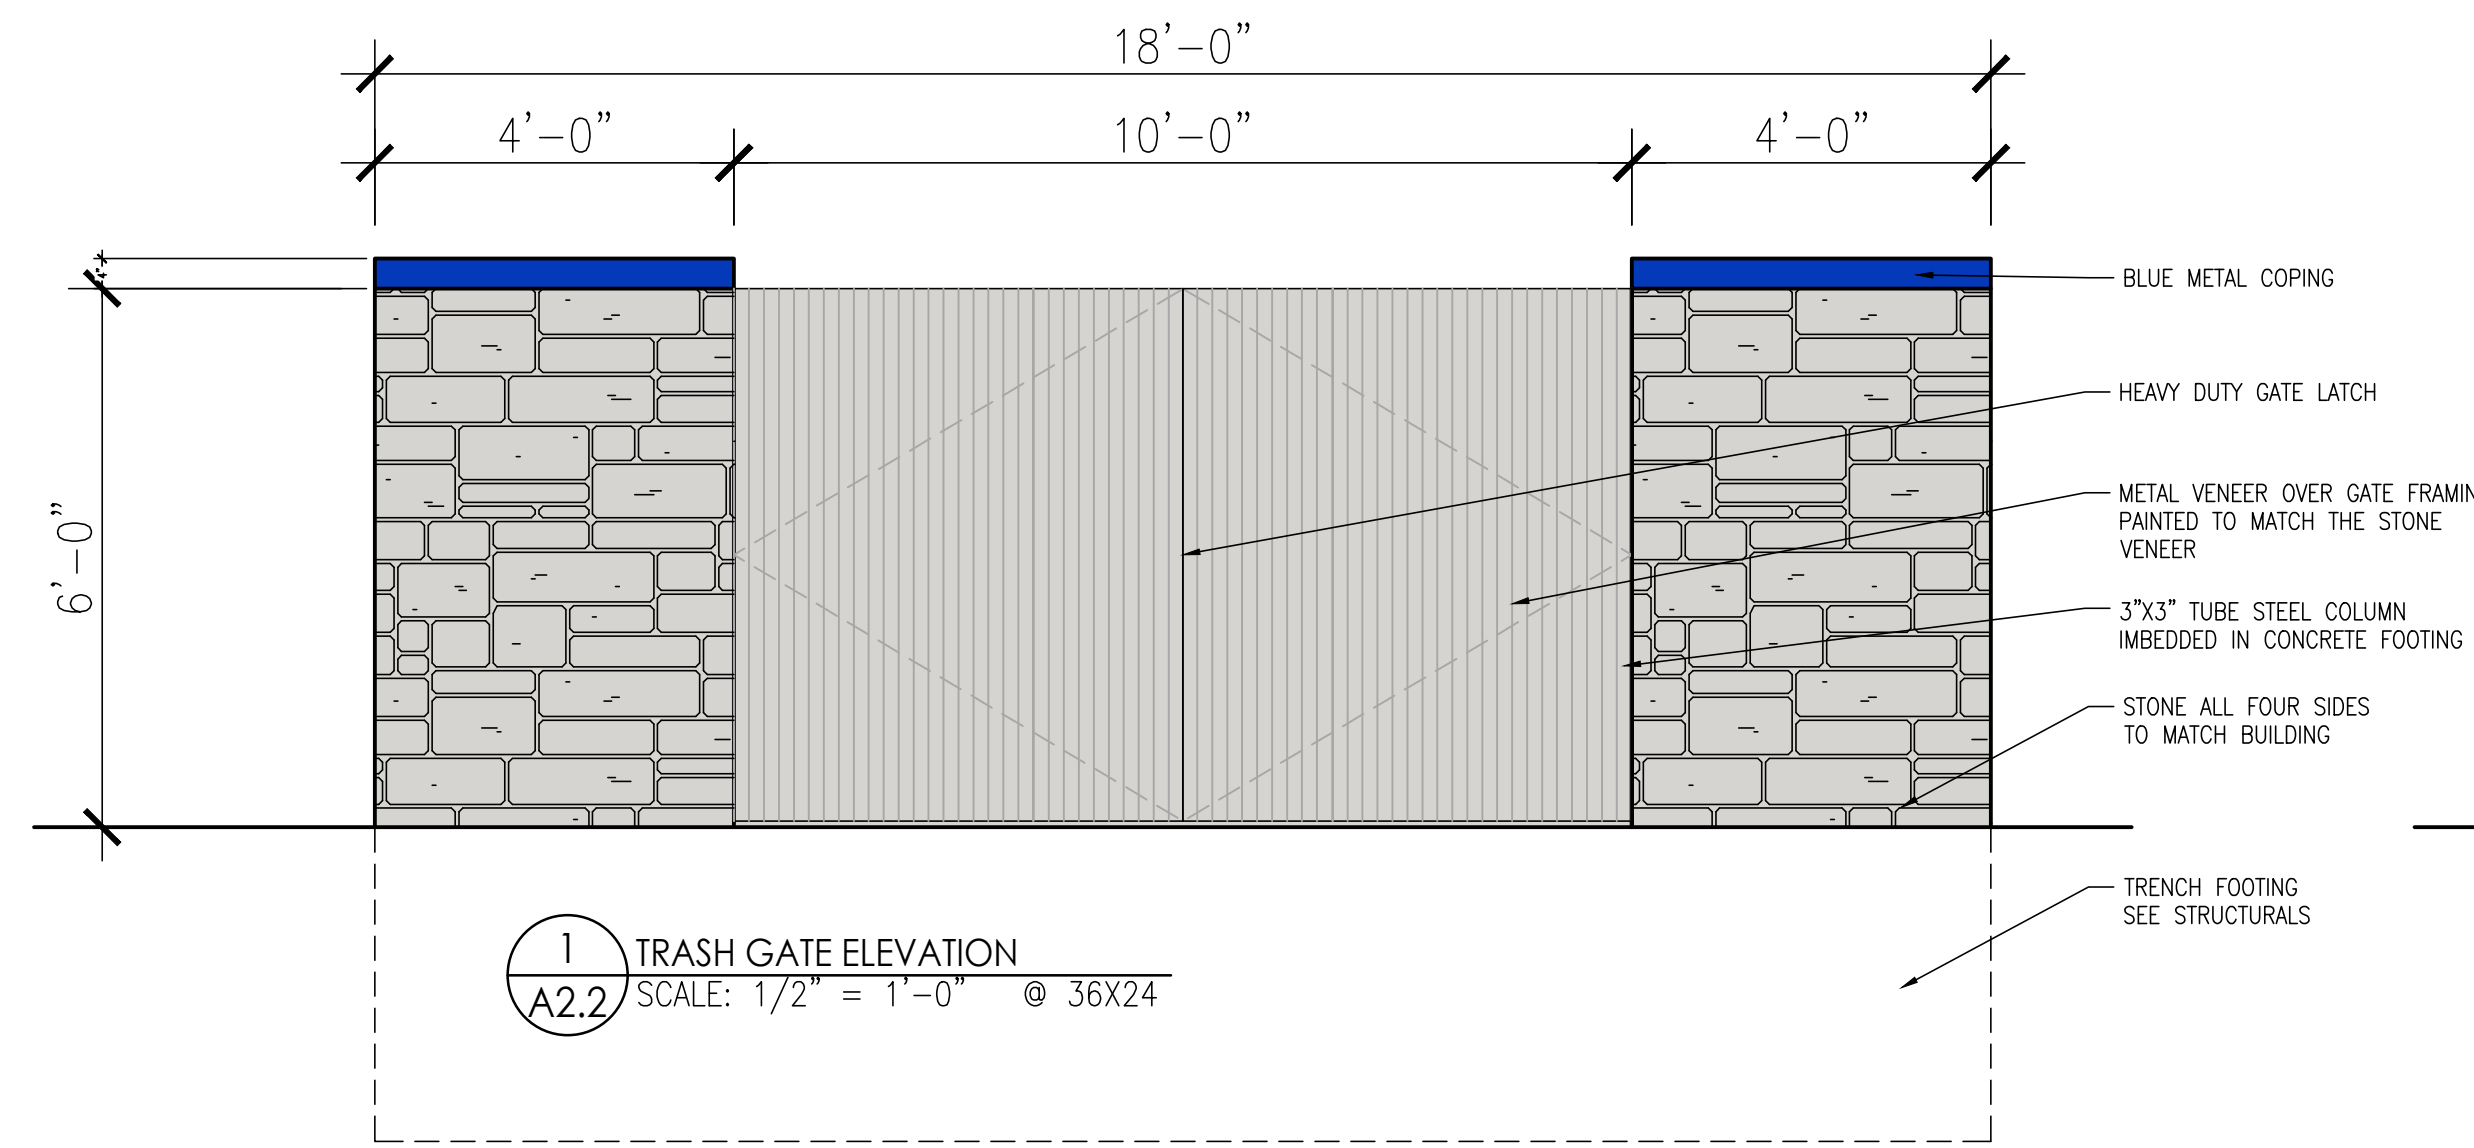

REISSUED WITH RESPONSES TO STAFF COMMENT 12-23-2025

ISSUED / REVISION	DATE
PRE-APP REVIEW	7-21-2025
ISSUED FOR PERMITS	22-28-2025
ISSUED FOR CITY COUNCIL REVIEW	32-13-2025
ISSUED FOR CITY COUNCIL MTG	3-27-2024
METAL STUD WALL NOTE	5-31-2024
HOOD WALL ASSEMBLY NOTE	6-4-2024

Charlotte's Kitchen  
Drive Thru Restaurant  
1165 SE University Avenue  
Waukee, Iowa 50263



JOB NO. 250046-5

TITLE TRASH ENCLOSURE AND EMPLOYEE SHED ELEVATIONS

SHEET A2.2